

CERTIFICATE OF LOCATION OF GOVERNMENT CORNER

County of Anoka State of Minnesota


North 1/4 Corner of Sec. 30 Township 34 Range 22

On the 1st day of February, 1979, the described corner was evidenced by area resurvey

and to perpetuate the location of said corner, at the exact location thereof, a permanent marker was placed consisting of a cast iron monument with a sign and post on the north side

AND on the 27th day of April, 2004, said permanent marker was found and the ties were updated

Updated reference ties are as shown below.

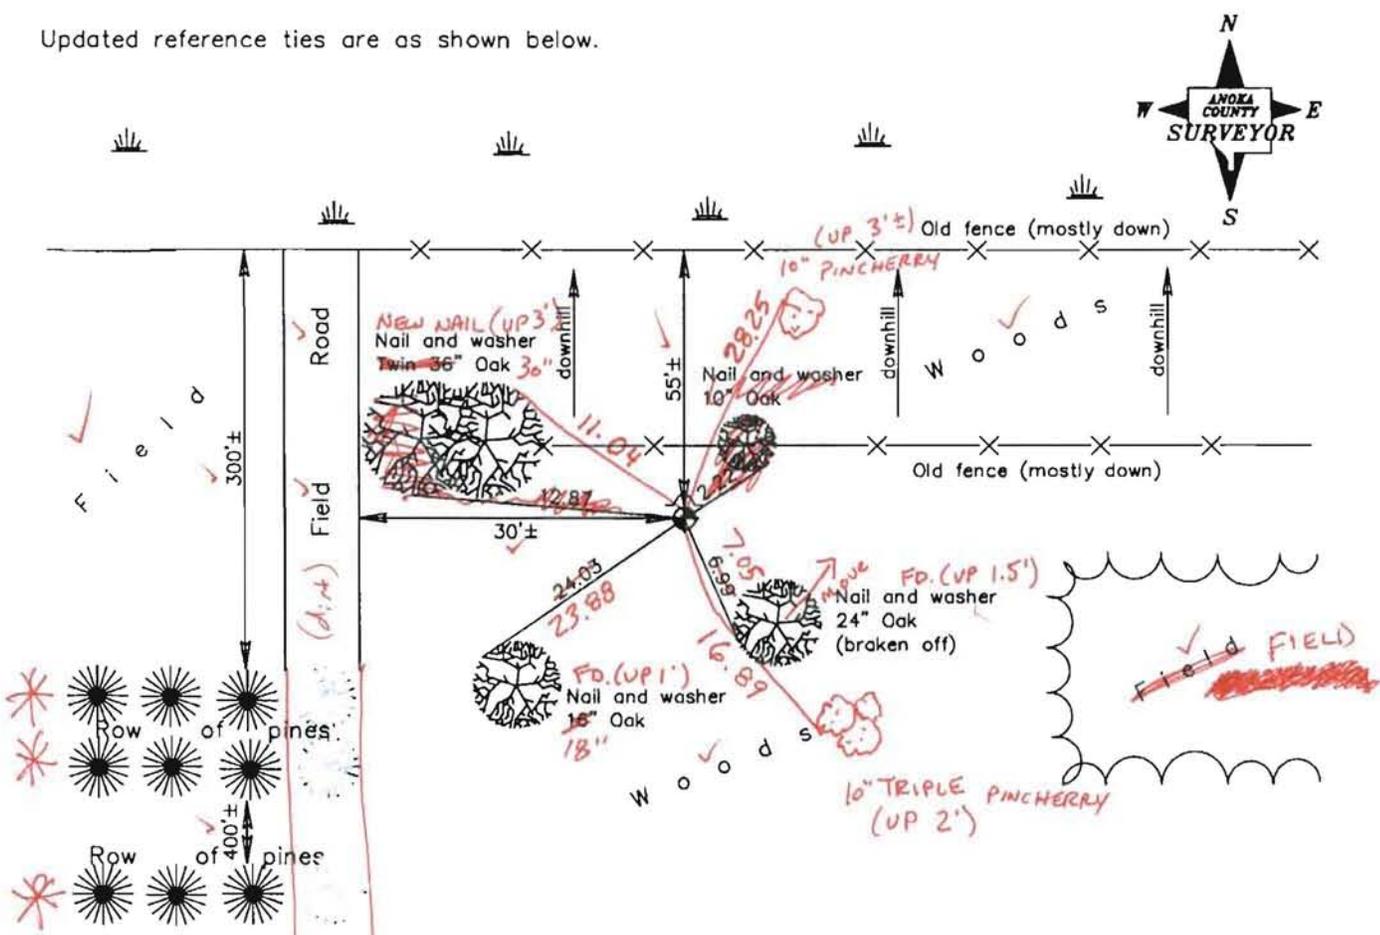

5-7-14
BK-SS
T/T

Revised date
8/13/86
7/12/93
4/27/04

N.A.D. 1983 Coordinates (1996 Adjustment)	
County Project Coordinates	
Northing	<u>238022.2224</u>
Easting	<u>534301.1000</u>
Date	<u>5/03/04</u>

I hereby certify that this United States public land survey monument record is correct and complete to the best of my knowledge and belief.

Larry D. Hoium Date: 4/27/04

Larry D. Hoium, Anoka County Surveyor

Minnesota License Number 18165

CERTIFICATE OF LOCATION OF GOVERNMENT CORNER

County of Anoka


State of Minnesota

NORTH QTR Corner of Sec. 30 Township 34 Range 22

I hereby certify that on the 1 day of FEB., 1979, I found the described corner which was evidenced by AREA RESURVEY

and I further certify that to perpetuate the location of said corner, I did, at the exact location thereof, place a permanent marker consisting of CAST IRON MON.


which reference or witness monuments are located in the manner following:

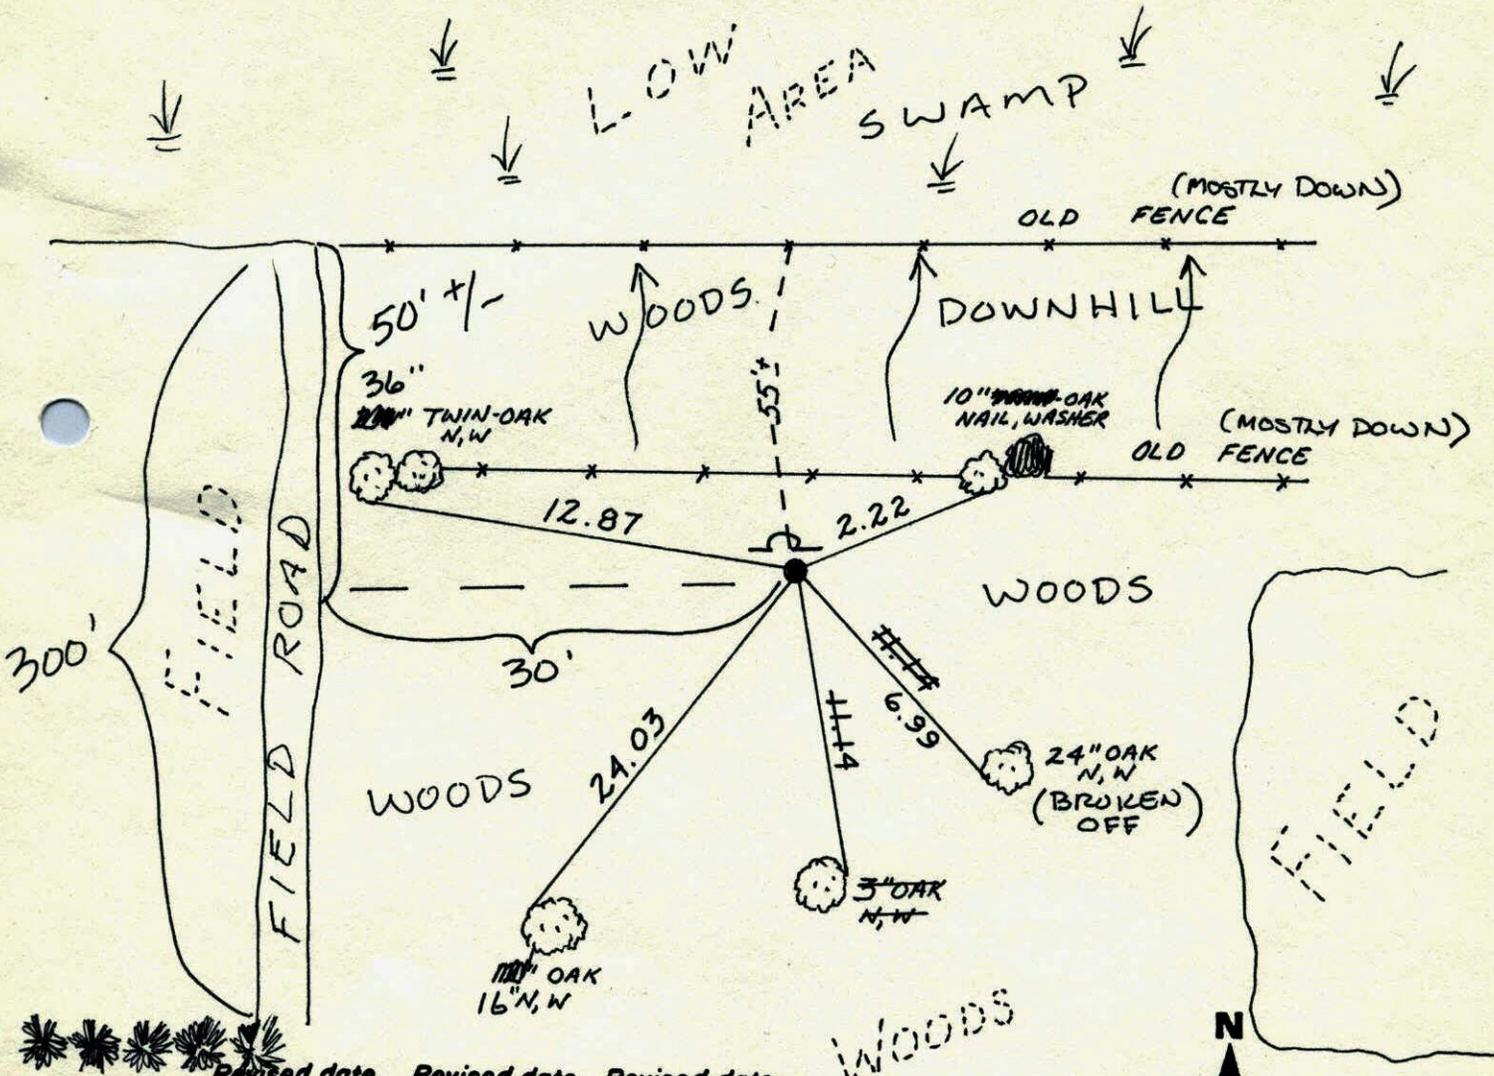

Revised date Revised date Revised date

8-13-86		
7-12-93		
4-27-04		

400'
(TO NEXT
PINE
ROW)

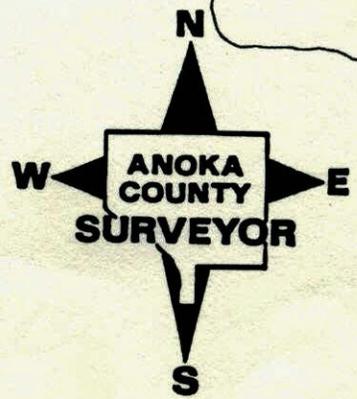

N¹/₄ CORNER SECTION 30-T34-R22


SET 1/2" IRON PIPE FROM AREA RESURVEY.

SET CAST IRON WITH SIGN + post.

9-30-79 H. LARSON
B. GUETZKO
D. NAGLAK

1 FEB 79
H. LARSON
B. GUETZKO
D. NAGLAK

LOW LAND

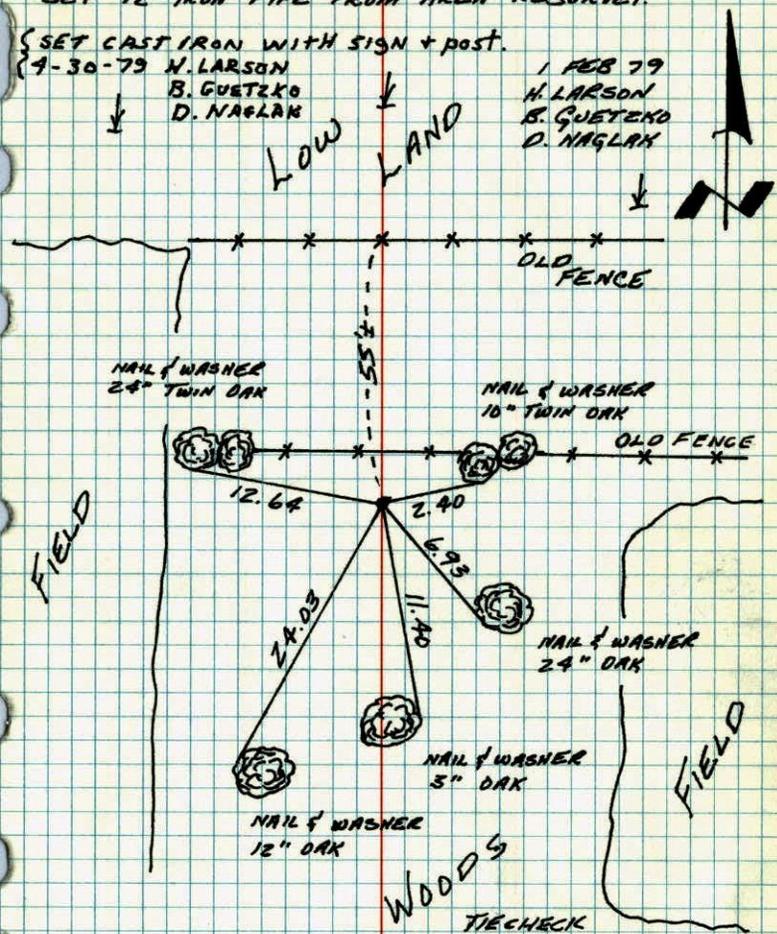

TIE CHECK
6-9-82
R. ROSS
J. BEIER

TEMPERATURE CORRECTED
AND HORIZONTALLY
TAPED MEASUREMENTS


ROLAND W. ANDERSON
COUNTY SURVEYOR
ANOKA COUNTY, MINNESOTA

NO. 448
TELEPHONE

N¹/₄ Cor. Section 30 T34 R22

Set 1/2" Iron pipe from area
resurvey.

#1 10°
2-1-79
H. Larson
B. Guetzko
D. Naglak

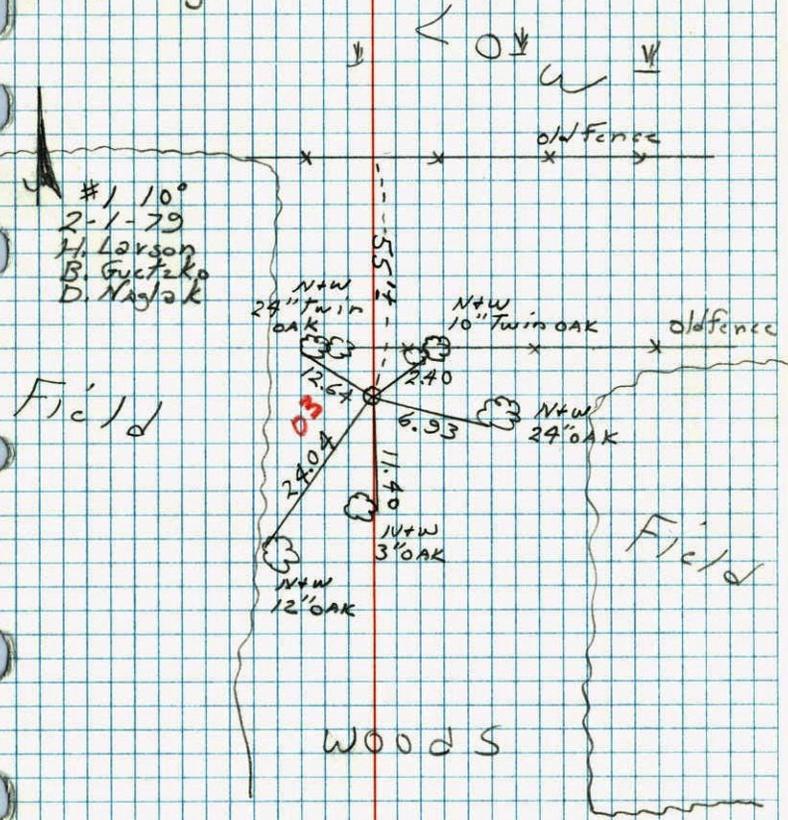

WOODS

NO. 448
TELEPHONE