

# CERTIFICATE OF LOCATION OF GOVERNMENT CORNER

County of Anoka

State of Minnesota

West 1/4 Corner of Sec. 26 Township 34 Range 22


On the 4th day of February, 1963, the described corner was evidenced by a cast iron monument set by N. C. Hoium

and to perpetuate the location of said corner, at the exact location thereof, a permanent marker was placed consisting of the same cast iron monument with a sign and post on the north side

~~\* STON MISSING~~      **ADDED NEW SIGN**  
**8-18-14 - BK-SS**

AND on the \_\_\_ day of \_\_\_\_\_, \_\_\_\_\_, said permanent marker was \_\_\_\_\_

Updated reference ties are as shown below.

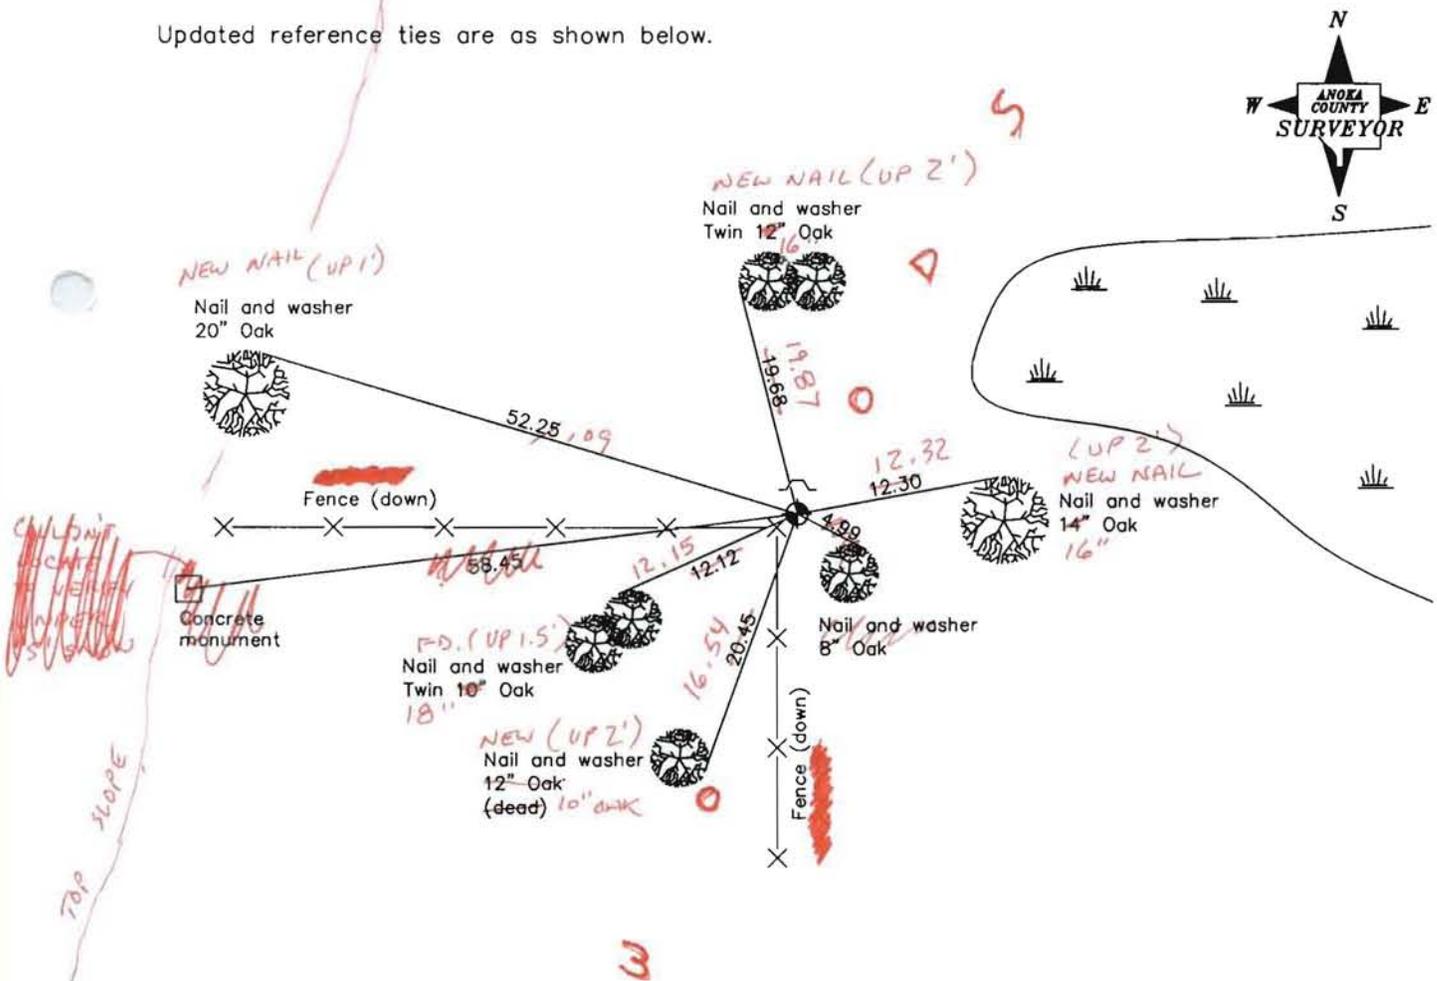

Revised date
11/06/90
7/01/93
1-29-14
BK-SS
TAPED

N.A.D. 1983 Coordinates (1996 Adjustment)	
County Project Coordinates	
Northing	234951.6365
Easting	552996.7554
Date	1/15/04

I hereby certify that this United States public land survey monument record is correct and complete to the best of my knowledge and belief.

\_\_\_\_\_, Date \_\_\_\_\_

\_\_\_\_\_, Anoka County Surveyor

Minnesota License Number \_\_\_\_\_

# CERTIFICATE OF LOCATION OF GOVERNMENT CORNER

County of Anoka

State of Minnesota


WEST QTR. Corner of Sec. 26 Township 34 Range 22

I hereby certify that on the 4 day of FEB., 1963, I found the described corner which was evidenced by CAST IRON MON. SET BY N.C. HOIUM


and I further certify that to perpetuate the location of said corner, I did, at the exact location thereof, place a permanent marker consisting of SAME

SIGN & Post ON NTH SIDE

which reference or witness monuments are located in the manner following:

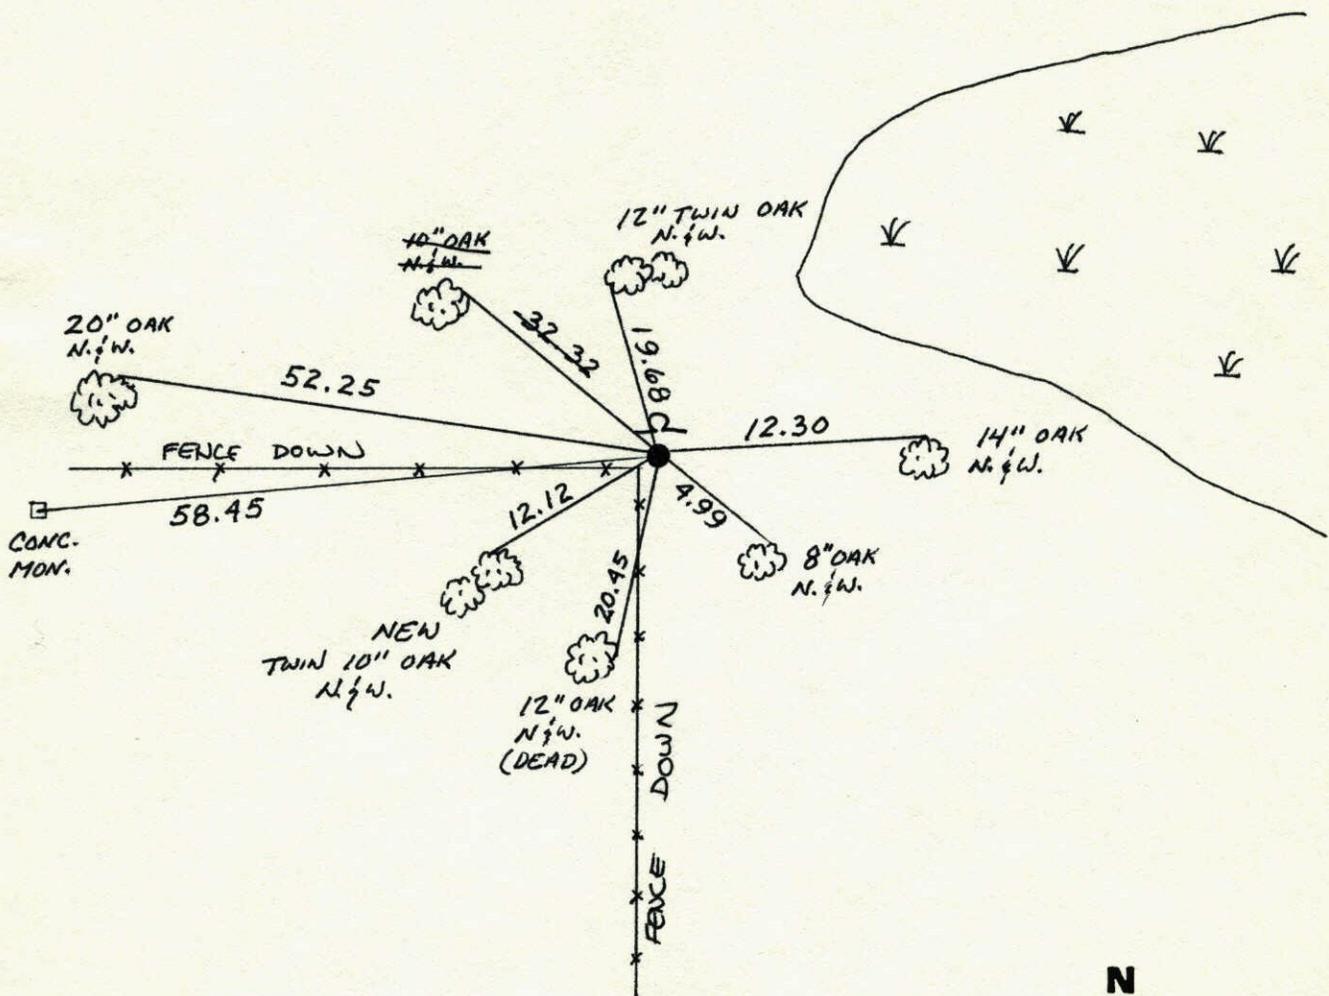


Revised date	Revised date	Revised date
11-6-90		
7-1-93		

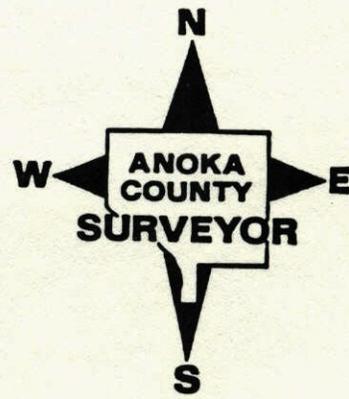

W 1/4 Cor Sec. 26-T 34-R 22

Cast Iron Monument

Set N.C. Hoium

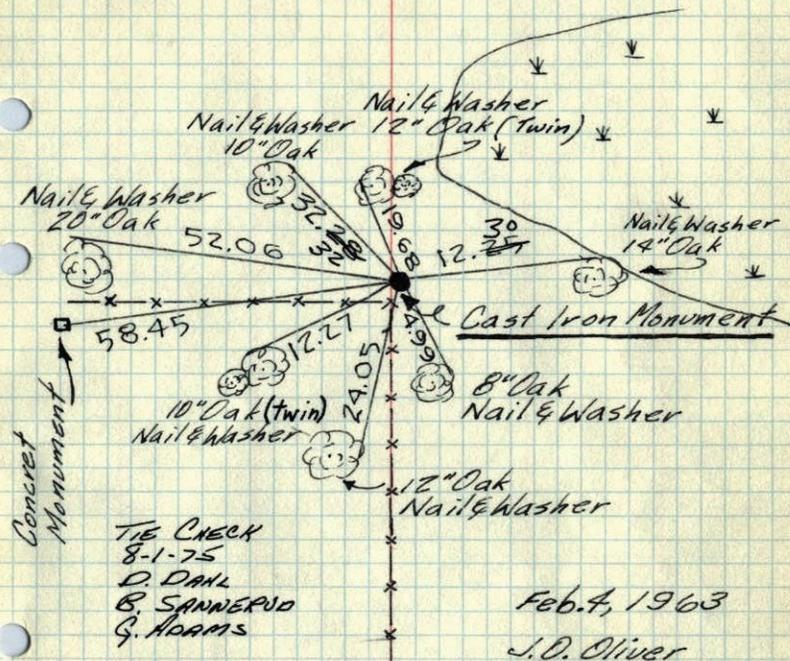

Concrete Monument

TIE CHECK  
8-1-75  
D. DAHL  
B. SANNEPUD  
G. ADAMS

TIE CHECK  
6-9-82  
P. ROSS  
J. BERER

Feb. 4, 1963

J.D. Oliver  
M.D. Anderson

Tie Check  
June 20, 1967  
D. Potter  
D. Powell

TEMPERATURE CORRECTED  
AND HORIZONTALLY  
TAPED MEASUREMENTS


ROLAND W. ANDERSON  
COUNTY SURVEYOR  
ANOKA COUNTY, MINNESOTA

Tie Check  
8-9-78  
D. Dahl  
B. Stephens  
M. Kisrow

W 1/4 Cor Sec. 26-T 34-R 22

Cast Iron Monument

Set N.C. Hoium

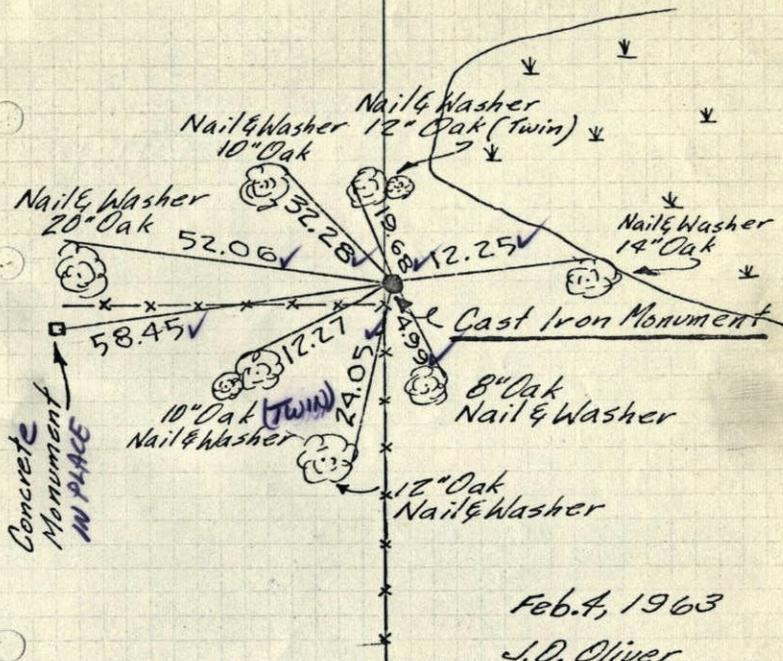

Concrete Monument  
IN PLACE

Feb. 4, 1963

J.D. Oliver  
M.D. Anderson

6/20/67  
D. POTTER  
D. POWELL

TEMPERATURE CORRECTED  
AND HORIZONTALLY  
TAPED MEASUREMENTS

ROLAND W. ANDERSON  
COUNTY SURVEYOR  
ANOKA COUNTY, MINNESOTA

