

CERTIFICATE OF LOCATION OF GOVERNMENT CORNER

County of Anoka

State of Minnesota


Witness Corner of Sec. 25 Township 34 Range 22
 (on north line of NE 1/4)

On the 6th day of April, 1975, the described corner was evidenced by area resurvey

and to perpetuate the location of said corner, at the exact location thereof, a permanent marker was placed consisting of a cast iron monument with a sign and post on the north side

AND on the ___ day of _____, _____, said permanent marker was _____

Updated reference ties are as shown below.

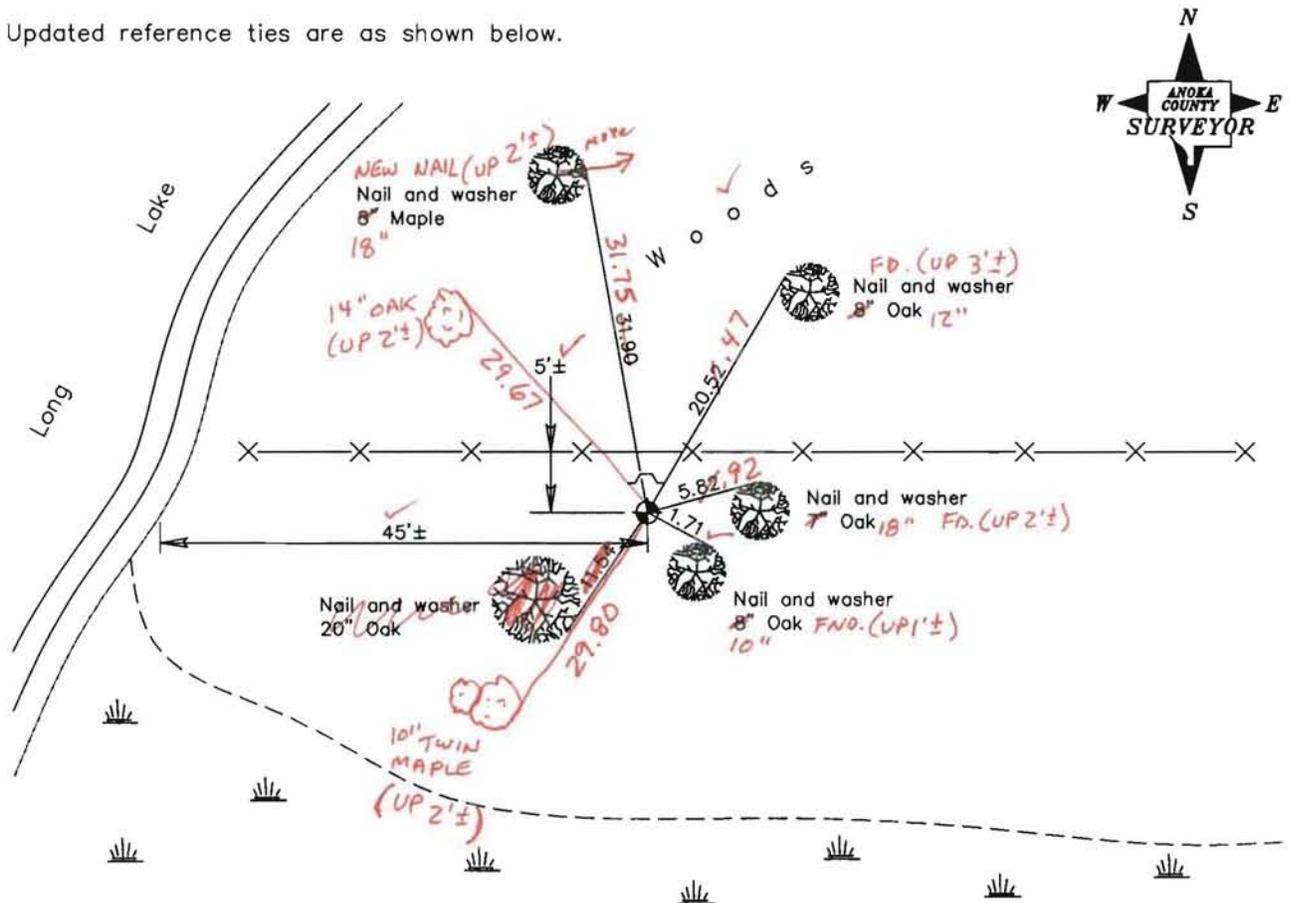

5-2-14
BK-55
TAPED

Revised date	7/12/93

N.A.D. 1983 Coordinates (1996 Adjustment)	
County Project Coordinates	
Northing	237414.2399
Easting	561258.4650
Date	4/21/05

I hereby certify that this United States public land survey monument record is correct and complete to the best of my knowledge and belief.

_____ Date _____

_____, Anoka County Surveyor

Minnesota License Number _____


CERTIFICATE OF LOCATION OF GOVERNMENT CORNER

WITNESS CORNER *County of Anoka* *State of Minnesota*
ON NORTH LINE of
NORTHWEST QUARTER Corner of Sec. 25 Township 34 Range 22


I hereby certify that on the 6 day of APRIL, 1975, I found the described corner which was evidenced by AREA RESURVEY

and I further certify that to perpetuate the location of said corner, I did, at the exact location thereof, place a permanent marker consisting of CAST IRON MONUMENT SIGN AND POST ON NORTH SIDE

which reference or witness monuments are located in the manner following:

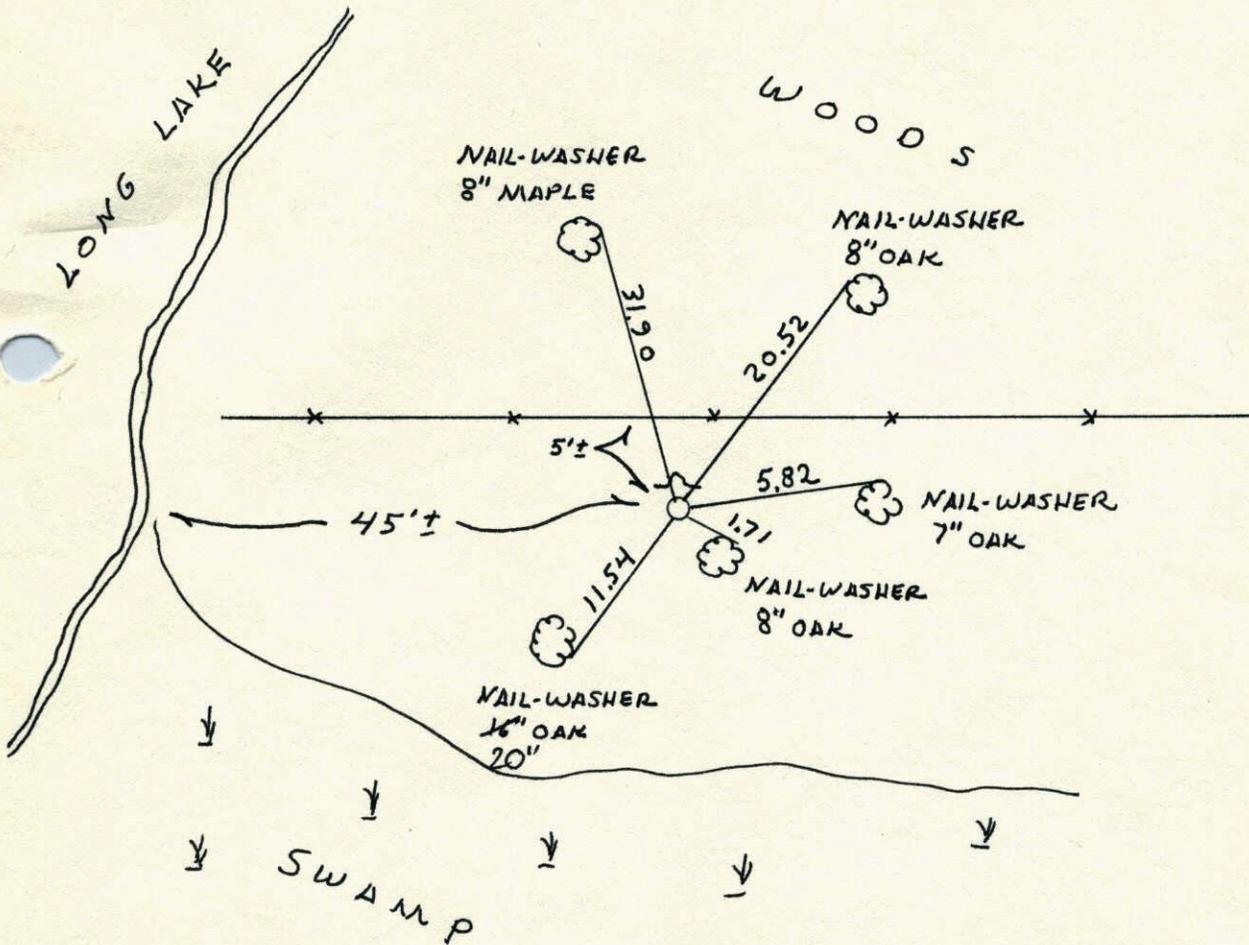

Revised date	Revised date	Revised date
7-12-93		

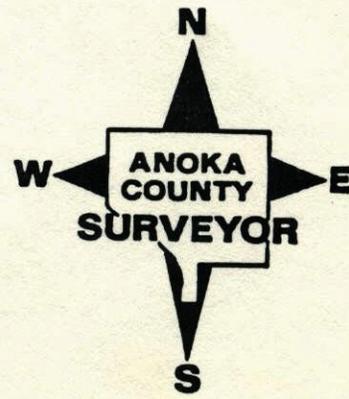


2
W.C. On North Line Of NE 1/4 Sec. 25,

T34, R22

Set Cast Iron Monument From Area Resurvey.

Sign & Post On North Side.

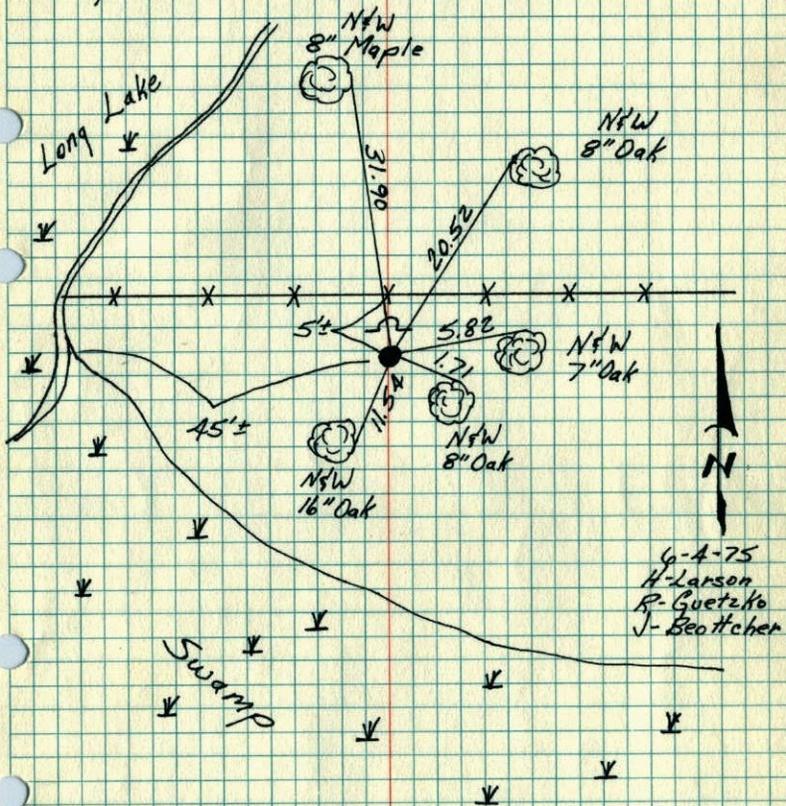


6-4-75
H. Larson
R. Guetzko
J. Beutcher

TEMPERATURE CORRECTED ROLAND W. ANDERSON
AND HORIZONTALLY COUNTY SURVEYOR
TAPED MEASUREMENTS ANOKA COUNTY, MINNESOTA

W.C. on N. Line of NE 1/4 Sec. 25, T34, R22

Set cast iron monument from area
resurvey sign & post on N. side

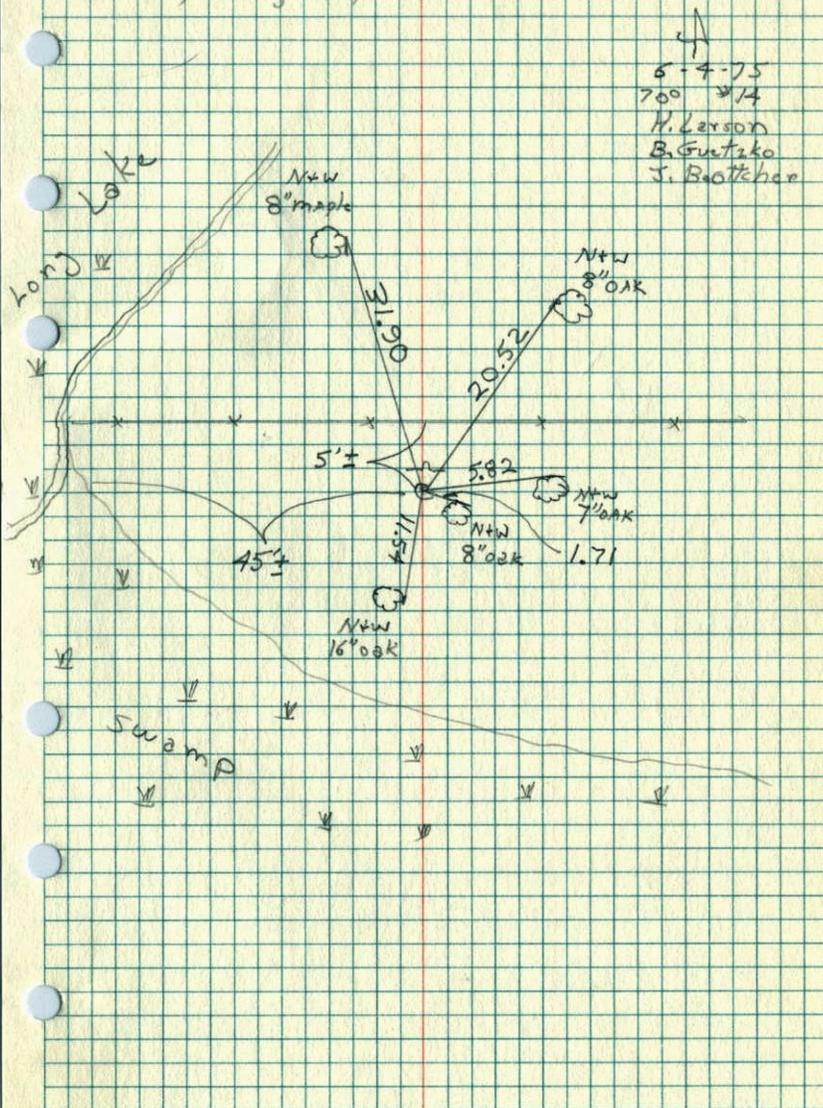

6-4-75
70° W 1/4
H. Larson
R. Guetzko
J. Beutcher