

CERTIFICATE OF LOCATION OF GOVERNMENT CORNER

County of Anoka

State of Minnesota


East 1/4 Corner of Sec. 26 Township 34 Range 22

On the 20th day of June, 1967, the described corner was evidenced by a concrete monument *(MON. LEANING S.W.)*

and to perpetuate the location of said corner, at the exact location thereof, a permanent marker was placed consisting of the same concrete monument with a sign and post on the north side
MON. S. OF SIGN POST ~~1' +/-~~ 1' +/-

AND on the ___ day of _____, _____, said permanent marker was _____

Updated reference ties are as shown below.

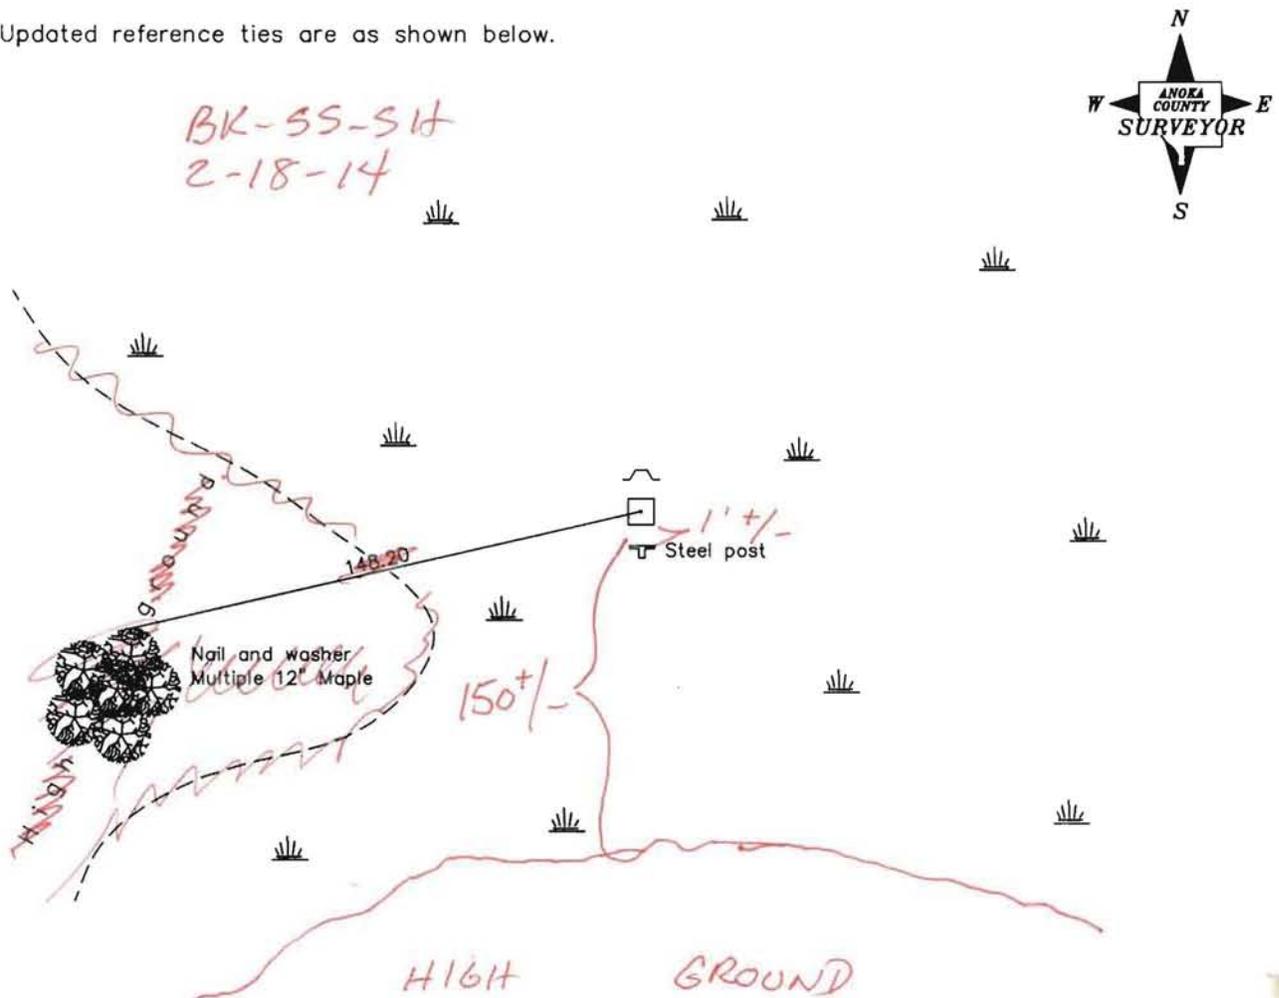

Revised date

1982
1986
6/28/95

N.A.D. 1983 Coordinates
(1996 Adjustment)

County Project Coordinates
Northing <u>234835.3245</u>
Easting <u>558249.4039</u>
Date <u>2/10/04</u>

I hereby certify that this United States public land survey monument record is correct and complete to the best of my knowledge and belief.

Date _____
 _____, Anoka County Surveyor
 Minnesota License Number _____

3D 0.04

N = 234835.3894

E = 558249.8015

CERTIFICATE OF LOCATION OF GOVERNMENT CORNER

County of Anoka


State of Minnesota

EAST 1/4 Corner of Sec. 26 Township 34 Range 22


I hereby certify that on the 20 day of JUNE, 19 67, I found the described corner which was evidenced by CONCRETE MONUMENT

and I further certify that to perpetuate the location of said corner, I did, at the exact location thereof, place a permanent marker consisting of CONCRETE MONUMENT WITH SIGN AND POST ON NORTH SIDE

which reference or witness monuments are located in the manner following:

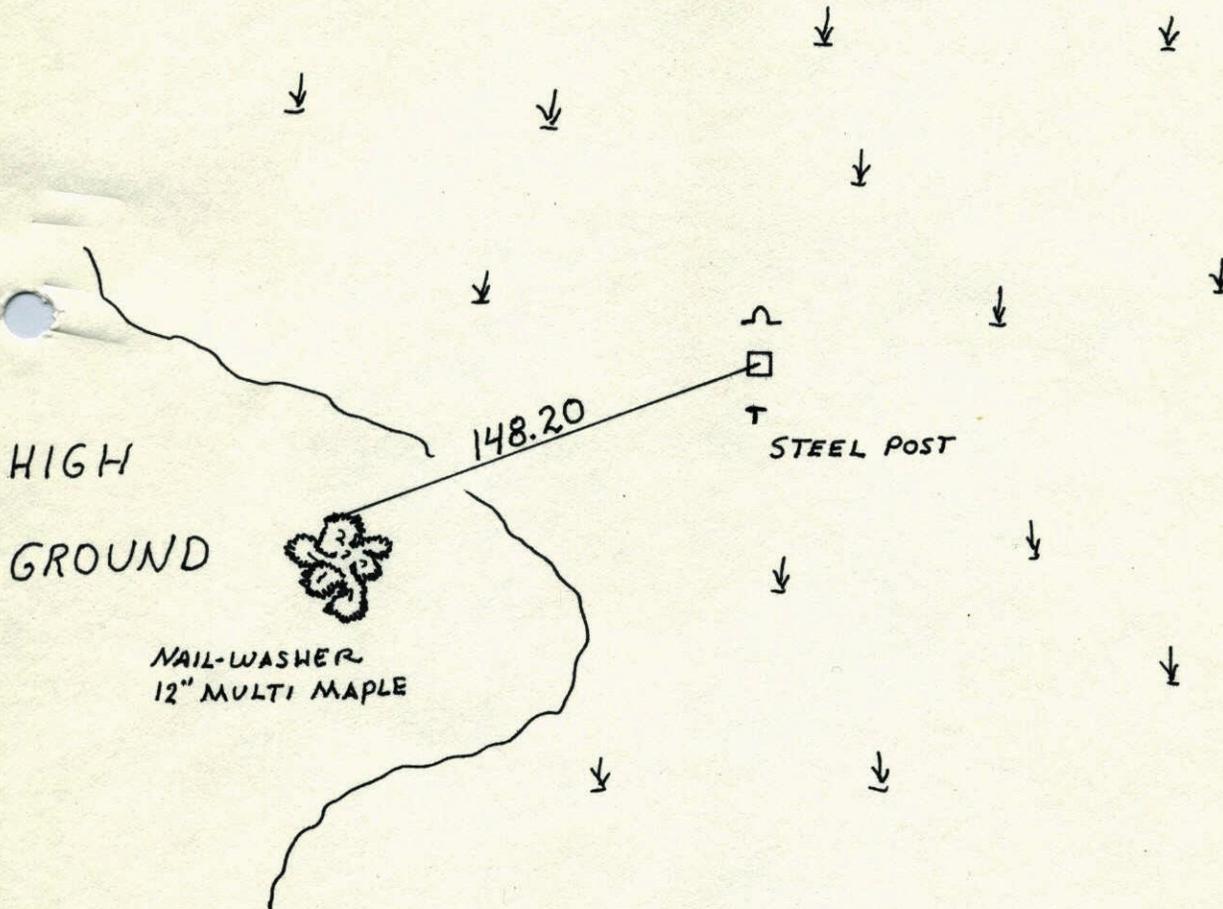


Revised date	Revised date	Revised date
WET 82		
WET 86		
6-28-95		

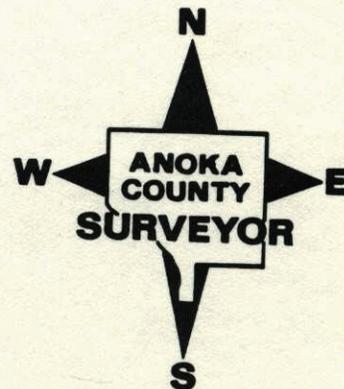

EAST 1/4 SEC. 26 T_W 34 R. 22

CONCRETE MON. WITH SIGN

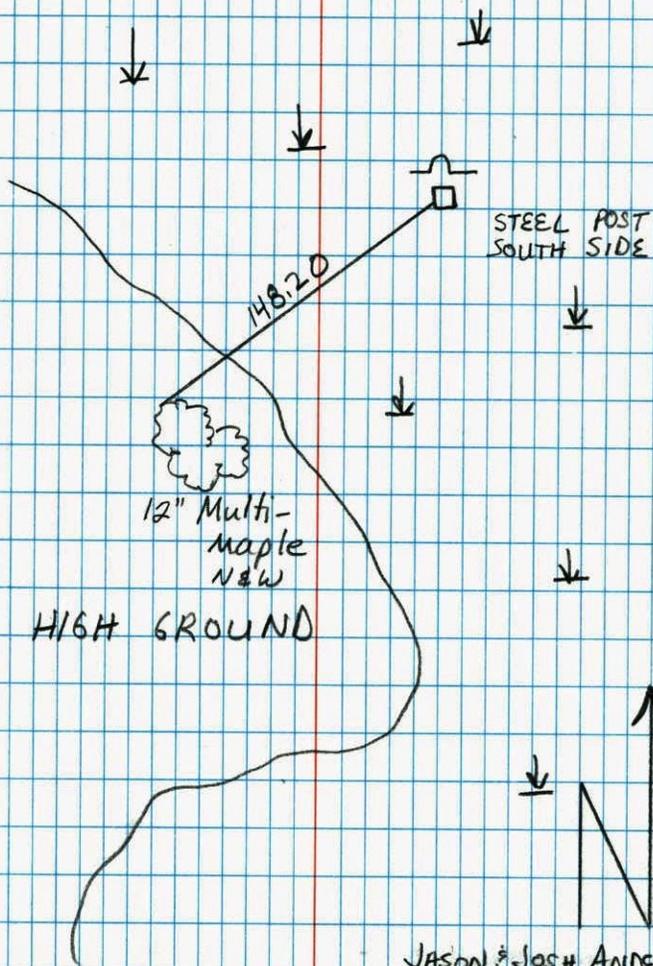


JASON & JOSH ANDERSON
6-28-95

NATIONAL PRINTFAST NO. 446

E1/4 Corner Section 26-T34-R22

Tied concrete monument that was raised in June of 1978, but was unable to tie. Corner was undisturbed and up 1' (Original ties are all gone)

21 Dec 78
H. Larson
R. Guetzko
D. Naglak

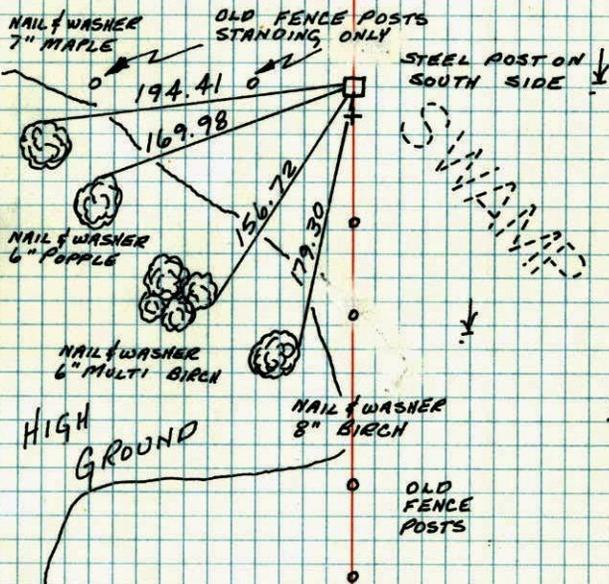

WET 1982

TEMPERATURE CORRECTED
AND HORIZONTALLY
TAPED MEASUREMENTS

ROLAND W. ANDERSON
COUNTY SURVEYOR
ANOKA COUNTY, MINNESOTA

NO. 446


TELETYPE

E 1/4 Cor. Section 26 T34 R22

Tied concrete monument that was raised in June of 1978 but was unable to tie. corner was undisturbed and up 1'±

(original ties are all gone)

12-21-78
#1 25°
H. Larson
B. Gutzko
D. Naglak

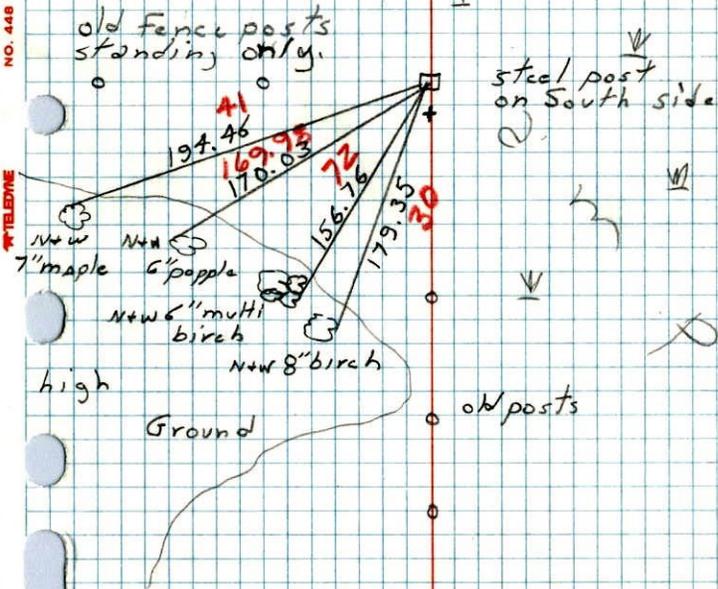


E 1/4 Cor. Sec. 26, T34, R22

Concrete Monument, ~~up 0.5'~~
down 0.3'

Found ties gone
concrete under
ice.
1-13-78
H. Larson
B. Gutzko
J. Boettcher

Tie Check
July 19, 1971
K. Birch
J. Boettcher
B. Olson

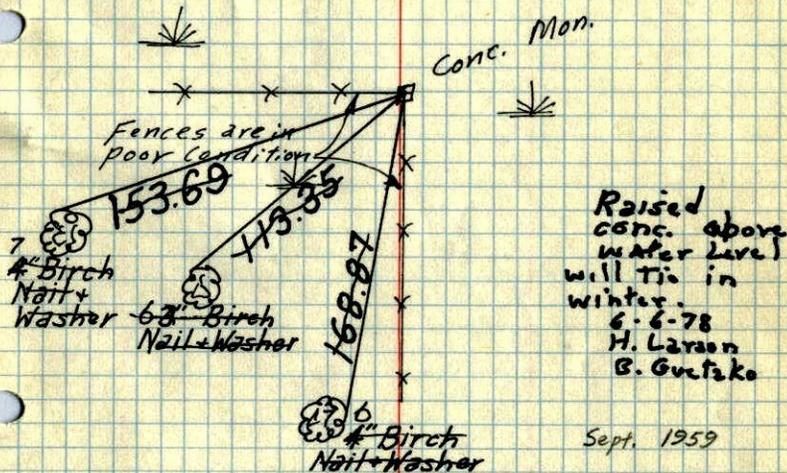

Raised conc. above
water level
will tie in
winter.
6-6-78
H. Larson
B. Gutzko

Sept. 1959

Tie Check
June 20, 1967
D. Potter
D. Powell

TEMPERATURE CORRECTED
AND HORIZONTALLY
TAPED MEASUREMENTS

ROLAND W. ANDERSON
COUNTY SURVEYOR
ANOKA COUNTY, MINNESOTA


X

D

3

E 1/4 Corr. Sec. 26, T34, R22

Concrete Monument, ~~up 0.5'~~
Down 0.3'

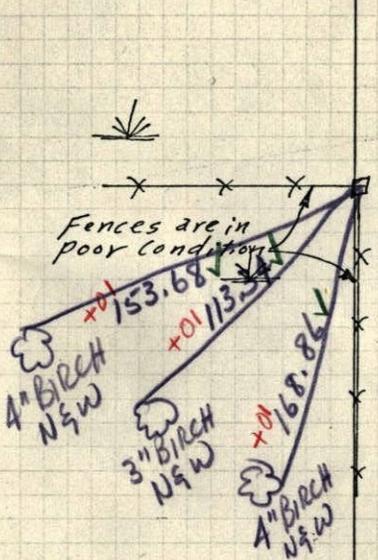

Fences are in poor condition

Conc. Mon.

6/20/67

D. POTTER
D. AWELL
78° F ✓
#7 ✓

Sept. 1959

TEMPERATURE CORRECTED
AND HORIZONTALLY
TAPED MEASUREMENTS

ROLAND W. ANDERSON
COUNTY SURVEYOR
ANOKA COUNTY, MINNESOTA