

CERTIFICATE OF LOCATION OF GOVERNMENT CORNER

County of Anoka

State of Minnesota


Southeast Corner of Sec. 26 Township 34 Range 22

On the 4th day of February, 1963, the described corner was evidenced by a cast iron monument with a 3/4" iron pipe to the north

and to perpetuate the location of said corner, at the exact location thereof, a permanent marker was placed consisting of the same cast iron monument

AND on the 10th day of September, 2012, said permanent marker was replaced with a cast iron monument after construction and the ties were updated

Updated reference ties are as shown below.

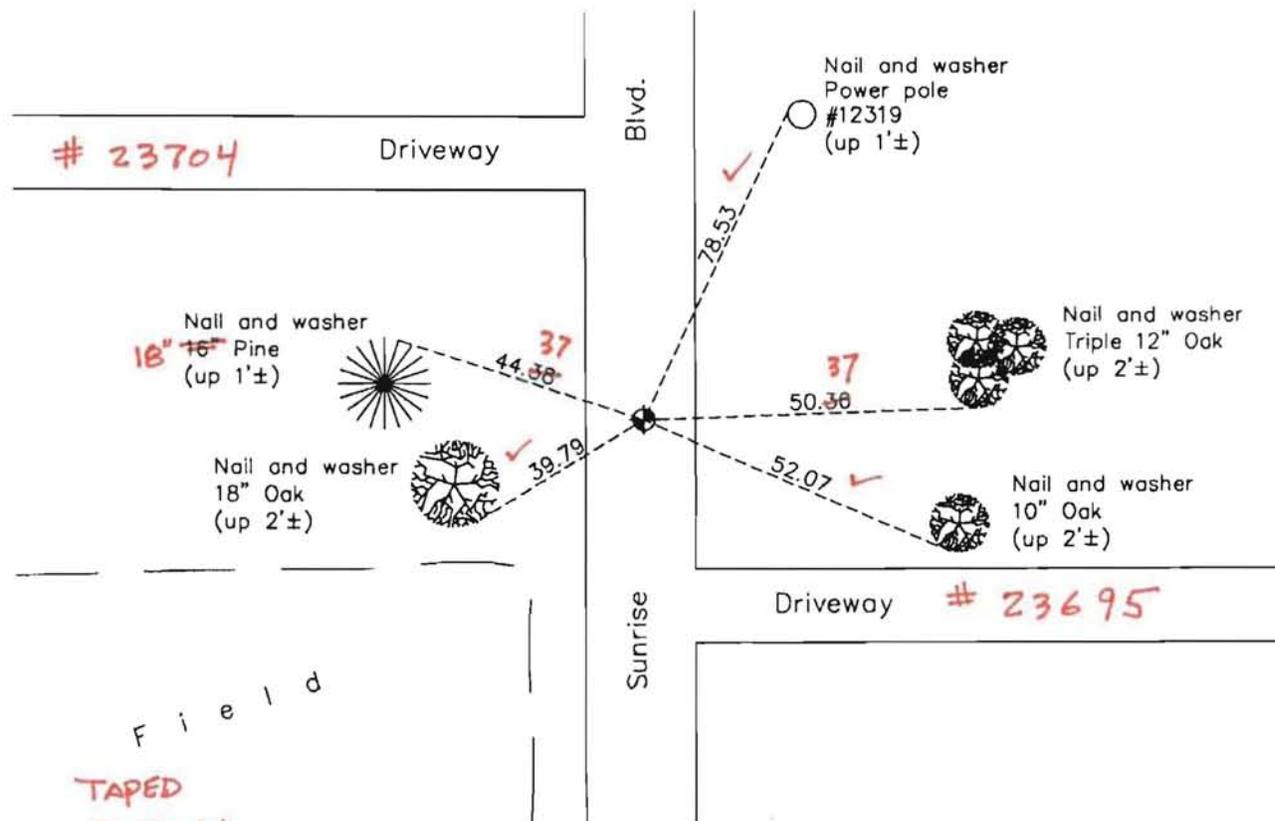

TAPED
2-13-14
JS SH

CIM GOOD COND.

Revision Date
12/18/13

N.A.D. 1983 Coordinates
(1996 Adjustment)

County Project Coordinates	
Northing	232183.6808
Easting	558339.1586
Date	6/03/03

I hereby certify that this United States public land survey monument record is correct and complete to the best of my knowledge and belief.

Date 12/18/13

Larry D. Hoiium, Anoka County Surveyor
 Minnesota License Number 18165

CERTIFICATE OF LOCATION OF GOVERNMENT CORNER

County of Anoka

State of Minnesota

Southeast Corner of Sec. 26 Township 34 Range 22


On the 4th day of February, 1963, the described corner was evidenced by a cast iron monument with a 3/4" iron pipe to the north

and to perpetuate the location of said corner, at the exact location thereof, a permanent marker was placed consisting of the same cast iron monument

AND on the ___ day of _____, _____, said permanent marker was _____

Updated reference ties are as shown below.

9-10-12 J.G. SH.
RESET C.I.M AFTER CONST.
RESWUNG TIES

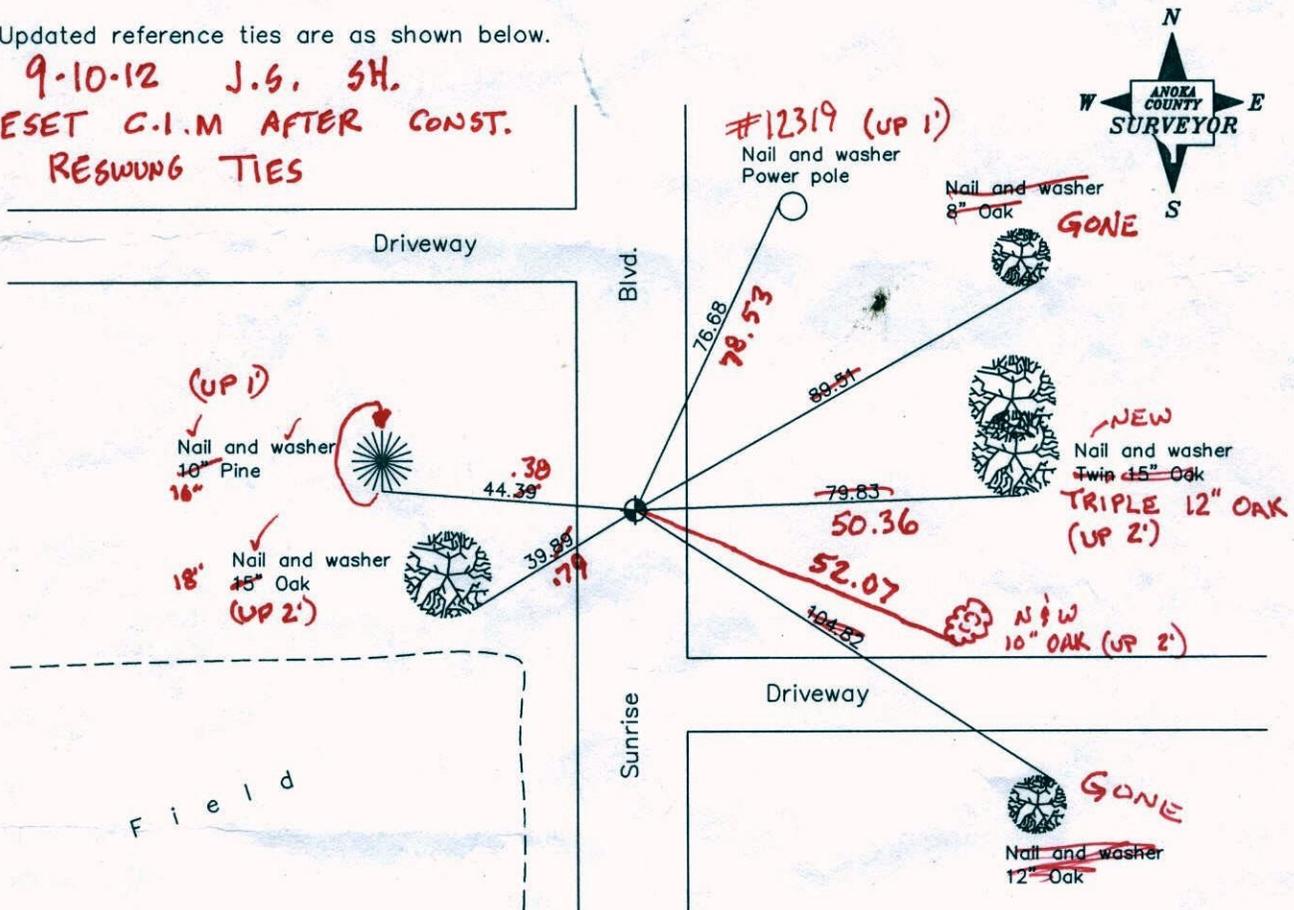

Revised date
6/14/93

N.A.D. 1983 Coordinates (1996 Adjustment)	
County Project Coordinates	
Northing	<u>232183.6808</u>
Easting	<u>558339.1586</u>
Date	<u>6/03/03</u>

I hereby certify that this United States public land survey monument record is correct and complete to the best of my knowledge and belief.

_____ Date _____


_____, Anoka County Surveyor

Minnesota License Number _____

S. 0.07
W. 0.05

SE COR SEC 26 34 22

RECLAIMED ROAD DURING CONST.
BROKE OFF MON. T/T FIN..

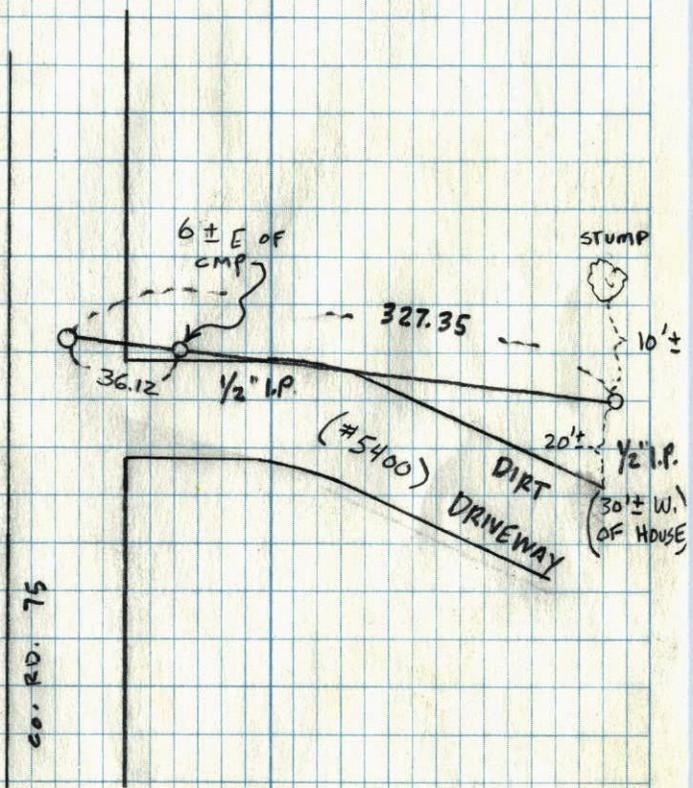

VRS FIN LOCATION:

3D, Q =

N:
E:

CERTIFICATE OF LOCATION OF GOVERNMENT CORNER

County of Anoka

State of Minnesota


Southeast Corner of Sec. 26 Township 34 Range 22

On the 4th day of February, 1963, the described corner was evidenced by a cast iron monument with a 3/4" iron pipe to the north

and to perpetuate the location of said corner, at the exact location thereof, a permanent marker was placed consisting of the same cast iron monument

AND on the ___ day of _____, _____, said permanent marker was _____

Updated reference ties are as shown below.

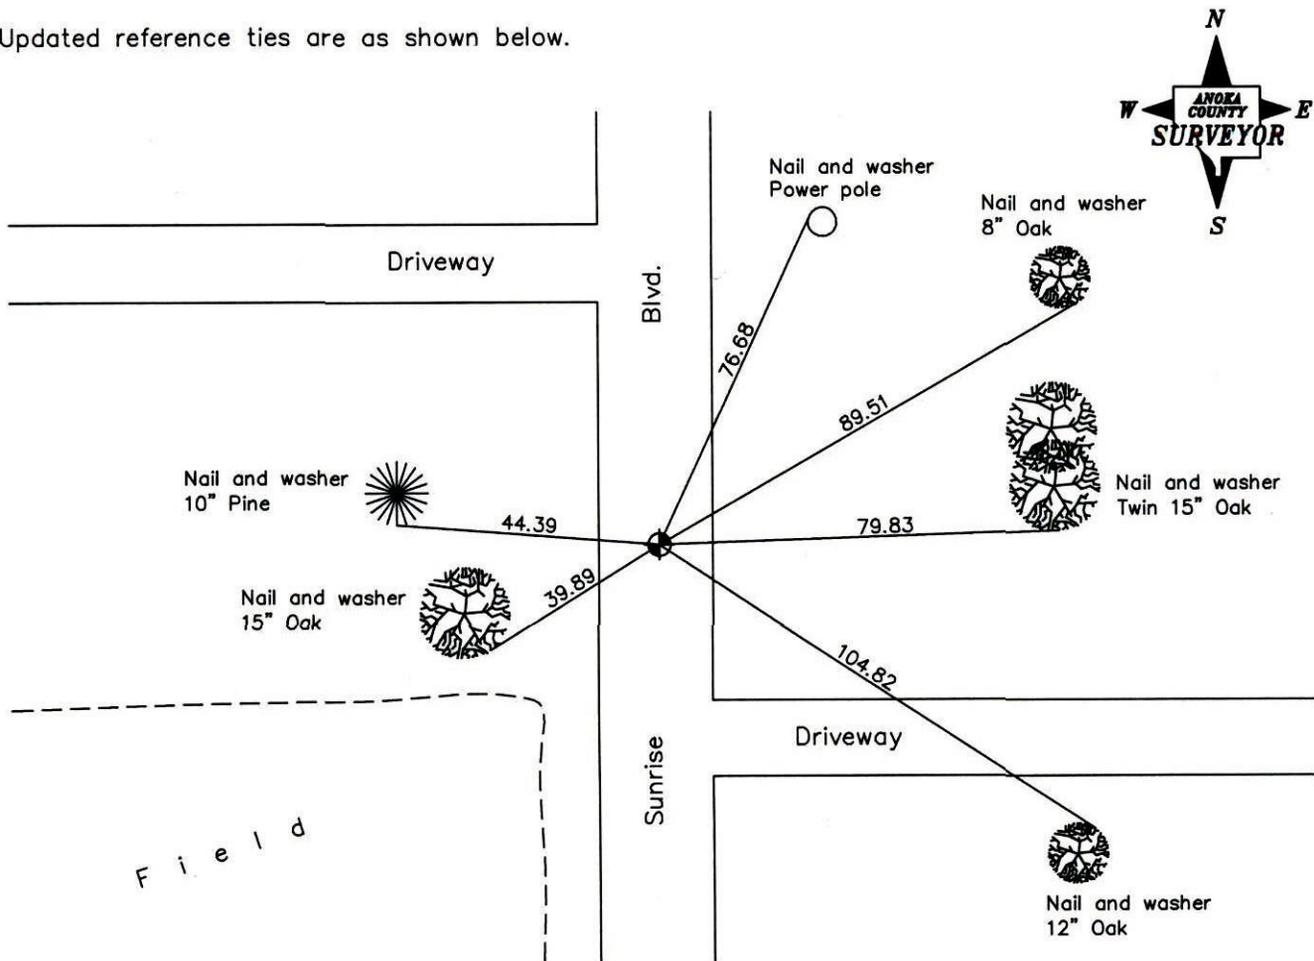

Revised date

6/14/93

N.A.D. 1983 Coordinates
(1996 Adjustment)

County Project Coordinates

Northing 232183.6808

Easting 558339.1586

Date 6/03/03

I hereby certify that this United States public land survey monument record is correct and complete to the best of my knowledge and belief.

_____ Date _____

_____, Anoka County Surveyor

Minnesota License Number _____

CERTIFICATE OF LOCATION OF GOVERNMENT CORNER

County of Anoka


State of Minnesota

SOUTHEAST Corner of Sec. 26 Township 34 Range 22


I hereby certify that on the 4 day of FEB., 1963, I found the described corner which was evidenced by CAST IRON WITH 3/4" I.P. TO NORTH

and I further certify that to perpetuate the location of said corner, I did, at the exact location thereof, place a permanent marker consisting of CAST IRON

which reference or witness monuments are located in the manner following:

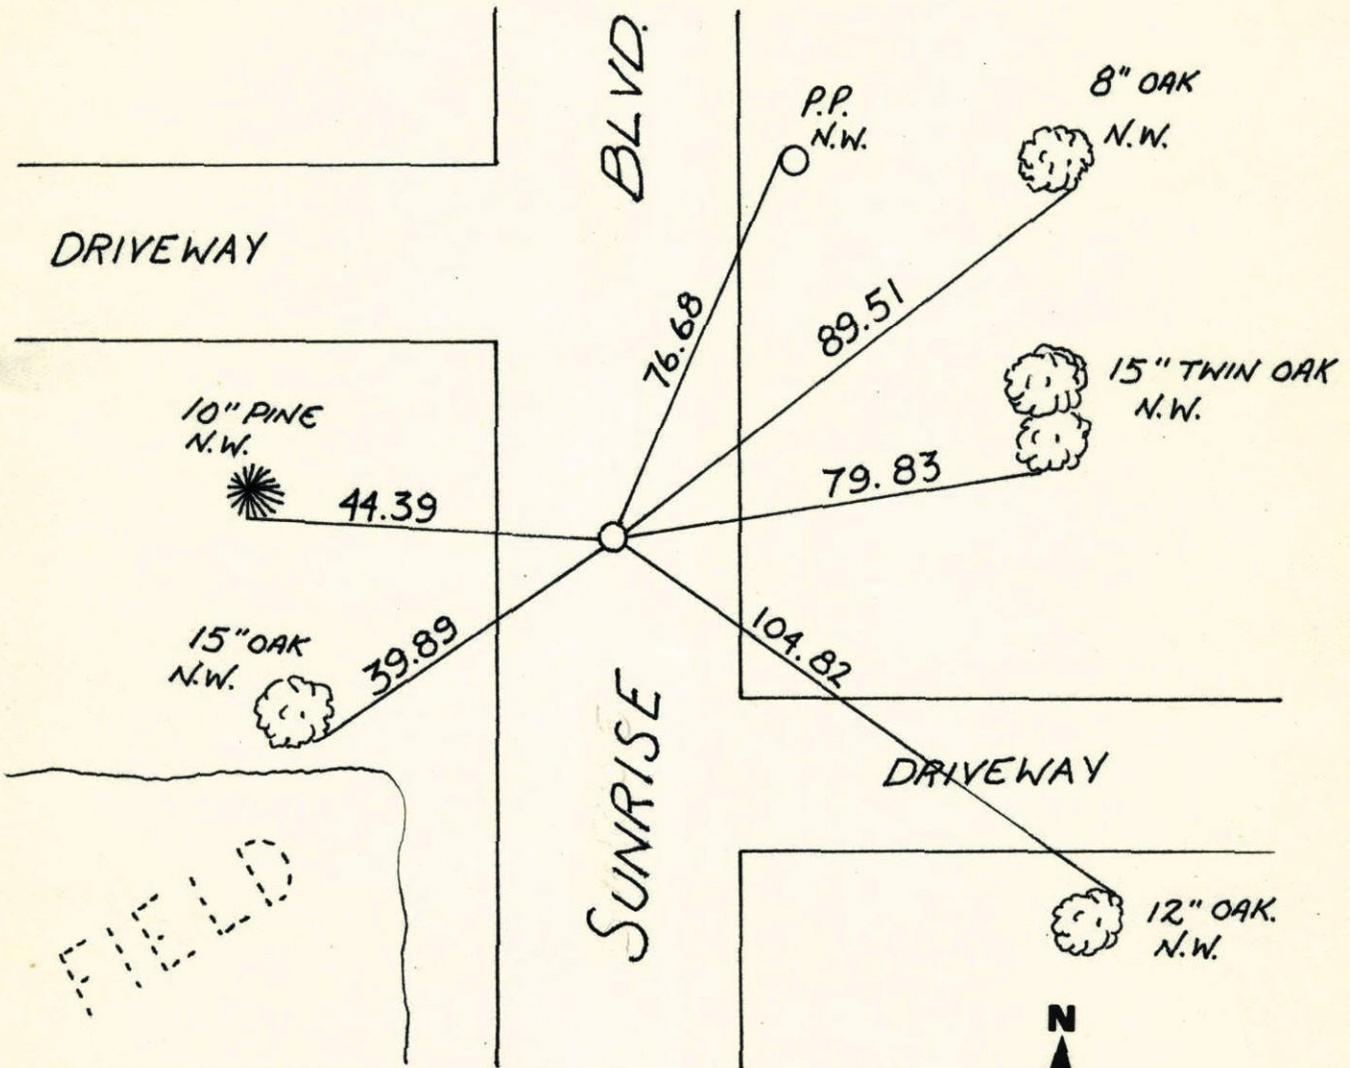


Revised date	Revised date	Revised date
6-14-93		

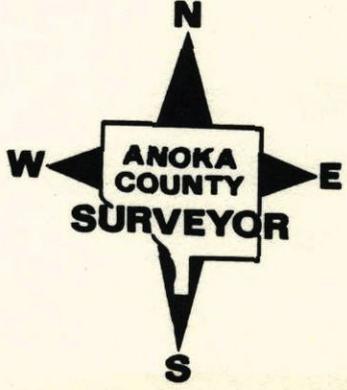

Pg. 24

Southeast Corner Sec 26 T34
 Retic Cast IRON MON. R22

DRIVEWAY

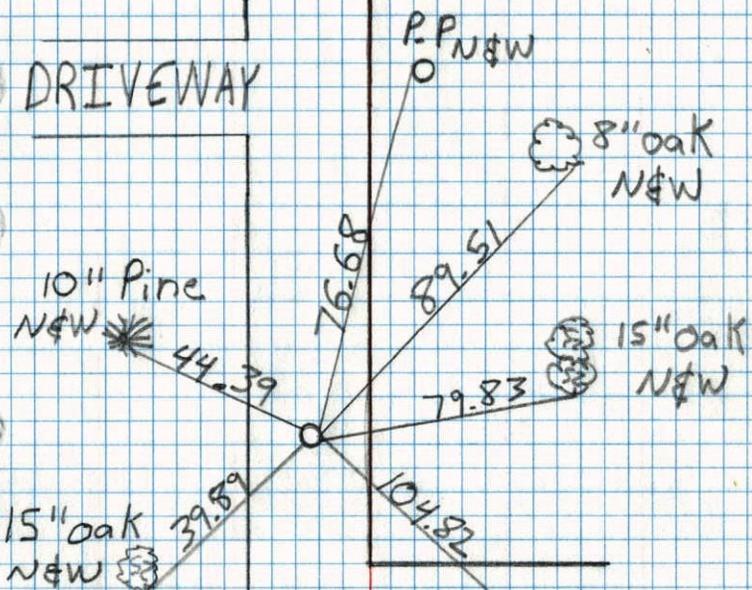

DRIVEWAY

FIELD


6-14-93
 Jayme Anderson
 Josh Anderson

SE CORNER SEC. 26 T34 R22

NON-MAGNETIC CAST IRON MONUMENT
 IN PLACE WITH 3/4" IRON PIPE ON
 NORTH SIDE.
 CAST IRON SET BY N.C. HOIUM

** LINE OF
 ** 2" PIPES

DRIVEWAY

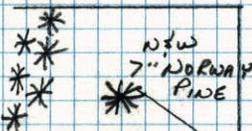

DRIVEWAY

FIELD


FEB 2, 1987
 BOB GUETZKO
 HARRY GRAMS

SE Cor Sec 26-T34-R22

Cast Iron Monument (non-magnetic)
with 3/4 inch iron pipe on North side
Down 0.3' Set by N.C. Hoium

Feb. 4, 1963

J.O. Oliver
M.D. Anderson

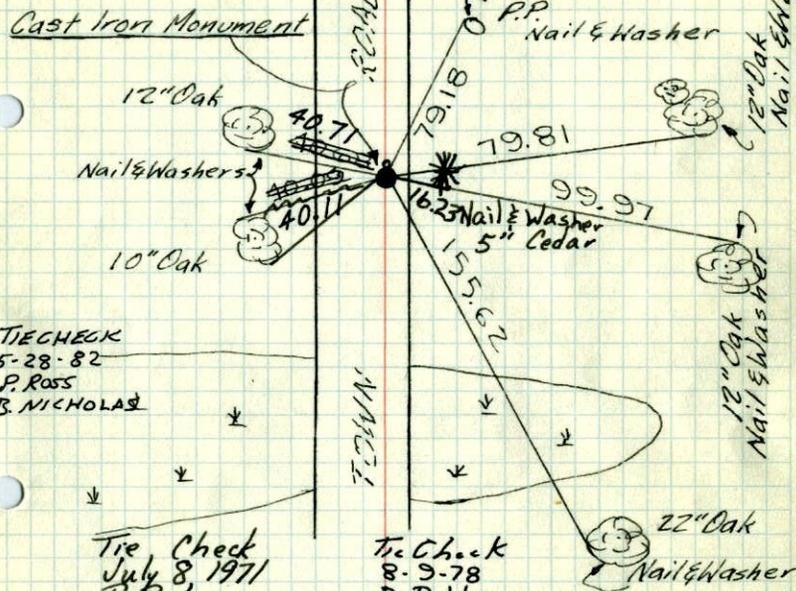

Tie Check
July 8, 1971
R. Brien
J. Boettcher
B. Olson

ROLAND L. OLIVERSON
COUNTY SURVEYOR
'ANOKA COUNTY, MINNESOTA'

TEMPERATURE CORRECTED
AND HORIZONTALLY
TAPED MEASUREMENTS

Tie Check
June 20, 1967
D. Potter
D. Powell


TIE CHECK
8-4-75
D. DAHL
B. SANNERUD
G. HOAMS

SE Cor Sec 26-T34-R22

Cast Iron Monument (non-magnetic)
with 3/4 inch iron pipe on North side
Down 0.3' Set by N.C. Hoium

Feb. 4, 1963

J.O. Oliver
M.D. Anderson

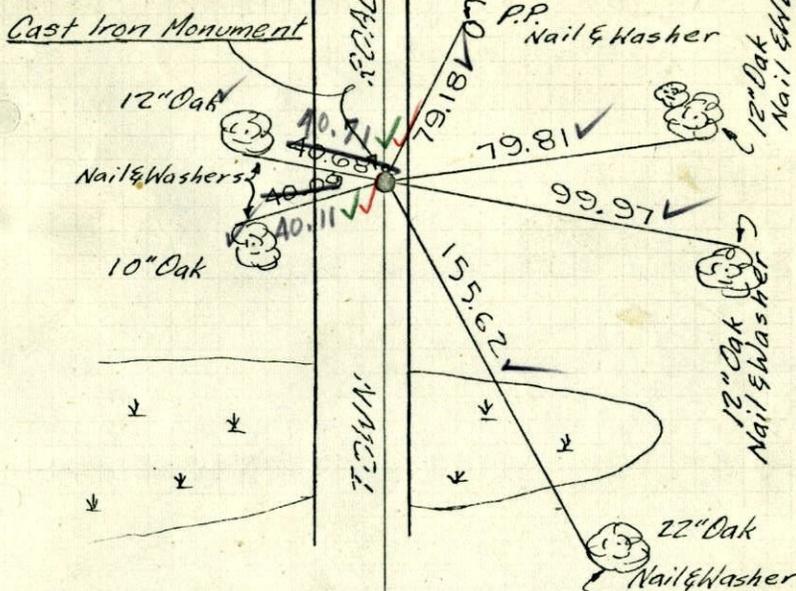

6/20/67
D. POTTER
D. POWELL
#7-80°F ✓


ROLAND L. OLIVERSON
COUNTY SURVEYOR
'ANOKA COUNTY, MINNESOTA'

TEMPERATURE CORRECTED
AND HORIZONTALLY
TAPED MEASUREMENTS

SE Cor. Sec. 26, T34, R22

C.I. Mon. down 0.3' with 3/4" I.P. on

No. Side

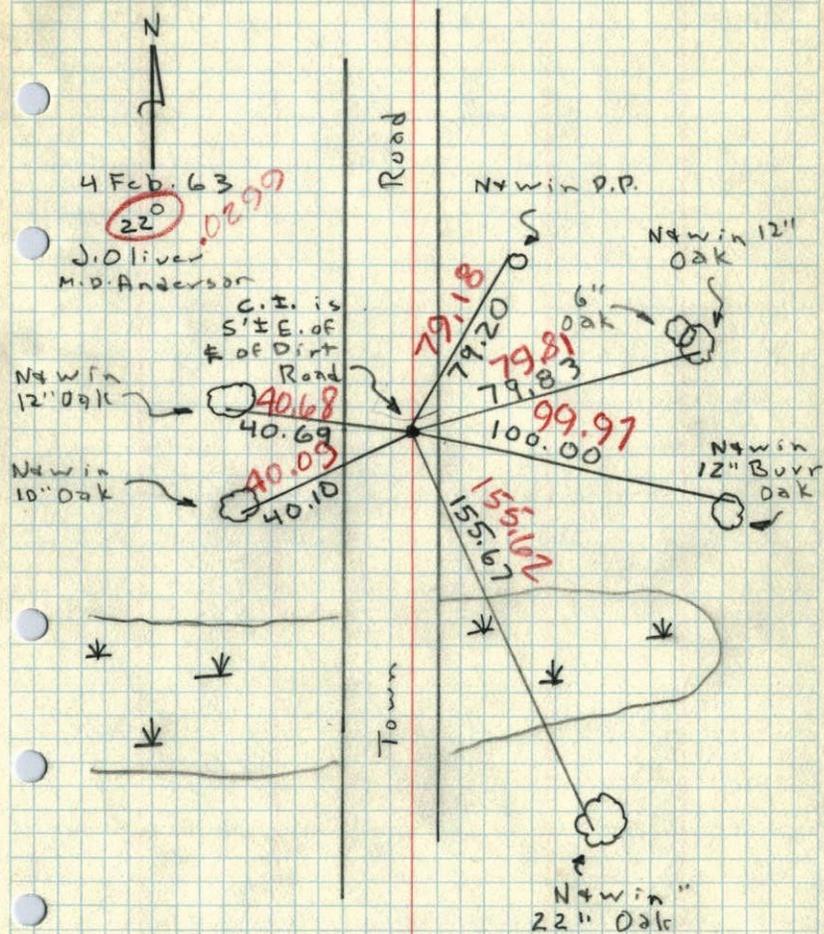


SE Sec 26 T34 R22

Cast Iron Mon.

(County Surveyor)

6/17/59

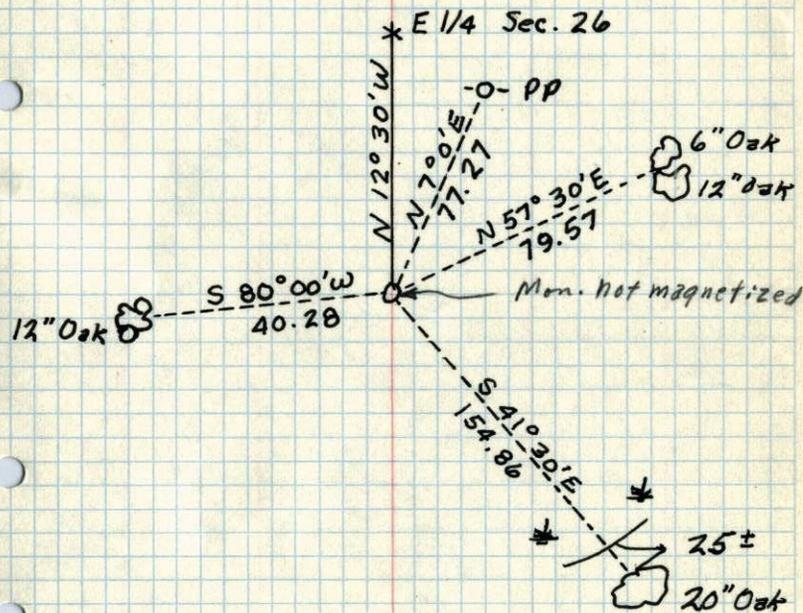


26	25
35	36

SE Cor Sec 26-34-22

6/17/59 R.C. SCHULTZ-R.H. SCHULTZ

CAST IRON MON.
(COUNTY SURVEYOR)

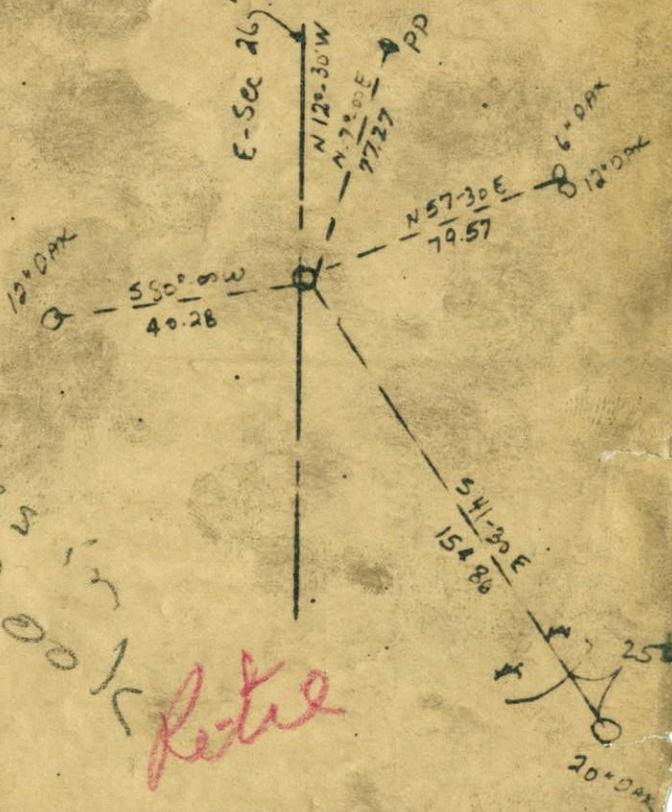

Ties in Book
Retire

N. C. HOIUM
AND ASSOCIATES, INC.
LAND SURVEYORS

ANOKA, MINNESOTA