

CERTIFICATE OF LOCATION OF GOVERNMENT CORNER

County of Anoka

State of Minnesota

South 1/4 Corner of Sec. 27 Township 34 Range 22

On the 16th day of March, 1967, the described corner was evidenced by area resurvey


and to perpetuate the location of said corner, at the exact location thereof, a permanent marker was placed consisting of a cast iron monument with a sign and post on the north side

(UP 0.1)

AND on the ___ day of _____, _____, said permanent marker was _____

Updated reference ties are as shown below.

1/17/14
JS BK SH
TIED OUT CIM.

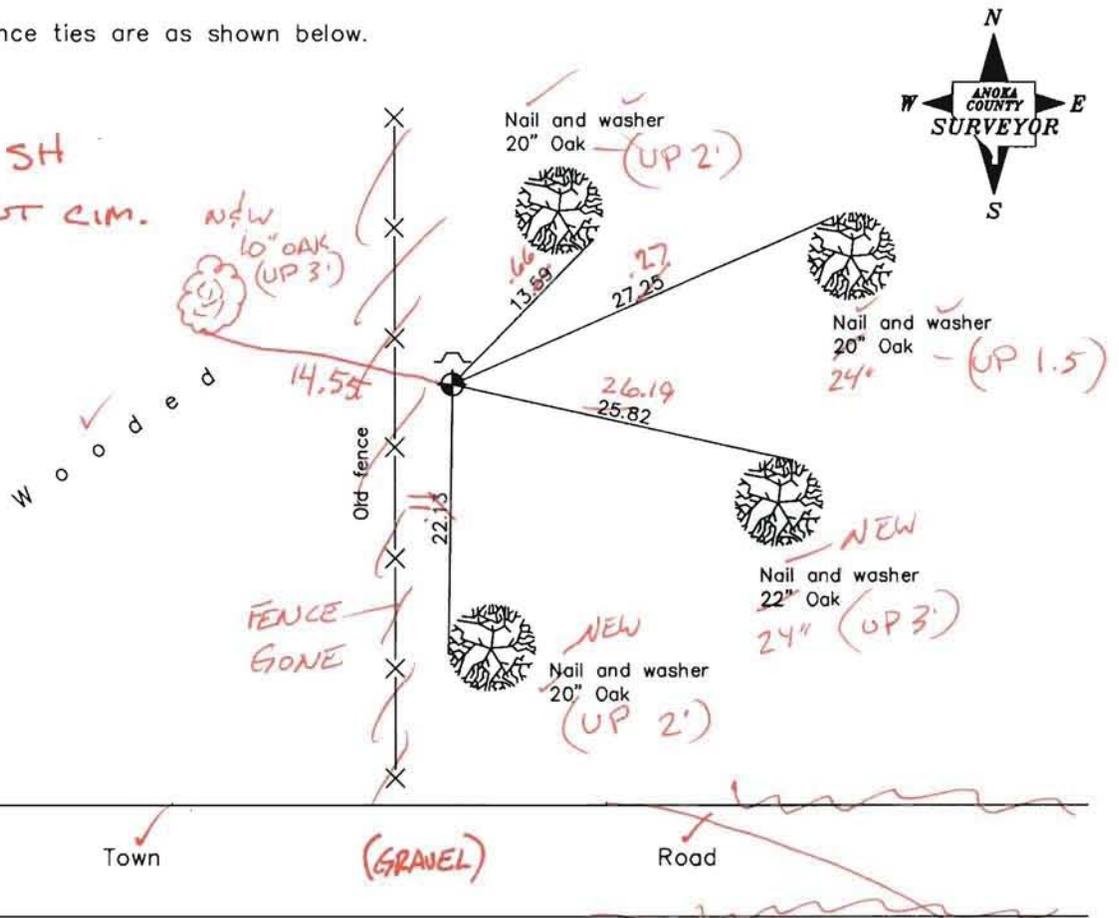

Revised date	6/21/93

N.A.D. 1983 Coordinates (1996 Adjustment)	
County Project Coordinates	
Northing	<u>232423.6387</u>
Easting	<u>550403.5261</u>
Date	<u>1/29/04</u>

I hereby certify that this United States public land survey monument record is correct and complete to the best of my knowledge and belief.

_____ Date _____

_____, Anoka County Surveyor

Minnesota License Number _____

CERTIFICATE OF LOCATION OF GOVERNMENT CORNER

County of Anoka


State of Minnesota

SOUTH 1/4 Corner of Sec. 27 Township 34 Range 22


I hereby certify that on the 16 day of MARCH, 1967, I found the described corner which was evidenced by AREA RESURVEY

and I further certify that to perpetuate the location of said corner, I did, at the exact location thereof, place a permanent marker consisting of CAST IRON MONUMENT SIGN AND POST ON NORTH SIDE

which reference or witness monuments are located in the manner following:

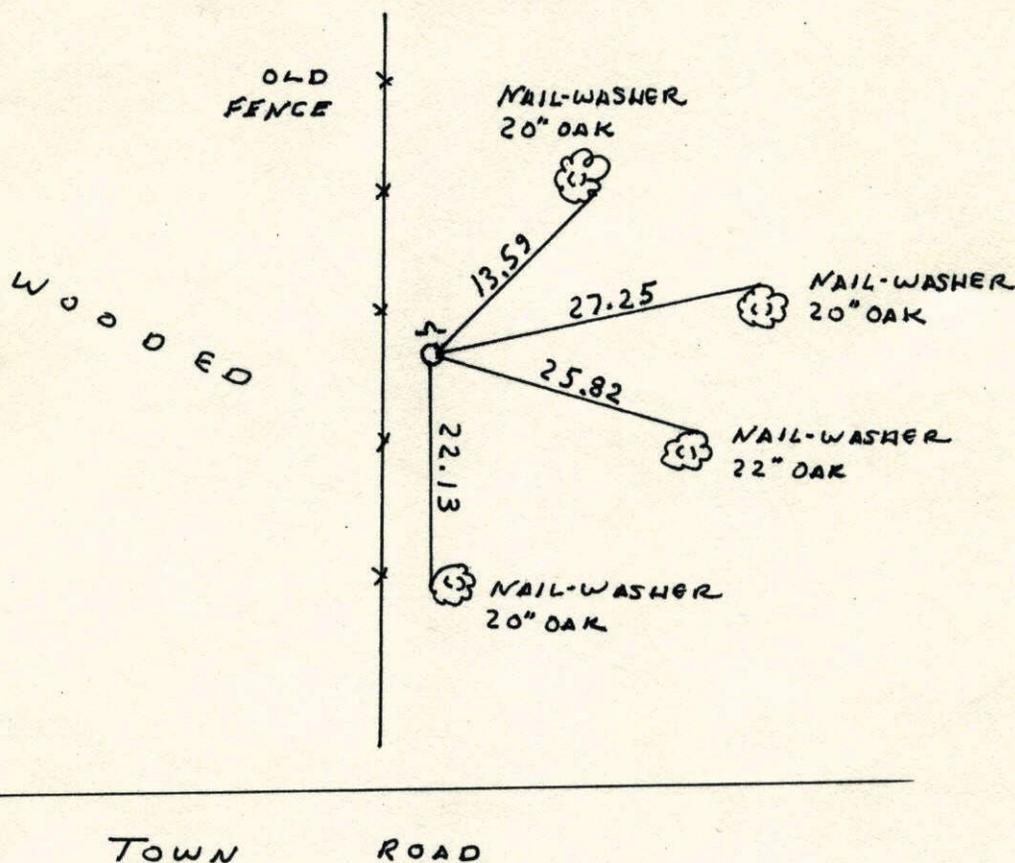

Revised date	Revised date	Revised date
6-21-93		

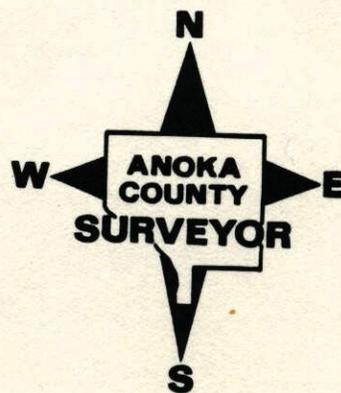

S 1/4 COR. SECTION 27 T34 R22

RETIRED CAST IRON SIGN & POST ON


NORTH SIDE

6-21-93

M.S.

JA

JA

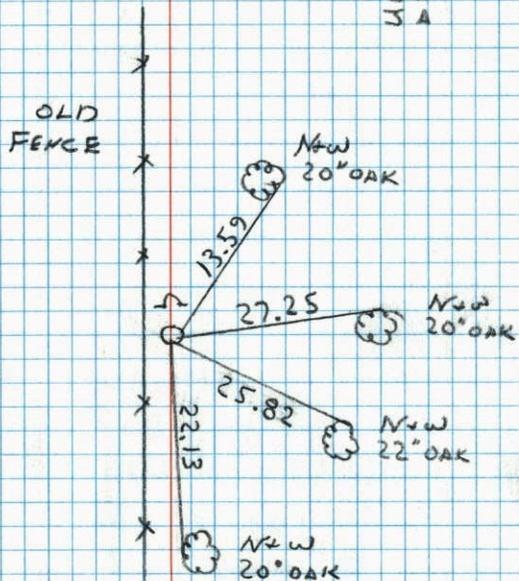


TOWN ROAD

S 1/4 Cor Sec. 27-T34-R22

Set cast iron mon. Flash under fence.

Up 0.2'

Set cor. from area resurvey

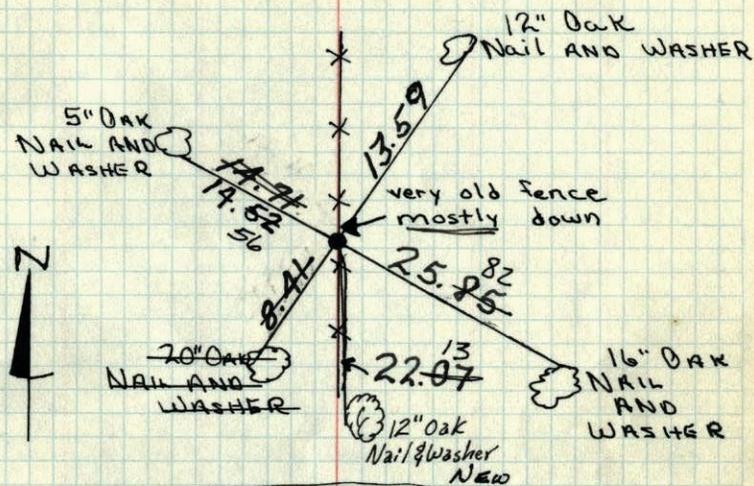

TOWN ROAD


To Check
8-10-78
D. Dahl
M. Kisrow
B. Stephens

MARCH 16, 1967

M.D. ANDERSON
D. h. Potter200
TAPE #7TIE CHECK
8-4-75D. DAHL
B. SPANBERG
S. ADAMSTIE CHECK
6-1-82
P. ROSS
D. NICHOLASTie Check
June 21, 1967
D. Potter
D. PowellTie Check
July 8, 1971
R. Briegleb
J. Boettcher
B. OlsonTEMPERATURE CORRECTED
AND HORIZONTALLY
TAPED MEASUREMENTSROLAND W. ANDERSON
COUNTY SURVEYOR
ANOKA COUNTY, MINNESOTA

S 1/4 Cor. Sec. 27-T34-R22

Set Cast Iron Mon. Flush under fence
Set cor. from area resurvey

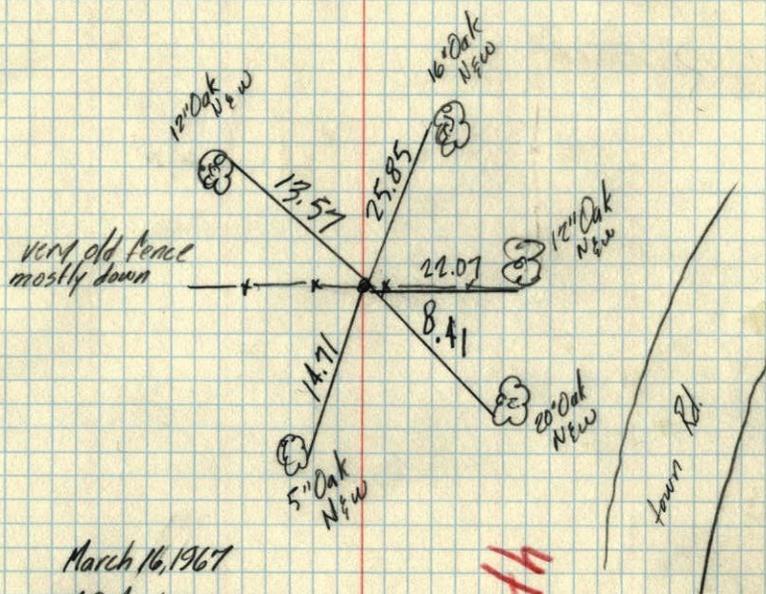

March 16, 1967

M.D. Anderson
D.L. Potter

20°
#7




Change North

X D

S 1/4 Cor Sec. 27-T34-R22

Set cast iron mon. Flush under fence.
Set cor. from area resurvey

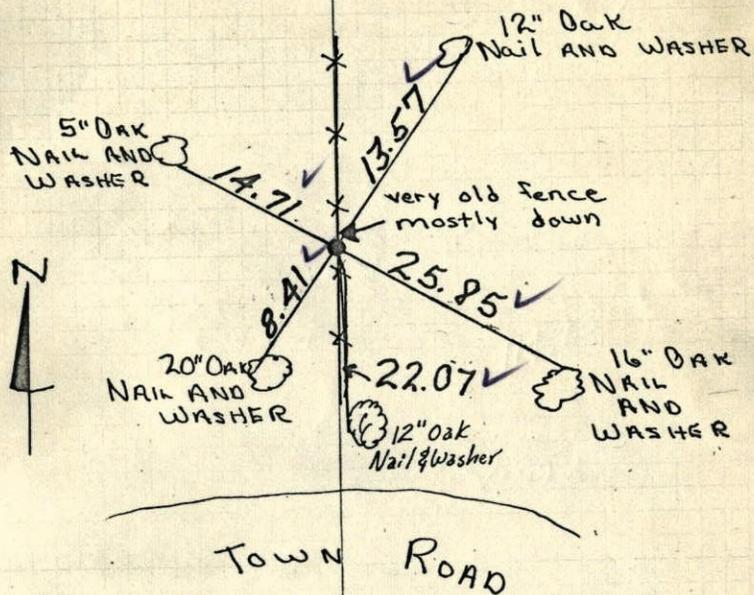

MARCH 16, 1967

M.D. ANDERSON
D.L. POTTER

20°
TAPE #7

6/21/67

D. POTTER
D. POWELL

TEMPERATURE CORRECTED
AND HORIZONTALLY
TAPED MEASUREMENTS

ROLAND W. ANDERSON
COUNTY SURVEYOR
ANOKA COUNTY, MINNESOTA