

CERTIFICATE OF LOCATION OF GOVERNMENT CORNER

County of Anoka State of Minnesota


Southeast Corner of Sec. 28 Township 34 Range 22

On the 16th day of March, 1967, the described corner was evidenced by area resurvey

and to perpetuate the location of said corner, at the exact location thereof, a permanent marker was placed consisting of a cast iron monument

AND on the 10th day of June, 2004, said permanent marker was found and the ties were updated

Updated reference ties are as shown below.

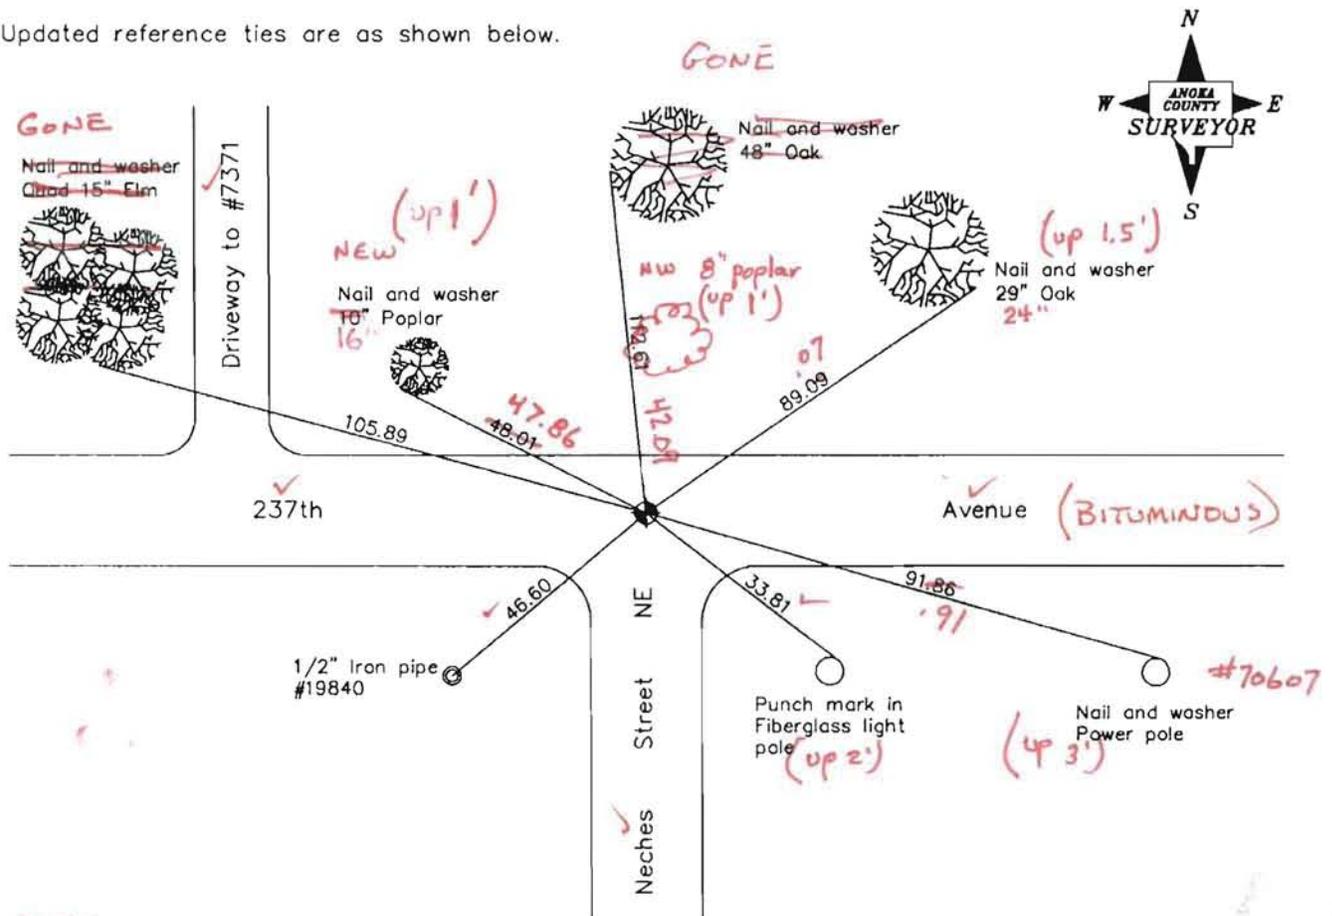

2-13-14
JS SH GOOD COND.

Revised date

6/16/93
7/14/99
6/10/04

N.A.D. 1983 Coordinates
(1996 Adjustment)

County Project Coordinates	
Northing	<u>232530.0602</u>
Easting	<u>547736.7064</u>
Date	<u>6/04/03</u>

I hereby certify that this United States public land survey monument record is correct and complete to the best of my knowledge and belief.

Larry D. Hoium Date 6/10/04
 Larry D. Hoium, Anoka County Surveyor
 Minnesota License Number 18165

VRS COORDS

3DR: 0.05

N: 232530.0984
 E 547736.7032

CERTIFICATE OF LOCATION OF GOVERNMENT CORNER

County of Anoka


State of Minnesota

SOUTHEAST Corner of Sec. 28 Township 34 Range 22


I hereby certify that on the 16TH day of MARCH, 1967, I found the described corner which was evidenced by AREA RESURVEY

and I further certify that to perpetuate the location of said corner, I did, at the exact location thereof, place a permanent marker consisting of CAST IRON MON.

which reference or witness monuments are located in the manner following:

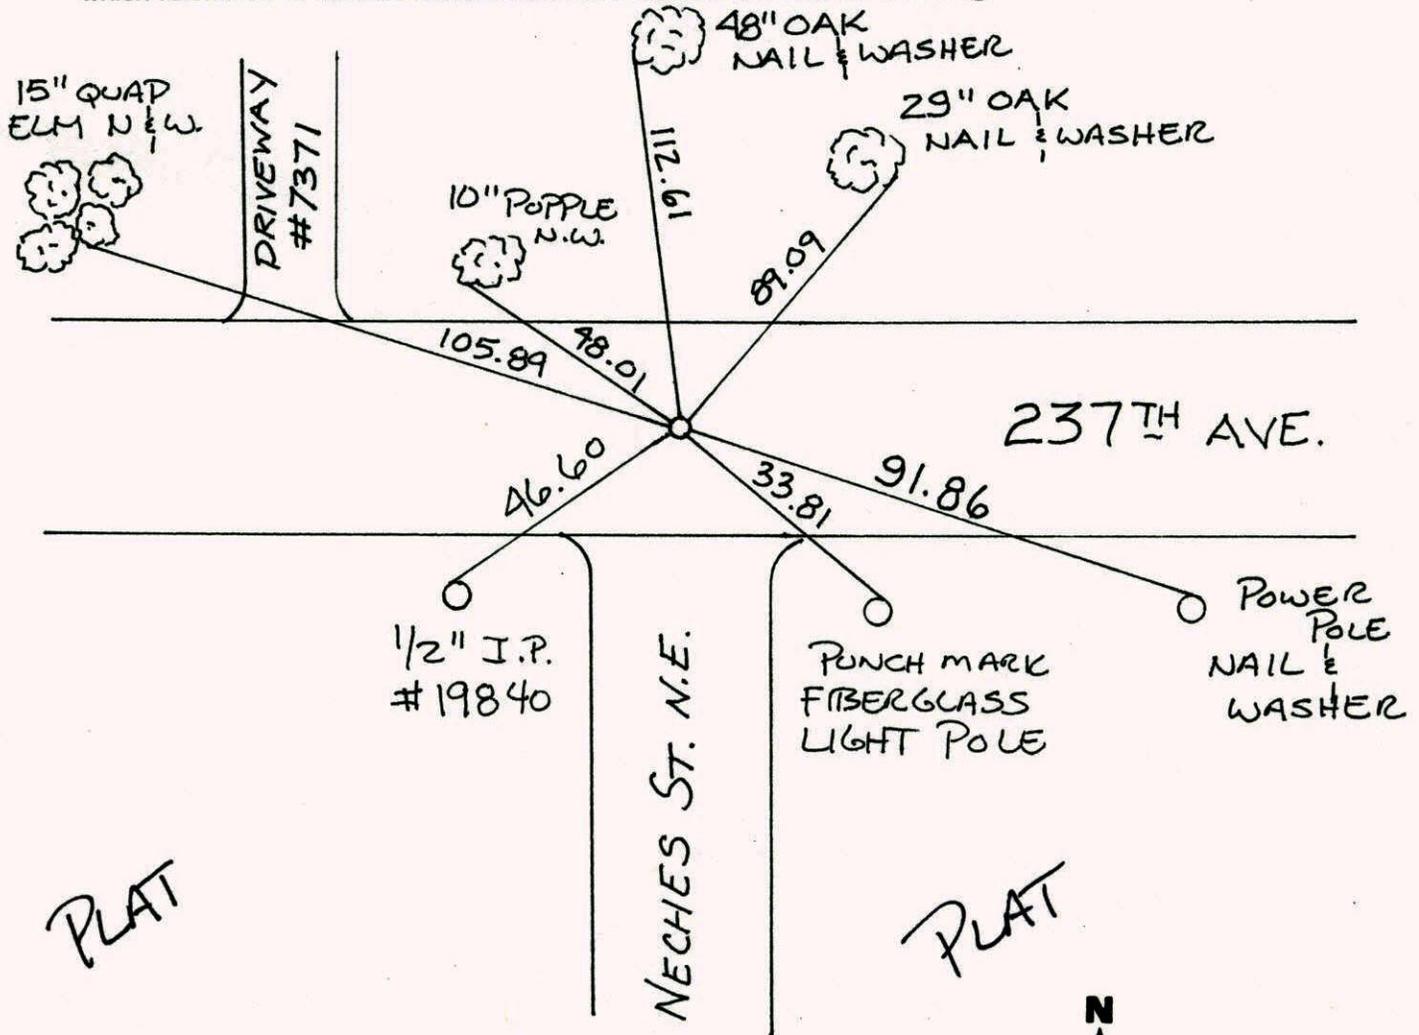


Revised date	Revised date	Revised date
12-9-88		
6-16-93		
7-14-99		
6-10-04		

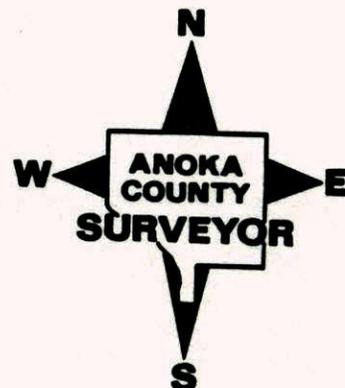

SOUTHEAST COR. SEC. 28, T. 34, R. 22

MONUMENT RAISED AND RETIED

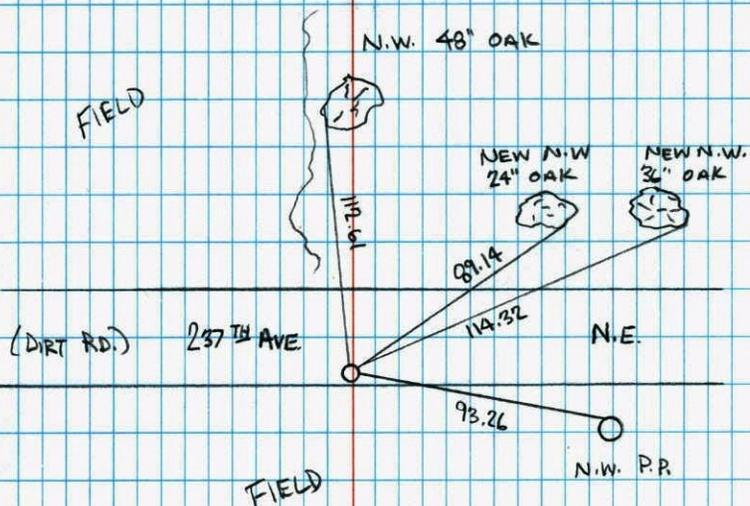

9-14-99


J. SIMMER
T. SCHWAB



S.E. CORNER SECTION 28-T34-R22

SET CAST IRON MONUMENT DOWN 0.4' FROM AREA RESURVEY.

16 MAR 67
M.D. ANDERSON
O.L. POTTER

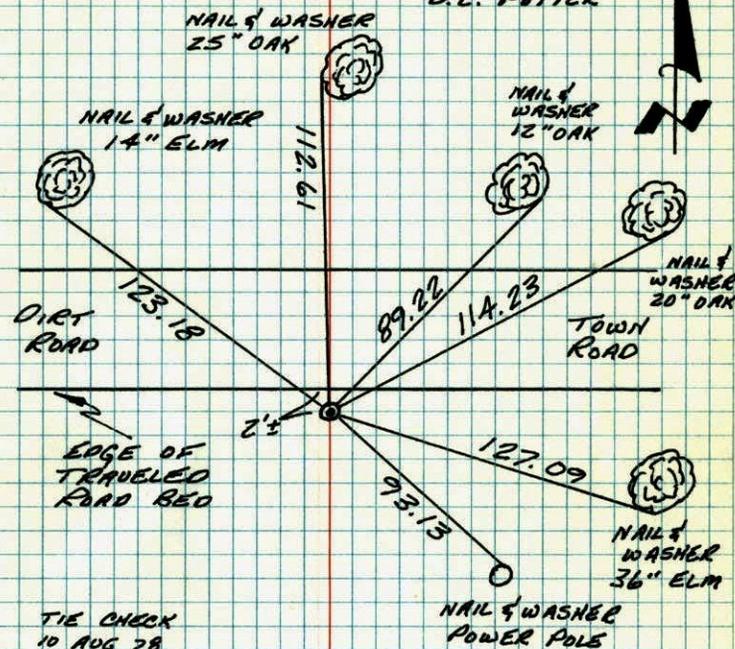

TIE CHECK
10 AUG 78
D. DAHL
M. KISROW
B. STEPHENS

TIE CHECK
6-1-82
P. ROSS
B. NICHOLBS

TEMPERATURE CORRECTED
AND HORIZONTALLY
TAPED MEASUREMENTS


ROLAND W. ANDERSON
COUNTY SURVEYOR
ANOKA COUNTY, MINNESOTA

SE Cor. SEC. 28-T34-R-22

Set C.I. mon. down 0.4'±

Set cor. from area resurvey

MARCH 16, 1967

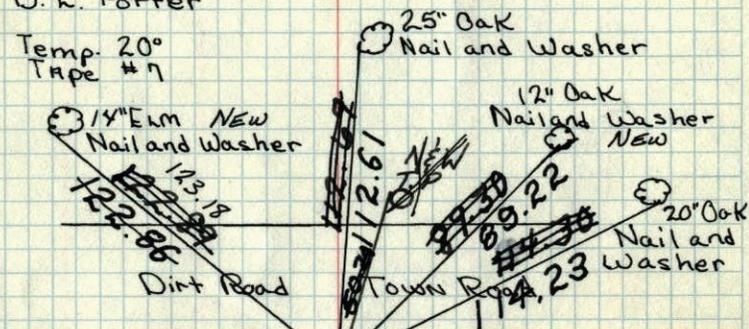
Reset Cast Iron From TIES
JUNE 30, 1976 H. LarsonM. D. Anderson
D. h. PotterTemp. 20°
Tape #7edge of traveled
road bedTie Check
June 21, 1967
D. Potter
D. PowellTie Check
July 8, 1971R. Brien,
J. Boettcher
B. OlsonSEE NEW
TIE BOOK21'
127.09
99.03
93.13
36" Elm
Nails
Washer
Telephone Pole
NEWTIE CHECK
8-4-75
D. Dahl
G. Spangrud
G. Adams
3
Tie Check
8-10-78
D. Dahl
M. Kisrow
B. StephensTEMPERATURE CORRECTED AND HORIZONTALLY
TAPED MEASUREMENTS ROLAND W. ANDERSON
COUNTY SURVEYOR
ANOKA COUNTY, MINNESOTA

SE Cor. SEC. 28-T34-R-22

Set C.I. mon. down 0.4'±

Set cor. from area resurvey

MARCH 16, 1967

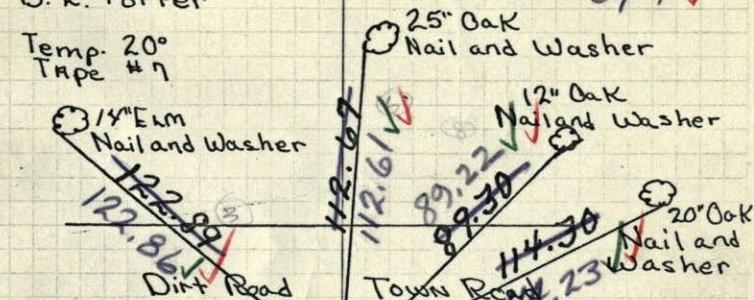
M. D. Anderson
D. h. PotterTemp. 20°
Tape #7edge of traveled
road bed127.14
127.09
36" Elm
Nails
WasherTEMPERATURE CORRECTED AND HORIZONTALLY
TAPED MEASUREMENTS ROLAND W. ANDERSON
COUNTY SURVEYOR
ANOKA COUNTY, MINNESOTA

X D

S.E. Cor. Sec 28-T 34-R22

Set C.I. Mon. down 0.4'±

Set Cor. from area resurvey

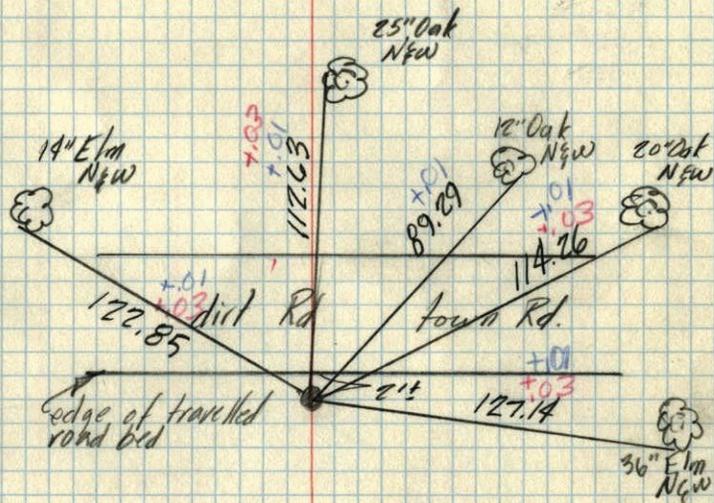

March 16, 1967

M.D. Anderson
D.L. Patter

temp. 20°
tape #7