

# CERTIFICATE OF LOCATION OF GOVERNMENT CORNER

County of Anoka                      State of Minnesota


## South 1/4 Corner of Sec. 28 Township 34 Range 22

On the 28th day of March, 1966, the described corner was evidenced by a 1" X 5' square steel rod

and to perpetuate the location of said corner, at the exact location thereof, a permanent marker was placed consisting of a cast iron monument

AND on the 9th day of August, 2005, said permanent marker was found and the ties were updated

Updated reference ties are as shown below.

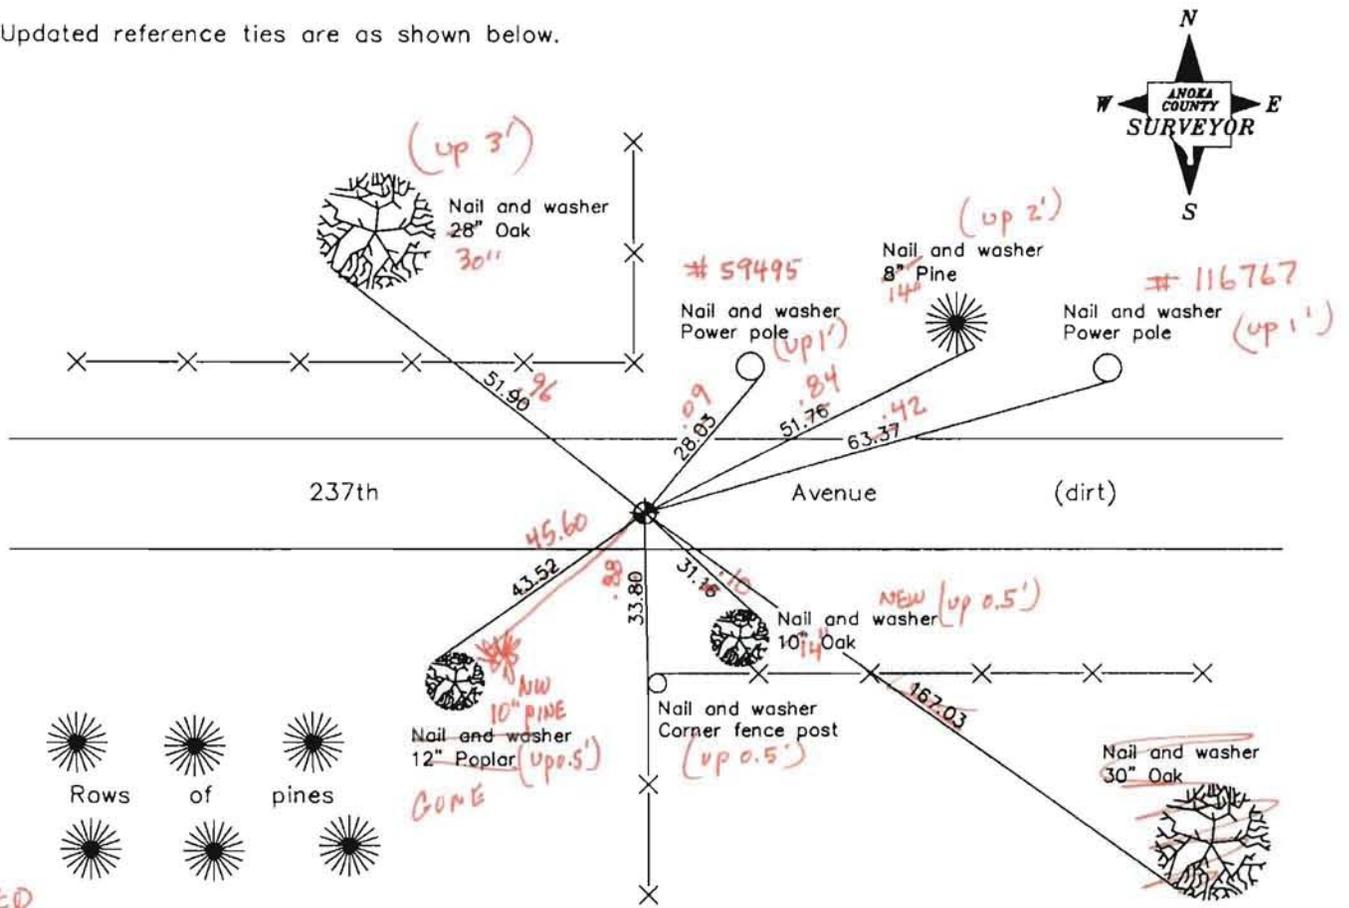

TAPED

2-13-14  
JS SH

CIM GOOD SHAPE

Revised date

7/05/86
6/16/93
8/09/05

N.A.D. 1983 Coordinates  
(1996 Adjustment)

County Project Coordinates	
Northing	<u>232634.4398</u>
Easting	<u>545109.4982</u>
Date	<u>6/09/03</u>

I hereby certify that this United States public land survey monument record is correct and complete to the best of my knowledge and belief.

*Larry D. Hoium*                      Date 8/09/05

\_\_\_\_\_  
Larry D. Hoium, Anoka County Surveyor

Minnesota License Number 18165

VRS

3DQ=0.07

N: 232634.3073  
E: 545109.4530

# CERTIFICATE OF LOCATION OF GOVERNMENT CORNER

County of Anoka


State of Minnesota

SOUTH 1/4 Corner of Sec. 28 Township 34 Range 22


I hereby certify that on the 28 day of MARCH, 1966, I found the described corner which was evidenced by 1" x 5' SQUARE STEEL ROD

and I further certify that to perpetuate the location of said corner, I did, at the exact location thereof, place a permanent marker consisting of CAST IRON MONUMENT

which reference or witness monuments are located in the manner following:

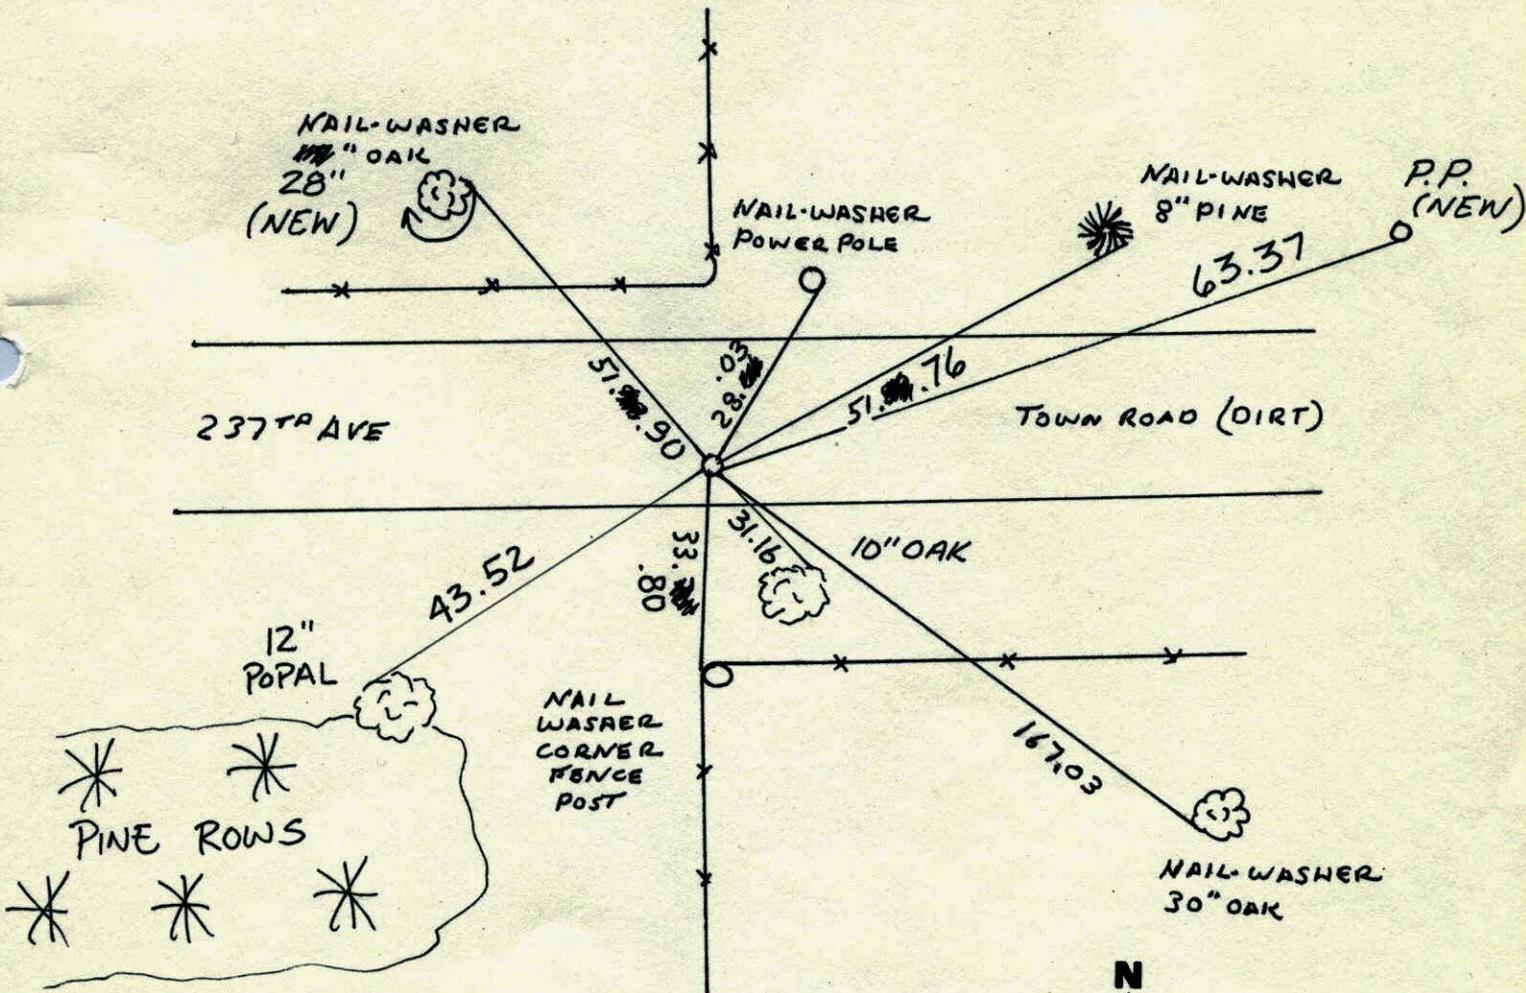


Revised date	Revised date	Revised date
7-5-86		
6-16-93		
8-9-05		

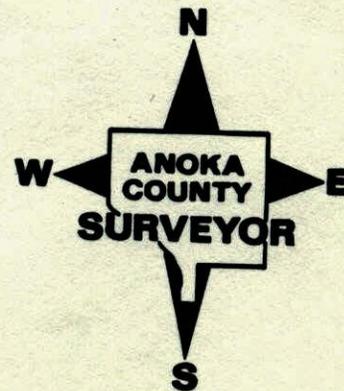

S 1/4 CORNER SEC 28 T34 R22

RETIED CAST IRON MONI

6-16-93

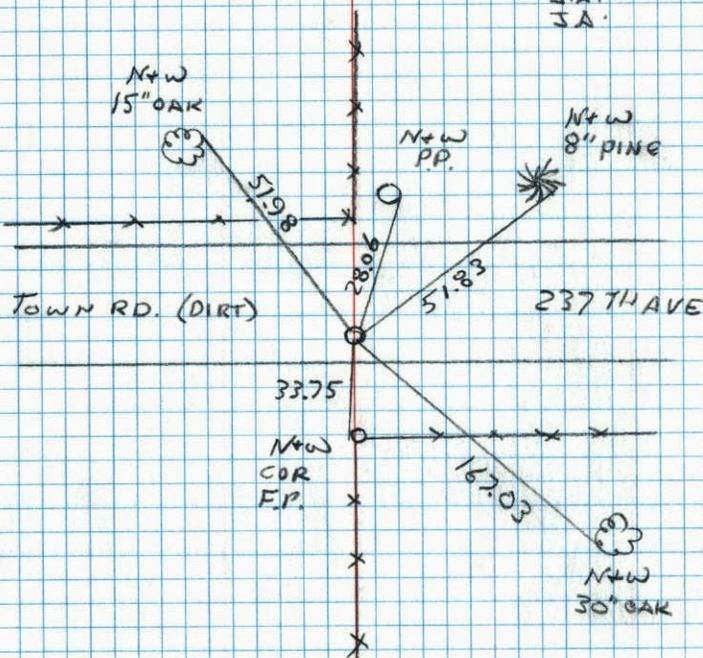J.A.  
J.A.


NO. 448

TELEPHONE

S 1/4 Cor Sec 28 T34 R22

Found 1" sq by 5" steel rod. Could find no store as claimed by area resident to be at corner however road is in cut of 2' top and rod could easily have been set to replace stone

Replaced rod with 3/4" of 2" Iron pipe corner is 2' East of fence lines running N+S.

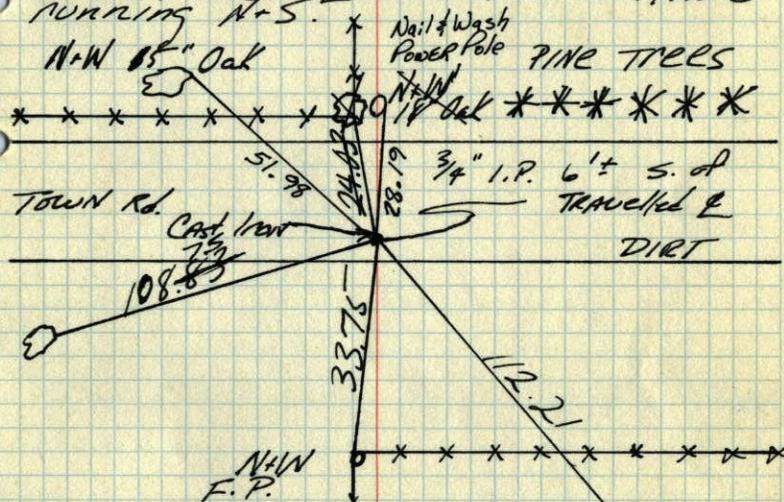

Set Cast Iron Mon. down 10"

Ties Checked  
July 8, 1971

R. Brien  
J. Boettcher  
B. Olson

TIE CHECK  
8-4-75  
D. Dahl  
B. Sannerud  
G. Adams

Tie Check  
8-10-78  
D. Dahl  
M. Kisraw  
B. Stephens

TIE CHECK  
6-1-82  
P. Ross  
B. Nicholas


TEMPERATURE CORRECTED  
AND HORIZONTALLY  
TAPED MEASUREMENTS

ROLAND W. ANDERSON  
COUNTY SURVEYOR  
ANOKA COUNTY, MINNESOTA

### 5/4 Cor Sec 28 T34 R22

Found 1" sq. by 5" steel rod. could find no stone as claimed. by area resident to be at corner, however road is in cut of 2' to 4' and rod could easily have been set to replace stone.  
 Replaced rod with 3/4" x 2' iron pipe down 6".

Mar. 28, 1966  
 J. Oliver  
 H. Larson

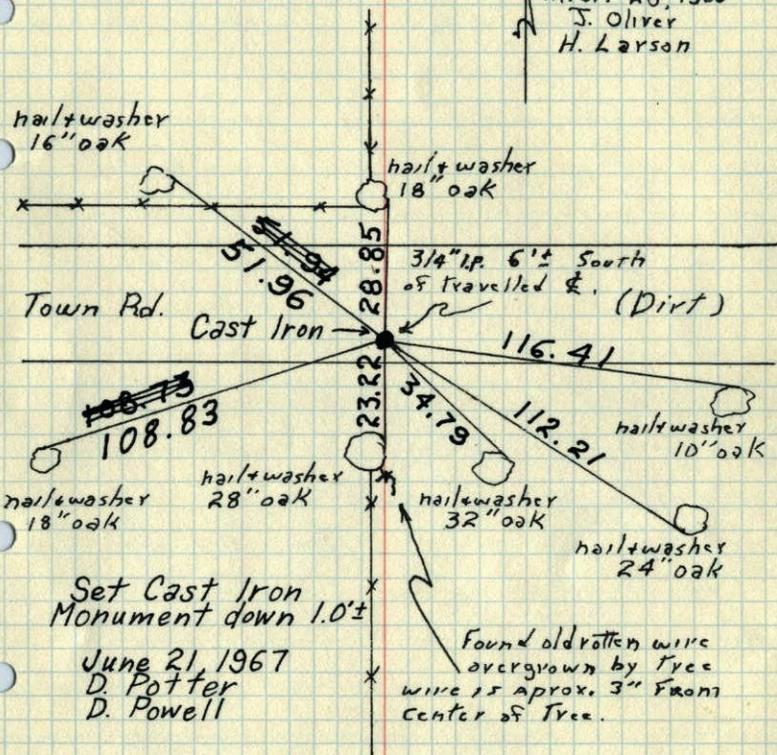

Set Cast Iron Monument down 1.0'±  
 June 21, 1967  
 D. Potter  
 D. Powell


TEMPERATURE CORRECTED AND HORIZONTALLY TAPED MEASUREMENTS  
 ROLAND W. ANDERSON  
 COUNTY SURVEYOR  
 ANOKA COUNTY, MINNESOTA

### 5/4 Cor Sec 28 T34 R22

Found 1" sq. by 5" steel rod. could find no stone as claimed. by area resident to be at corner, however road is in cut of 2' to 4' and rod could easily have been set to replace stone.  
 Replaced rod with 3/4" x 2' iron pipe down 6".

SET C.I. DOWN 1.0'±

Mar. 28, 1966  
 J. Oliver  
 H. Larson

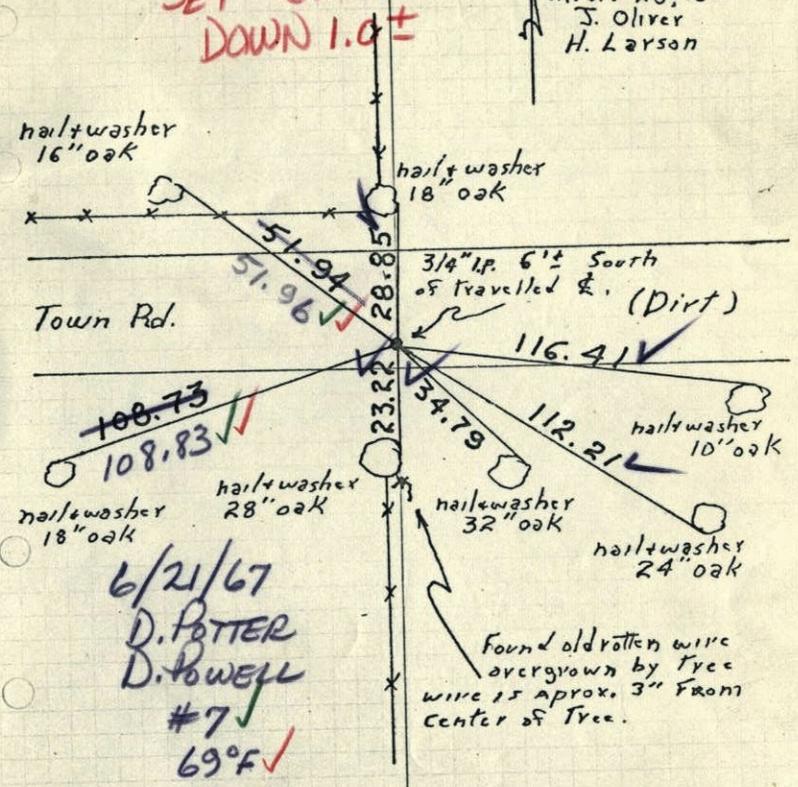

6/21/67  
 D. POTTER  
 D. POWELL  
 #7  
 69°F

TEMPERATURE CORRECTED AND HORIZONTALLY TAPED MEASUREMENTS  
 ROLAND W. ANDERSON  
 COUNTY SURVEYOR  
 ANOKA COUNTY, MINNESOTA


S 1/4 Cor. Sec. 28, T 34, R 22

Found 1" Sq. by 5' Steel Rod. Could find no stone as claimed by a nech resident to be at Corner; however road is in cut of 2 to 4' and rod could easily have been set to replace stone.

Replaced rod with 3/4" X 2' Iron pipe down 6'.

Nails and washers in all tie trees.

N  
 Mar. 28, 1966  
 430 ± 5  
 J. Oliver  
 H. Larson

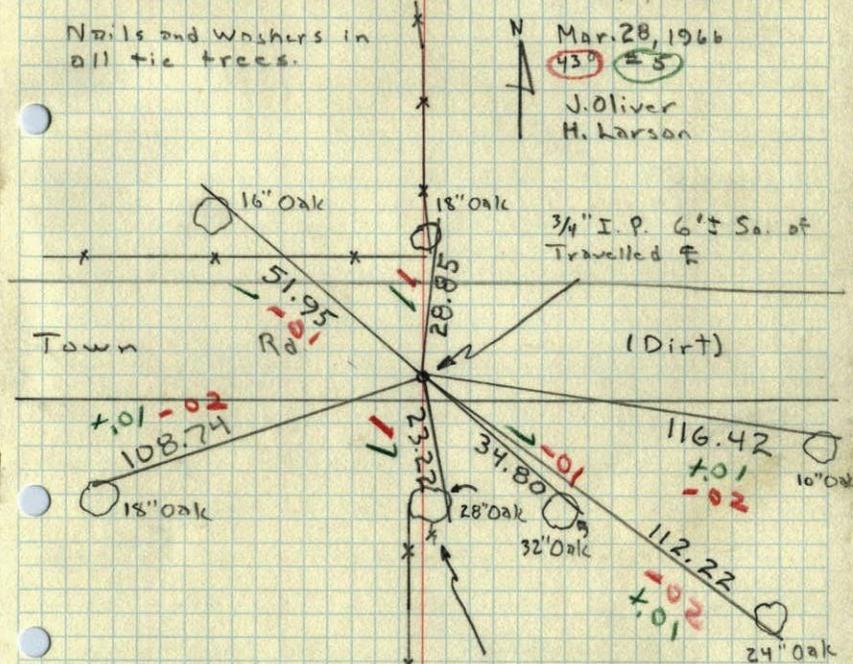

Found old rotten wire overgrown by tree. Wire is approx 3" to East of Center of tree.

TEMPERATURE CORRECTED  
 AND HORIZONTALLY  
 TAPED MEASUREMENTS

ROLAND W. ANDERSON  
 COUNTY SURVEYOR  
 ANOKA COUNTY, MINNESOTA