

# CERTIFICATE OF LOCATION OF GOVERNMENT CORNER

County of Anoka

State of Minnesota

Witness Corner of Sec. 25 Township 34 Range 22  
(on north line of NW 1/4)


On the 28th day of May, 1975, the described corner was evidenced by area resurvey

and to perpetuate the location of said corner, at the exact location thereof, a permanent marker was placed consisting of a cast iron monument with a sign and post on the north side

(MON. UNDER WATER 0.4' ±)

AND on the \_\_\_ day of \_\_\_\_\_, \_\_\_\_\_, said permanent marker was \_\_\_\_\_

Updated reference ties are as shown below.

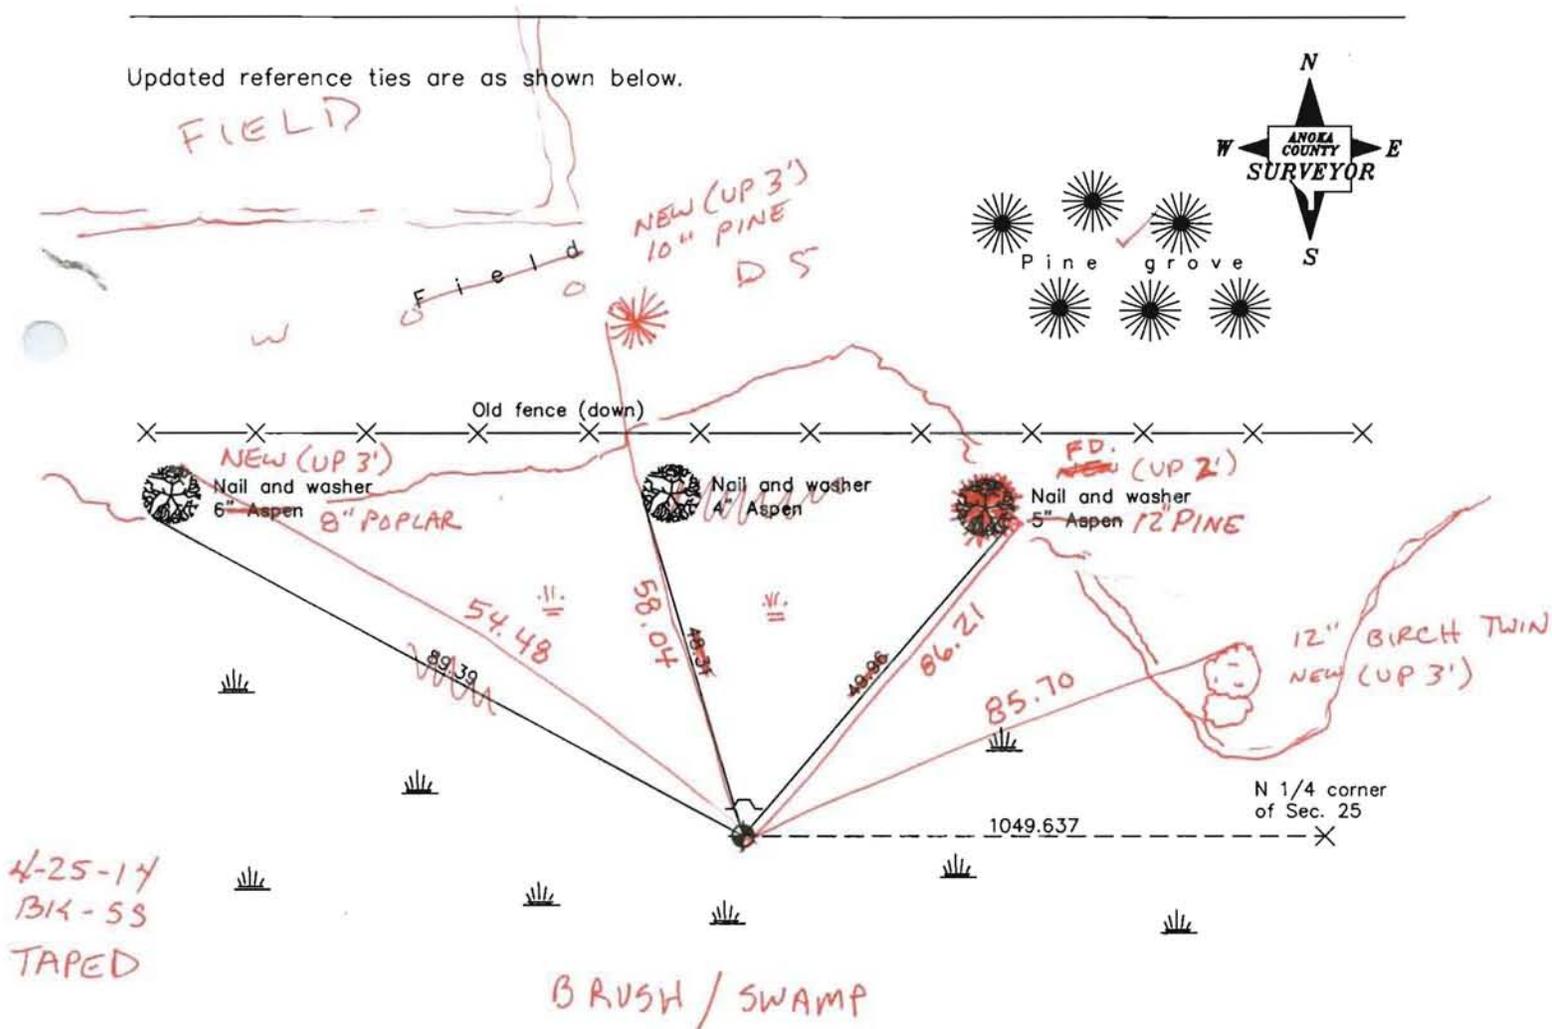

4-25-14  
BIK-SS  
TAPED

Revised date

8/14/86
7/01/93

N.A.D. 1983 Coordinates  
(1996 Adjustment)

County Project Coordinates	
Northing	<u>237447.5807</u>
Easting	<u>559760.3235</u>
Date	<u>3/18/04</u>

I hereby certify that this United States public land survey monument record is correct and complete to the best of my knowledge and belief.

\_\_\_\_\_  
\_\_\_\_\_, Anoka County Surveyor  
Minnesota License Number \_\_\_\_\_

VRS 3DQ = 0.05 N = 237447.5270 E = 559760.3141

# CERTIFICATE OF LOCATION OF GOVERNMENT CORNER


WITNESS COR. N. LINE County of Anoka State of Minnesota

OF  
NORTHWEST QTR Corner of Sec. 25 Township 34 Range 22


I hereby certify that on the 28 day of MAY, 1975, I found the described corner which was evidenced by AREA RE-SURVEY

and I further certify that to perpetuate the location of said corner, I did, at the exact location thereof, place a permanent marker consisting of CAST IRON MON.

which reference or witness monuments are located in the manner following:

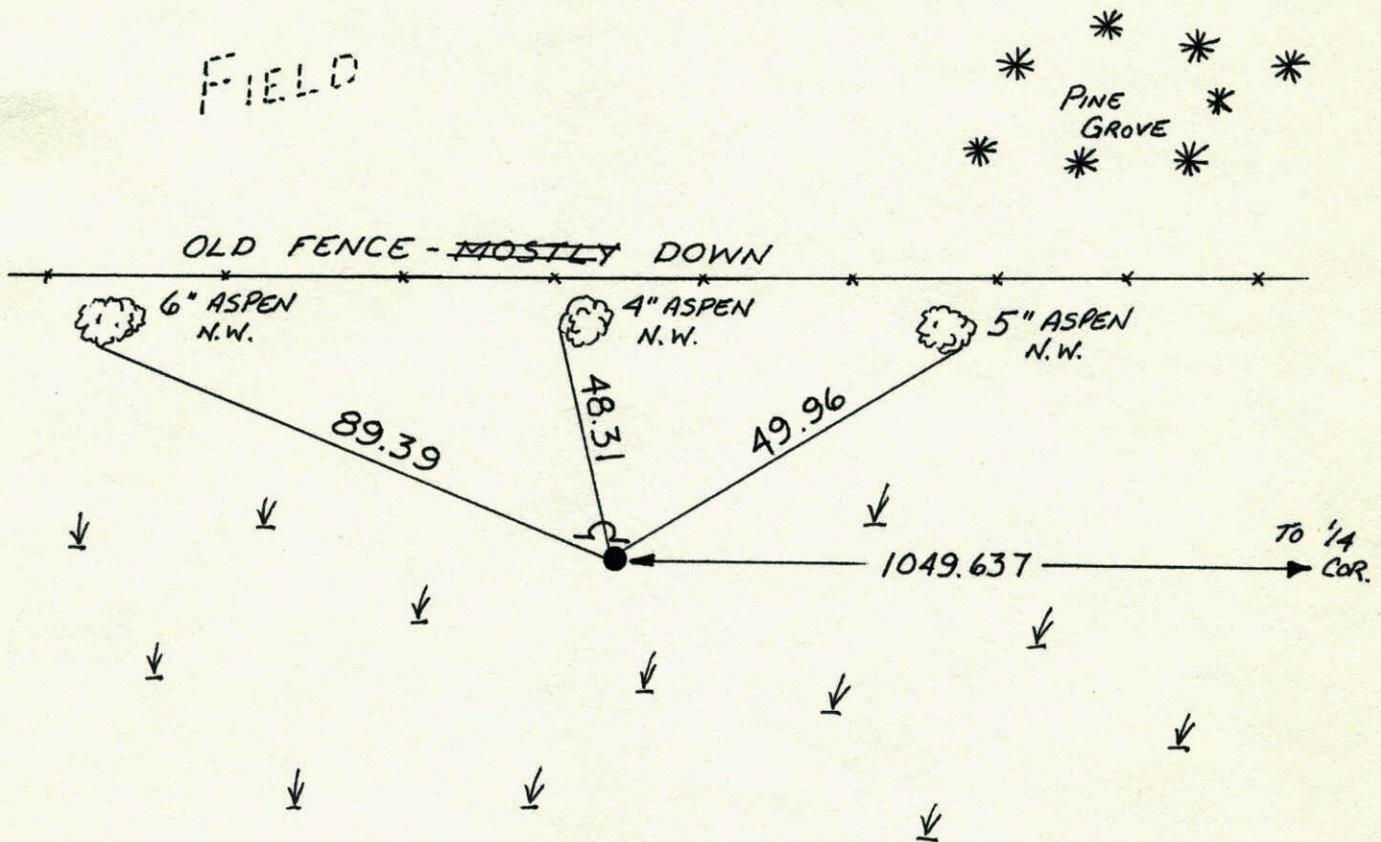

Revised date	Revised date	Revised date
8-14-86		
7-1-93		

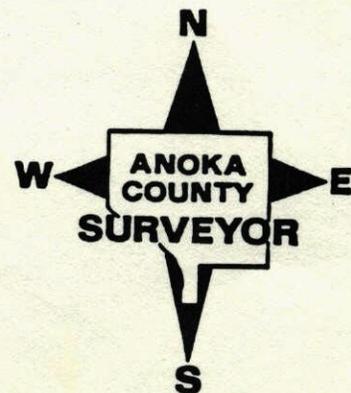


3  
W.C. On North Line Of NW 1/4 Sec 25

T34-R22

Set Cast Iron Monument From Area Resurvey

Set Post And Sign On North Side.

Field

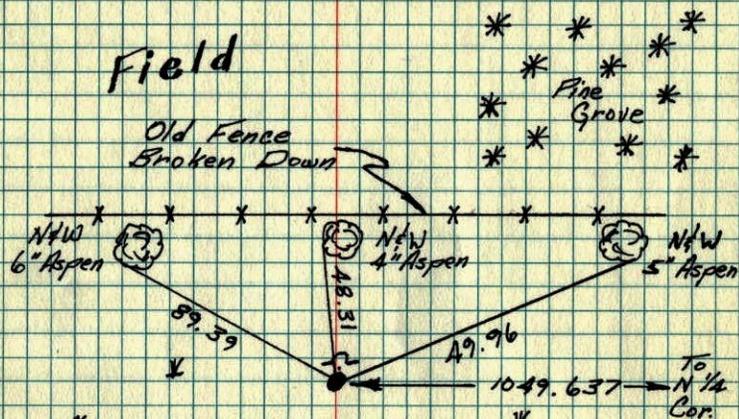

5-28-75	T. Chack	TIECHECK
H. Larson	8-8-78	6-15-82
R. Guetzko	D. Dahl	P. ROSS
J. Beutcher	M. Kigron	P. HORNBY
	B. Stephens	J. BEIER

TEMPERATURE CORRECTED  
AND HORIZONTALLY  
TAPED MEASUREMENTS


ROLAND W. ANDERSON  
COUNTY SURVEYOR  
ANOKA COUNTY, MINNESOTA

3  
W.C. on North Line of P NW 1/4 Sec. 25 T34 R22

Set cast iron monument From area resurvey

Set post & sign on N. side

Field

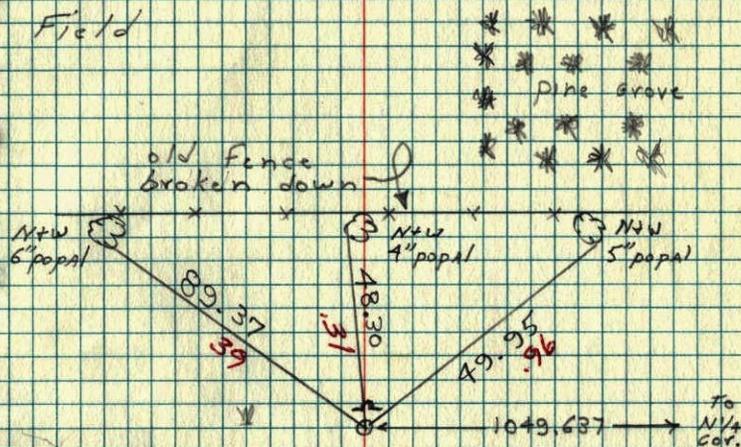

5-28-75
8-14-70
H. Larson
R. Guetzko
J. Beutcher