

8-26-14
BK JS SS

STATIC FOR NEW MON.

CERTIFICATE OF LOCATION OF GOVERNMENT CORNER

County of Anoka

State of Minnesota

Northeast Corner of Sec. 32 Township 34 Range 22

On the 1st day of October, 1973, the described corner was evidenced by area resurvey


and to perpetuate the location of said corner, at the exact location thereof, a permanent marker was placed consisting of a red and white iron pipe

9-4-14 JS SH SET 8' TELSPAR up 1' w/ CAP + PUNCHMARK


AND on the 3rd day of November, 2003, said permanent marker was found and the ties were updated

Updated reference ties are as shown below.

NEEDS RESET

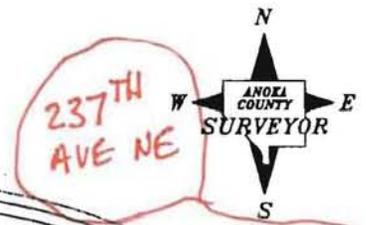

237TH AVE NE

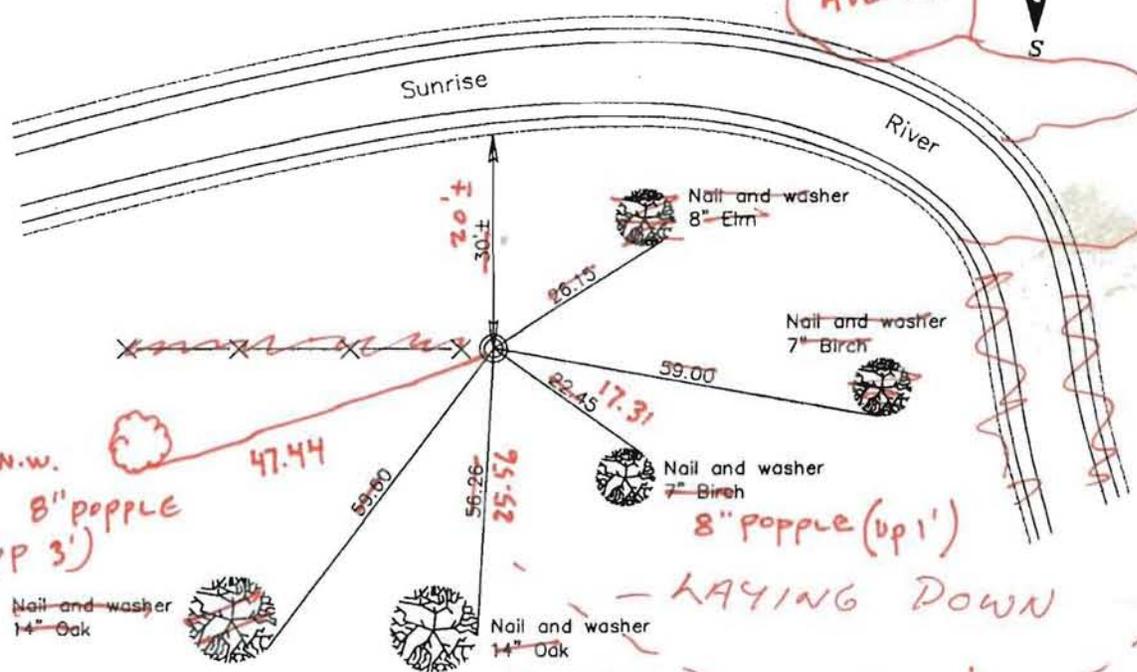

BK-SS
1-14-14

N.W. 8" POPPLE (UP 3')

8" POPPLE (UP 1')

6" MAPLE (UP 3')

LAYING DOWN

125'±

TYPICAL DRIVE NE CO RD 85

Revised date
7/05/86
6/22/93
11/03/03

N.A.D. 1983 Coordinates (1996 Adjustment)
County Project Coordinates
Northing 232786.8504
Easting 542467.8768
Date 11/03/03

I hereby certify that this United States public land survey monument record is correct and complete to the best of my knowledge and belief.

Larry D. Hoium Date 11/03/03
 Larry D. Hoium, Anoka County Surveyor
 Minnesota License Number 18165

CERTIFICATE OF LOCATION OF GOVERNMENT CORNER

County of Anoka


State of Minnesota

North East Corner of Sec. 32 Township 34 Range 22

I hereby certify that on the 1 day of October, 1973, I found the described corner which was evidenced by AREA RESURVEY

and I further certify that to perpetuate the location of said corner, I did, at the exact location thereof, place a permanent marker consisting of RED and WHITE IRON PIPE

which reference or witness monuments are located in the manner following:

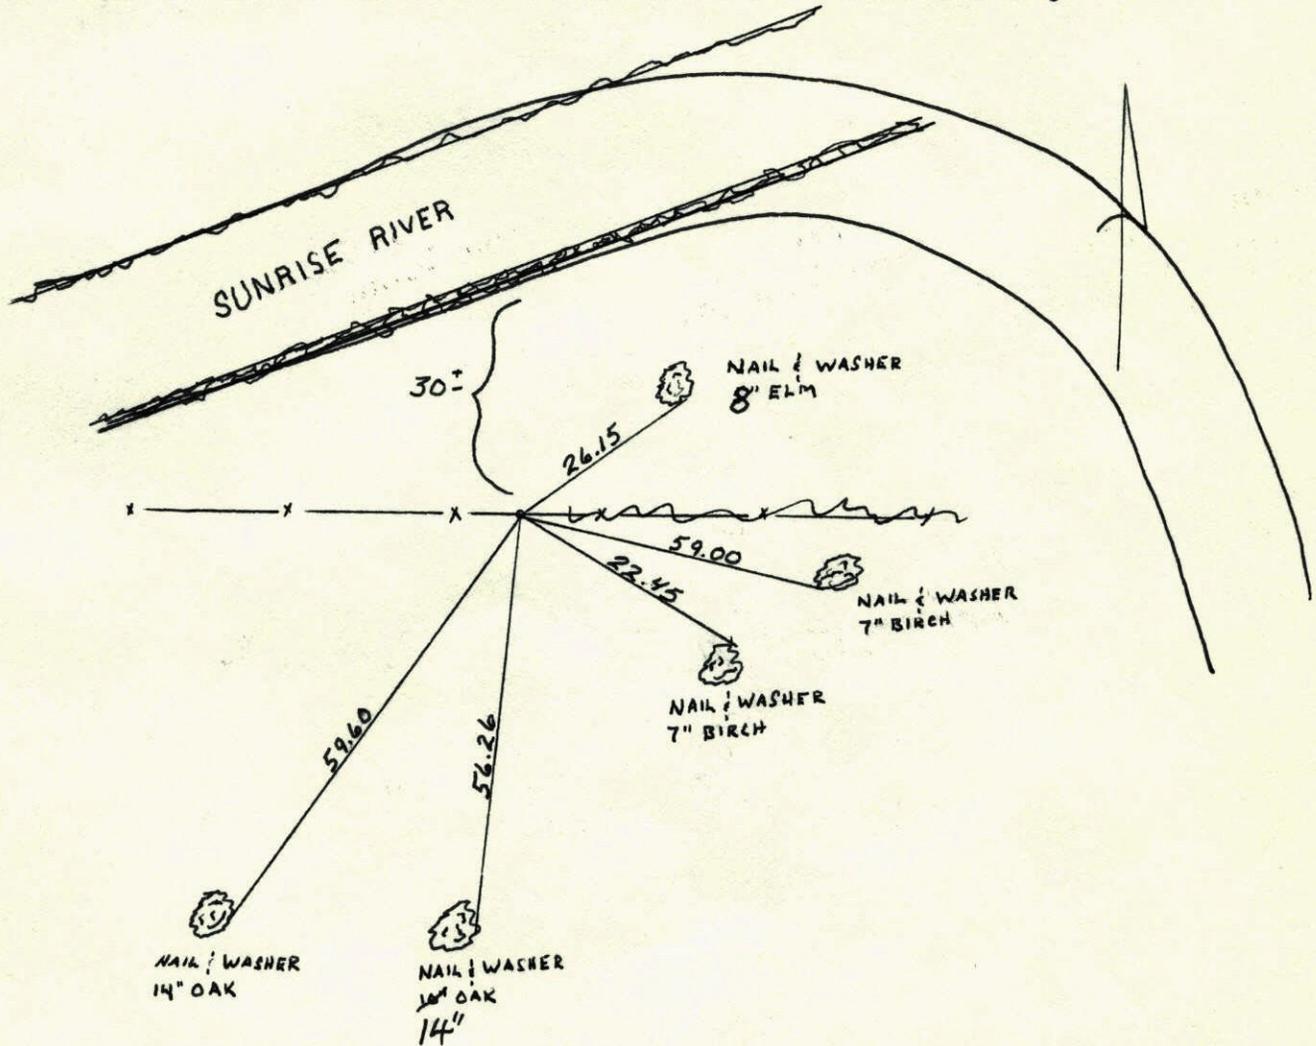

Revised date

7-5-86
6-22-93
11-3-03

By

D. VOGEL

Minnesota State Plane Coordinates

South Zone

Y _____ X _____


County Surveyor _____

Date _____

Registered Land Surveyor No. _____

NE Cor. Sec. 32, T34, R22


Set red and white iron pipe
from area resurvey

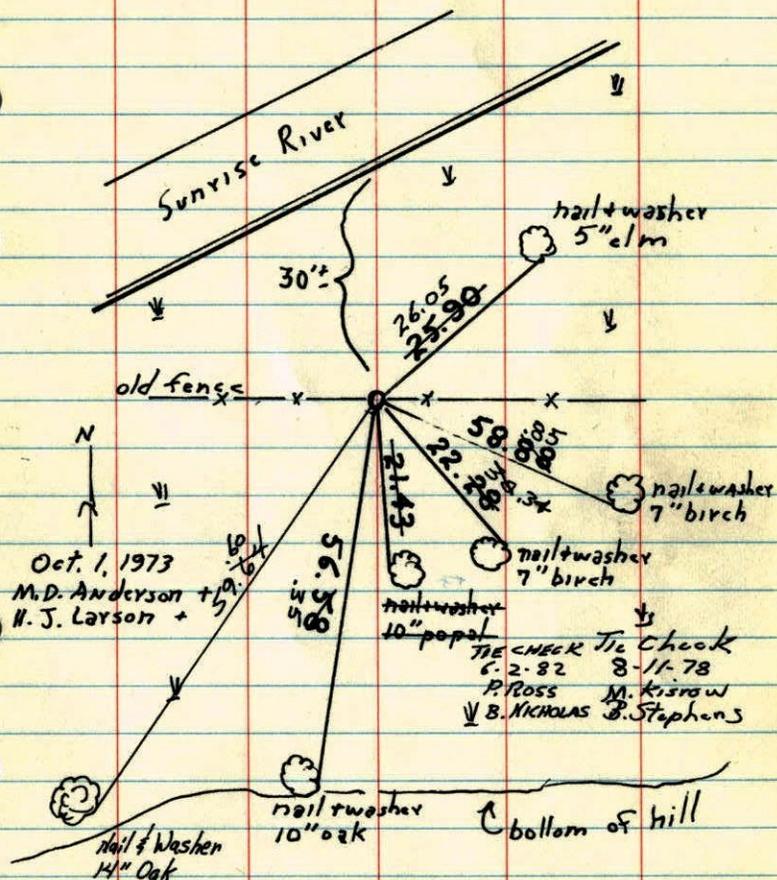

ROLAND W. ANDERSON
COUNTY SURVEYOR
ANOKA COUNTY, MINNESOTA

TEMPERATURE CORRECTED
AND HORIZONTALLY
TAPED MEASUREMENTS

N.E. Cor. Sec. 32-T34-R22
Set Red & White Iron pipe from area
resurvey

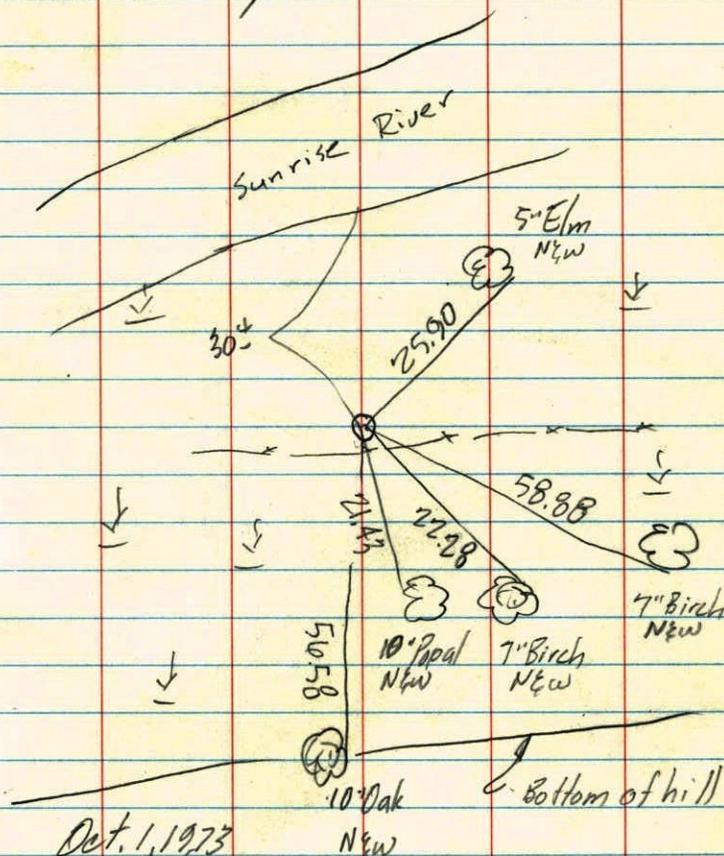

Oct. 1, 1973
M.D. Anderson +
H.S. Larson +
temp. 68°
tape #18