

8.26.14 JS BK 55

STATIC POS. POUNDED ORIGINAL RED & WHITE DOWN UP 2'

CERTIFICATE OF LOCATION OF GOVERNMENT CORNER
County of Anoka State of Minnesota

Northeast Corner of Sec. 31 Township 34 Range 22


On the 22nd day of June, 1976, the described corner was evidenced by a 1/2" iron pipe

and to perpetuate the location of said corner, at the exact location thereof, a permanent marker was placed consisting of a red and white iron pipe 3" PIPE IN GOOD COND. up 4'

AND on the ___ day of _____, _____, said permanent marker was _____

Updated reference ties are as shown below.

ACCESS FROM #23661

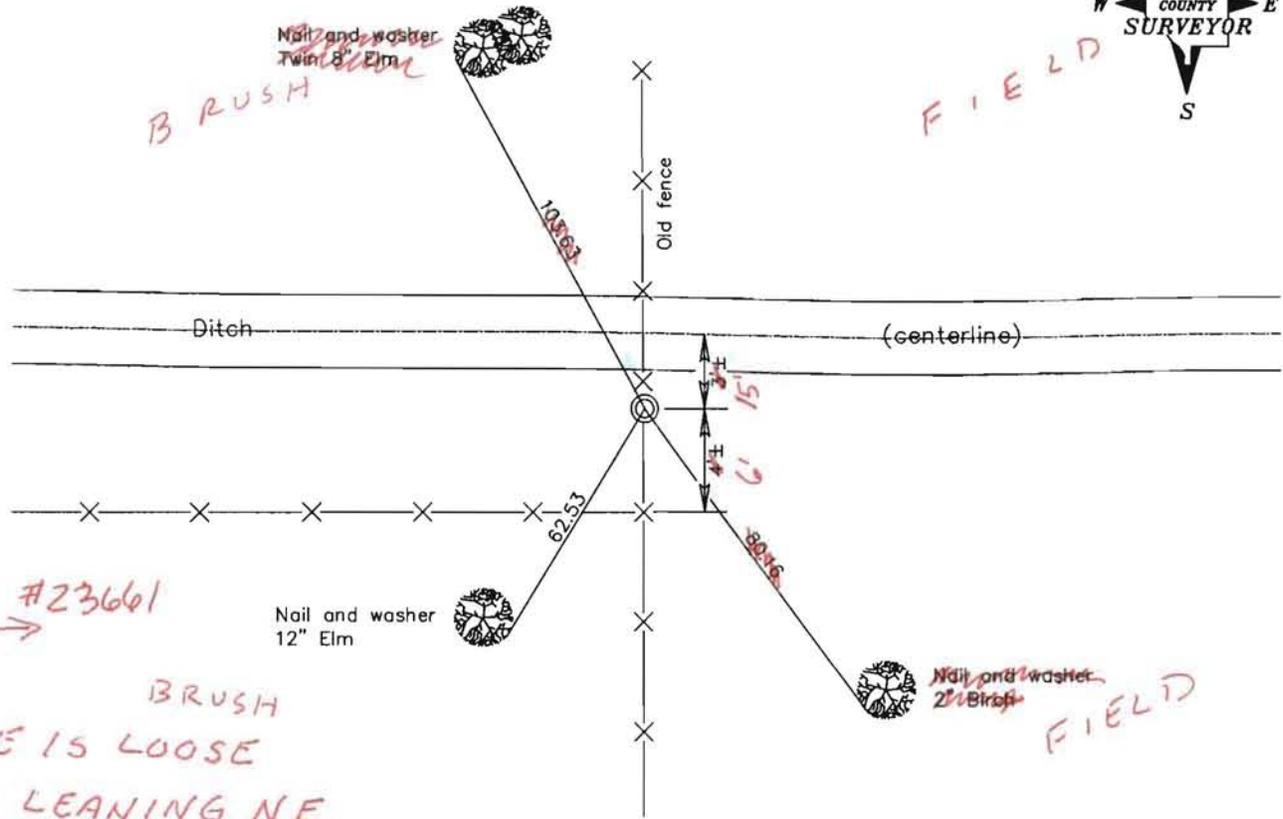

WALKED IN (TRAILS) #23661
BRUSH
PIPE IS LOOSE AND LEANING N.E.
*NEEDS RESET
BK. 55
5-5-14

| |
|--------------|
| Revised date |
| 8/14/86 |
| 6/22/93 |
| |
| |
| |

| |
|---|
| N.A.D. 1983 Coordinates (1996 Adjustment) |
| County Project Coordinates |
| Northing 232731.9222 |
| Easting 537224.8800 |
| Date 2/17/04 |

I hereby certify that this United States public land survey monument record is correct and complete to the best of my knowledge and belief.

_____, Anoka County Surveyor

Minnesota License Number _____

YRS
3DQ = 0.04 N = 232731.8461 E = 537224.6874

033-502
705-330

CERTIFICATE OF LOCATION OF GOVERNMENT CORNER

County of Anoka


State of Minnesota

NORTHEAST Corner of Sec. 31 Township 34 Range 22


I hereby certify that on the 22 day of JUNE, 1976, I found the described corner which was evidenced by 1/2" I. P.

and I further certify that to perpetuate the location of said corner, I did, at the exact location thereof, place a permanent marker consisting of RED, WHITE I. P.

which reference or witness monuments are located in the manner following:

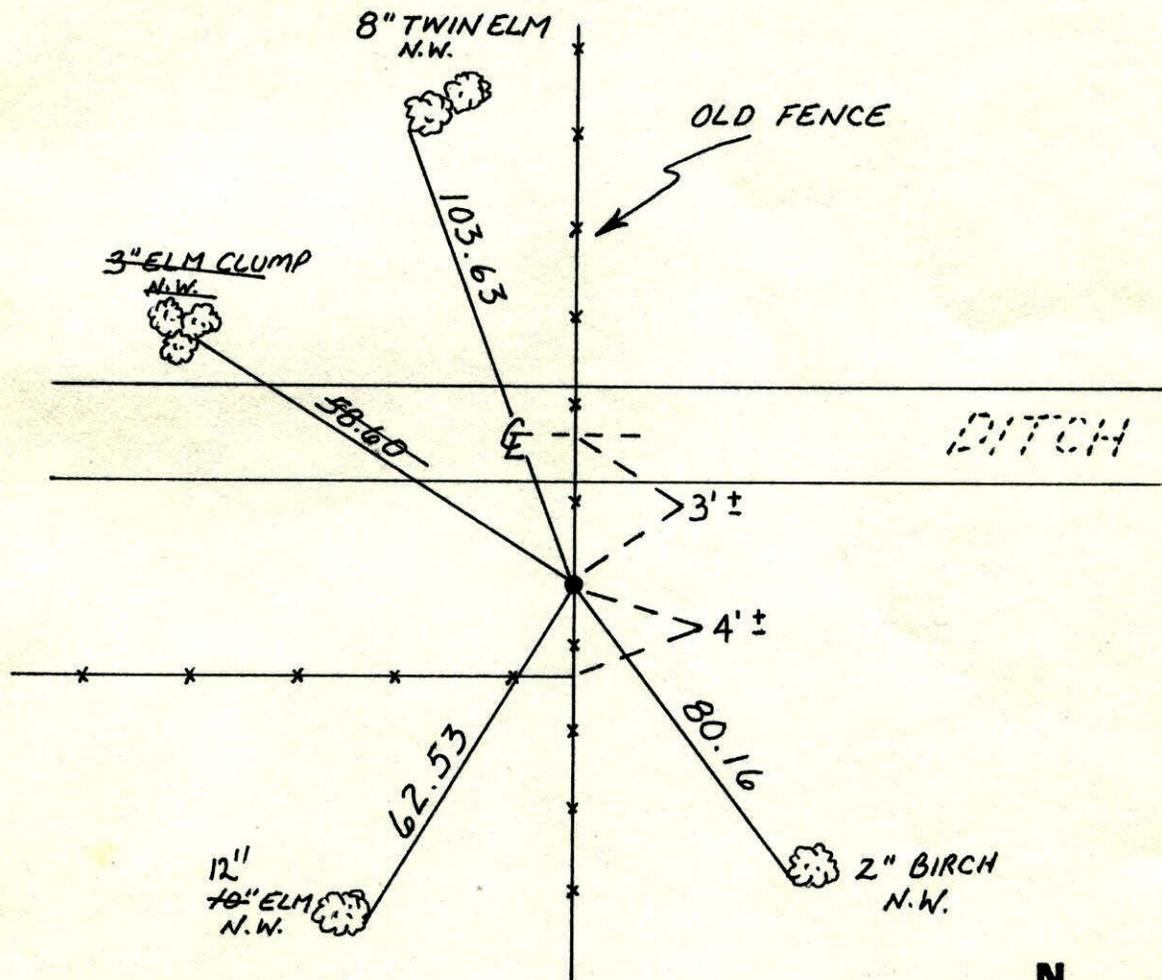


| Revised date | Revised date | Revised date |
|--------------|--------------|--------------|
| 8-14-86 | | |
| 6-22-93 | | |
| | | |
| | | |
| | | |
| | | |

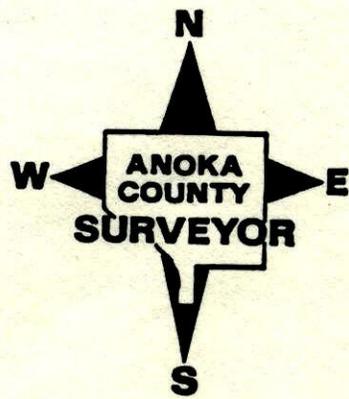

N.E. Cor. Sec. 31 T34 R22

Found $\frac{1}{2}$ " Iron Pipe Set By N.C. Hoium
 Replaced With Red And White Iron Pipe

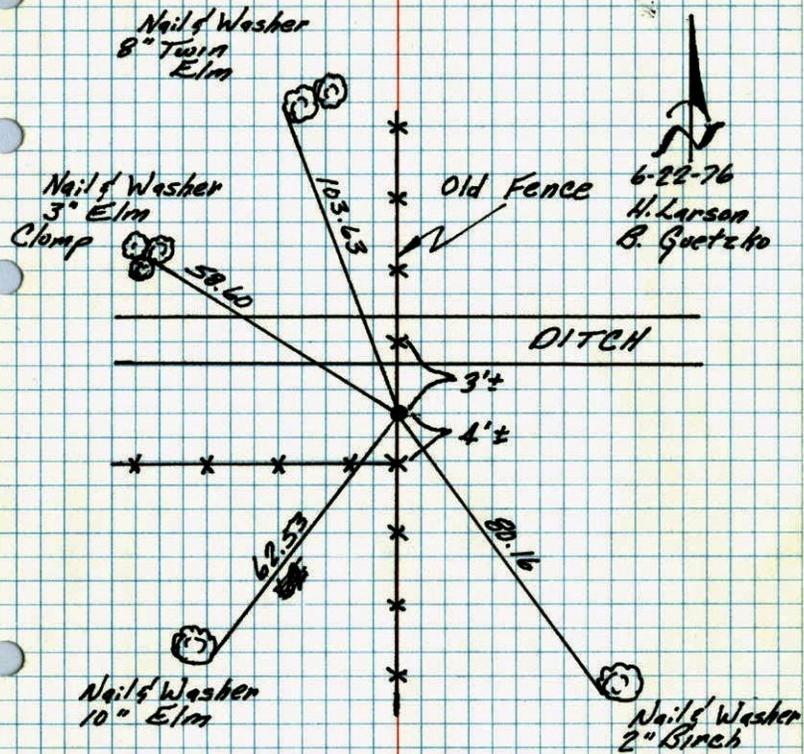


| | |
|----------|-------------|
| TIECHECK | Tie Check |
| 6-9-82 | 8-11-78 |
| P. RASS | M. KISSNER |
| J. BEIER | J. STEPHENS |

TEMPERATURE CORRECTED
 AND HORIZONTALLY
 TAPED MEASUREMENTS

ROLAND W. ANDERSON
 COUNTY SURVEYOR
 ANOKA COUNTY, MINNESOTA

NE Cor. Sec. 31 T34 R22

Found $\frac{1}{2}$ " Iron pipe set by N.C. Hoium.
 Replaced with Red and white iron pipe

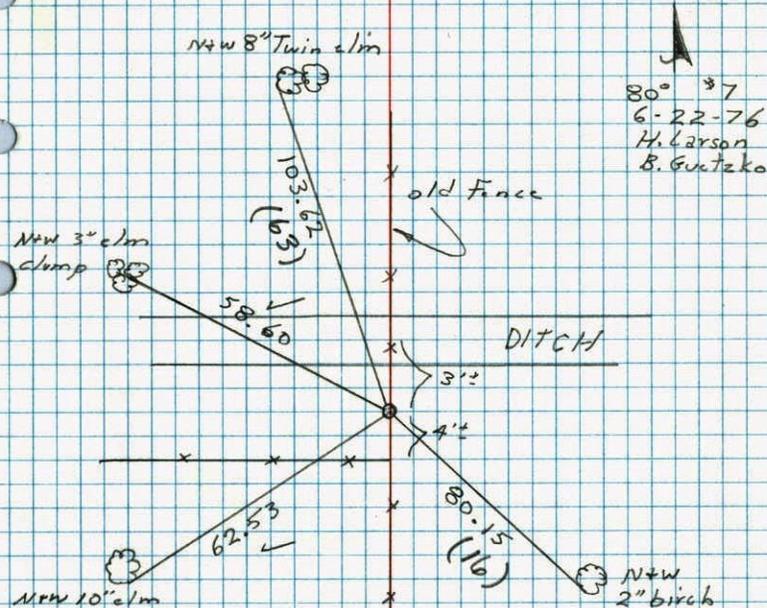

TEMPERATURE CORRECTED
 AND HORIZONTALLY
 TAPED MEASUREMENTS

ROLAND W. ANDERSON
 COUNTY SURVEYOR
 ANOKA COUNTY, MINNESOTA