

CERTIFICATE OF LOCATION OF GOVERNMENT CORNER

County of Anoka

State of Minnesota

North 1/4 Corner of Sec. 31 Township 34 Range 22



On the 19th day of November, 1971, the described corner was evidenced by an iron pipe

and to perpetuate the location of said corner, at the exact location thereof, a permanent marker was placed consisting of a cast iron monument

AND on the 16th day of Jan., 2014, said permanent marker was Same cim w/ sign post on S. side (no sign)

~~* COULD USE NEW SIGN~~ **ADDED SIGN 8-18-14 BK-55**

Updated reference ties are as shown below.

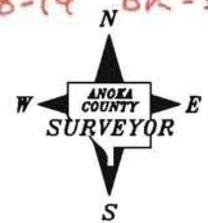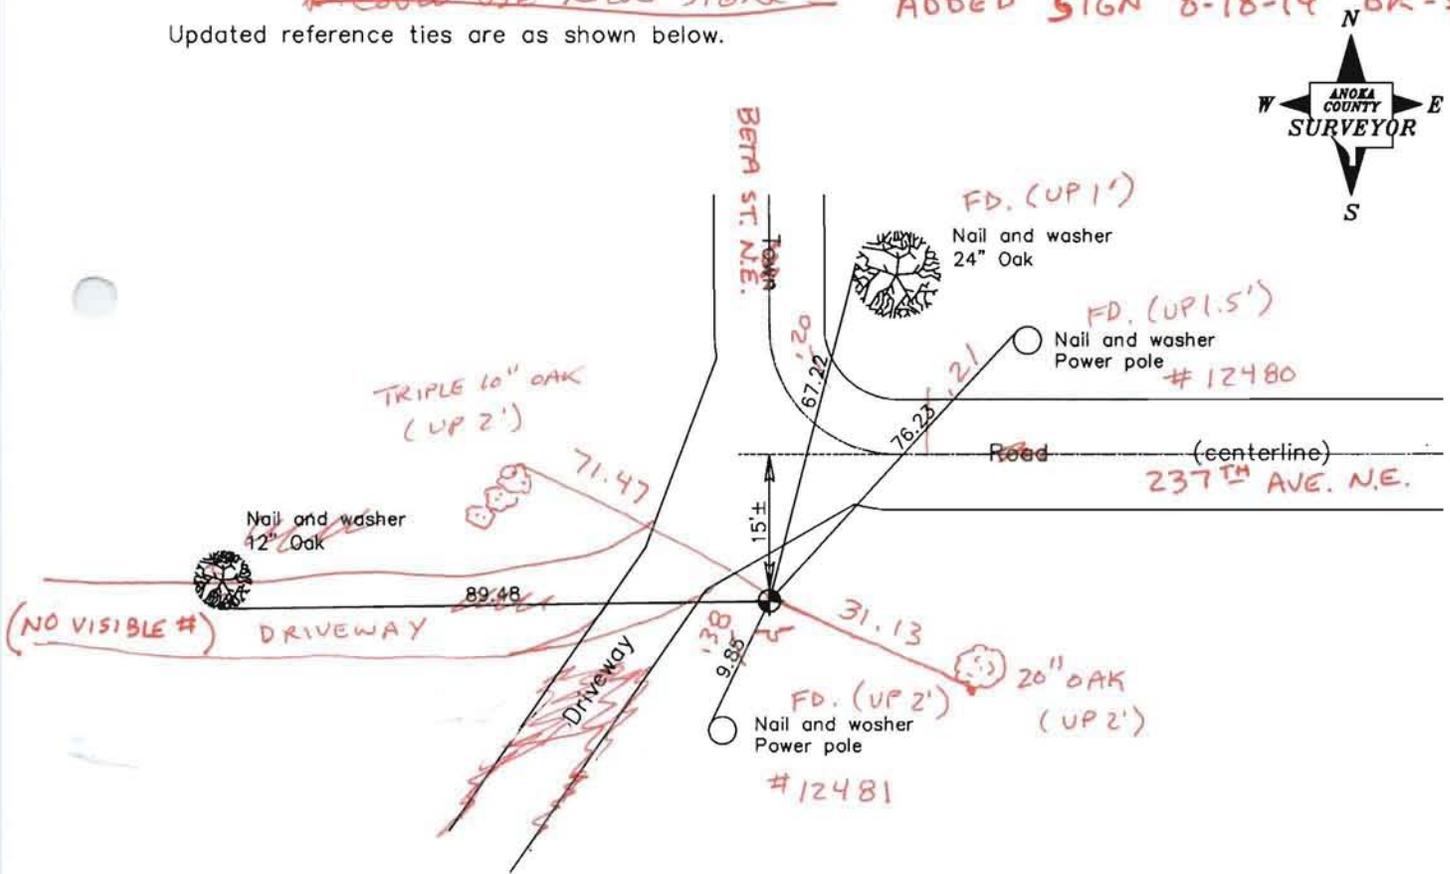

Revised date
5/27/82
8/14/86
6/17/93
BK-55

TAPED

N.A.D. 1983 Coordinates (1996 Adjustment)
County Project Coordinates
Northing <u>232749.6913</u>
Easting <u>534576.5763</u>
Date <u>6/04/03</u>

I hereby certify that this United States public land survey monument record is correct and complete to the best of my knowledge and belief.

_____ Date _____

_____, Anoka County Surveyor

Minnesota License Number _____

CERTIFICATE OF LOCATION OF GOVERNMENT CORNER

County of Anoka


State of Minnesota

NORTH QTR. Corner of Sec. 31 Township 34 Range 22


I hereby certify that on the 19 day of Nov., 1971, I found the described corner which was evidenced by I.P.

and I further certify that to perpetuate the location of said corner, I did, at the exact location thereof, place a permanent marker consisting of CAST IRON MON.

which reference or witness monuments are located in the manner following:

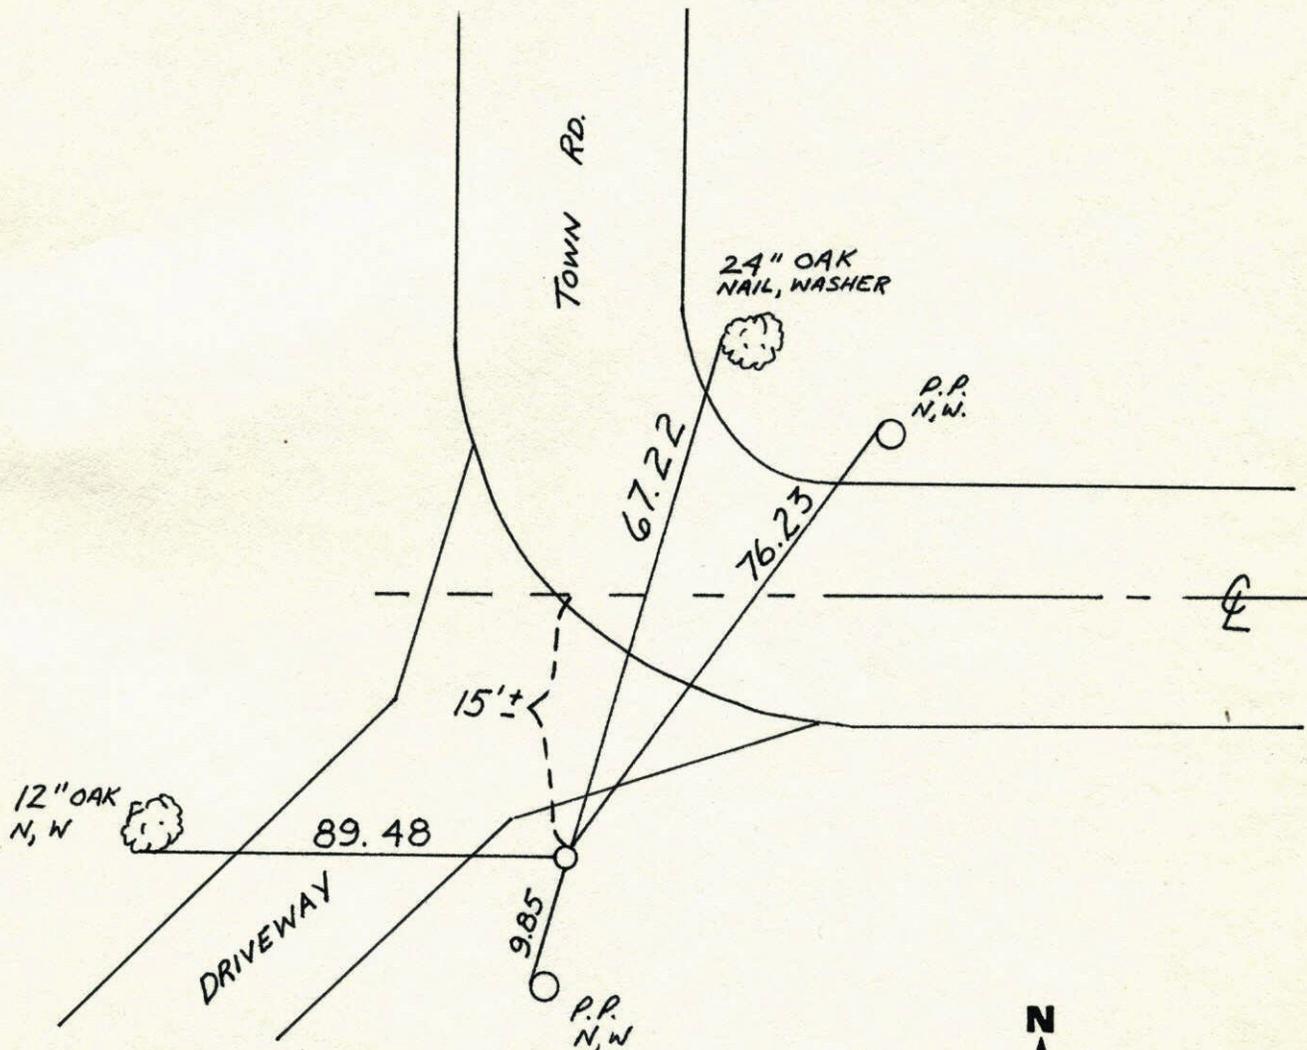


Revised date	Revised date	Revised date
5-27-82		
8-14-86		
6-17-93		

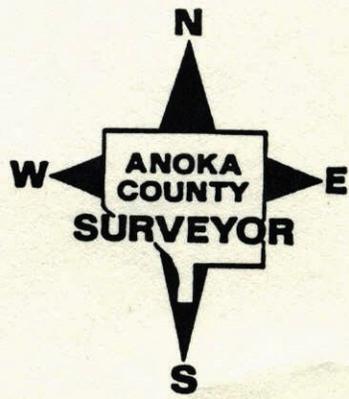

10-27-71

N 1/4 SEC. 31 T. 34 R. 22

Tied
11-19-71
H.L.

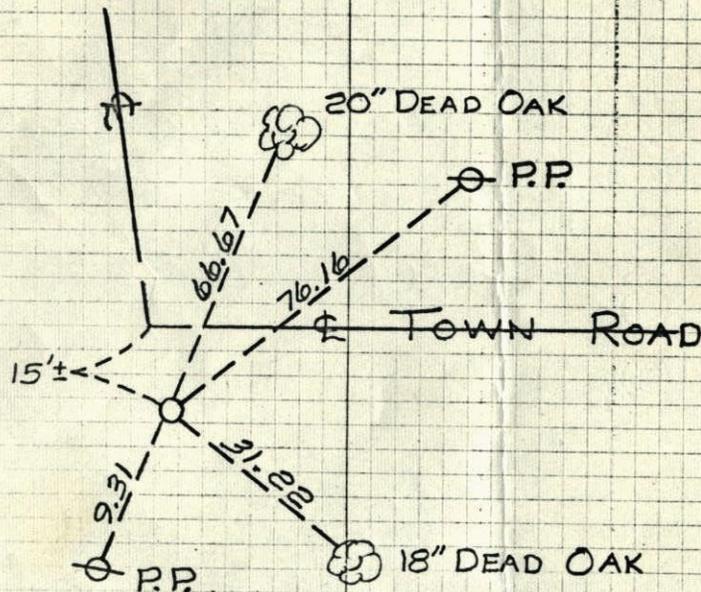

N. C. Hoium and Associates, Inc.

ENGINEERS AND SURVEYORS

10130 Central Ave. N. E. (Hwy. 65)

Minneapolis, Minnesota 55433