

CERTIFICATE OF LOCATION OF GOVERNMENT CORNER

County of Anoka

State of Minnesota

West 1/4 Corner of Sec. 34 Township 34 Range 22


On the 2nd day of January, 1975, the described corner was evidenced by a 1" iron pipe

and to perpetuate the location of said corner, at the exact location thereof, a permanent marker was placed consisting of a red and white iron pipe (UP 3'±)

AND on the ___ day of _____, _____, said permanent marker was _____

Updated reference ties are as shown below.

SNOWMOBILE TRAIL

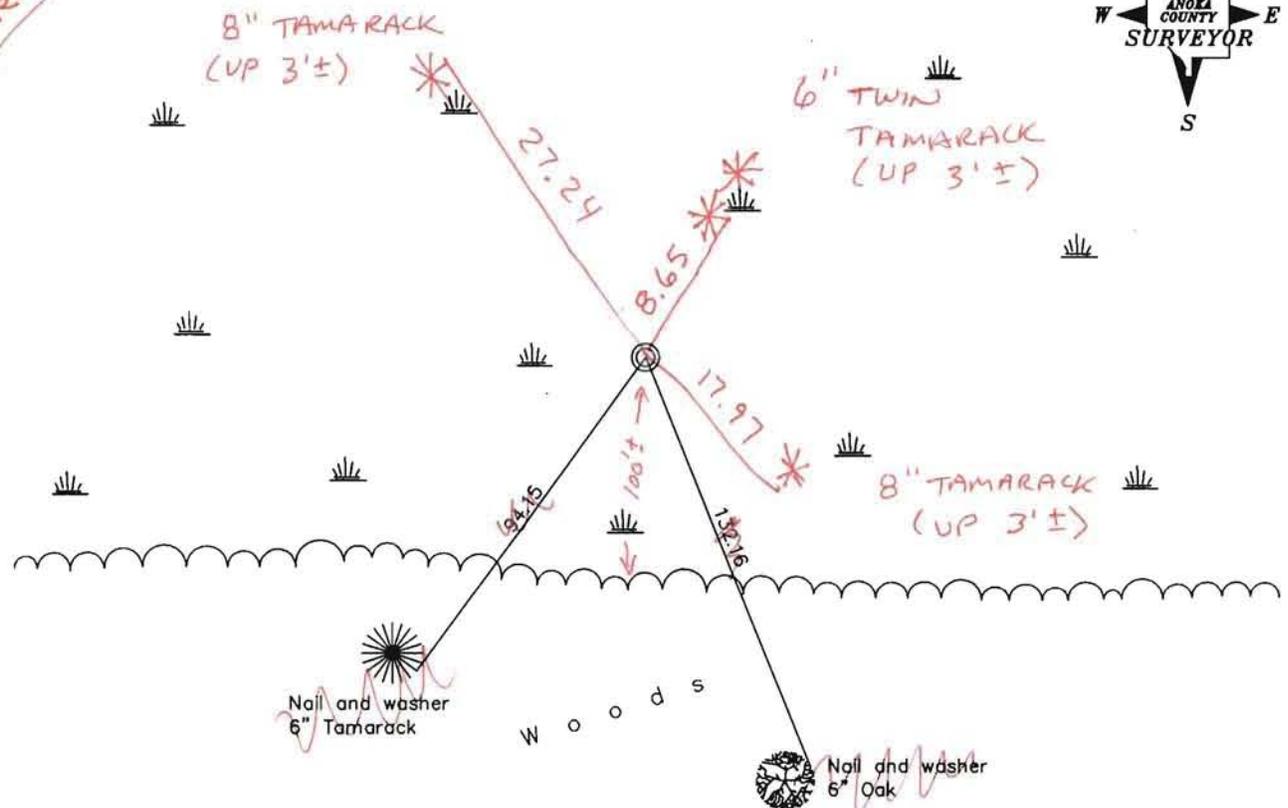

Revised date

1982
1986
7/11/95
2-12-14
BK-SS

TAPED

N.A.D. 1983 Coordinates (1996 Adjustment)

County Project Coordinates	
Northing	229872.2085
Easting	547784.9670
Date	2/12/04

I hereby certify that this United States public land survey monument record is correct and complete to the best of my knowledge and belief.

_____ Date _____
 _____, Anoka County Surveyor
 Minnesota License Number _____

CERTIFICATE OF LOCATION OF GOVERNMENT CORNER

County of Anoka


State of Minnesota

WEST QTR. Corner of Sec. 34 Township 34 Range 22


I hereby certify that on the 2 day of JAN., 1975, I found the described corner which was evidenced by 1" I.P.

and I further certify that to perpetuate the location of said corner, I did, at the exact location thereof, place a permanent marker consisting of RED, WHITE I.P.

which reference or witness monuments are located in the manner following:

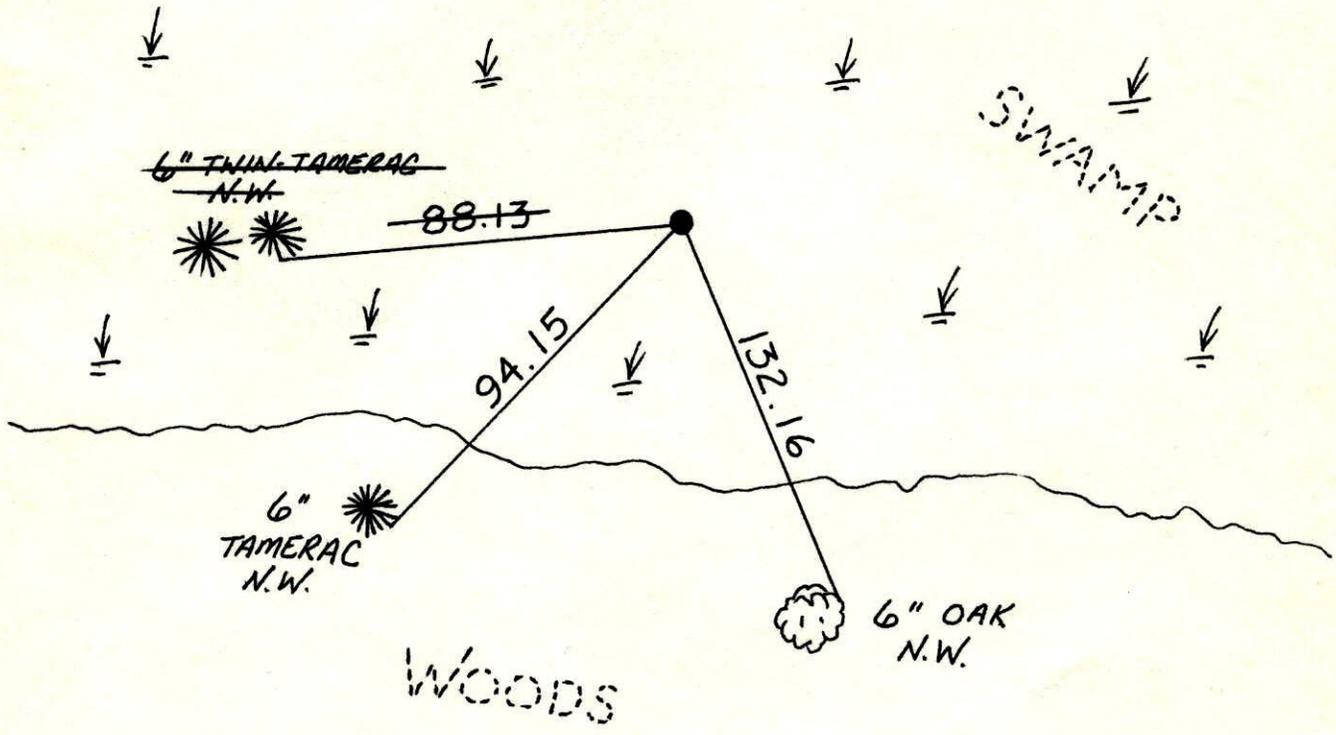


Revised date	Revised date	Revised date
WET 82		
" 86		
7-11-95		

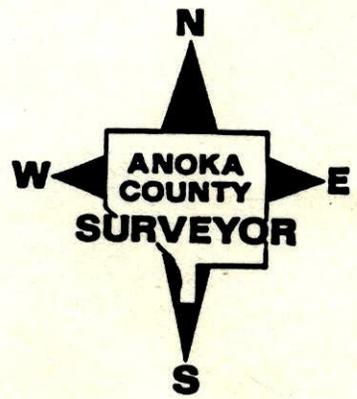

WEST 1/4 Sec. 34 T_W 34 R. 22

RETIE R/W IRON PIPE

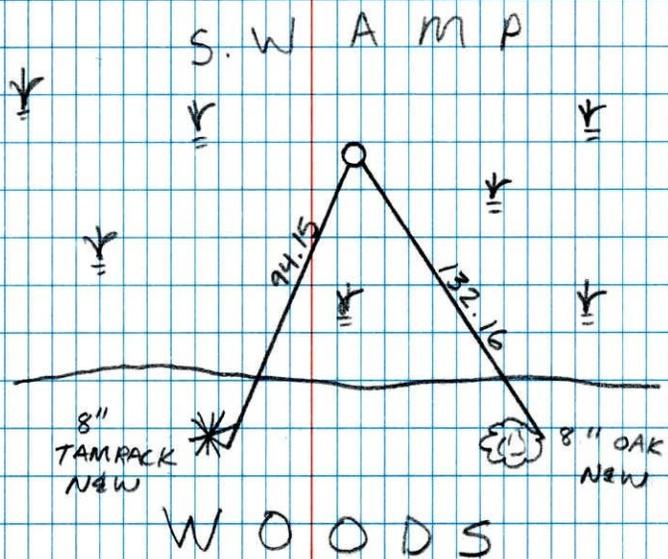

JOHN & JASON ANDERSON

7-11-95

NO. 446

NATIONAL PRINTFAST

W 1/4 Cor Sec 34-T34-R22

Replaced 1" Iron Pipe With 2" Red & White Iron Pipe. Up 3' 5"

Temp 30°


Tape #14

Jan 2, 1975

H. Larson

R. Guetzko

J. Beutcher

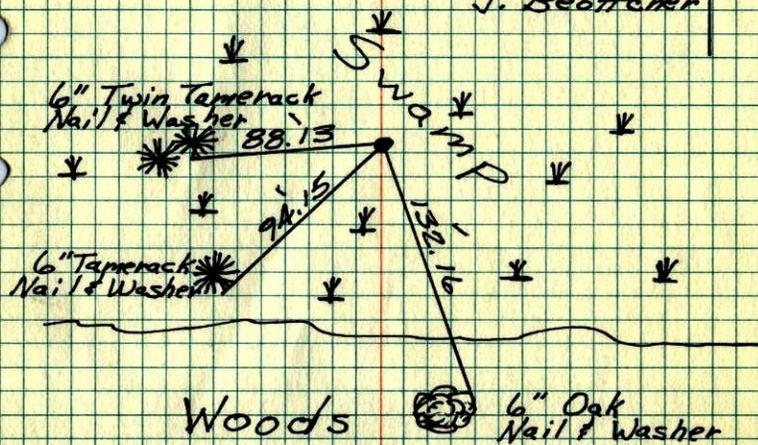

Tie check

2-17-78

H. Larson

B. Guetzko

WET 1282

ROLAND W. ANDERSON

COUNTY SURVEYOR

ANOKA COUNTY, MINNESOTA

TEMPERATURE CORRECTED
AND HORIZONTALLY
TAPED MEASUREMENTS

West 1/4 Cor. Sec. 34 T34 R22

Replaced 1" iron pipe with 2" red + white
iron pipe. up 3'±

30° ± 14

1-2-75

H. Larson

J. Butcher

B. Guetzko

Swamp

NW
6" Twin
Tamarack

88.15

13

97.17

15

132.19

16

NW
6" Tamarack

NW
6" Oak

Woods

