

CERTIFICATE OF LOCATION OF GOVERNMENT CORNER

County of Anoka

State of Minnesota


West 1/4 Corner of Sec. 35 Township 34 Range 22

On the 13th day of November, 1975, the described corner was evidenced by area resurvey

and to perpetuate the location of said corner, at the exact location thereof, a permanent marker was placed consisting of a cast iron monument with a sign and post on the north side

AND on the ___ day of _____, _____, said permanent marker was _____

Updated reference ties are as shown below.

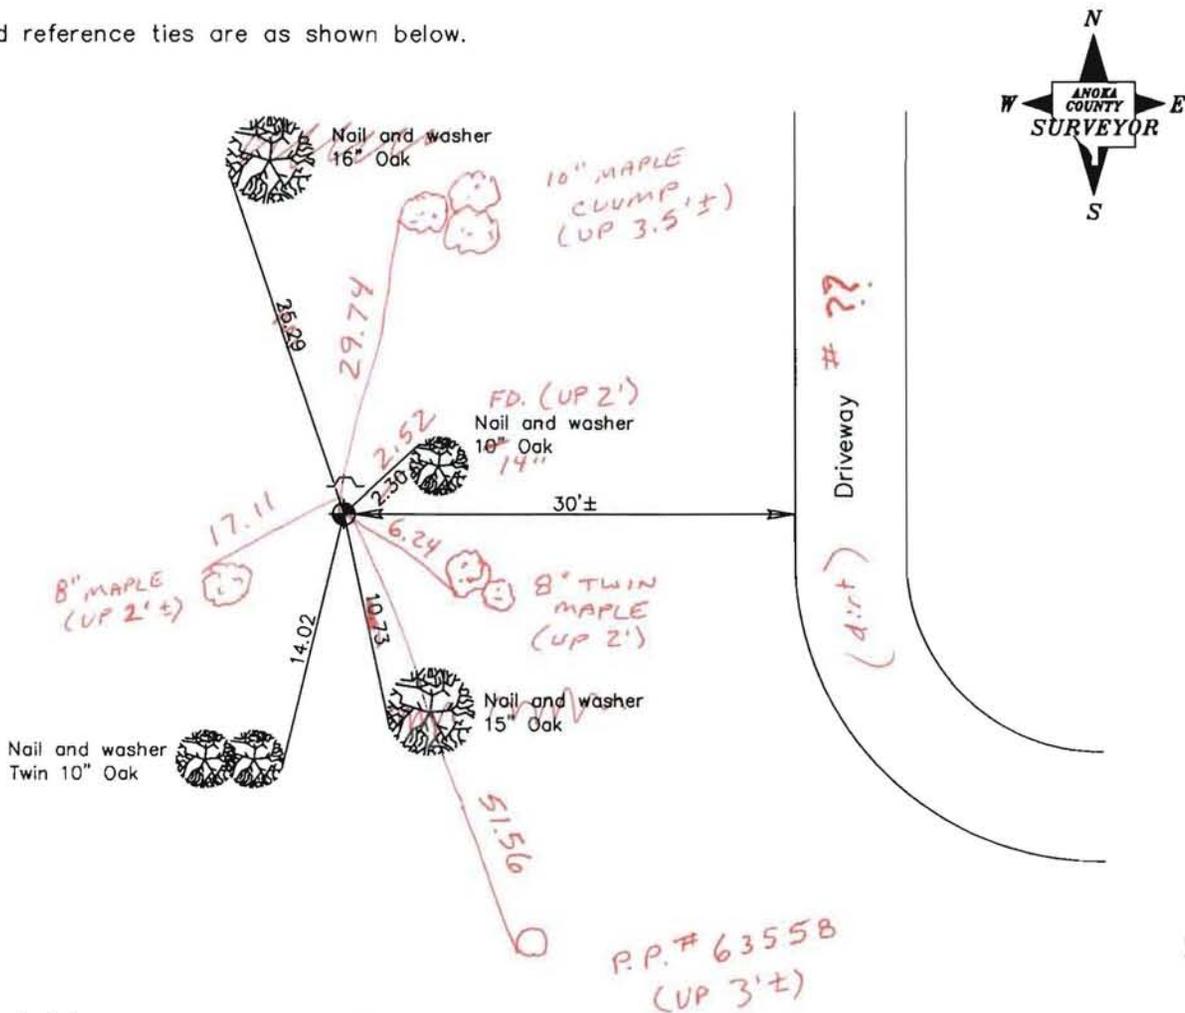

Revised date
7/05/93
2-3-14
BK-SS
T/T

N.A.D. 1983 Coordinates (1996 Adjustment)
County Project Coordinates
Northing <u>229681.5000</u>
Easting <u>553176.9174</u>
Date <u>2/04/04</u>

I hereby certify that this United States public land survey monument record is correct and complete to the best of my knowledge and belief.

_____, Anoka County Surveyor

Minnesota License Number _____

CERTIFICATE OF LOCATION OF GOVERNMENT CORNER

County of Anoka


State of Minnesota

WEST 1/4 Corner of Sec. 35 Township 34 Range 22


I hereby certify that on the 13 day of NOV, 19 75, I found the described corner which was evidenced by AREA RESURVEY

and I further certify that to perpetuate the location of said corner, I did, at the exact location thereof, place a permanent marker consisting of CAST IRON MONUMENT
Sign & Post NORTH SIDE

which reference or witness monuments are located in the manner following:


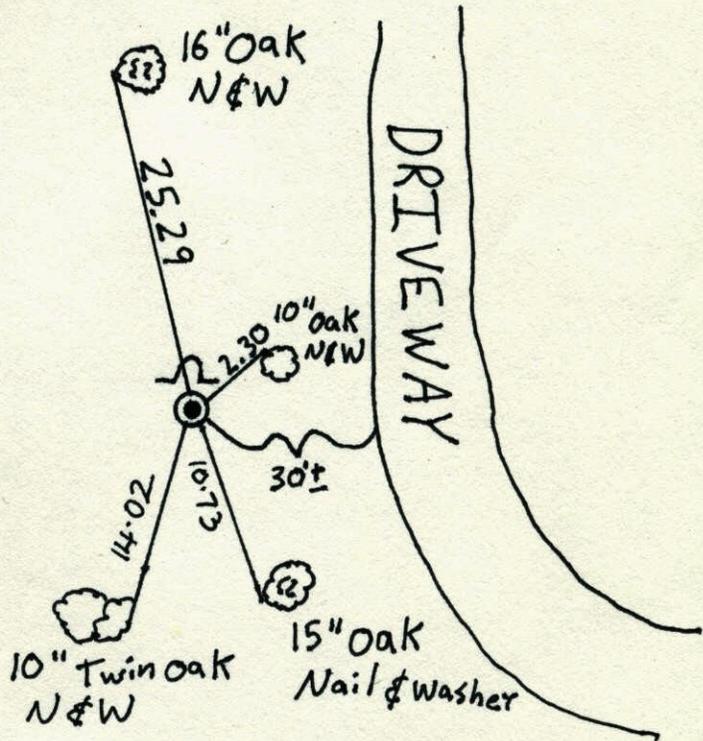


Revised date	Revised date	Revised date
7-5-93		

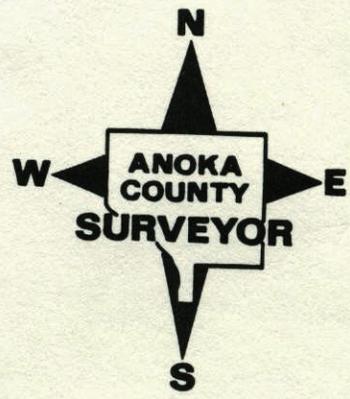

WEST 1/4 CORNER SEC. 35 T34
 Retie CAST IRON R22


Sign & Post
 North Side

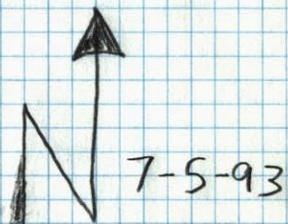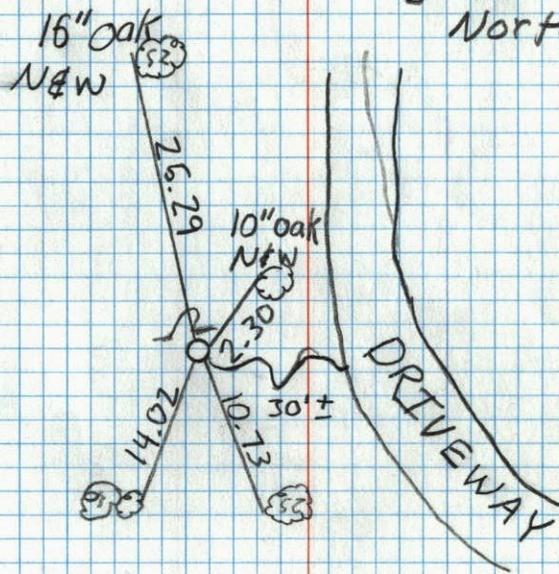

Jayne Anderson
 Josh Anderson

W 1/4 COR. SEC. 35, T. 34, R. 22

SET CAST IRON MONUMENT FROM
 AREA RESURVEY. SIGN AND POST
 ON NORTH SIDE OF MONUMENT.

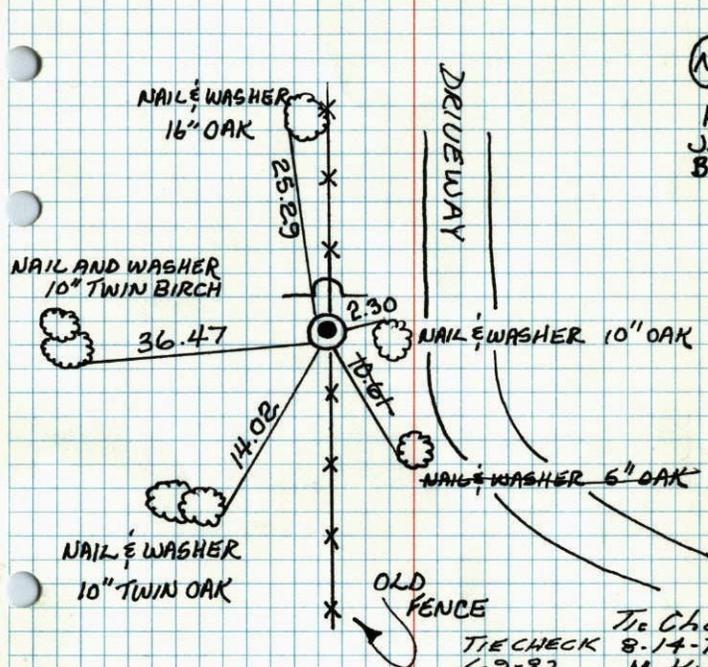

N 11-13-75
 H. LARSON
 J. BOETTCHER
 B. GUETZKO

Tie Check
 TIE CHECK 8-14-78
 6-9-82 M. Kisrow
 P. Ross B. Stephens
 J. BEIER

TEMPERATURE CORRECTED
 AND HORIZONTALLY
 TAPED MEASUREMENTS

ROLAND W. ANDERSON
 COUNTY SURVEYOR
 ANOKA COUNTY, MINNESOTA

W $\frac{1}{4}$ Cor. Sec. 35 T34 R22

Set cast iron monument From area
resurvey. Sign + post on North side

