

CERTIFICATE OF LOCATION OF GOVERNMENT CORNER

County of Anoka

State of Minnesota


East 1/4 Corner of Sec. 36 Township 34 Range 22

On the 24th day of June, 1975, the described corner was evidenced by area resurvey

and to perpetuate the location of said corner, at the exact location thereof, a permanent marker was placed consisting of a cast iron monument

AND on the 30th day of July, 2003, said permanent marker was replaced with a new cast iron monument and the ties were updated

Updated reference ties are as shown below.

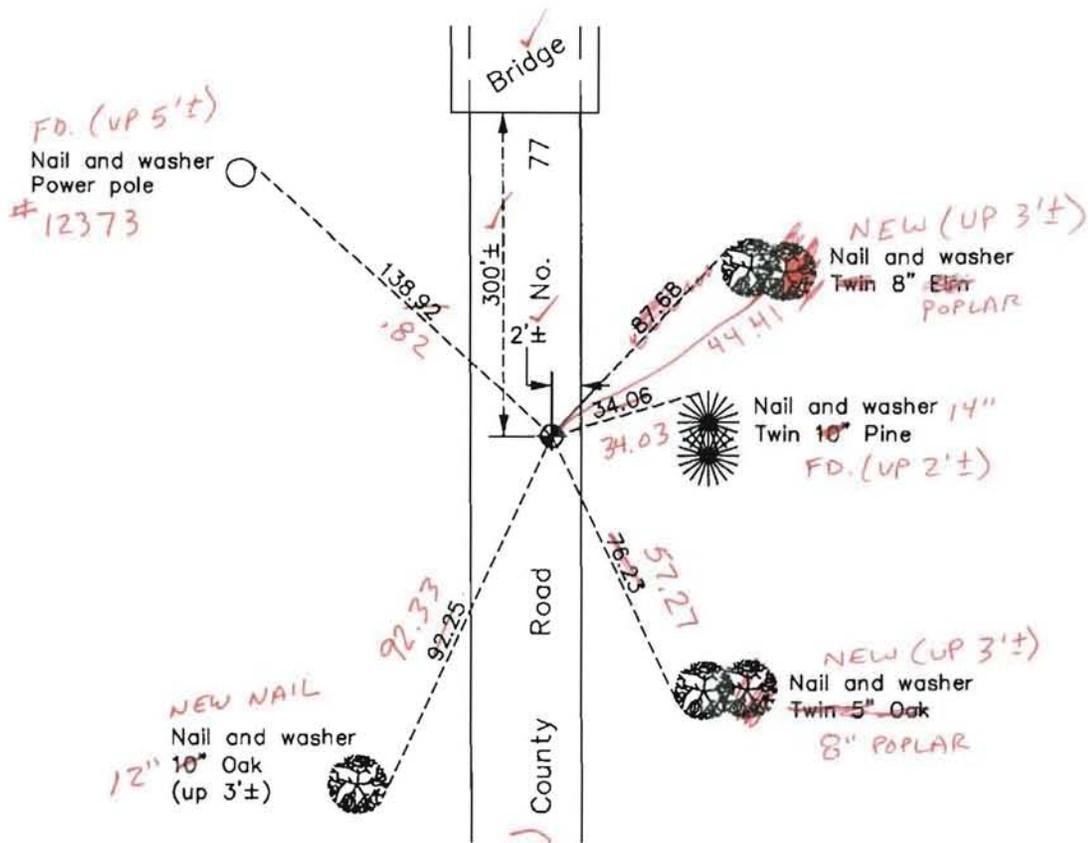

Revision Date
12/06/10

N.A.D. 1983 Coordinates
(1996 Adjustment)

County Project Coordinates	
Northing	229422.8519
Easting	563690.3686
Date	2/09/04

I hereby certify that this United States public land survey monument record is correct and complete to the best of my knowledge and belief.

Larry D. Hoium Date 12/06/10

Larry D. Hoium, Anoka County Surveyor

Minnesota License Number 18165

2-5-14
BK-SS T/T

CERTIFICATE OF LOCATION OF GOVERNMENT CORNER

County of Anoka


State of Minnesota

EAST QUARTER Corner of Sec. 36 Township 34 Range 22


I hereby certify that on the 24th day of JUNE, 1975, I found the described corner which was evidenced by AREA - RESURVEY

and I further certify that to perpetuate the location of said corner, I did, at the exact location thereof, place a permanent marker consisting of CAST IRON MONUMENT

which reference or witness monuments are located in the manner following:

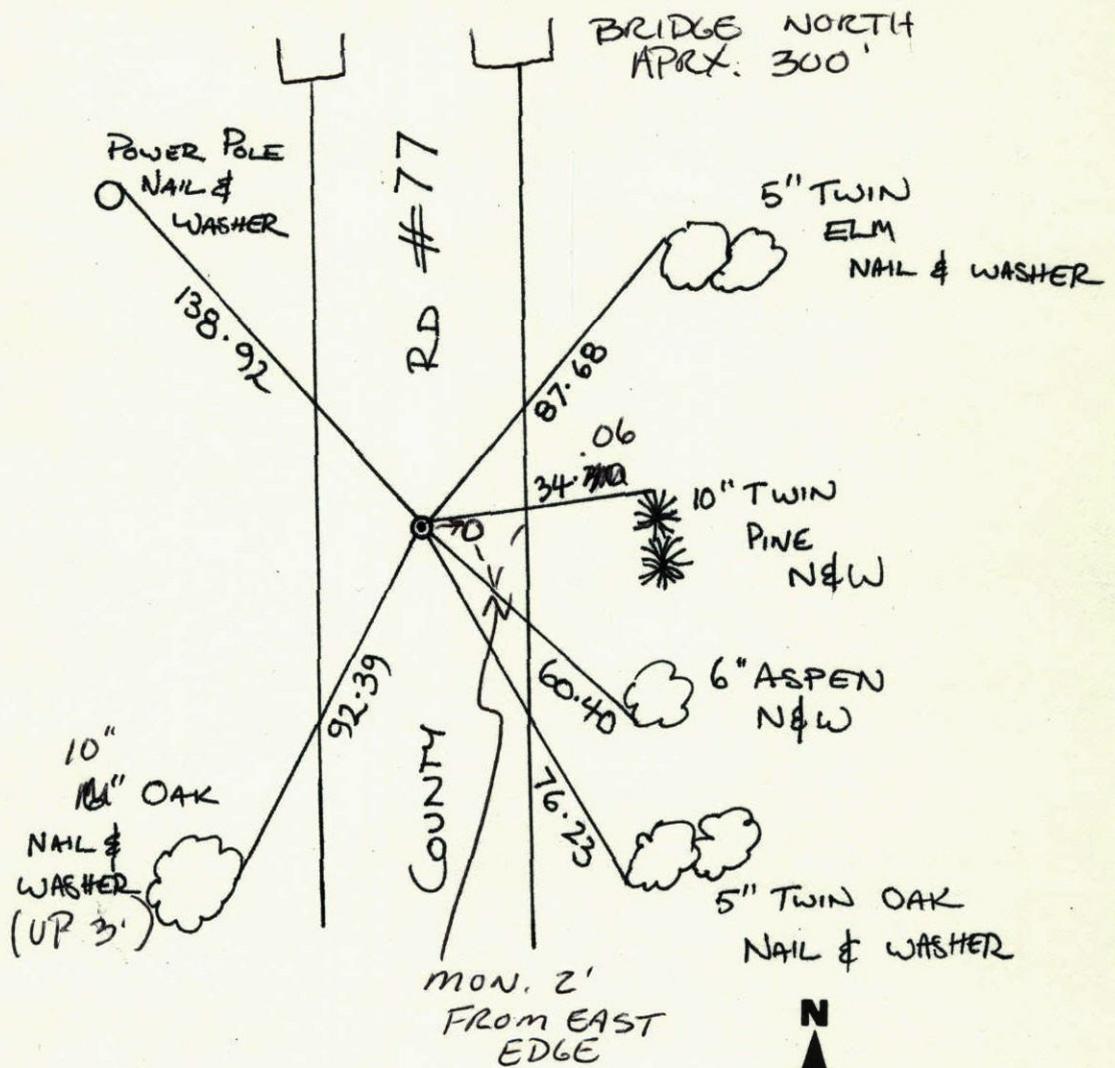

Revised date	Revised date	Revised date
7-5-86		
6-14-93		
7-30-03	REPLACED/TIED	

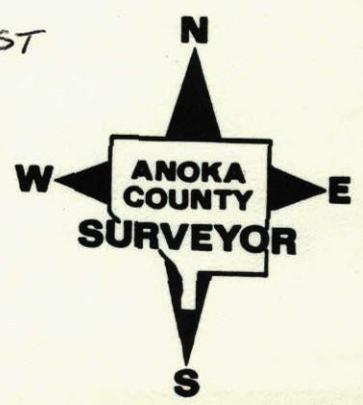

PULL REMOVE

CERTIFICATE OF LOCATION OF GOVERNMENT CORNER

County of Anoka


State of Minnesota

EAST QUARTER Corner of Sec. 36 Township 34 Range 22

I hereby certify that on the 24th day of JUNE, 1975, I found the described corner which was evidenced by AREA - RESURVEY

and I further certify that to perpetuate the location of said corner, I did, at the exact location thereof, place a permanent marker consisting of CAST IRON MONUMENT


which reference or witness monuments are located in the manner following:

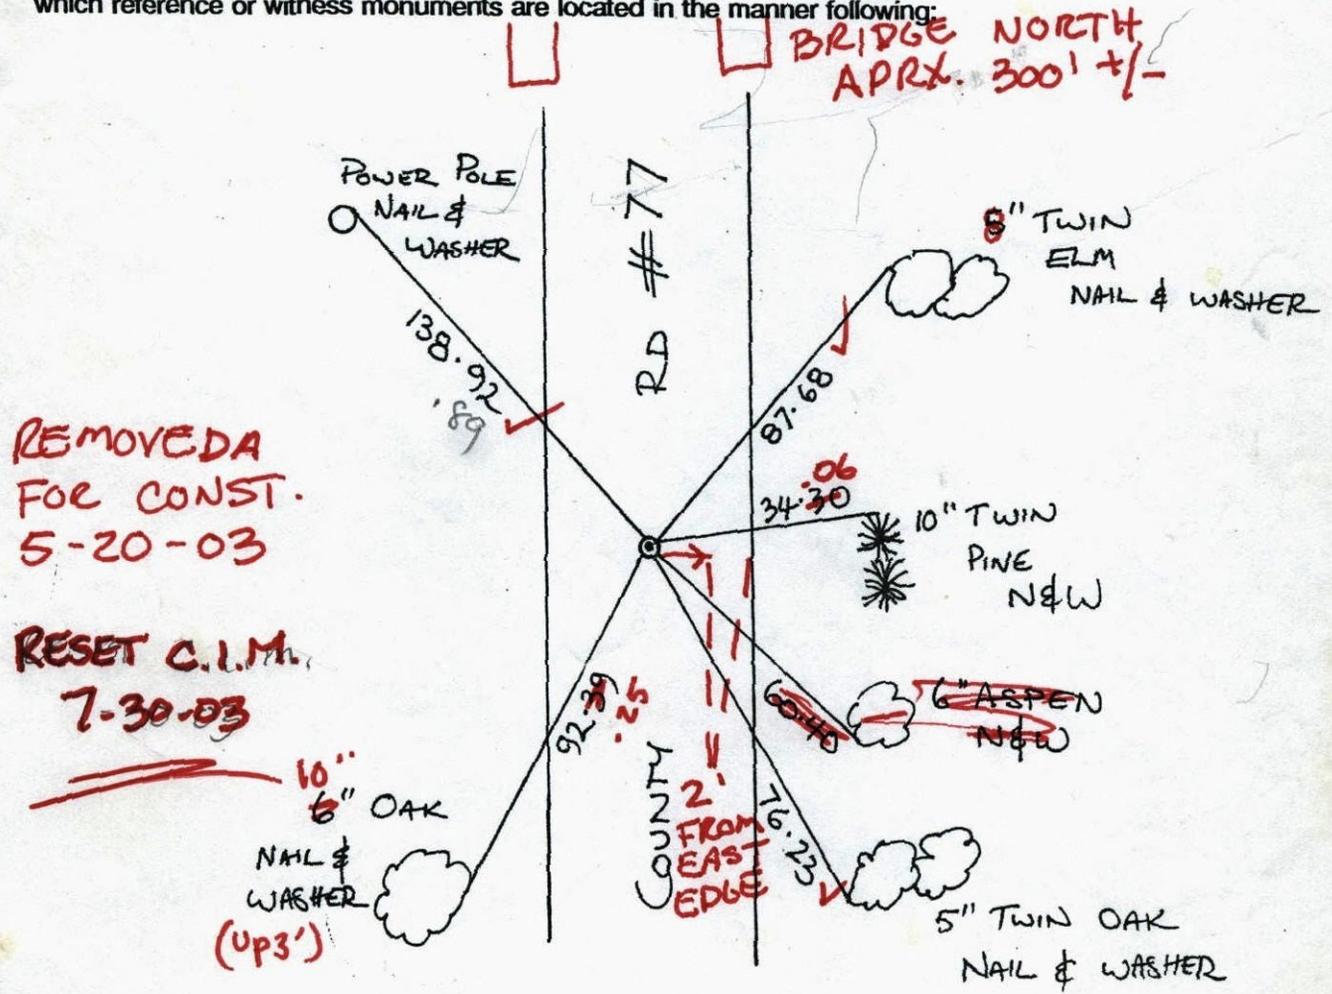

REMOVED A FOR CONST. 5-20-03


RESET C.I.M. 7-30-03

Revised date	Revised date	Revised date
7-5-86		
6-14-93		

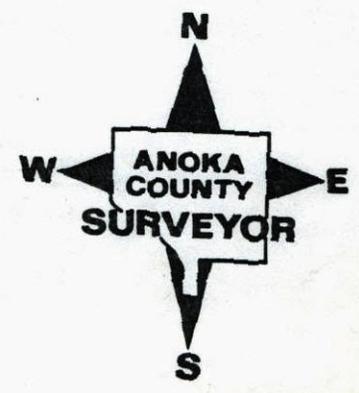

REDRAWN 12/06/10 LAF


TRANSIT TIE 40
 E 1/4 COR SEC. 36 T 34 R 22
 RETIED & PULLED CAST IRON MON.
 FOR CONSTRUCTION.

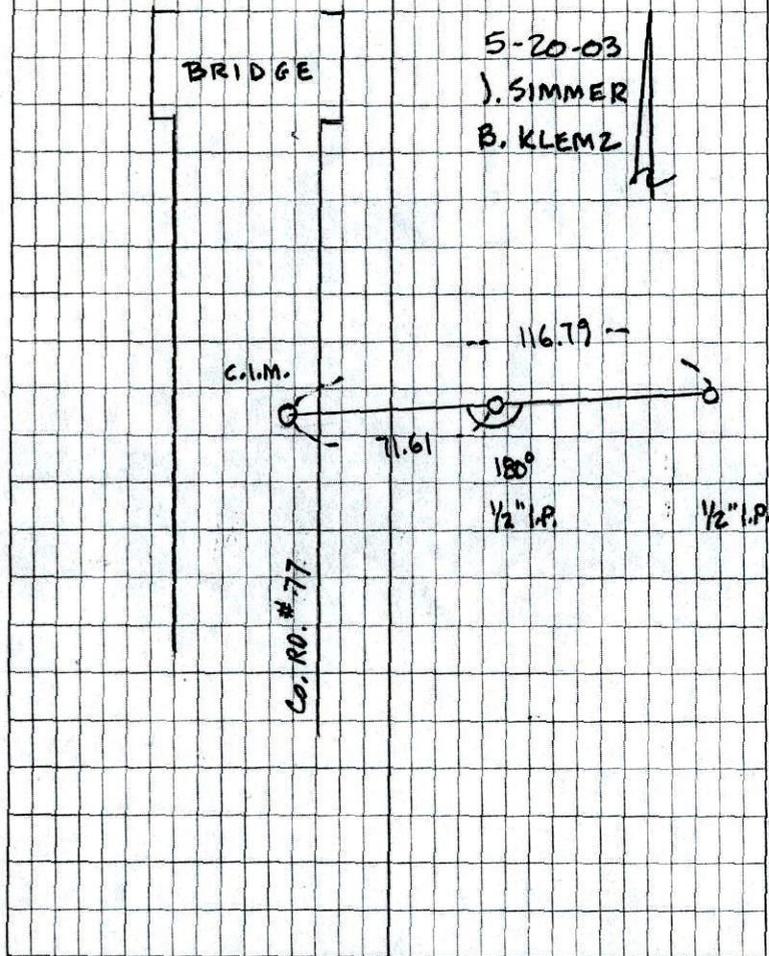


116.79
 71.61

 45.18

E 1/4 COR SEC. 36 T34 R 22
 RETIED & PULLED CAST IRON MON.
 FOR CONSTRUCTION.

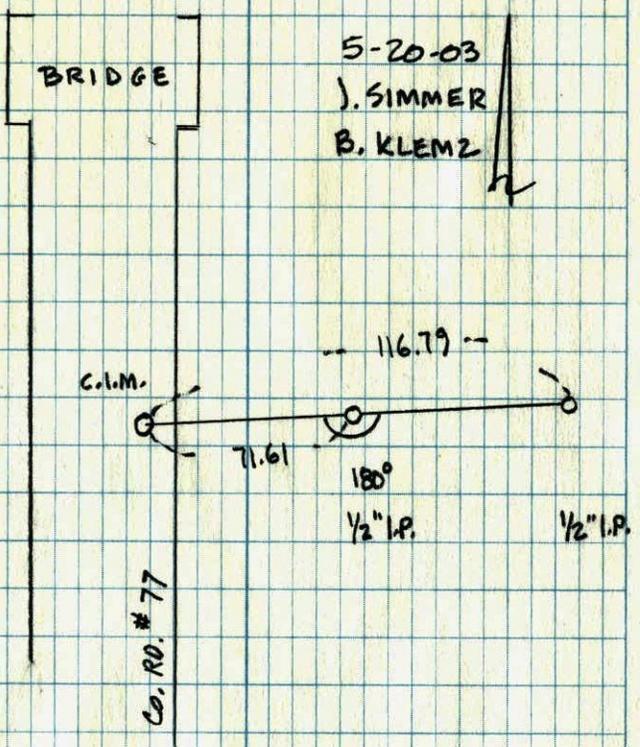

EAST 1/4 COR SEC 36 T34 R 22
 RETIE CAST IRON MONUMENT

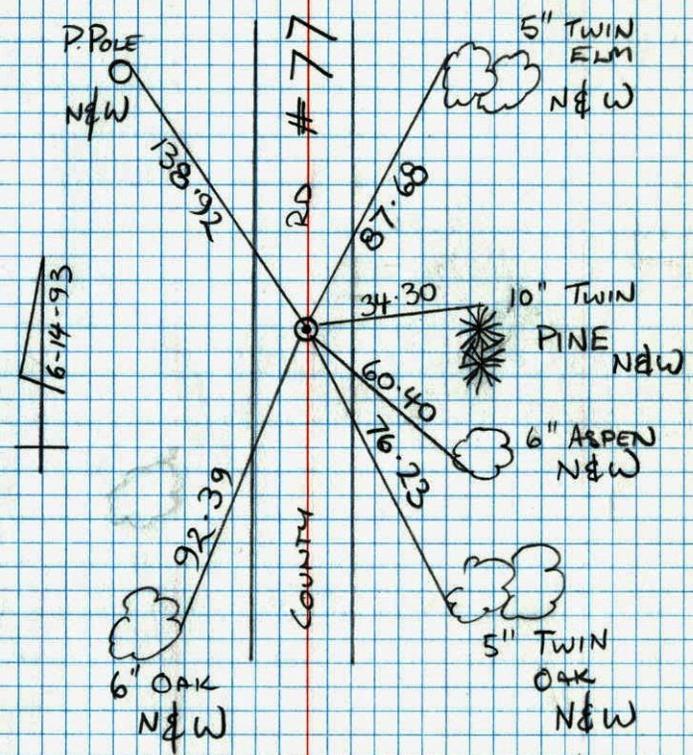


JAMIE ANDERSON
 JOSH ANDERSON

40
E 1/4 Cor. Sec 36 - T34 - R22

Set P.K. Spike From Area Resurvey
Set Cast Iron Monument Flush With PK's
2.00' North & West.

6-24-75
H. Larson
R. Guetzko
J. Beottcher

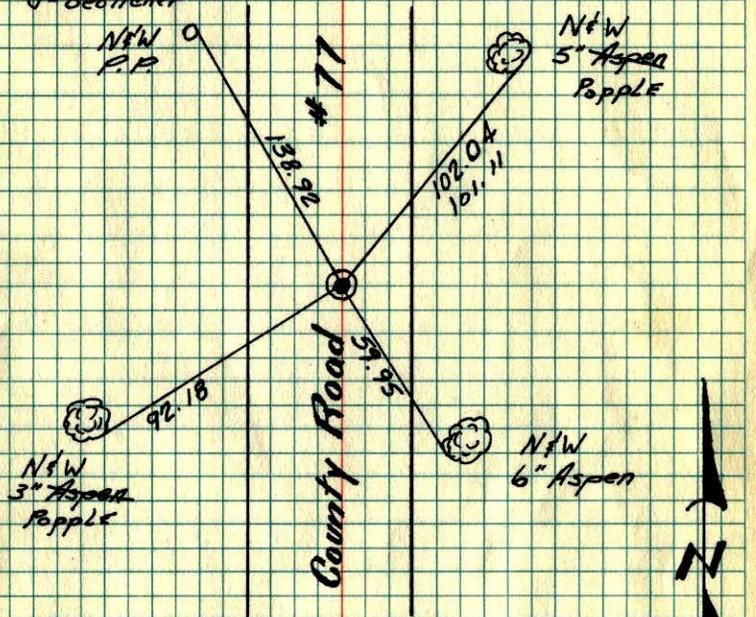

6-4-75
H. Larson
R. Guetzko
J. Beottcher

Tie Check
8-14-78
M. Kisrow
B. Stephens

TEMPERATURE CORRECTED
AND HORIZONTALLY
TAPED MEASUREMENTS


ROLAND W. ANDERSON
COUNTY SURVEYOR
ANOKA COUNTY, MINNESOTA

E 1/4 Cor. Sec. 36 T34 R22

Set PK spike from area resurvey.
Set cast iron monument flush
with PK's 2.00' N+W.

6-24-75
H. Larson
R. Guetzko
J. Beottcher

6-4-75
H. Larson
R. Guetzko
J. Beottcher

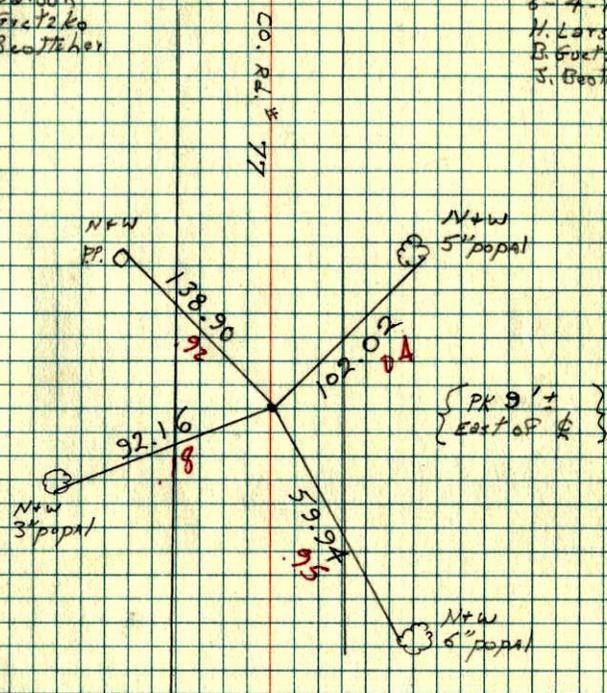

TEMPERATURE CORRECTED
AND HORIZONTALLY
TAPED MEASUREMENTS

ROLAND W. ANDERSON
COUNTY SURVEYOR
ANOKA COUNTY, MINNESOTA