43

S.W. Cor. Sec 35 - T34 - R22

Set Red & White Iron Pipe From Area Resurvey. I.P. Up 2.5'±

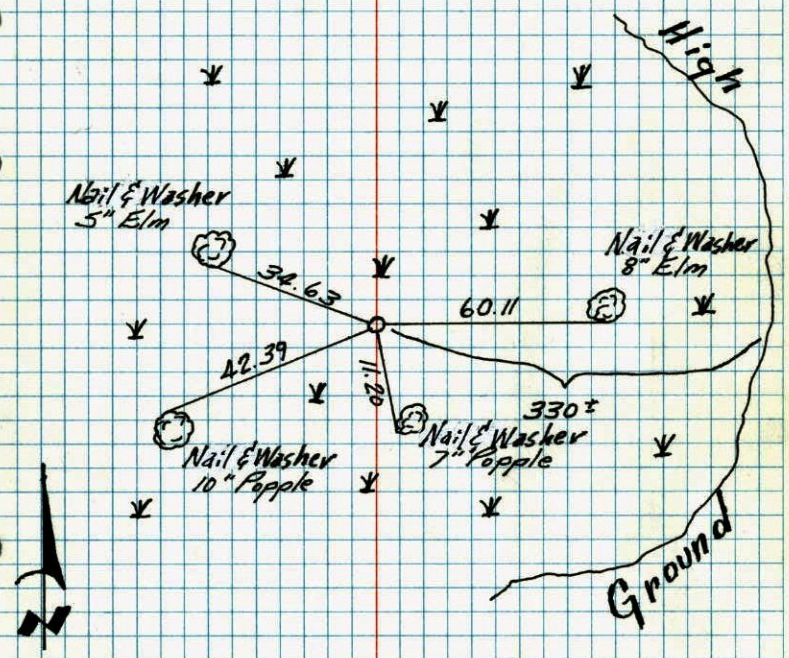

12-30-75
H. Larson
R. Guetzko
J. Boettcher

WET 1982

TEMPERATURE CORRECTED AND HORIZONTALLY TAPED MEASUREMENTS

ROLAND W. ANDERSON
COUNTY SURVEYOR
ANOKA COUNTY, MINNESOTA

43

SW Cor. Sec. 35 T34 R22
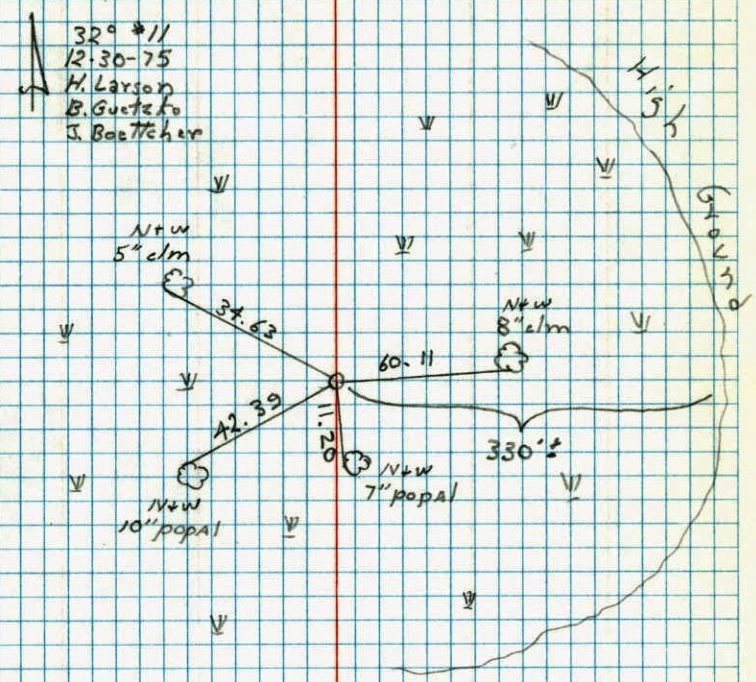
Set red + white iron pipe from area resurvey I.P. up 2.5'±