S 1/4 COR. SEC. 34-T34-R22

SET RED & WHITE IRON PIPE FROM AREA RESURVEY.
IRON PIPE UP 3.5'± WITH SIGN ATTACHED.

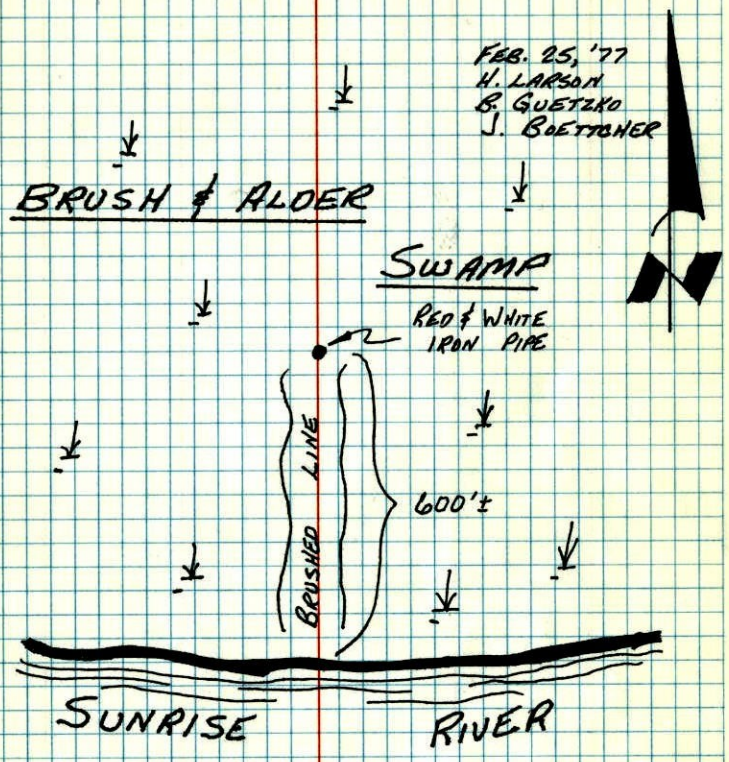

WET 1982

TEMPERATURE CORRECTED AND HORIZONTALLY TAPED MEASUREMENTS

ROLAND W. ANDERSON
COUNTY SURVEYOR
ANOKA COUNTY, MINNESOTA

S 1/4 Cor. Sec. 34 T34 R22
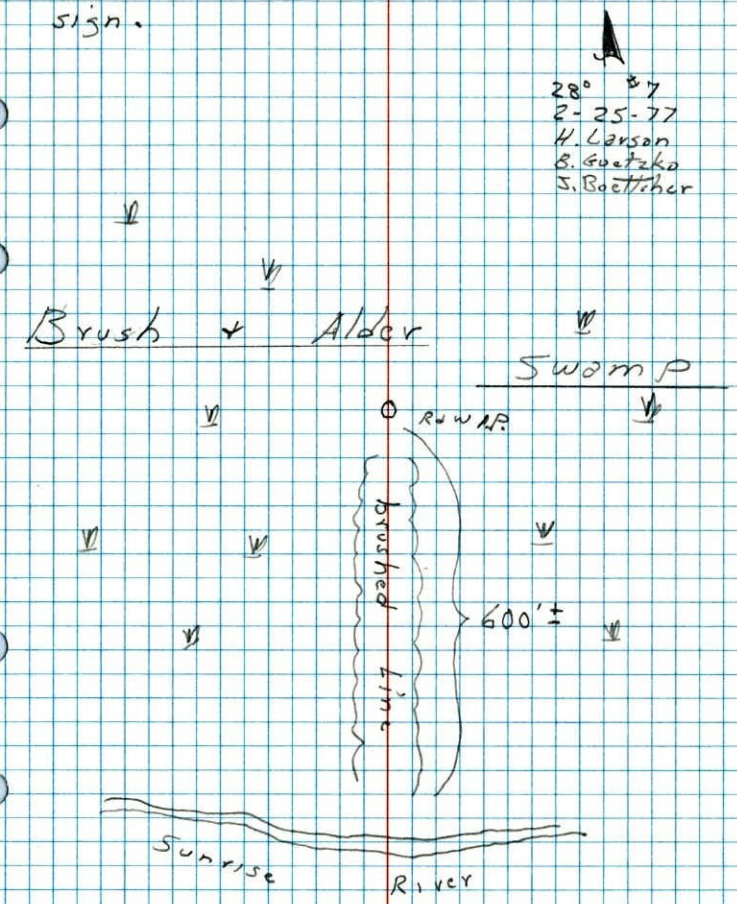
Set red and white iron pipe from area resurvey. I.P. up 3.5'± with sign.