S 1/4 Cor. Sec. 32 T34 R22

Set 1½" red and white iron pipe from area resurvey.

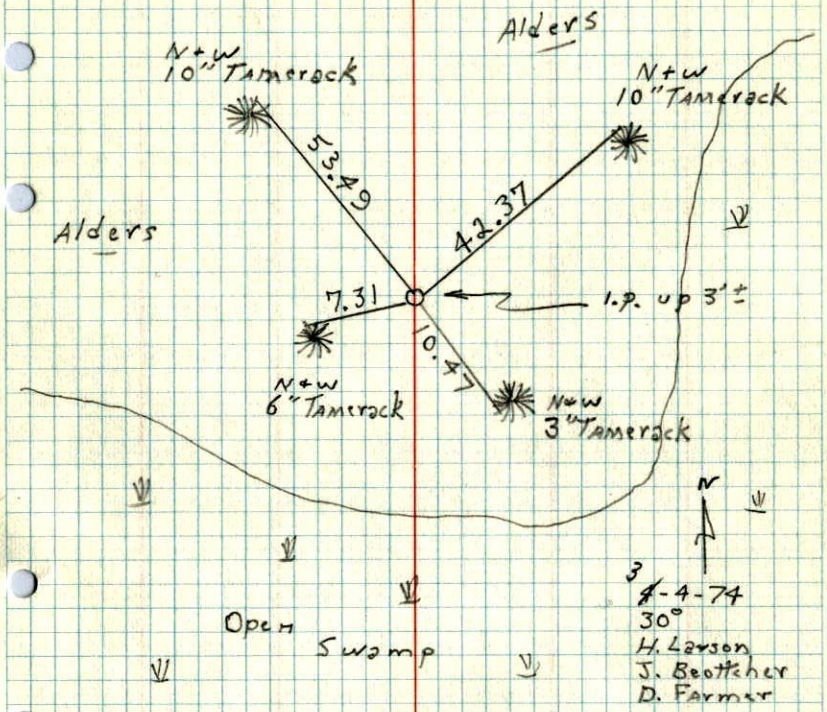

S 1/4 Cor. Sec. 32 T34 R22

H. Larson
J. Boettcher
D. Farmer

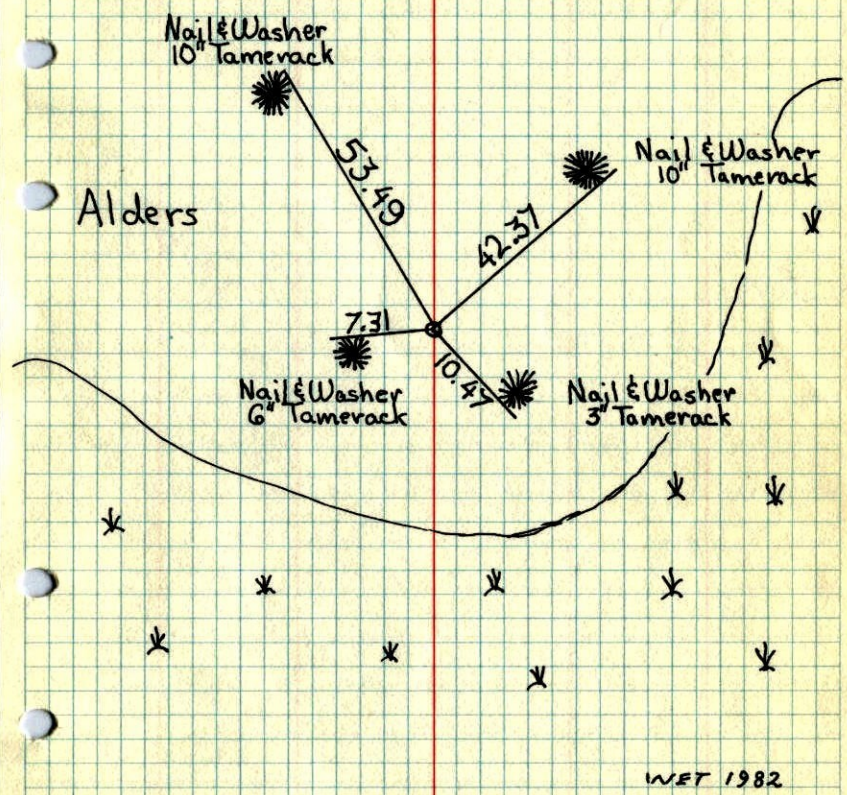

ROLAND W. ANDERSON
COUNTY SURVEYOR
ANOKA COUNTY, MINNESOTA

TEMPERATURE CORRECTED AND HORIZONTALLY TAPED MEASUREMENTS