Southwest corner Sec 32

CAST IRON MON T34 R22

Retie

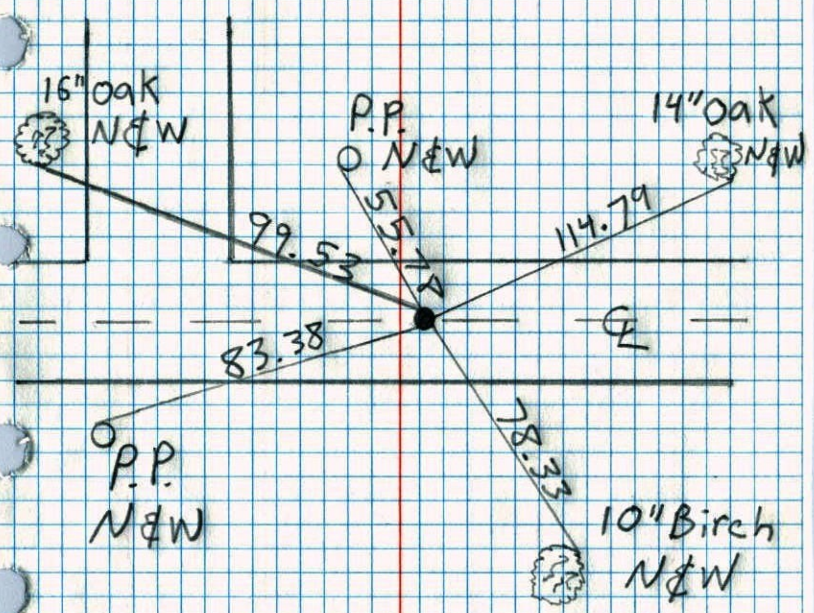

48

SW Cor. Sec. 32 T34 R22

Set cast iron monument from area resurvey

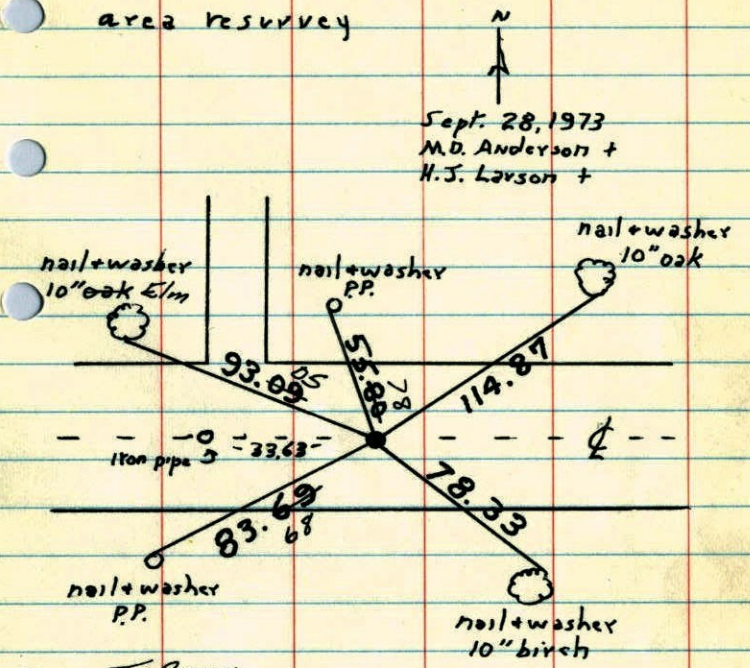

TIE CHECK
8-1-75
O. OAHL
B. SANDERUD
G. ADAMS

ROLAND W. ANDERSON
COUNTY SURVEYOR
ANOKA COUNTY, MINNESOTA

TEMPERATURE CORRECTED AND HORIZONTALLY TAPED MEASUREMENTS

TIE CHECK
8-14-78
B. STEPHENS
M. KISROW

TIE CHECK
5-29-82
P. ROSS
B. NICHOLAS

S.W. Cor. Sec. 32-T34-R22
Set C.I. Mon. From arca resurvey
In ℄ Blacktop Road

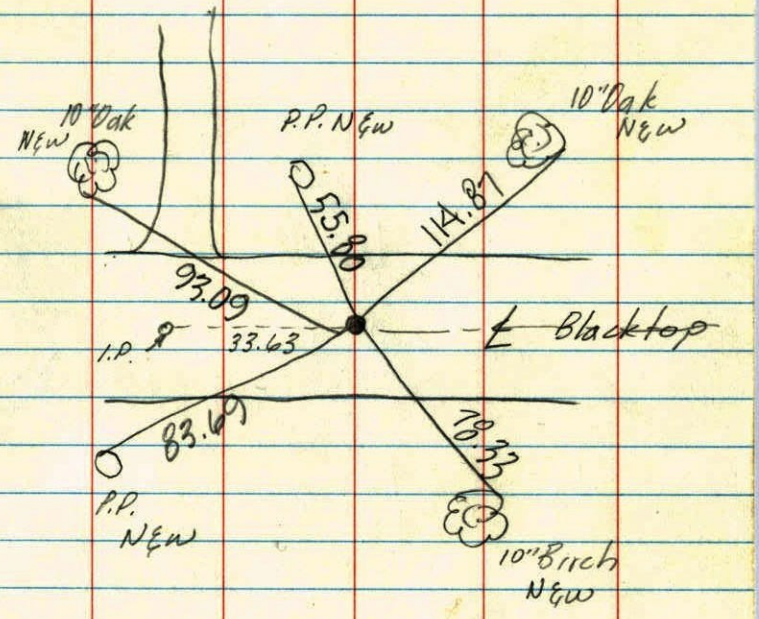

RDL

ANOKA COUNTY, MINNESOTA

Sept. 28, 1973
M.O. Anderson +
H.J. Larson +
temp. 65°
tape # 12