

CERTIFICATE OF LOCATION OF GOVERNMENT CORNER

County of Anoka


State of Minnesota

NORTHEAST Corner of Sec. 25 Township 34 Range 23


I hereby certify that on the 3 day of OCT, 1978, I found the described corner which was evidenced by AREA RESURVEY

and I further certify that to perpetuate the location of said corner, I did, at the exact location thereof, place a permanent marker consisting of RED AND WHITE IRON PIPE

which reference or witness monuments are located in the manner following:

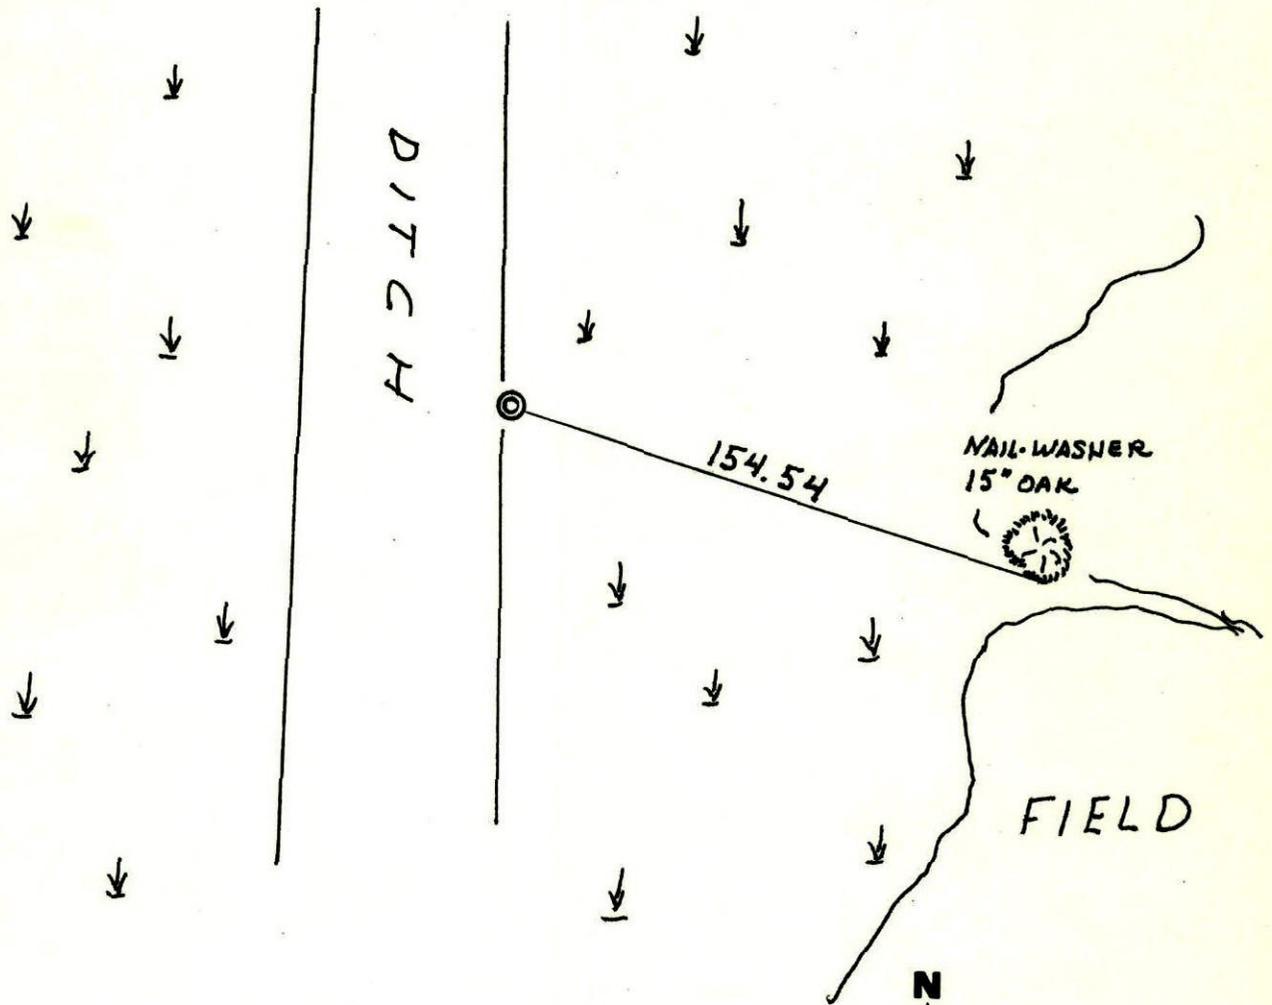


Revised date	Revised date	Revised date
6-15-82		
6-29-95		

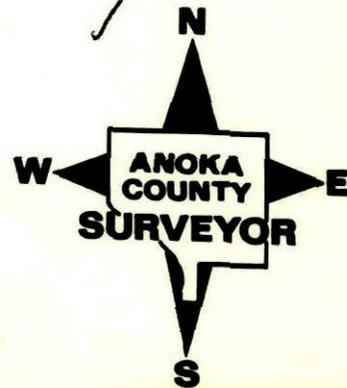

NE CORNER Sec. 25 Tw. 34 R. 23


RETIE RED/WHITE I.P.

REMOVE SIGN

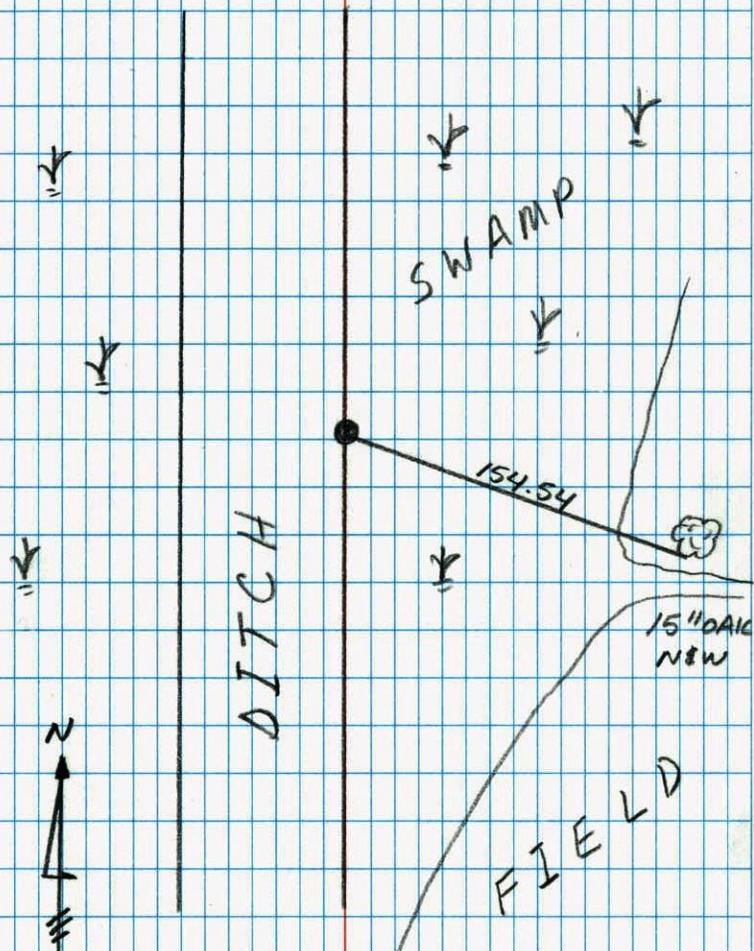JOSH & JASON
ANDERSON

6-29-95

N.E. COR. SECTION 25-T34-R23

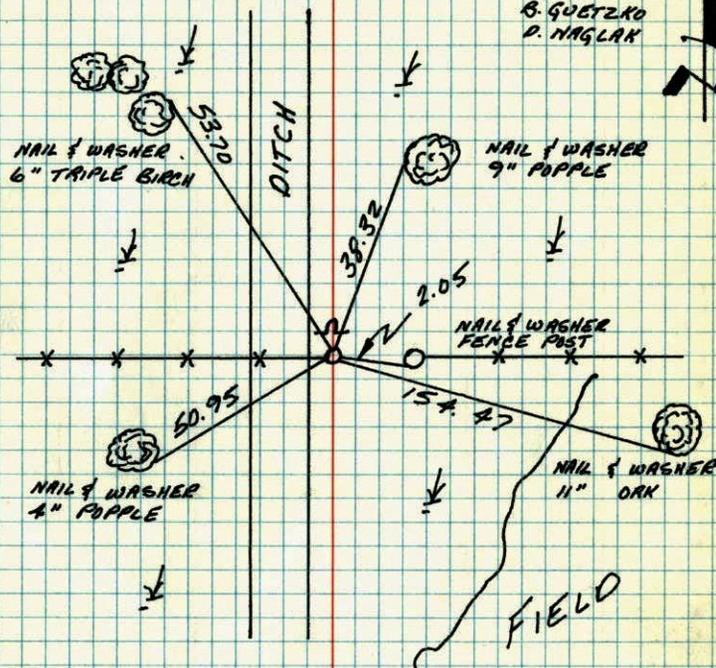SET RED AND WHITE IRON PIPE FROM AREA
RESURVEY. IRON PIPE ON EDGE OF DITCH.
SET SIGN AND POST ON NORTH SIDE.3 OCT 78
H. LARSON
B. GUETZKO
D. NAGLAKTIE CHECK
6-15-82
P. ROSS
P. HORNBY
S. BEIERTEMPERATURE CORRECTED
AND HORIZONTALLY
TAPED MEASUREMENTSROLAND W. ANDERSON
COUNTY SURVEYOR
ANOKA COUNTY, MINNESOTA


NE Cor. Section 25 T34 R23

Set $\frac{1}{2}$ " iron pipe from area
resurvey. I.P. on edge of ditch

Set Post and sign on North side
SET R₁W I.P.

11-2-78
H. LARSON

#1 60°
10-3-78
H. Larson
B. Gutzko
D. Naglak

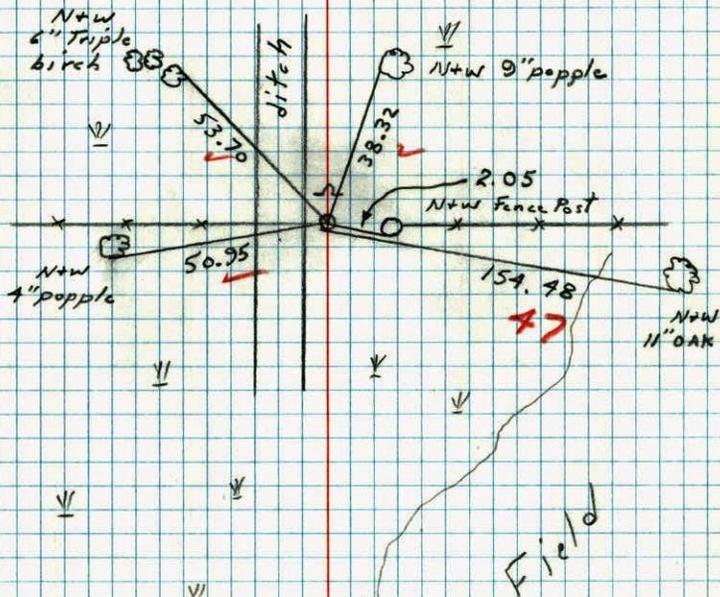

NO. 448

WILSON