Page No. 57

CERTIFICATE OF LOCATION OF GOVERNMENT CORNER

County of Anoka State of Minnesota

Northwest Corner of Sec. 27 Township 34 Range 23

On the 6th day of December, 1976, the described corner was evidenced by area resurvey

and to perpetuate the location of said corner, at the exact location thereof, a permanent marker was placed consisting of a red and white iron pipe with a sign attached (SIGN FACING N.W.)

AND on the ___ day of _____, ____, said permanent marker was _____

Updated reference ties are as shown below.

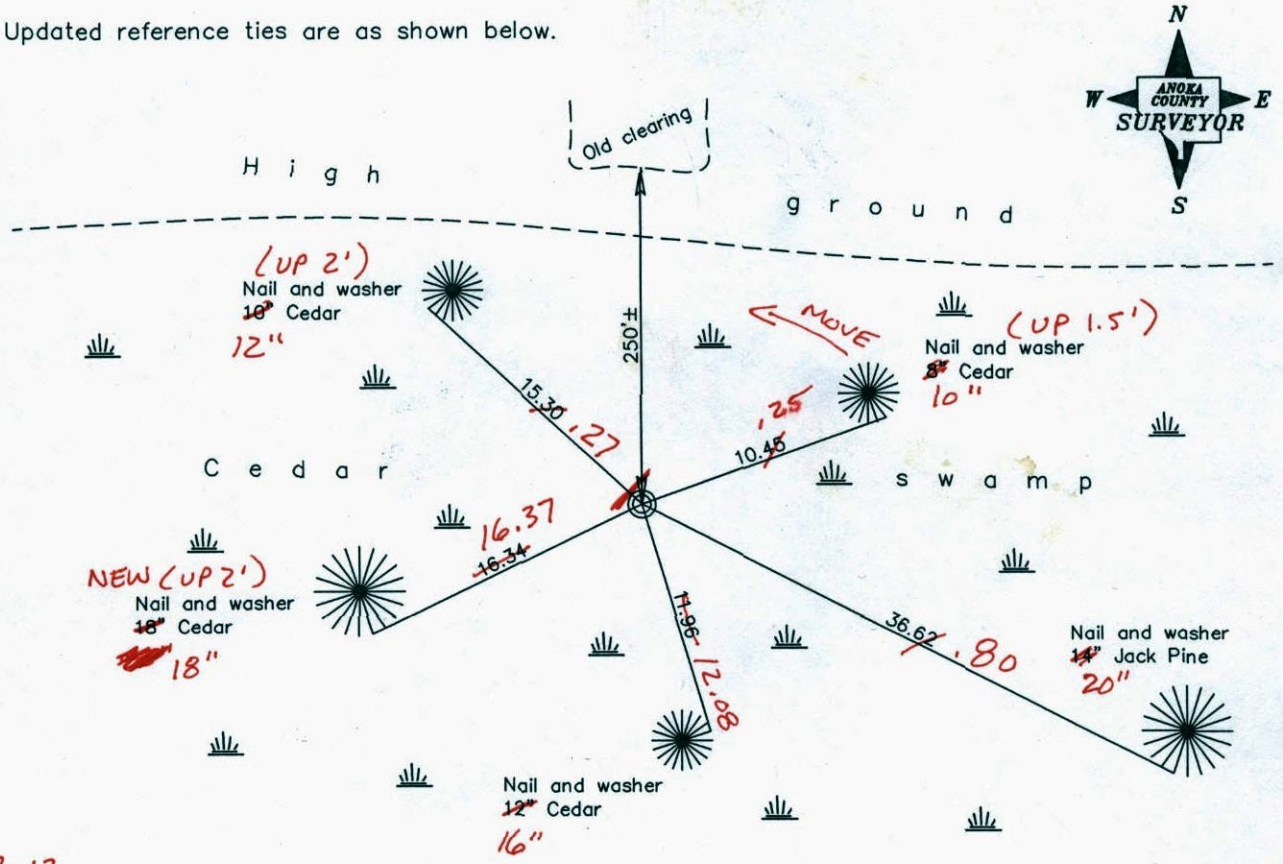

12-27-12

BK - 55

TAPED

Revised date
3/31/88
9/11/92

N.A.D. 1983 Coordinates
(1996 Adjustment)

County Project Coordinates	
Northing	238214.5803
Easting	516036.9624
Date	4/14/03

I hereby certify that this United States public land survey monument record is correct and complete to the best of my knowledge and belief.

_____ Date _____

_____, Anoka County Surveyor

Minnesota License Number _____

CERTIFICATE OF LOCATION OF GOVERNMENT CORNER

County of Anoka *State of Minnesota*

NORTHWEST Corner of Sec. 27 Township 34 Range 23

I hereby certify that on the 6 *day of* DEC. , 1976, *I found the described corner which was evidenced by* AREA RE-SURVEY

and I further certify that to perpetuate the location of said corner, I did, at the exact location thereof, place a permanent marker consisting of RED, WHITE I.P. W. SIGN

which reference or witness monuments are located in the manner following:

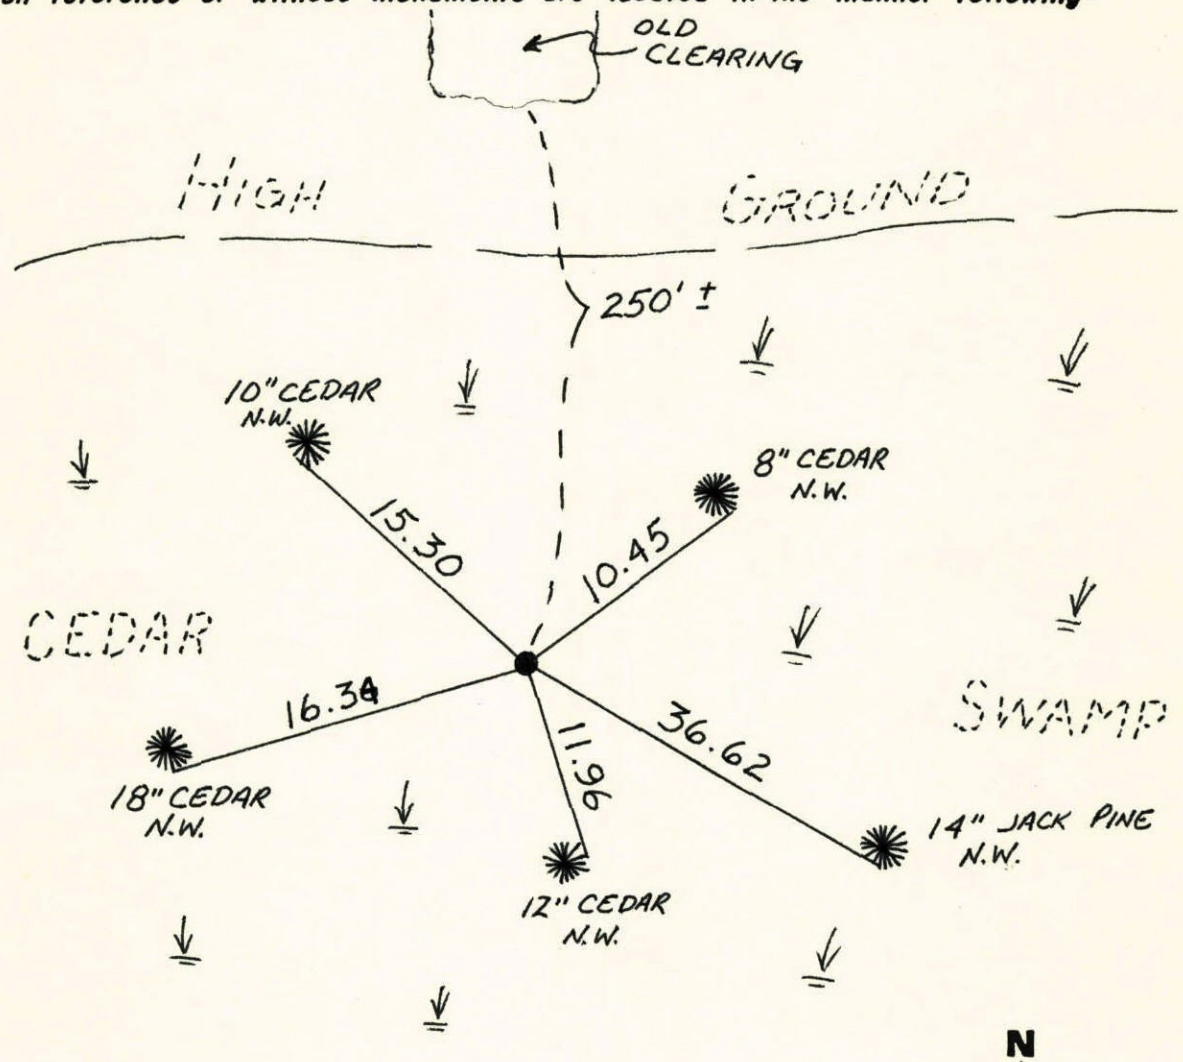

Revised date	Revised date	Revised date
3-31-88		
9-11-92		

N
W ANOKA COUNTY SURVEYOR E
S

N.W. COR. SEC. 27 - T34 - R23

SET RED AND WHITE IRON PIPE FROM AREA RESURVEY. IRON PIPE UP 3'±.

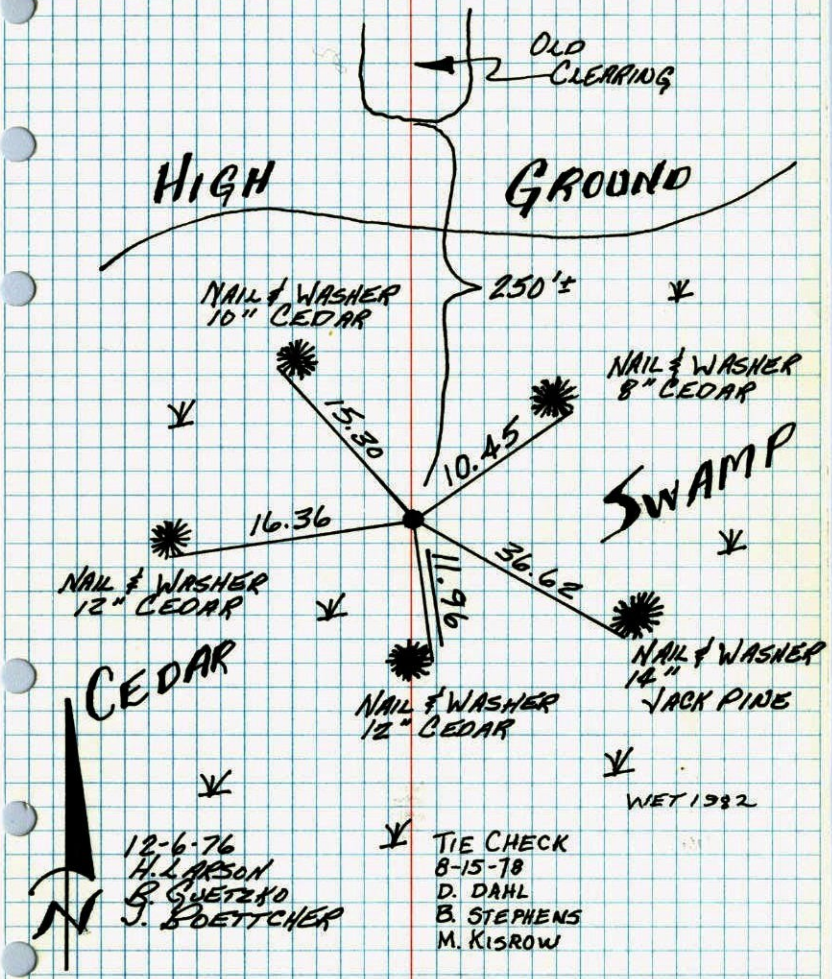

12-6-76
H. LARSON
B. GUETZKO
J. BOETTCHER

TIE CHECK
8-15-78
D. DAHL
B. STEPHENS
M. KISROW

TEMPERATURE CORRECTED AND HORIZONTALLY TAPED MEASUREMENTS

ROLAND W. ANDERSON
COUNTY SURVEYOR
ANOKA COUNTY, MINNESOTA

NW Cor Sec. 27 T 34 R23
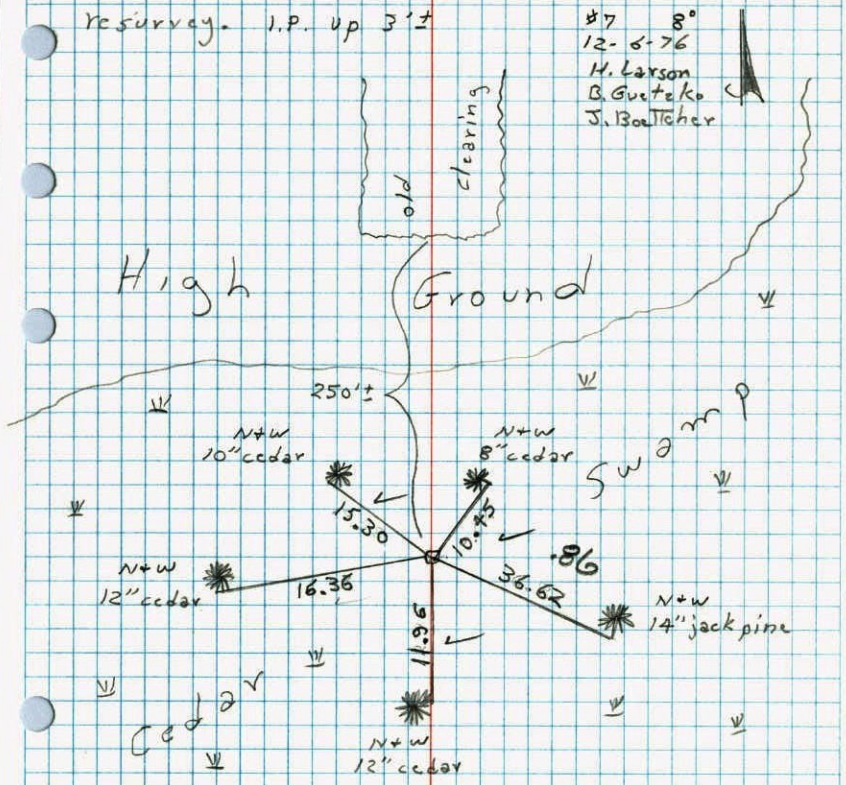
Set red+white iron pipe from area resurvey. I.P. up 3'±