

CERTIFICATE OF LOCATION OF GOVERNMENT CORNER

County of Anoka State of Minnesota


North $\frac{1}{4}$ Corner of Sec. 28 Township 34 Range 23

On the 3rd day of May, 1977, the described corner was evidenced by area resurvey

and to perpetuate the location of said corner, at the exact location thereof, a permanent marker was placed consisting of a red and white iron pipe with a sign attached - FACING SOUTH

AND on the ___ day of _____, _____, said permanent marker was _____

Updated reference ties are as shown below.

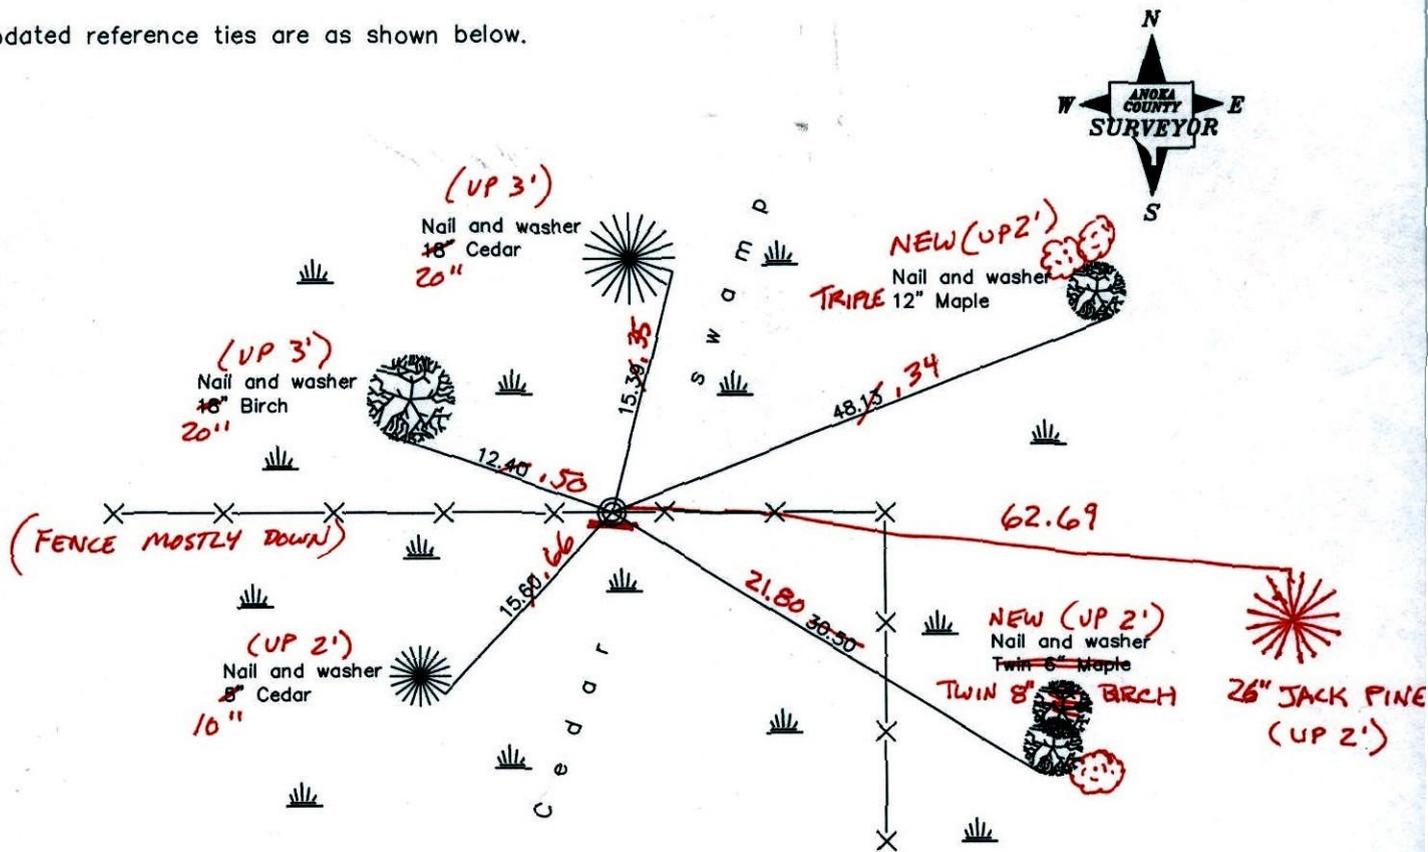

11-1-12
BK-SS
TAPED

Revised date
9/11/92

N.A.D. 1983 Coordinates (1996 Adjustment)	
County Project Coordinates	
Northing	<u>238155.7422</u>
Easting	<u>513425.5155</u>
Date	<u>4/14/03</u>

I hereby certify that this United States public land survey monument record is correct and complete to the best of my knowledge and belief.

_____, Date _____

_____, Anoka County Surveyor

Minnesota License Number _____

CERTIFICATE OF LOCATION OF GOVERNMENT CORNER

County of Anoka


State of Minnesota

NORTH QTR. Corner of Sec. 28 Township 34 Range 23


I hereby certify that on the 3 day of MAY, 19 77, I found the described corner which was evidenced by AREA RESURVEY

and I further certify that to perpetuate the location of said corner, I did, at the exact location thereof, place a permanent marker consisting of RED, WHITE I.P. WITH SIGN

which reference or witness monuments are located in the manner following:

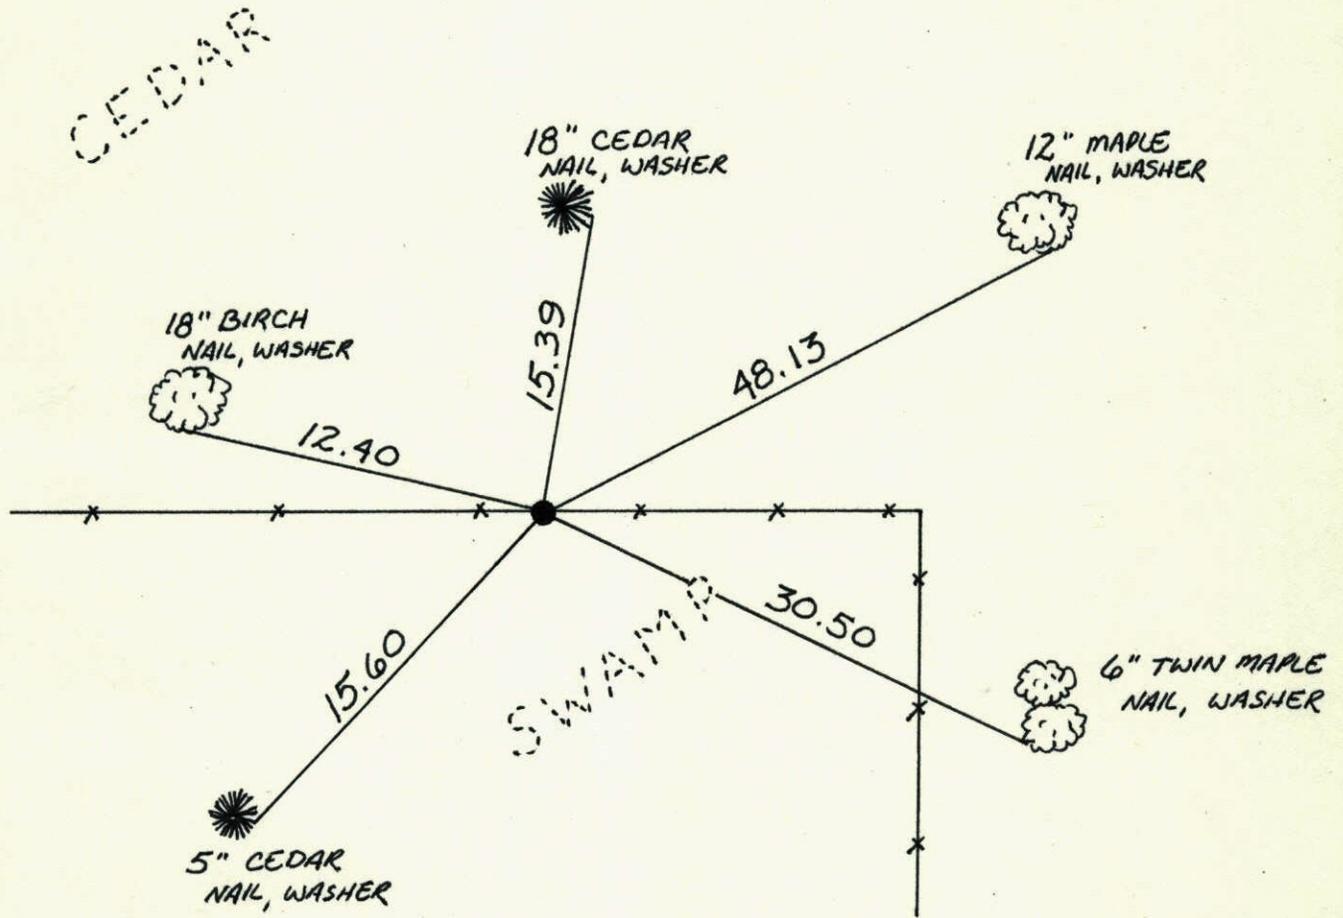


Revised date	Revised date	Revised date
9-11-92		

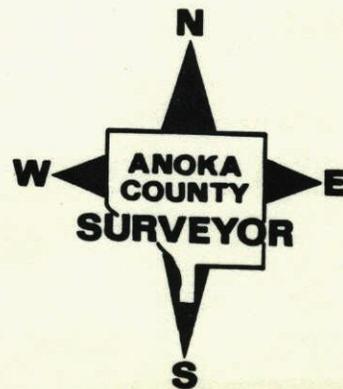

N 1/4 COR. SEC. 28-T34-R23

SET RED & WHITE IRON PIPE FROM AREA RESURVEY!

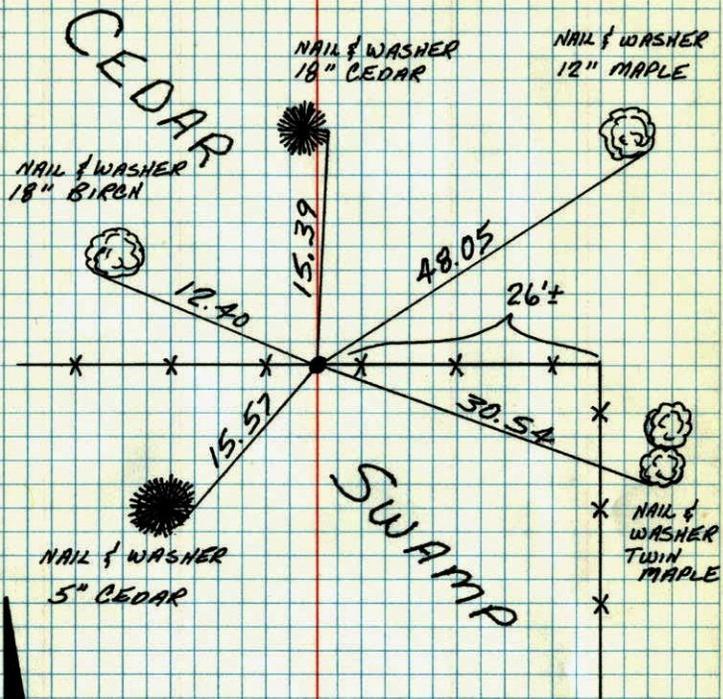

MAY 3, '77
H. LARSON
B. GUETZKO
J. BOETTCHER


WET 1982

TEMPERATURE CORRECTED
AND HORIZONTALLY
TAPED MEASUREMENTS

ROLAND W. ANDERSON
COUNTY SURVEYOR
'ANOKA COUNTY, MINNESOTA'

N 1/4 Cor. Sec. 28 T34 R23

Set red and white iron pipe from area
resurvey

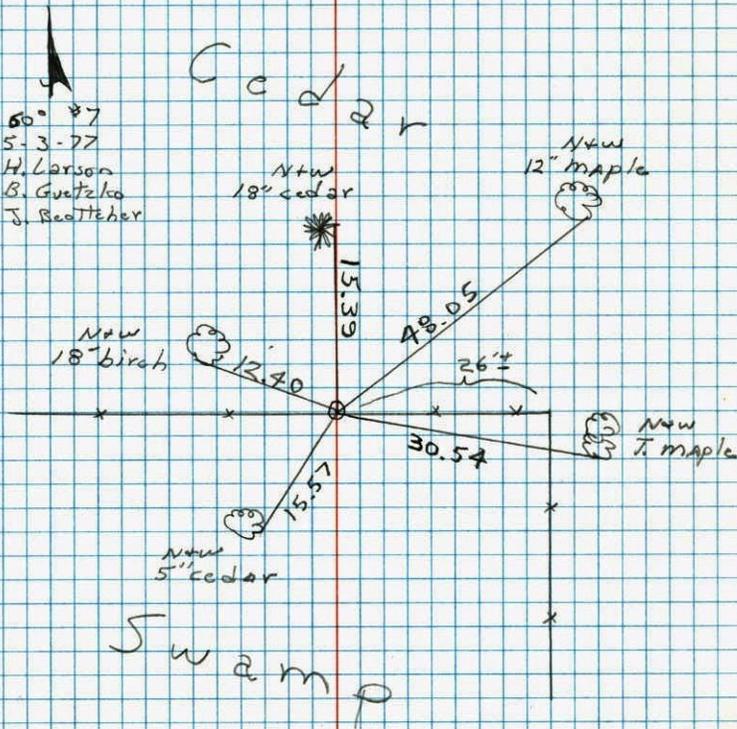

50' #7
5-3-77
H. Larson
B. Guetzko
J. Boettcher

TEMPERATURE CORRECTED
AND HORIZONTALLY
TAPED MEASUREMENTS

ROLAND W. ANDERSON
COUNTY SURVEYOR
'ANOKA COUNTY, MINNESOTA'