

CERTIFICATE OF LOCATION OF GOVERNMENT CORNER

County of Anoka State of Minnesota


Northwest Corner of Sec. 28 Township 34 Range 23

On the 15th day of April, 1976, the described corner was evidenced by a concrete monument with an iron pipe on the north side

and to perpetuate the location of said corner, at the exact location thereof, a permanent marker was placed consisting of a cast iron monument (down 0.2' I)

AND on the ___ day of _____, _____, said permanent marker was _____

Updated reference ties are as shown below.

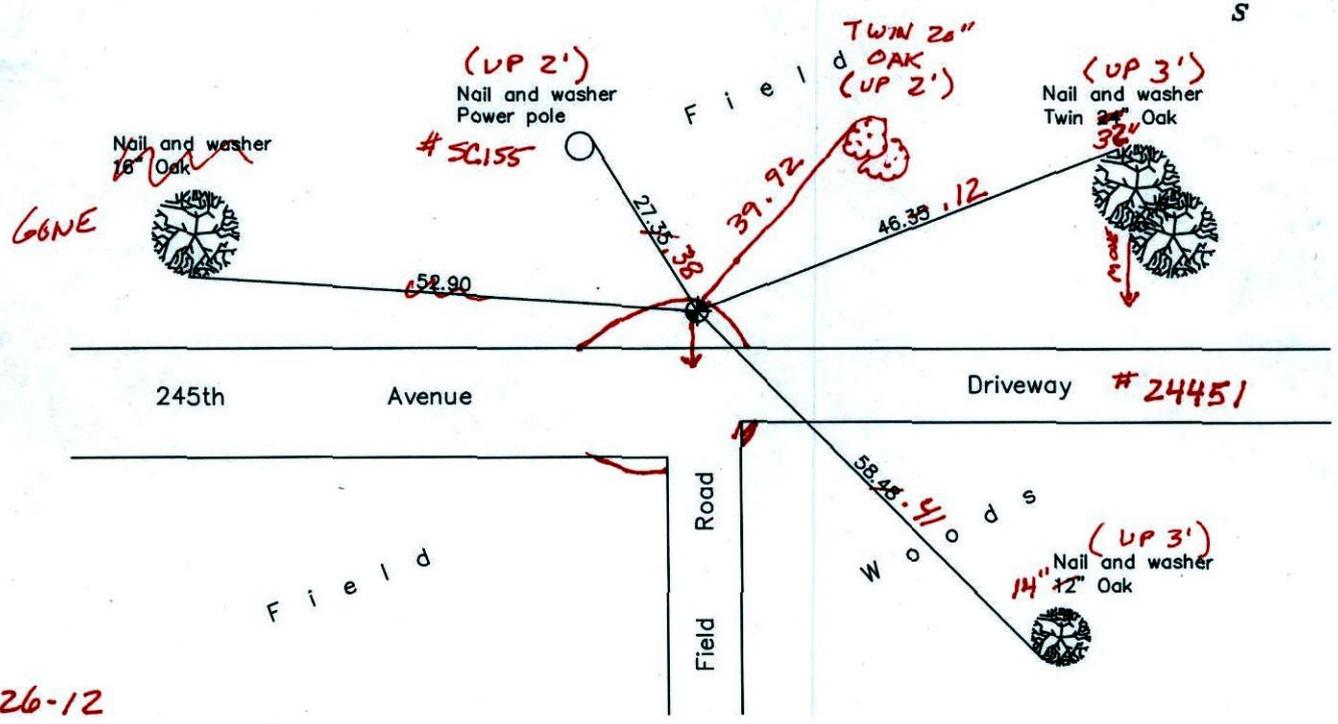

10-26-12
BK-SS

T/T - VRS Revised date

11/07/90
8/05/92
8/12/97

N.A.D. 1983 Coordinates (1996 Adjustment)

County Project Coordinates	
Northing	238033.6752
Easting	510743.3627
Date	3/27/03

I hereby certify that this United States public land survey monument record is correct and complete to the best of my knowledge and belief.

_____, Anoka County Surveyor
Minnesota License Number _____

VRS 3D=0.08

N=238033.6710

E=510743.3591

CERTIFICATE OF LOCATION OF GOVERNMENT CORNER

County of Anoka


State of Minnesota

NORTHWEST Corner of Sec. 28 Township 34 Range 23


I hereby certify that on the 15 day of APRIL, 1976, I found the described corner which was evidenced by CONCRETE-MONUMENT WITH IRON PIPE ON NORTH SIDE

and I further certify that to perpetuate the location of said corner, I did, at the exact location thereof, place a permanent marker consisting of CAST IRON MONUMENT

which reference or witness monuments are located in the manner following:

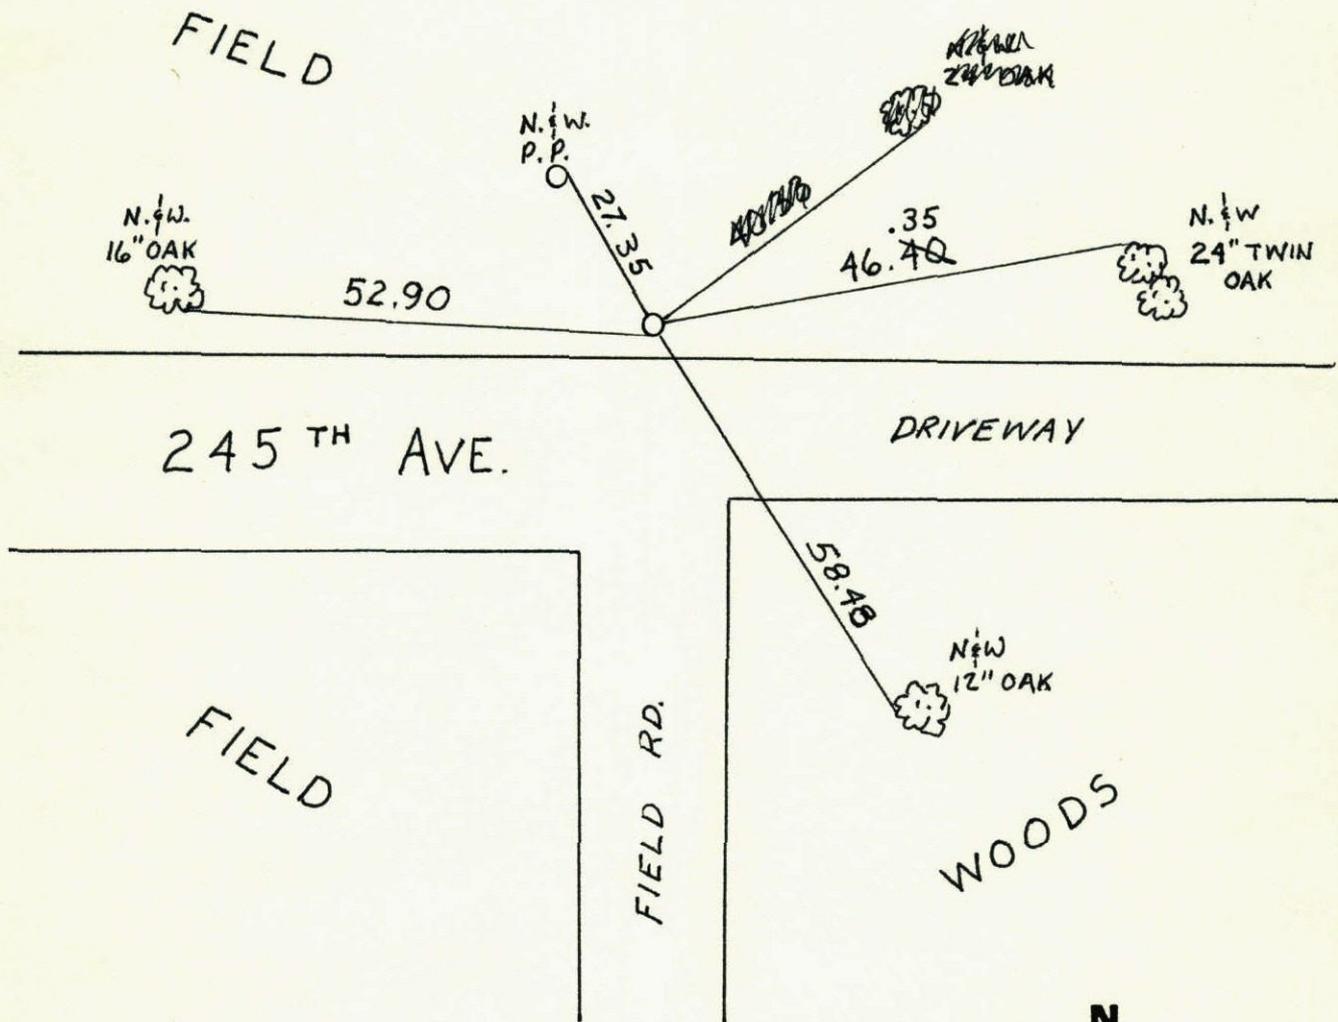

Revised date	Revised date	Revised date
11-7-90		
8-5-92		
8-12-97		

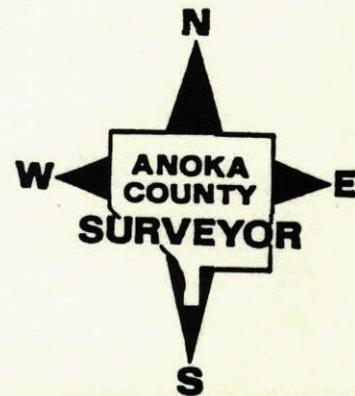


NW CORNER SECTION 28 T34 R23

REPLACED CONCRETE MONUMENT WITH
CAST IRON MON. REMOVED OLD 4" IRON

10-12-90

H. LARSON
B. KLEENZ

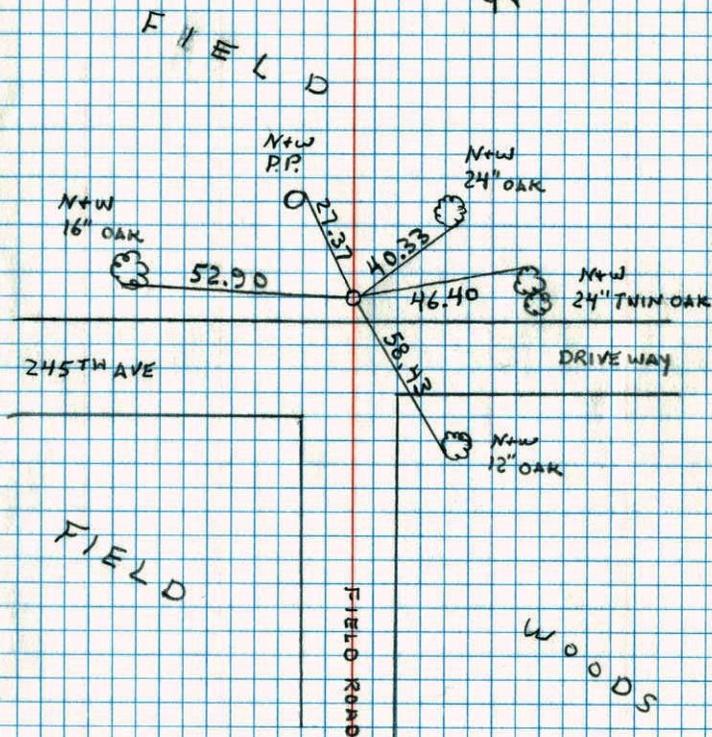


N.W. Corner Sec. 28 - T34 - R23

Found Concrete Monument Down .5'±.

Found Iron Rod Like Ones Set By State
For University Land.

Concrete Is On $\frac{1}{2}$ OF Road To West And South.

Concrete Has Iron Pipe On North Side.

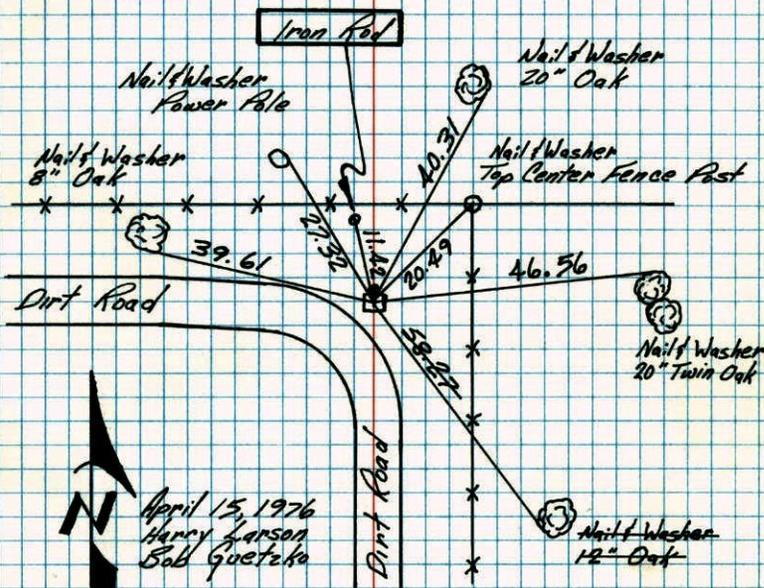

TIE CHECK

8-16-78

D. DAHL

B. STEPHENS

M. KISROW

TIECHECK

5-26-82

P. ROSS

B. NICHOLAS

TEMPERATURE CORRECTED
AND HORIZONTALLY
TAPED MEASUREMENTS

ROLAND W. ANDERSON
COUNTY SURVEYOR
ANOKA COUNTY, MINNESOTA

