

# CERTIFICATE OF LOCATION OF GOVERNMENT CORNER

County of Anoka

State of Minnesota


Northwest Corner of Sec. 26 Township 34 Range 22

On the 19th day of August, 1966, the described corner was evidenced by a cast iron monument

and to perpetuate the location of said corner, at the exact location thereof, a permanent marker was placed consisting of a red and white iron pipe (UP 4'±) Leaning SE'LY same

AND on the \_\_\_ day of \_\_\_\_\_, \_\_\_\_\_, said permanent marker was \_\_\_\_\_

Updated reference ties are as shown below.

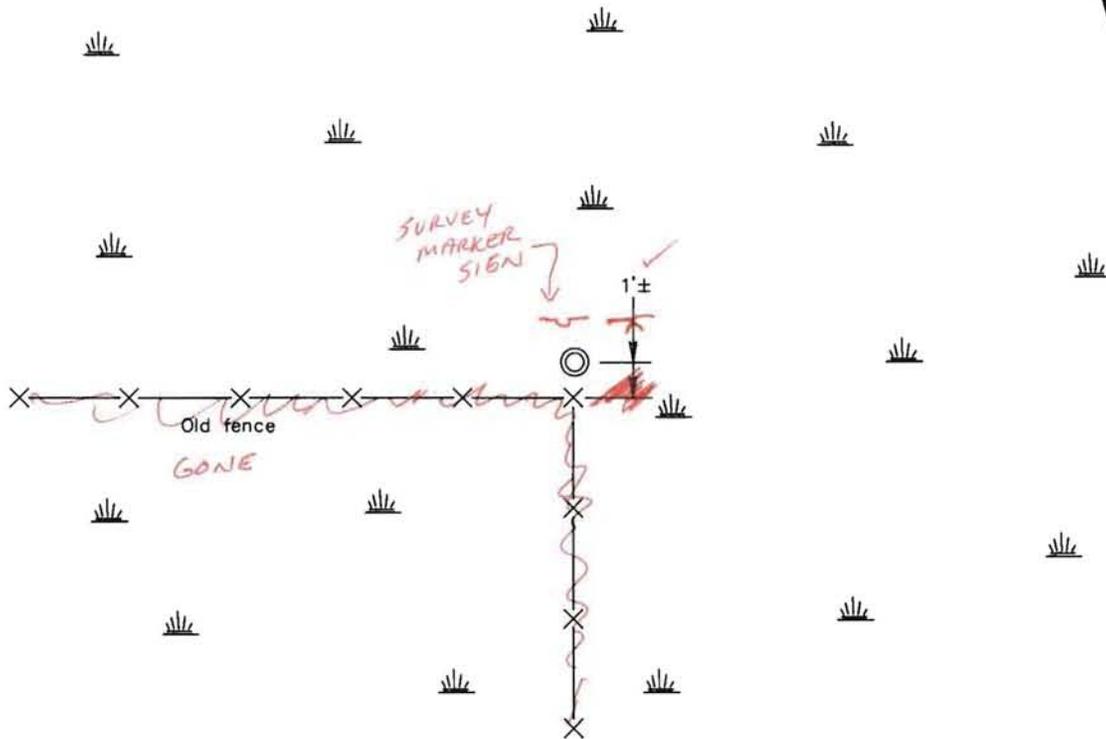

Revised date
6/09/82
7/11/95
2-14-14
BK-SS-SH
VRS

N.A.D. 1983 Coordinates (1996 Adjustment)	
County Project Coordinates	
Northing	237635.7458
Easting	552941.0892
Date	2/19/04

I hereby certify that this United States public land survey monument record is correct and complete to the best of my knowledge and belief.

\_\_\_\_\_ Date \_\_\_\_\_

\_\_\_\_\_, Anoka County Surveyor

Minnesota License Number \_\_\_\_\_

30Q = 0.05      N = 237635.5707      E = 552941.2236

# CERTIFICATE OF LOCATION OF GOVERNMENT CORNER

County of Anoka


State of Minnesota

NORTHWEST Corner of Sec. 26 Township 34 Range 22


I hereby certify that on the 19 day of AUG., 1966, I found the described corner which was evidenced by CAST IRON

and I further certify that to perpetuate the location of said corner, I did, at the exact location thereof, place a permanent marker consisting of RED, WHITE I.P.

which reference or witness monuments are located in the manner following:

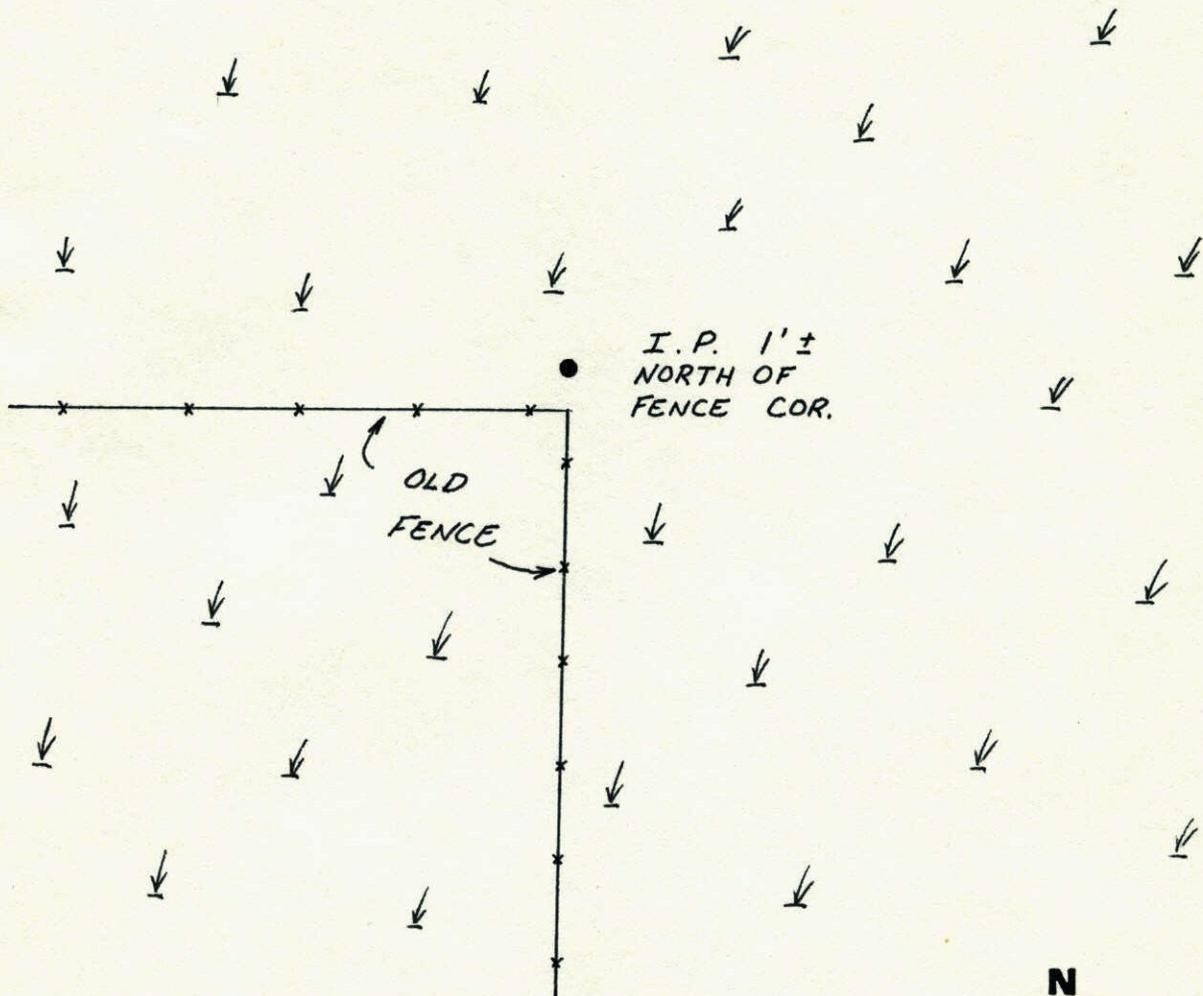


Revised date	Revised date	Revised date
6-9-82		
7-11-95		

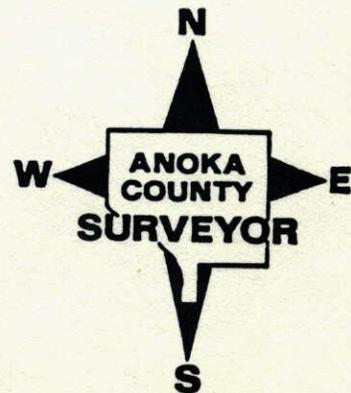

# N.W. Cor. Sec. 26-T34-R22

Set Red & White Iron Pipe From  
Area Resurvey. Iron Pipe Up 3'±

April 4, 1975  
H. Larson  
R. Guetzko  
J. Boettcher

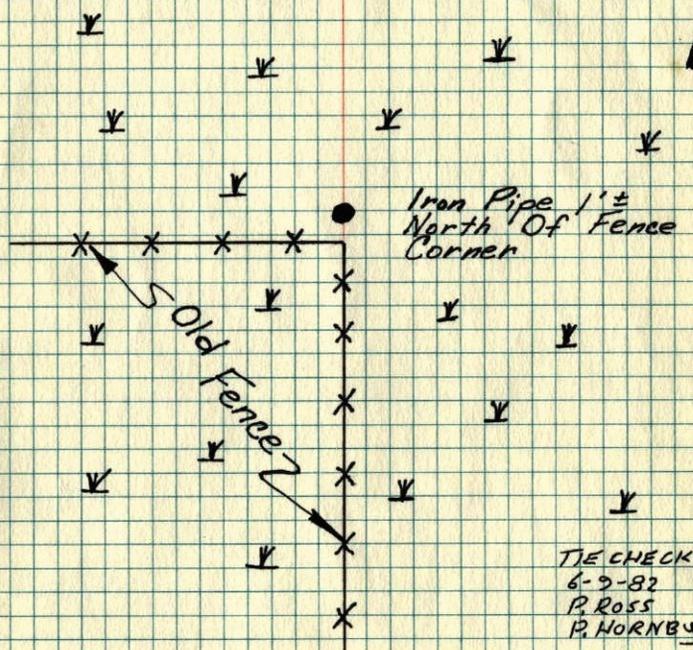


TIE CHECK  
6-9-82  
P. ROSS  
P. HORNBY

TEMPERATURE CORRECTED  
AND HORIZONTALLY  
TAPED MEASUREMENTS  
ROLAND W. ANDERSON  
COUNTY SURVEYOR  
ANOKA COUNTY, MINNESOTA

# NW Cor. Sec. 26 T34 R22

Set red & white iron pipe From  
area resurvey I.P. up 3'±

4-4-75  
H. Larson  
B. Guetzko  
J. Boettcher

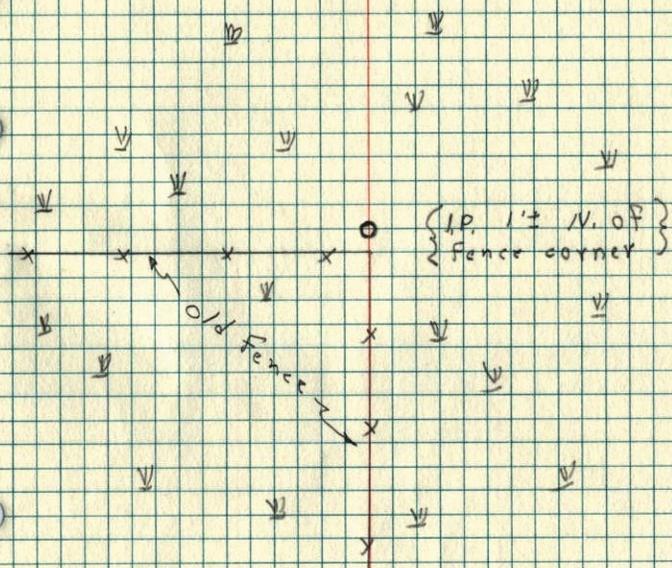

TEMPERATURE CORRECTED  
AND HORIZONTALLY  
TAPED MEASUREMENTS  
ROLAND W. ANDERSON  
COUNTY SURVEYOR  
ANOKA COUNTY, MINNESOTA