

CERTIFICATE OF LOCATION OF GOVERNMENT CORNER

County of Anoka State of Minnesota


North 1/4 Corner of Sec. 29 Township 34 Range 23

On the 22nd day of August, 1967, the described corner was evidenced by a P.K. nail set by N.C. Hoium on May 31, 1960

and to perpetuate the location of said corner, at the exact location thereof, a permanent marker was placed consisting of a 1/2" iron pipe

AND on the 21st day of September, 2006, said permanent marker was not found and a 1/2" iron pipe was set using area resurvey

Updated reference ties are as shown below.

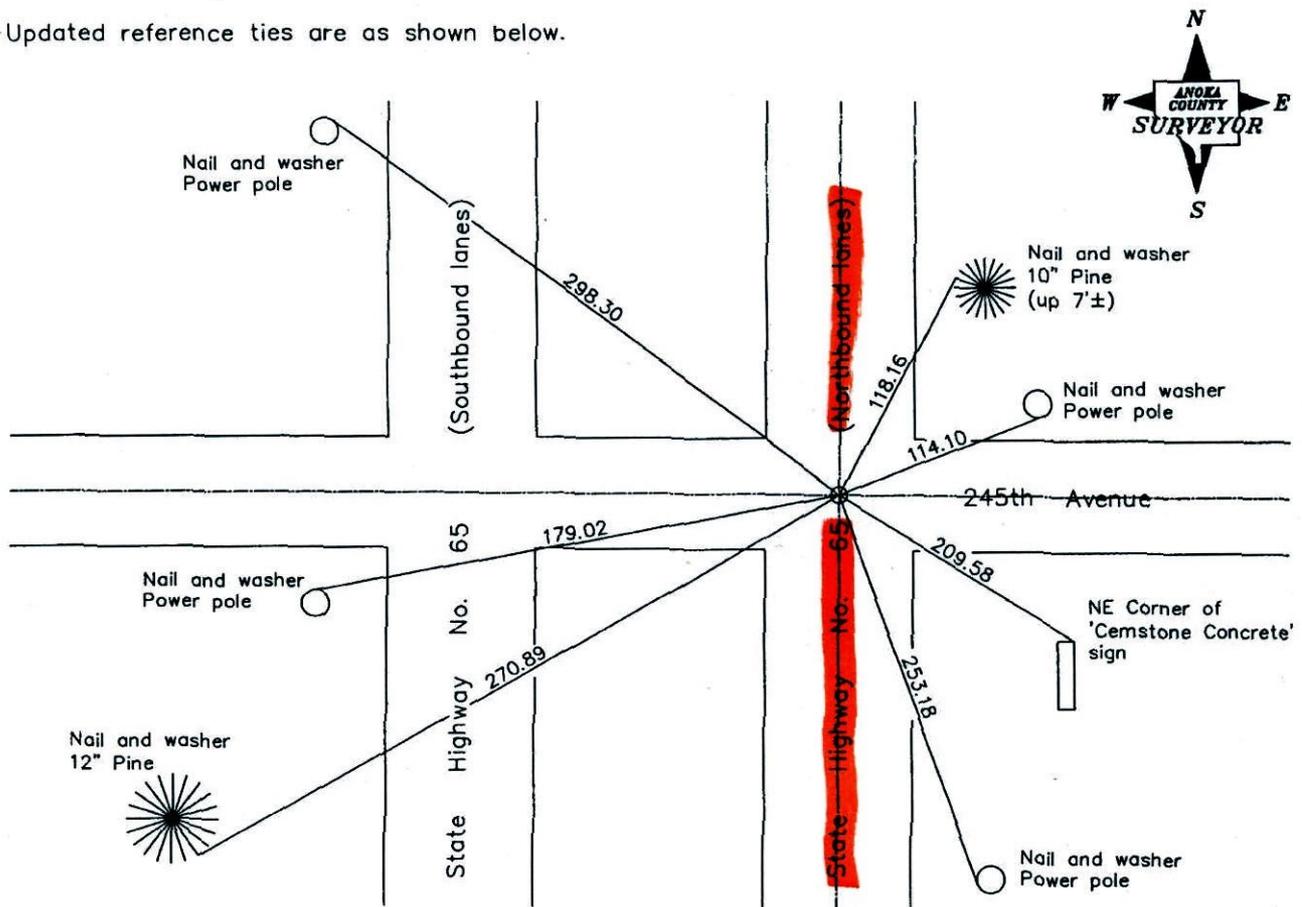

Revised date

10/12/90
Reset 9/21/06

N.A.D. 1983 Coordinates
(1996 Adjustment)

County Project Coordinates	
Northing	238027.4856
Easting	508095.6808
Date	9/21/06

I hereby certify that this United States public land survey monument record is correct and complete to the best of my knowledge and belief.

Date 7/5/07
Larry D. Hoium, Anoka County Surveyor
 Minnesota License Number 18165

CERTIFICATE OF LOCATION OF GOVERNMENT CORNER

County of Anoka


State of Minnesota

NORTH QTR. Corner of Sec. 29 Township 34 Range 23


I hereby certify that on the 22 day of AUG., 1967, I found the described corner which was evidenced by P.K. SET BY N.C. HOIUM 5-31-60

and I further certify that to perpetuate the location of said corner, I did, at the exact location thereof, place a permanent marker consisting of BRASS PLUG
1/2" IRON PIPE

which reference or witness monuments are located in the manner following:

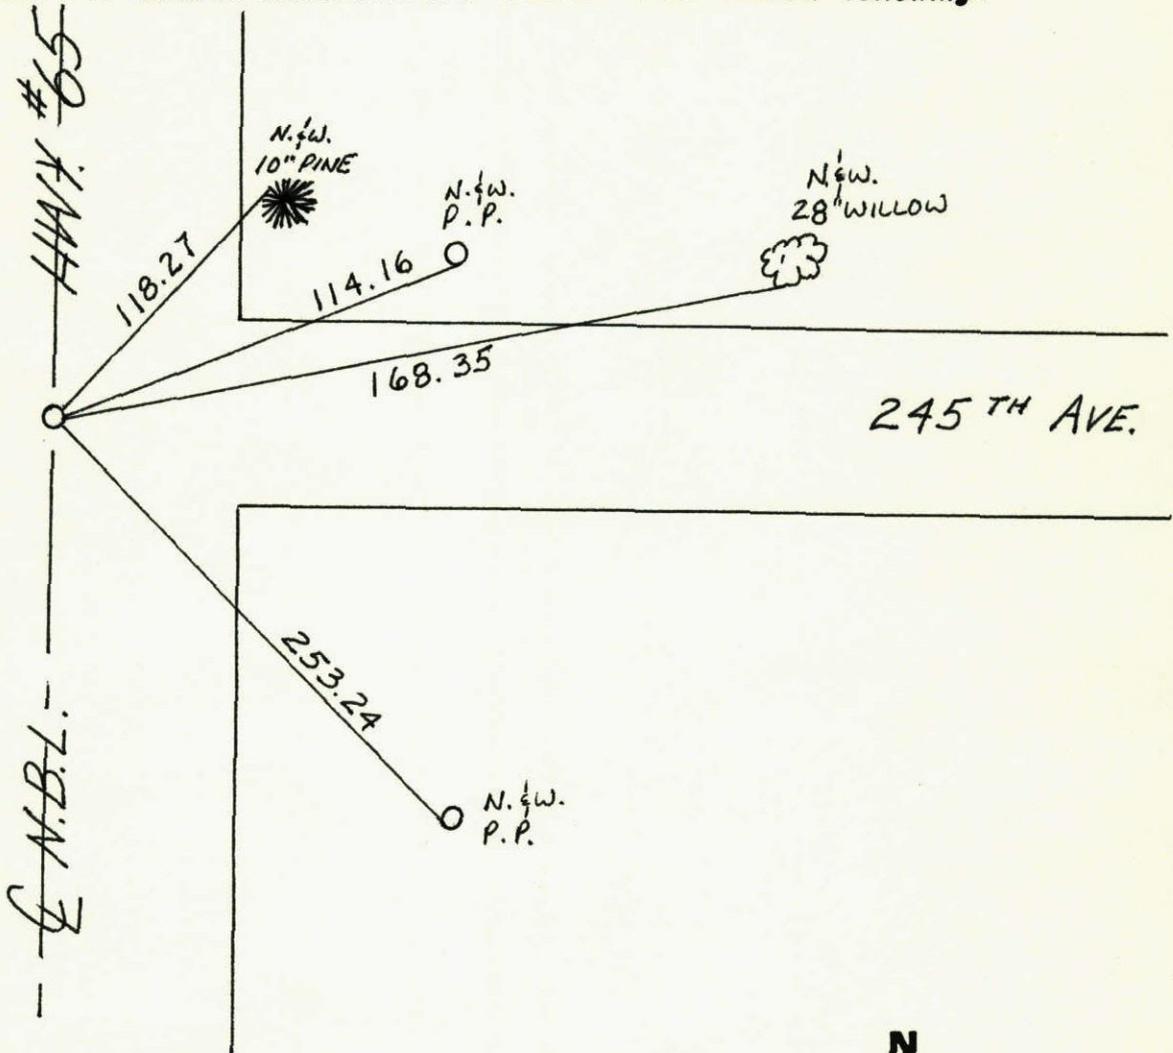


Revised date	Revised date	Revised date
11-7-90		
10-12-90 ^{HL}		

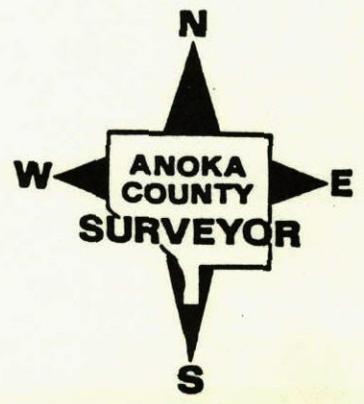

NORTH 1/4 CORNER SECTION 29 T34 R23


RESET CORNER FROM AREA RESURVEY

SET 1/2" I.P.

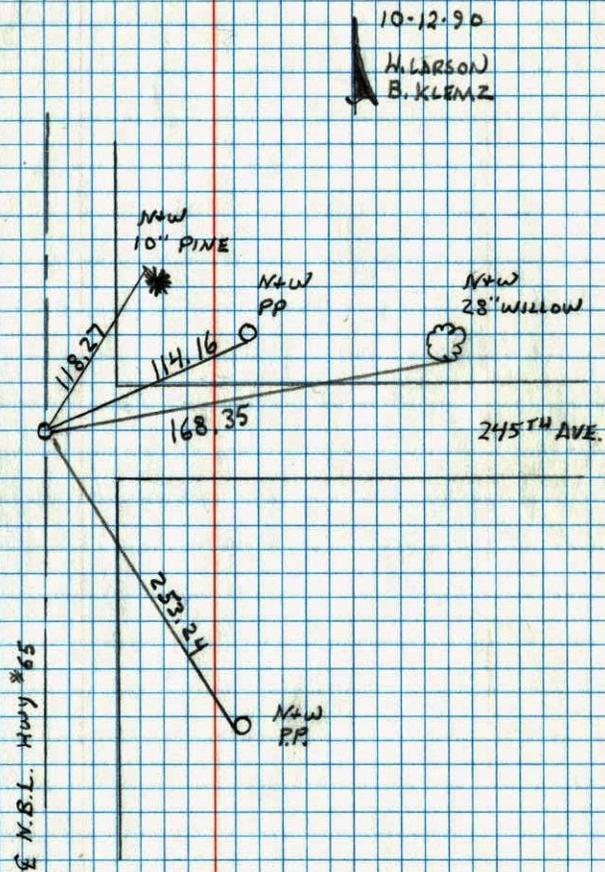


60
N 1/4 COR. SECTION 29 T34 R23


RETIRED BRASS PLUG

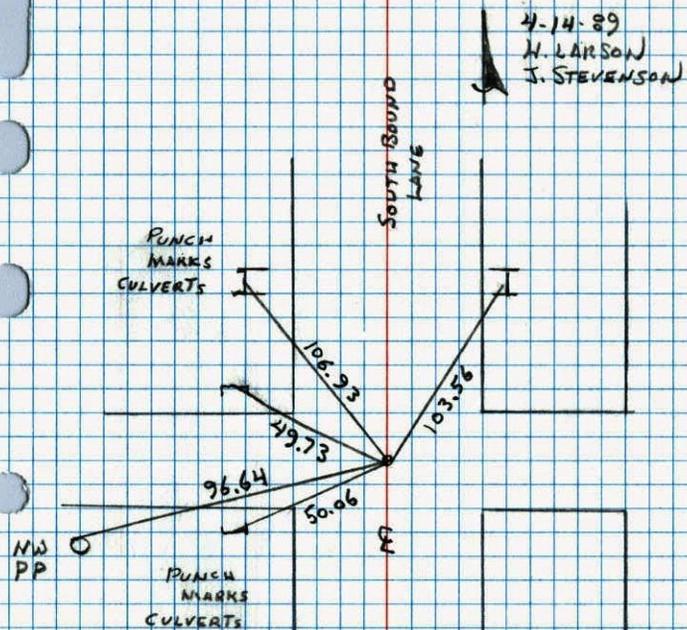

N¹/₄ Cor. Sec. 29-T34-R23

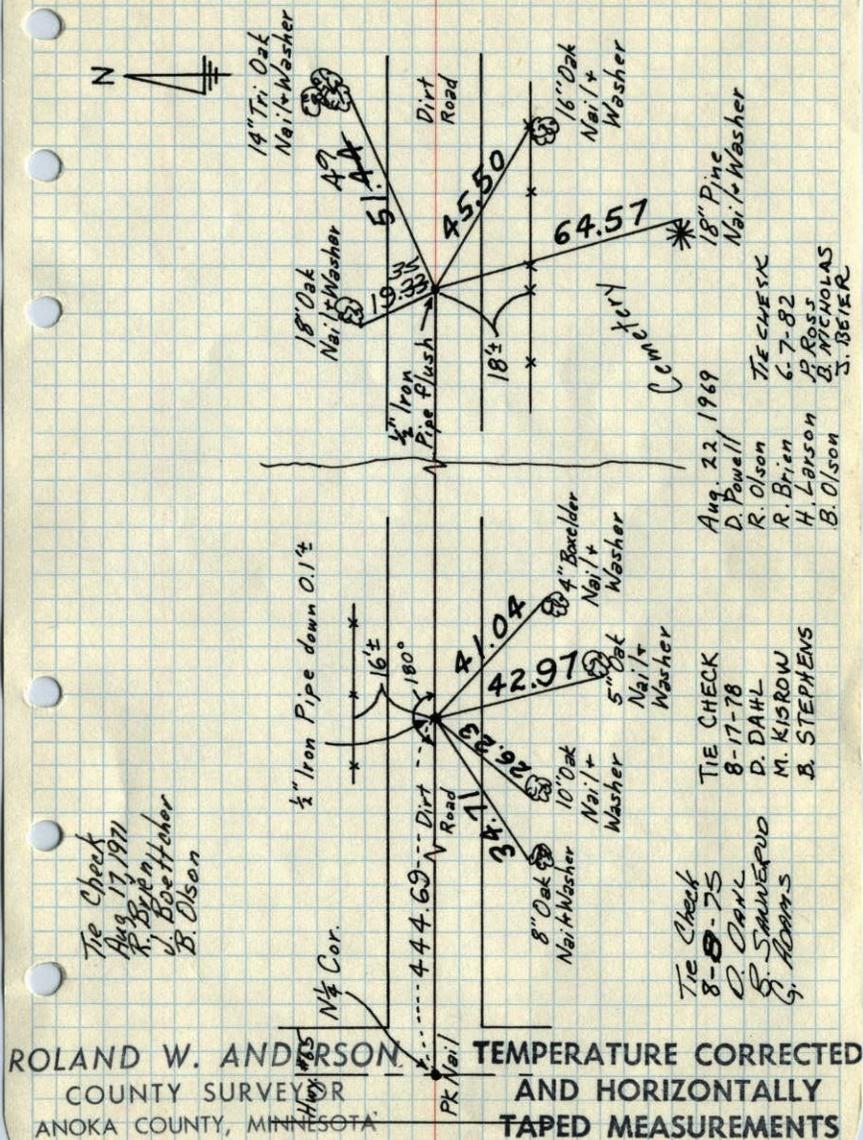


N¹/₄ Cor. Sec. 29-T34-R23

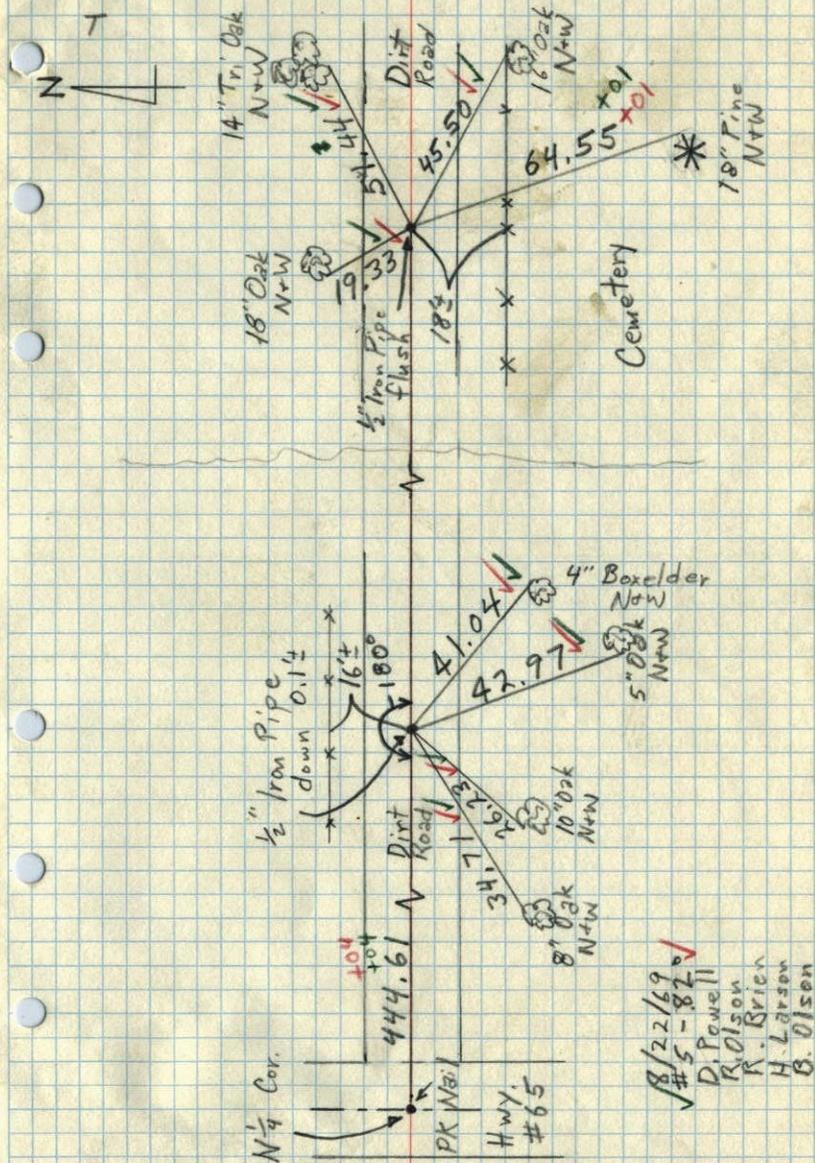

N¼ Cor. Sec. 29-T34-R23

PK set as possible corner by N.C. Hojum 5/31/60
PK is south 3.15' from seam and on centerline

August 22, 1967
D. Potter
D. Powell

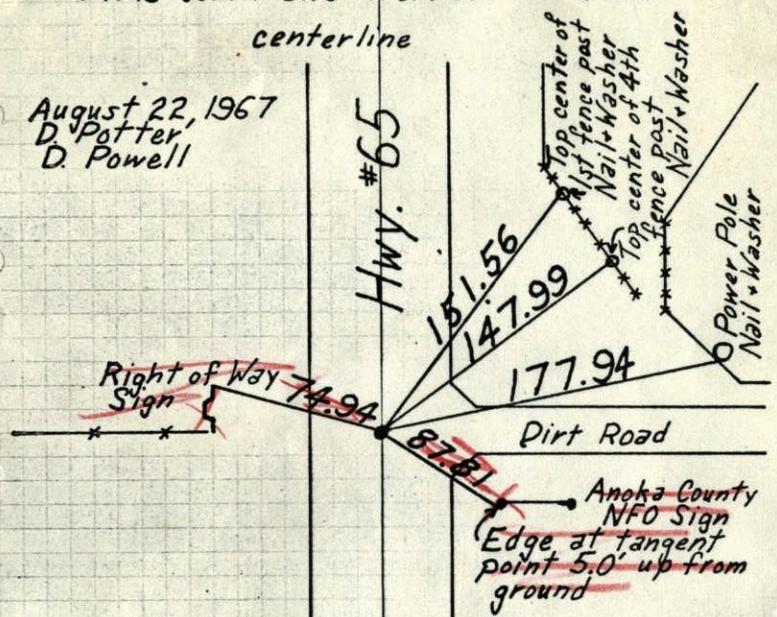

177.94
158.02
19.92


TEMPERATURE CORRECTED AND HORIZONTALLY TAPED MEASUREMENTS

ROLAND W. ANDERSON
COUNTY SURVEYOR
ANOKA COUNTY, MINNESOTA

N¼ Cor. Sec. 29-T34-R23

PK set as possible corner by N.C. Hojum 5/31/60
PK is south 3.15' from seam and on centerline

August 22, 1967
D. Potter
D. Powell

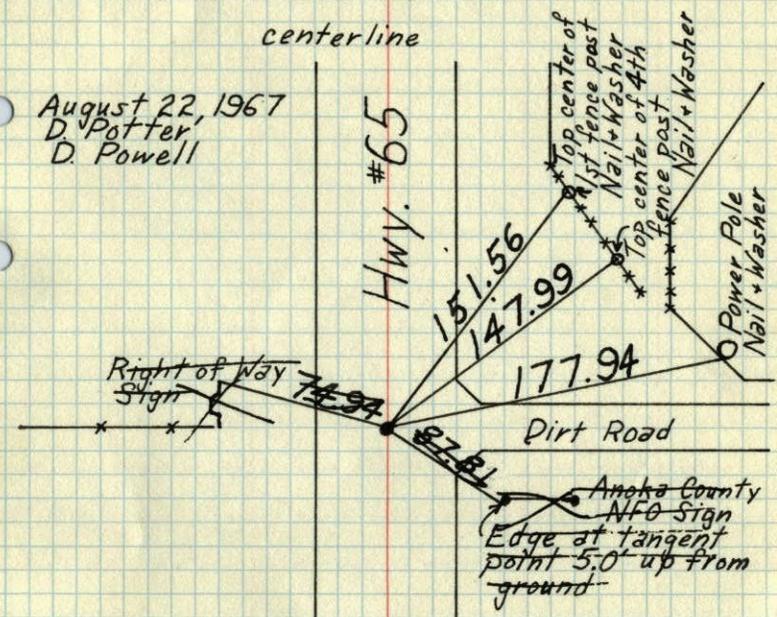

TEMPERATURE CORRECTED AND HORIZONTALLY TAPED MEASUREMENTS

ROLAND W. ANDERSON
COUNTY SURVEYOR
ANOKA COUNTY, MINNESOTA

N¹/₄ COR. SEC. 29, T34, R23


PK SET AS POSSIBLE CORNER
BY N.C. HOIUM 5/31/60

PK IS SOUTH 3.15 FROM SEAM
AND ON CENTER
LINE

8/22/67


D. POTTER
D. POWELL

✓#7-58°✓

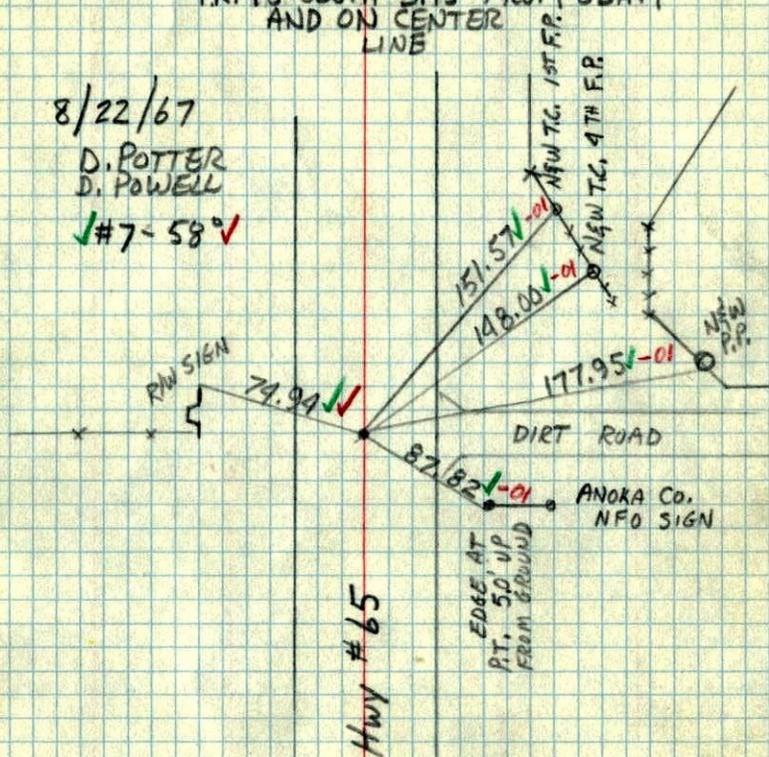

8A 11
N¹/₄ CORNER OF SECTION 29
TOWNSHIP 34, RANGE 23

POSSIBLE COR. SET P.K.
5/31/60 110/46

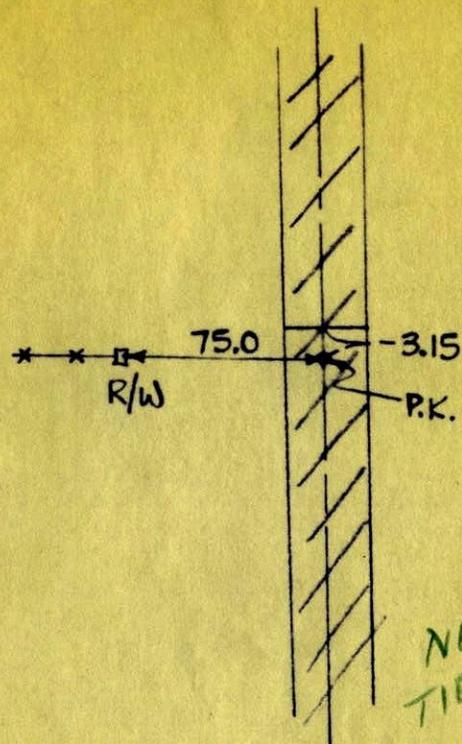

Don't Have

NEW TIE DRAWN

N. C. HOIUM
AND ASSOCIATES, INC.
LAND SURVEYORS

ANOKA, MINNESOTA