

CERTIFICATE OF LOCATION OF GOVERNMENT CORNER

County of Anoka State of Minnesota

Northwest Corner of Sec. 30 Township 34 Range 23


On the 27th day of December, 1966, the described corner was evidenced by area resurvey

and to perpetuate the location of said corner, at the exact location thereof, a permanent marker was placed consisting of a cast iron monument with a sign and post on the south side

(MON. UP 0.3'±)

AND on the 15th day of May, 2002, said permanent marker was found and the ties were updated

Updated reference ties are as shown below.

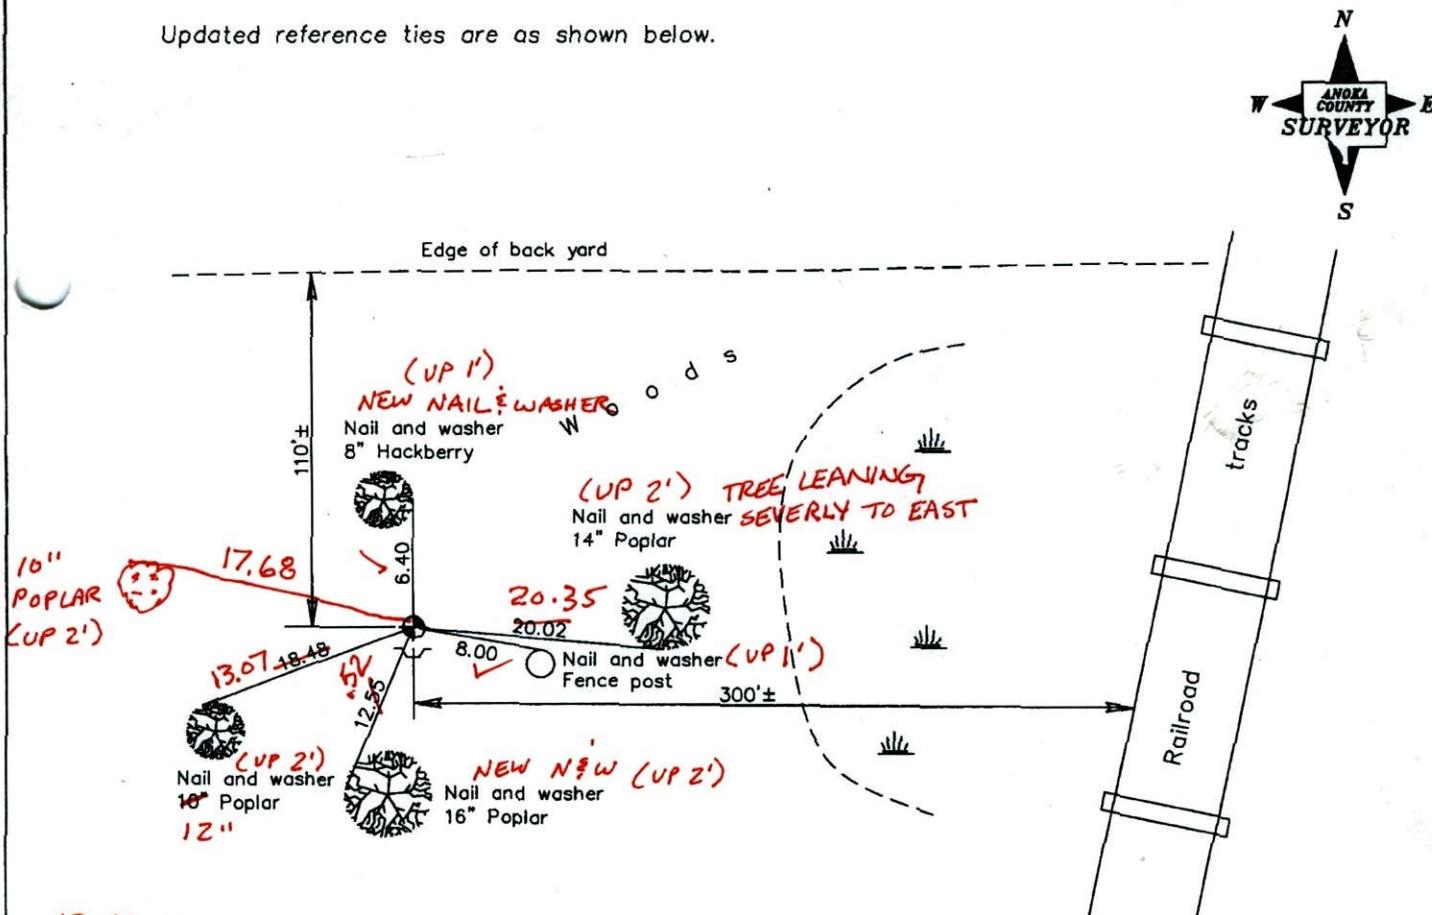

12-7-12
BK-SS
TAPED

Revised date
5/10/93
5/25/00
5/15/02

N.A.D. 1983 Coordinates (1996 Adjustment)	
County Project Coordinates	
Northing	237979.8104
Easting	500330.8591
Date	5/20/02

I hereby certify that this United States public land survey monument record is correct and complete to the best of my knowledge and belief.

Larry D. Hoium Date 5/15/02

Larry D. Hoium, Anoka County Surveyor

Minnesota License Number 18165

CERTIFICATE OF LOCATION OF GOVERNMENT CORNER

County of Anoka


State of Minnesota

NORTHWEST Corner of Sec. 30 Township 34 Range 23


I hereby certify that on the 27TH day of DECEMBER, 19 66, I found the described corner which was evidenced by AREA RESURVEY

and I further certify that to perpetuate the location of said corner, I did, at the exact location thereof, place a permanent marker consisting of CAST IRON MONUMENT - SIGN AND POST ON SOUTH SIDE - C.I.M. 300'± W. OF R.R. TRACKS

which reference or witness monuments are located in the manner following:

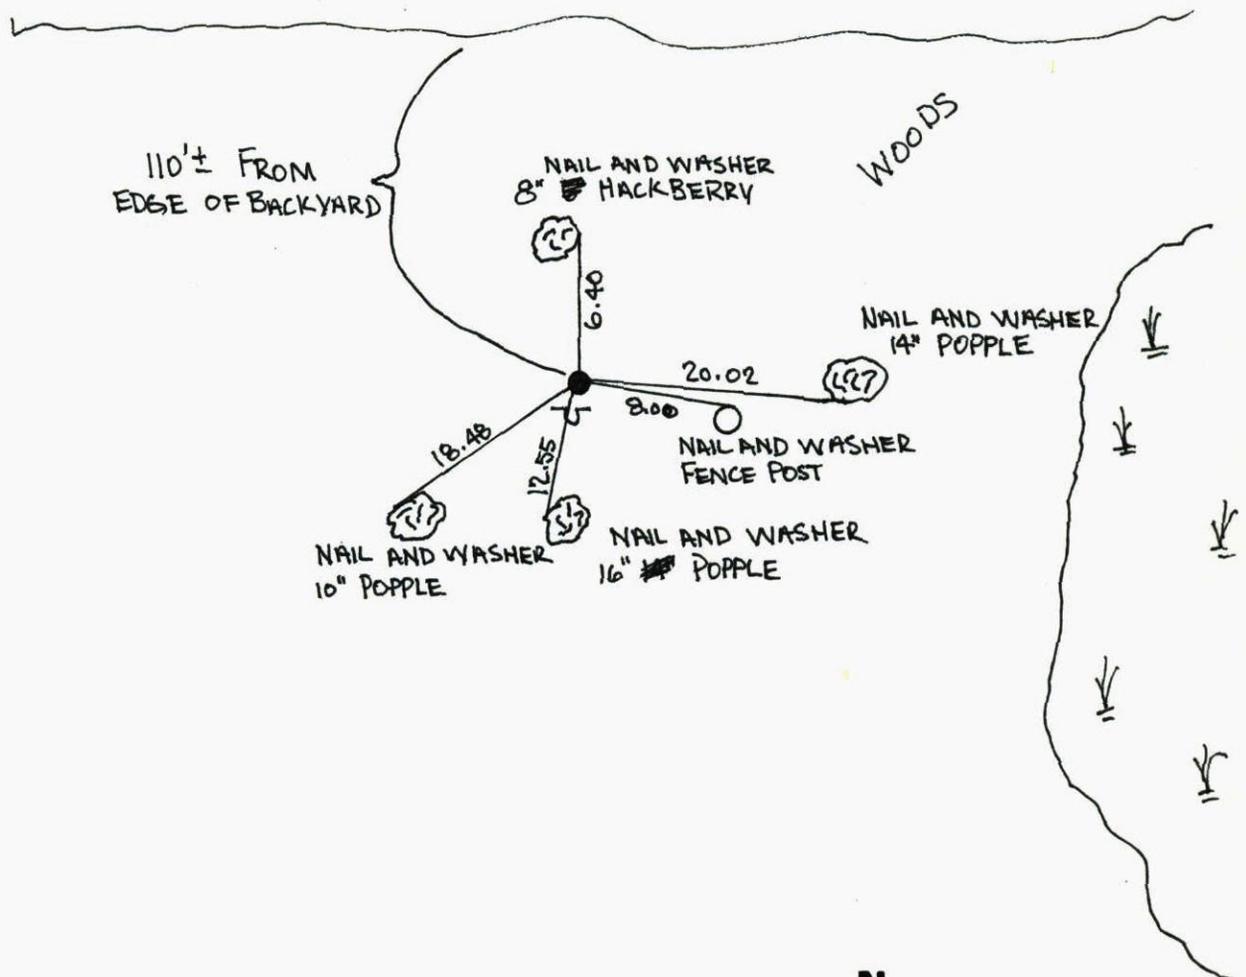


Revised date	Revised date	Revised date
6-7-82		
5-10-93		
5-25-00		
5-15-02		

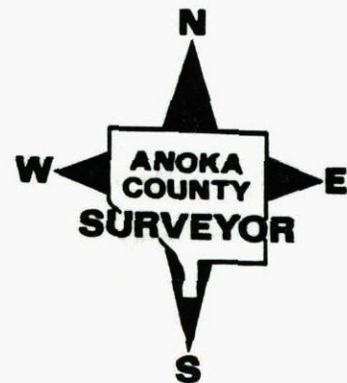

NORTHWEST COR. SEC. 30, T. 34, R. 23

RETIED C.I.M.

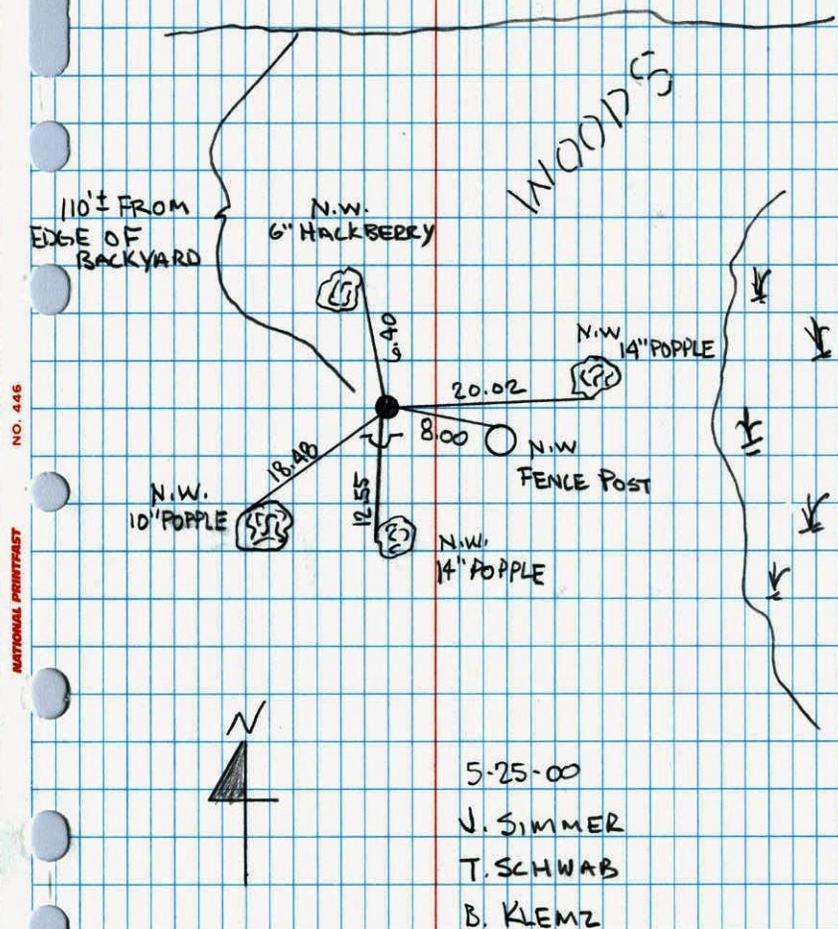

NW CORNER SECTION 30 T34 R23


RETIED CAST IRON MONUMENT
SIGN AND POST ON SOUTH SIDE.

C.I. 300'± WEST OF RR TRACKS

5-10-99


H. LARSON

M. STEWART

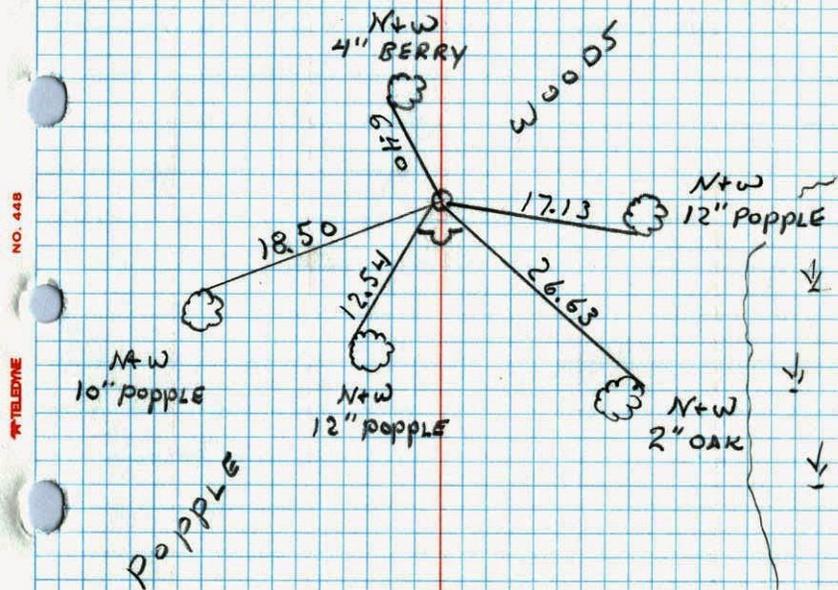

NW Cor. Sec. 30 T34 R23

Set cast iron monument from area resurvey.

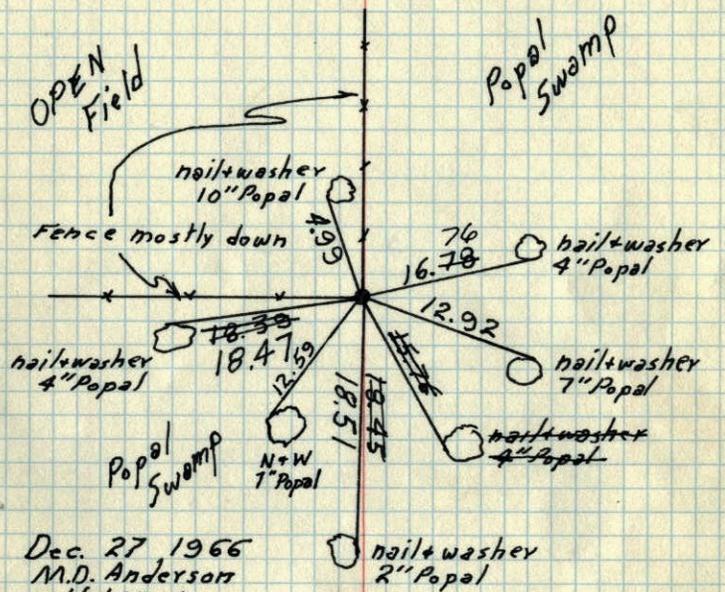

Dec. 27 1966
M.D. Anderson
H. Larson
D. Potter

Tie Check
July 12, 1967
D. Potter
D. Powell

TIE CHECK
8-16-78
D. DAHL
M. KISROW
B. STEPHENS


Tie Check
Aug 17, 1971
R. Brien
J. Boettcher
B. Olson

Tie Check
8-11-75
D. DAHL
B. SANNEPUD
G. NORMS

TEMPERATURE CORRECTED
AND HORIZONTALLY
TAPED MEASUREMENTS

ROLAND W. ANDERSON
COUNTY SURVEYOR
ANOKA COUNTY, MINNESOTA

NW Cor. Sec. 30 T34 R23
Set cast iron monument from area resurvey.

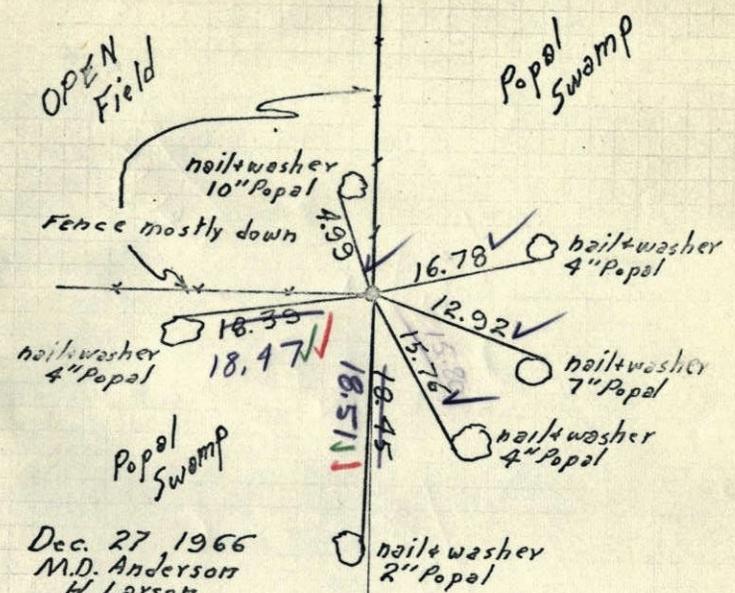

Dec. 27 1966
M.D. Anderson
H. Larson
D. Potter

7/12/67
D. POTTER
D. POWELL


#7-66

TEMPERATURE CORRECTED
AND HORIZONTALLY
TAPED MEASUREMENTS

ROLAND W. ANDERSON
COUNTY SURVEYOR
ANOKA COUNTY, MINNESOTA

N.W. Cor. Sec. 30-T 34-R 23

Set Cast Iron monument from area
resurvey

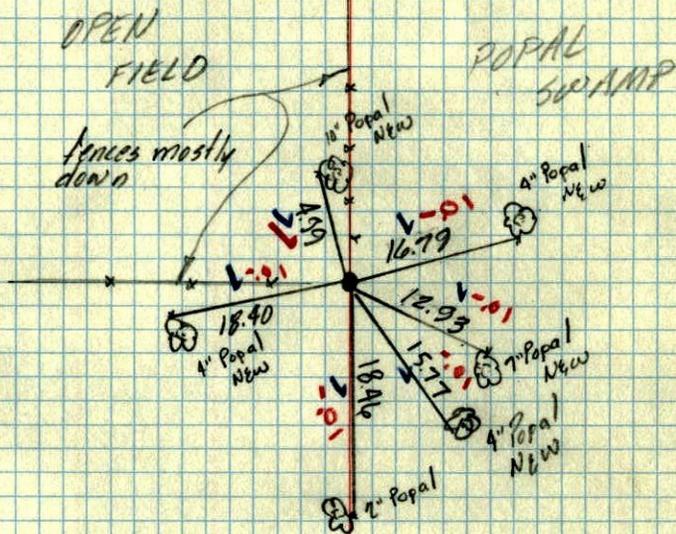

POPAL
SWAMP

Dec 27 1966
M. D. Anderson
H. J. Larson
D. C. Potter

Temp 15° ✓
tape # 7 ✓