Page No. 64

CERTIFICATE OF LOCATION OF GOVERNMENT CORNER

County of Anoka State of Minnesota

West 1/4 Corner of Sec. 30 Township 34 Range 23

On the 19th day of August, 1974, the described corner was evidenced by area resurvey

and to perpetuate the location of said corner, at the exact location thereof, a permanent marker was placed consisting of a cast iron monument (down 1'±) with a sign and post on the east side

AND on the 15th day of May, 2002, said permanent marker was found and the ties were updated

Updated reference ties are as shown below.

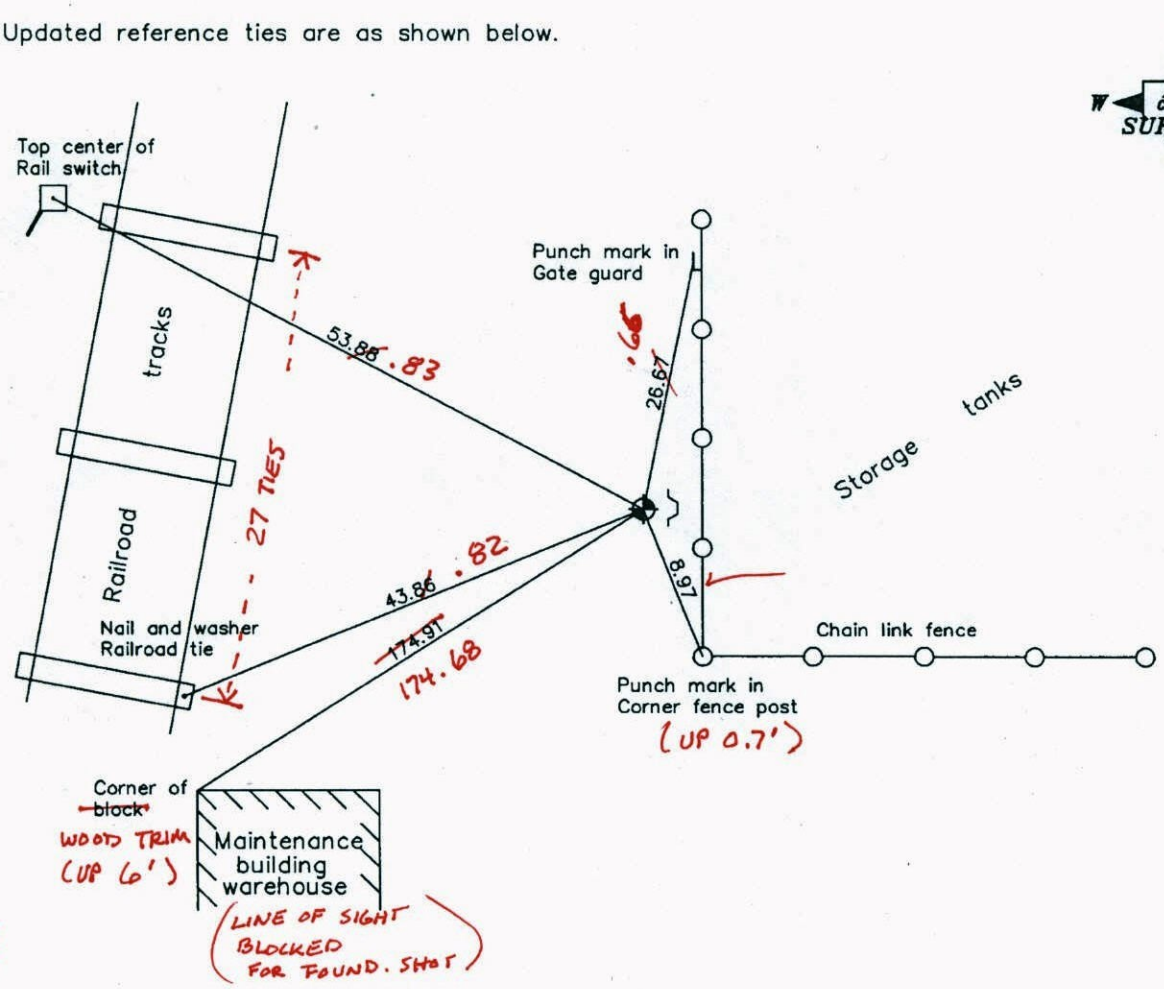

12-6-12
BK - 55
T/T - VRS

Revised date
9/18/98
5/25/00
5/15/02

N.A.D. 1983 Coordinates (1996 Adjustment)

County Project Coordinates	
Northing	235392.0028
Easting	500334.3942
Date	5/15/02

I hereby certify that this United States public land survey monument record is correct and complete to the best of my knowledge and belief.

Larry D. Hoium Date 5/15/02

Larry D. Hoium, Anoka County Surveyor

Minnesota License Number 18165

VRS 3D = 0.07 N = 235392.0320 E = 500334.3499

CERTIFICATE OF LOCATION OF GOVERNMENT CORNER

County of Anoka State of Minnesota

WEST 1/4 Corner of Sec. 30 Township 34 Range 23

I hereby certify that on the 19TH day of AUGUST, 19 74, I found the described corner which was evidenced by AREA RESURVEY

and I further certify that to perpetuate the location of said corner, I did, at the exact location thereof, place a permanent marker consisting of CAST IRON MONUMENT DOWN 1' ± SIGN AND POST ON EAST SIDE

which reference or witness monuments are located in the manner following:

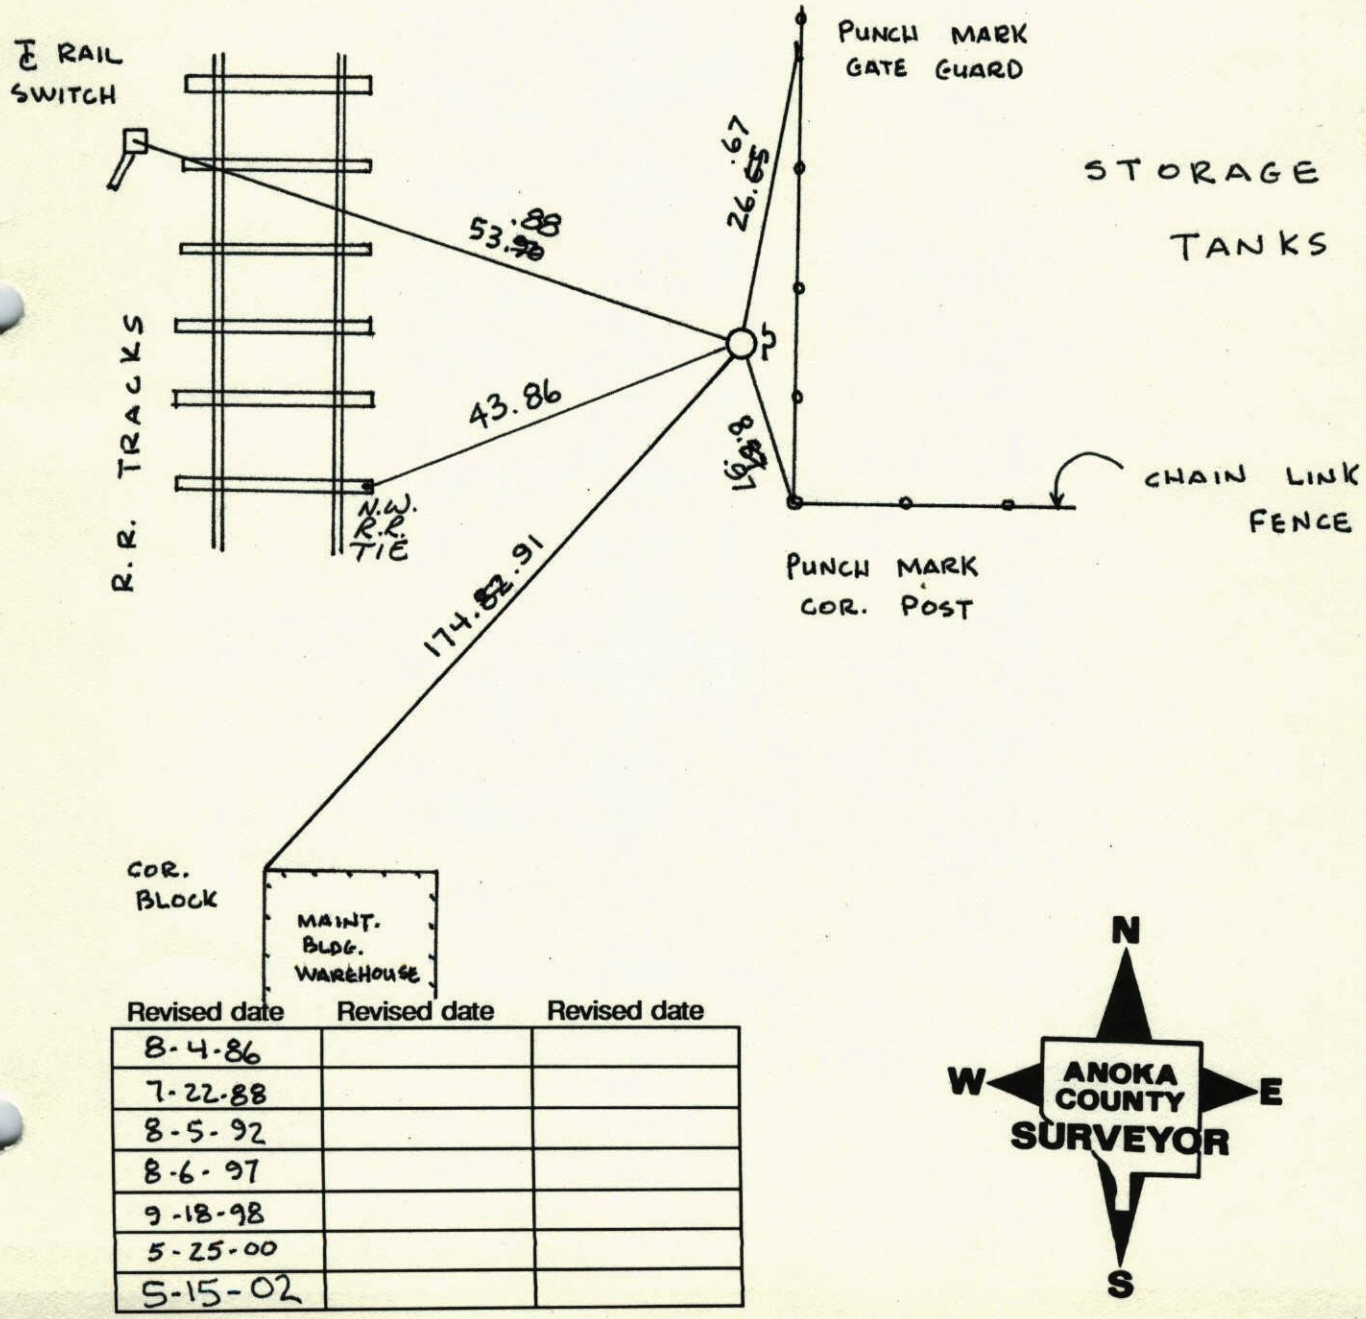

Revised date	Revised date	Revised date
8-4-86		
7-22-88		
8-5-92		
8-6-97		
9-18-98		
5-25-00		
5-15-02		

W1/4 COR. SEC. 30 T34 R23

RETIED CAST IRON MON.

C.I. 1'±

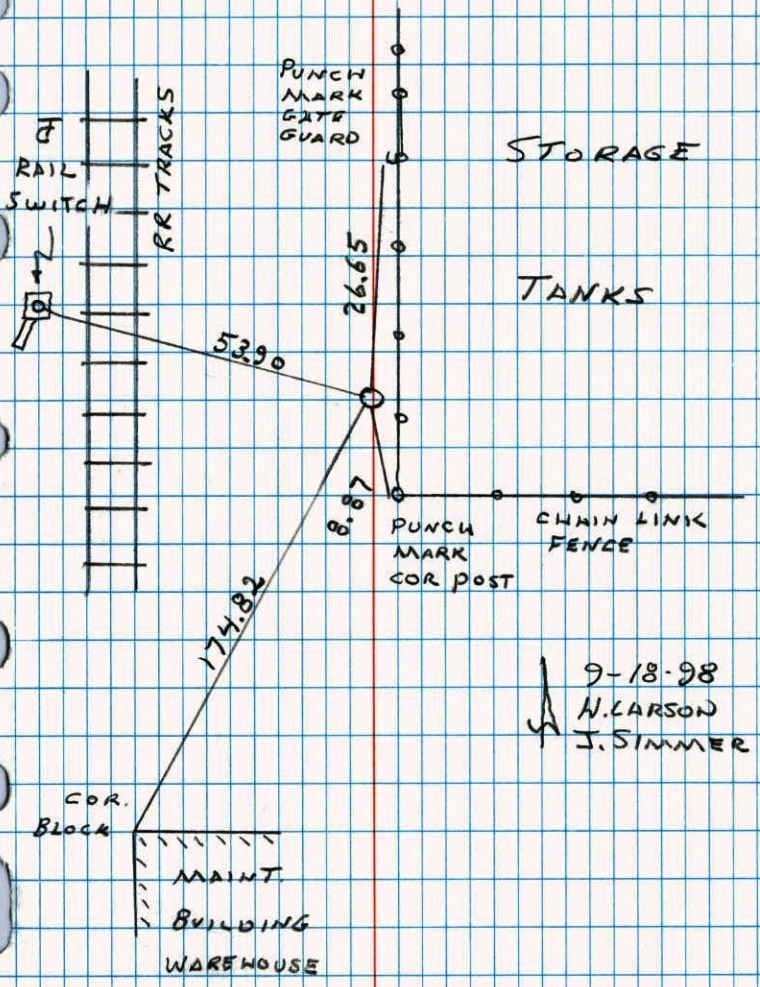

W 1/4 CORNER SECTION 30 T34 R23

RESET AFTER CONSTRUCTION SET FROM RESURVEY AND REMAINING TIE.

(SET CAST IRON DOWN 1'± 7-22-88)

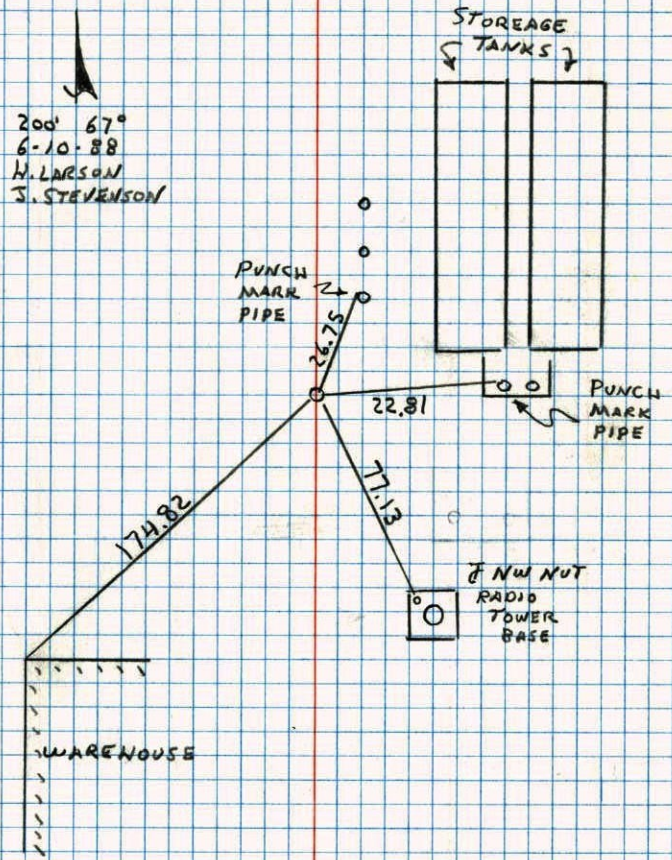

64

W 30 23

E¼ Cor. Sec. 25 - T34 - R24

Set Cast Iron Monument from Area Resurvey

Set Steel Sign Post With Warning Sign 1' N. Of Monument

TIE CHECK
8-11-75
O. DAHL
B. SANNERUD
G. ADAMS

TIE CHECK
8-16-78
D. DAHL
M. KISROW
B. STEPHENS

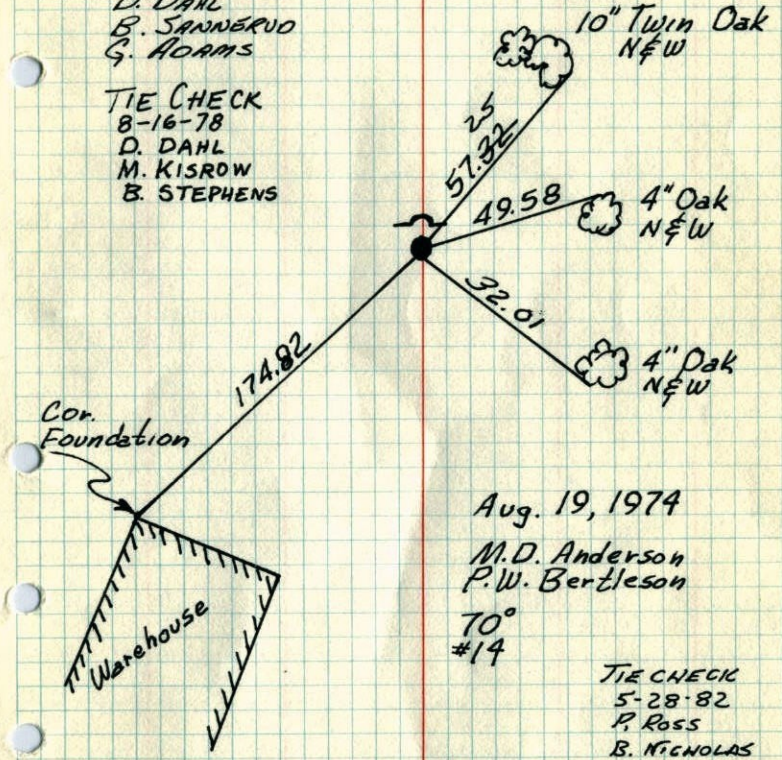

Aug. 19, 1974

M.D. Anderson
P.W. Bertleson

70°
#14

TIE CHECK
5-28-82
P. ROSS
B. NICHOLAS