

# CERTIFICATE OF LOCATION OF GOVERNMENT CORNER

County of Anoka State of Minnesota

East 1/4 Corner of Sec. 30 Township 34 Range 23

On the 23rd day of December, 1966, the described corner was evidenced by area resurvey


and to perpetuate the location of said corner, at the exact location thereof, a permanent marker was placed consisting of a cast iron monument **(MON. FOUND DOWN 0.3'± AND LEANING N.W.'LY) \* MON. BROKEN \* NEEDS RESET \***

AND on the 15th day of May, 2002, said permanent marker was found and the ties were updated

12-6-12 Updated reference ties are as shown below.

MIDDLE BROKEN FIN  
DIST.'s IN BLACK PEN/CIRCLED  
VRS COORD'S IN BLACK

JS SH  
5-29-13  
SET NEW CIM.  
SQUARED DIST'S  
ARE CORRECT  
VRS N: 235345.1931  
E: 505507.6607  
3D=0.06

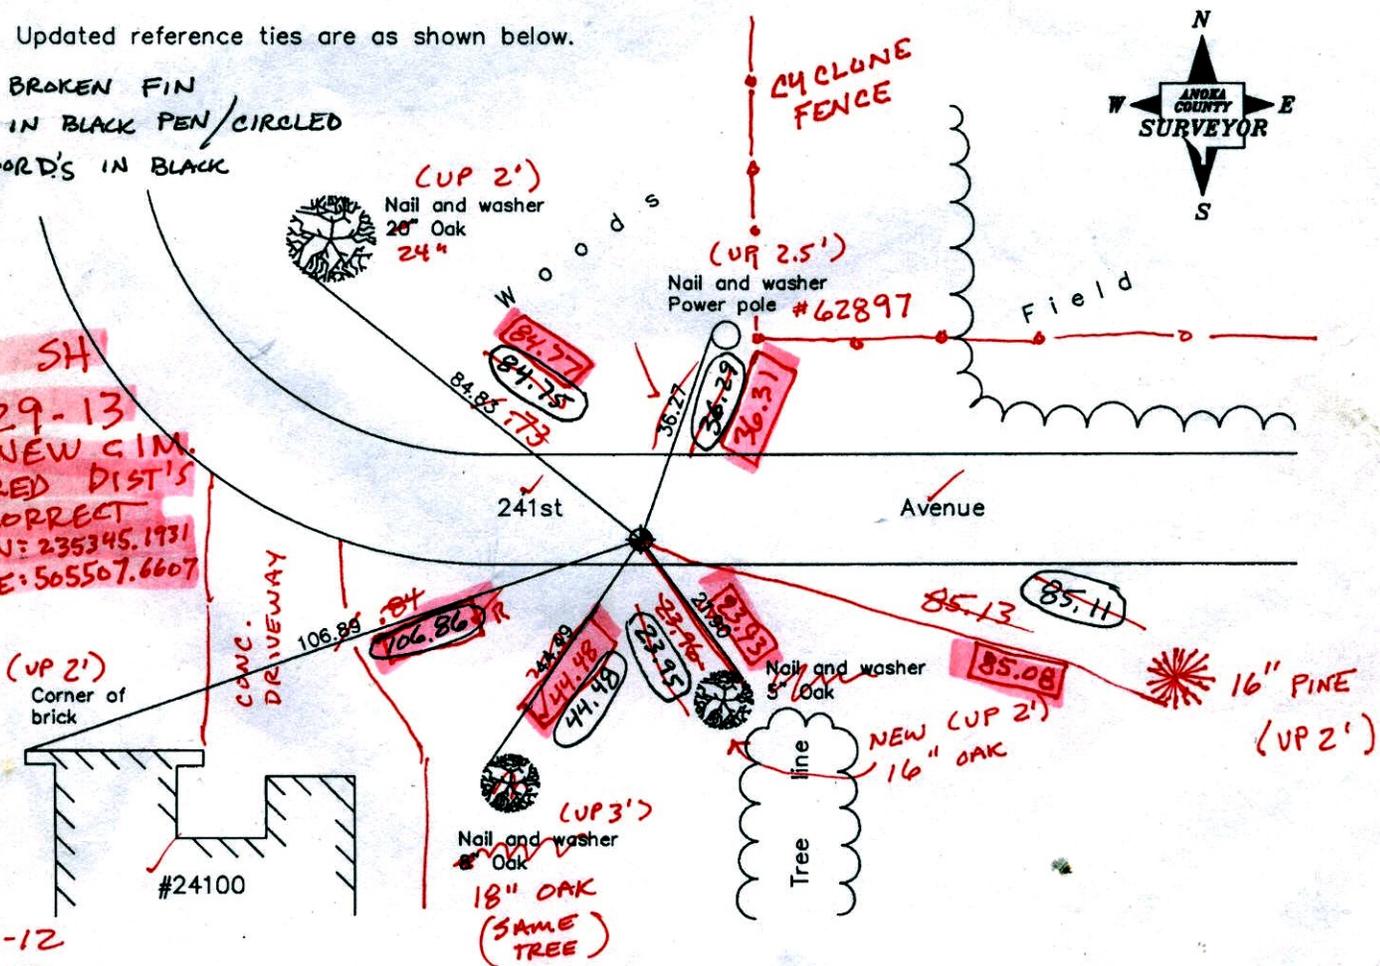

12-6-12  
BK-SS  
T/T-VRS Revised date

8/06/86
8/05/92
5/15/02

N.A.D. 1983 Coordinates (1996 Adjustment)	
County Project Coordinates	
Northing	235345.2391
Easting	505507.6868
Date	5/15/02

I hereby certify that this United States public land survey monument record is correct and complete to the best of my knowledge and belief.

*Larry D. Hoium* Date 5/15/02  
 Larry D. Hoium, Anoka County Surveyor  
 Minnesota License Number 18165

VRS 3D = 0.09      N = 235345.2358      E = 505507.6576  
 VRS 3D = 0.08      N = 235345.1972      E = 505507.6599

# CERTIFICATE OF LOCATION OF GOVERNMENT CORNER

County of Anoka

State of Minnesota


East 1/4 Corner of Sec. 30 Township 34 Range 23

On the 23rd day of December, 1966, the described corner was evidenced by area resurvey

and to perpetuate the location of said corner, at the exact location thereof, a permanent marker was placed consisting of a cast iron monument

AND on the 15th day of May, 2002, said permanent marker was found and the ties were updated

Updated reference ties are as shown below.

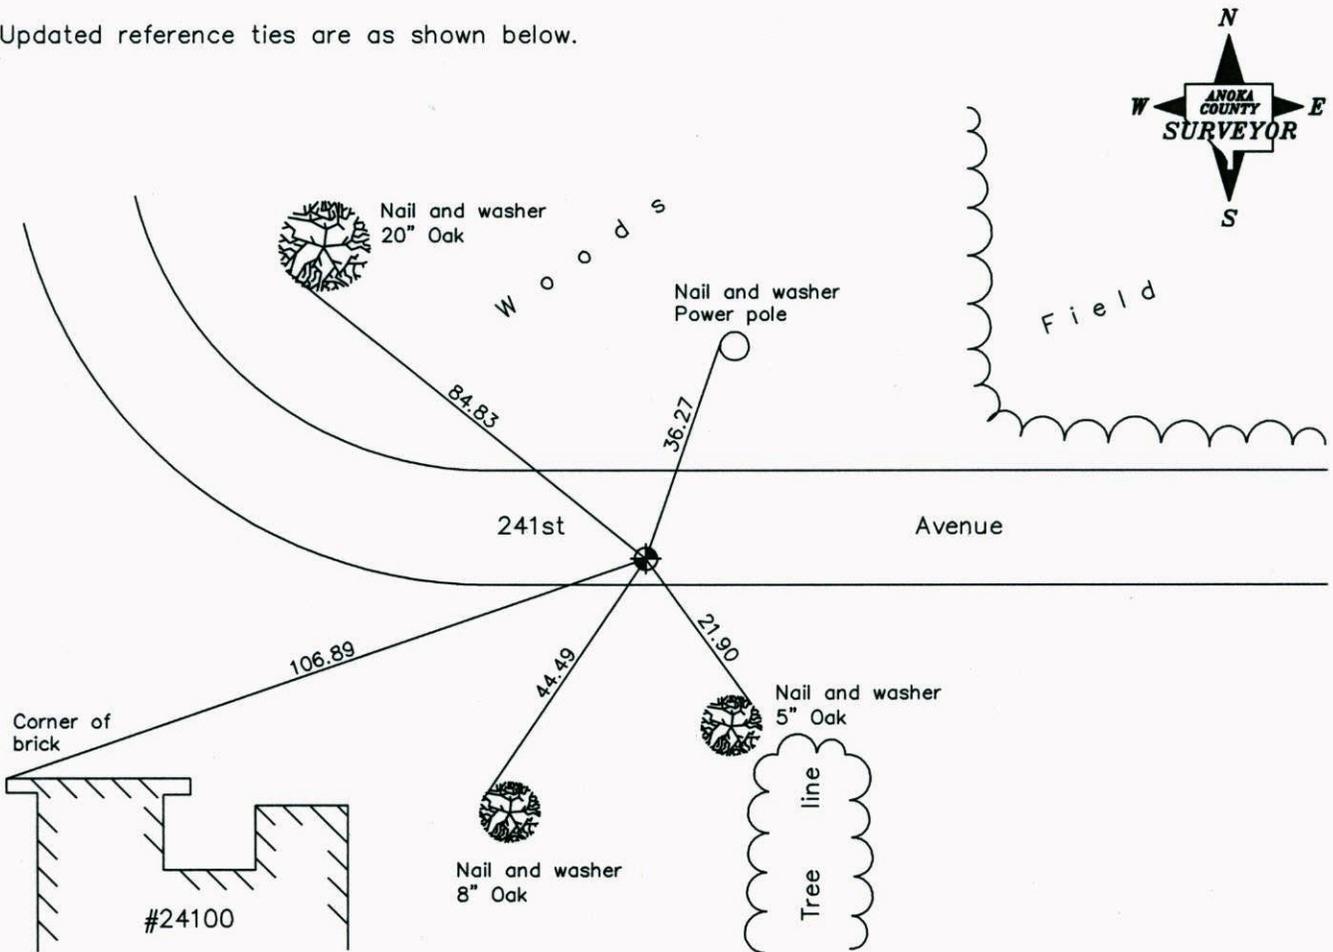

**Revised date**

8/06/86
8/05/92
5/15/02

**N.A.D. 1983 Coordinates  
(1996 Adjustment)**

County Project Coordinates
Northing <u>235345.2391</u>
Easting <u>505507.6868</u>
Date <u>5/15/02</u>

I hereby certify that this United States public land survey monument record is correct and complete to the best of my knowledge and belief.

*Larry D. Hoium* Date 5/15/02

\_\_\_\_\_  
Larry D. Hoium, Anoka County Surveyor  
Minnesota License Number 18165

# CERTIFICATE OF LOCATION OF GOVERNMENT CORNER

County of Anoka


State of Minnesota

EAST 1/4 Corner of Sec. 30 Township 34 Range 23

I hereby certify that on the 23 day of DECEMBER, 19 66, I found the described corner which was evidenced by AREA RESURVEY

and I further certify that to perpetuate the location of said corner, I did, at the exact location thereof, place a permanent marker consisting of CAST IRON MONUMENT

which reference or witness monuments are located in the manner following:

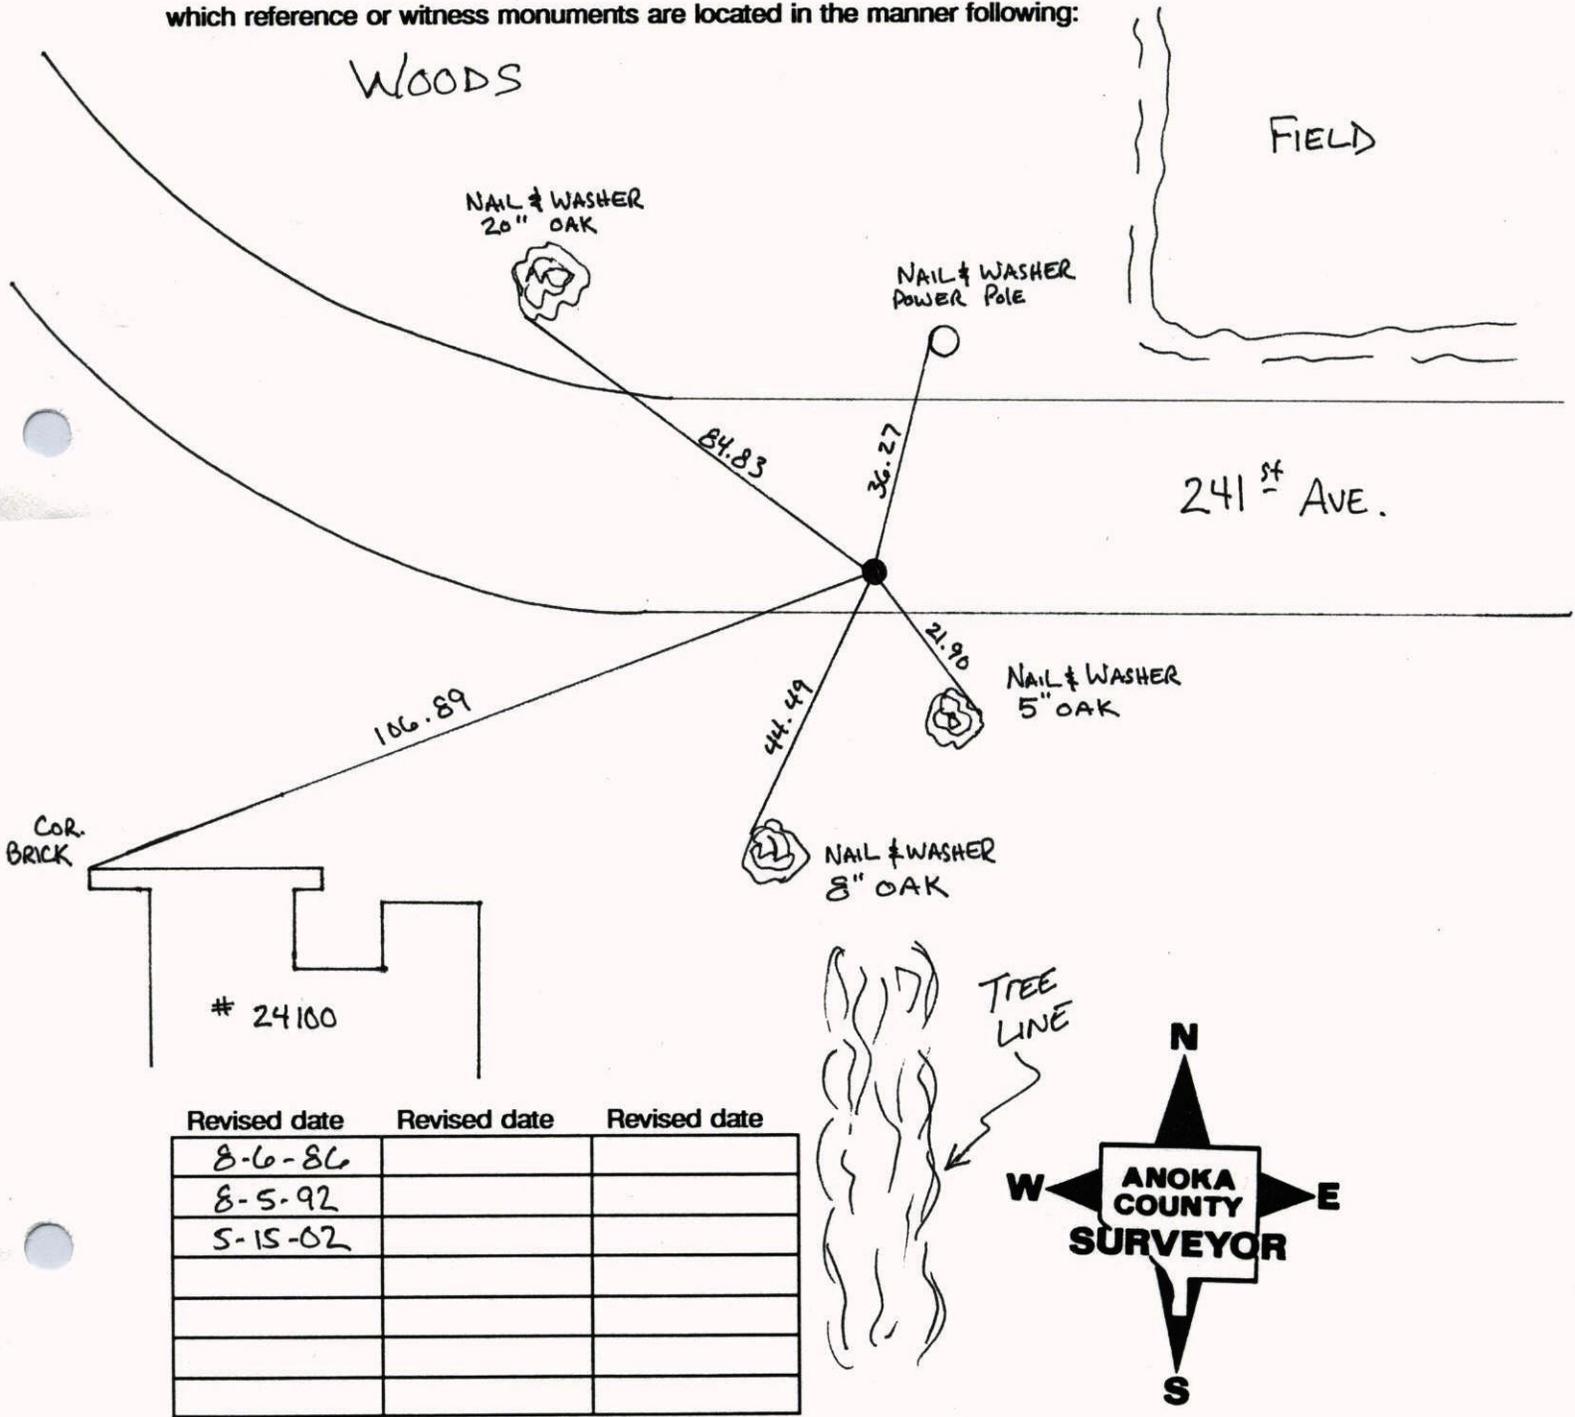


Revised date	Revised date	Revised date
8-6-86		
8-5-92		
5-15-02		

65  
E 1/4 Corner Section 30-T34-R23

Set Cast Iron Monument From Area Resurvey  
Monument Set In Slope Of Road Ditch.

Dec 23, 1966  
M.D. Anderson  
H.J. Larson  
D.L. Patter

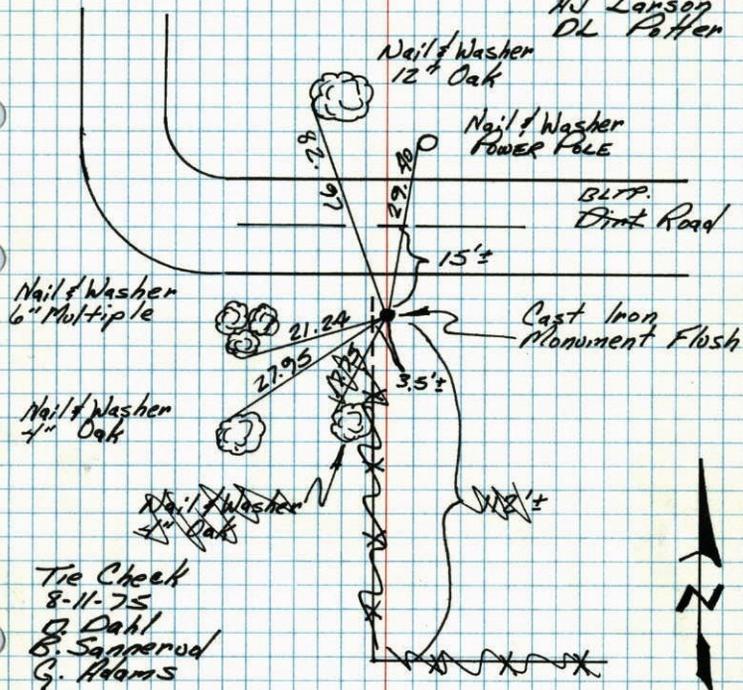

Tie Check  
8-11-75  
D. Dahl  
B. Sannerud  
G. Adams

TIE CHECK  
8-17-78  
D. DAHL  
M. STEPHENS  
M. KISROW

TIECHECK  
5-28-82  
P. Ross  
B. NICHOLAS

TEMPERATURE CORRECTED  
AND HORIZONTALLY  
TAPED MEASUREMENTS


ROLAND W. ANDERSON  
COUNTY SURVEYOR  
ANOKA COUNTY, MINNESOTA

65 #4  
E 1/4 Cor. Sec. 30, T.34, R.23

Set cast iron monument from  
area resurvey. Monument set  
in slope of road ditch,

Dec. 23, 1966  
M.D. Anderson  
H. J. Larson  
D. L. Patter

Tie Check  
Aug. 23, 1971  
B. Olson  
J. Boettcher

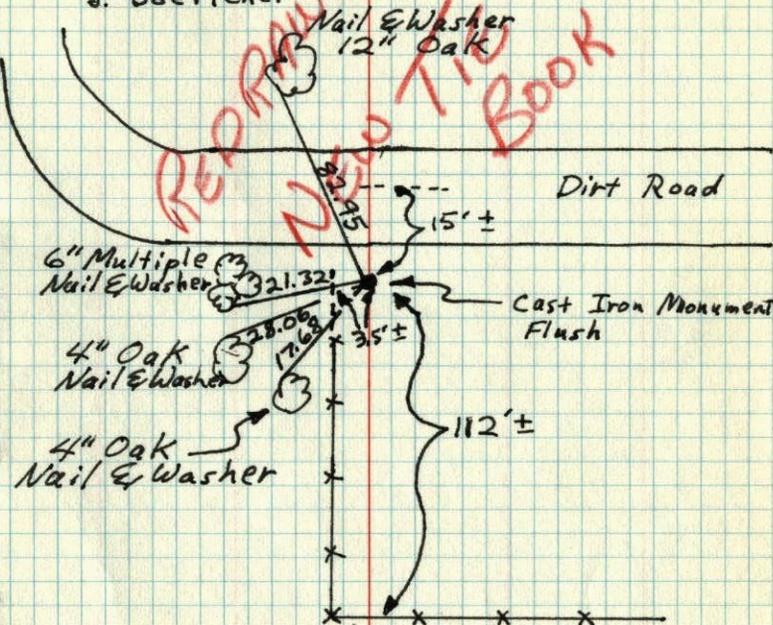


TEMPERATURE CORRECTED  
AND HORIZONTALLY  
TAPED MEASUREMENTS


ROLAND W. ANDERSON  
COUNTY SURVEYOR  
ANOKA COUNTY, MINNESOTA

14

E 1/4 Cor. Sec. 30 T34 R23

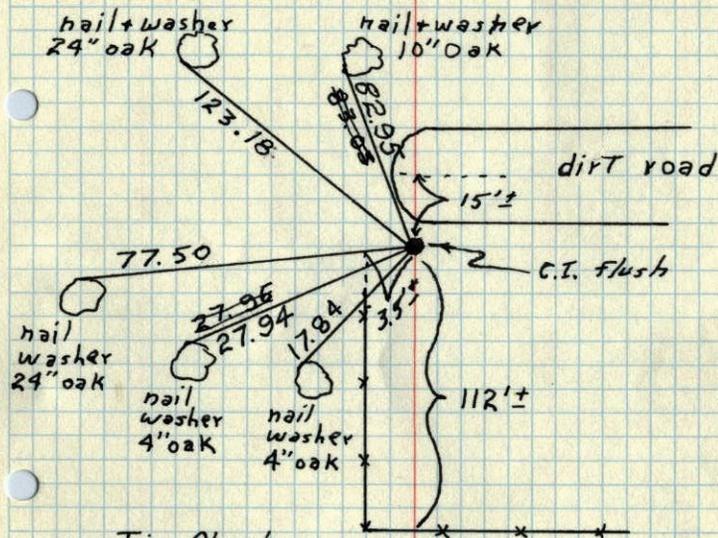Set cast iron monument from area  
resurvey. mon. set in slope of Rd. ditch.Dec. 23 1966  
M.D. Anderson  
H. S. Larson  
D. L. PotterTie Check  
July 12, 1967  
D. Potter  
D. PowellTEMPERATURE CORRECTED  
AND HORIZONTALLY  
TAPED MEASUREMENTSROLAND W. ANDERSON  
COUNTY SURVEYOR  
ANOKA COUNTY, MINNESOTA~~18~~

E 1/4 Cor. Sec. 30 T34 R23

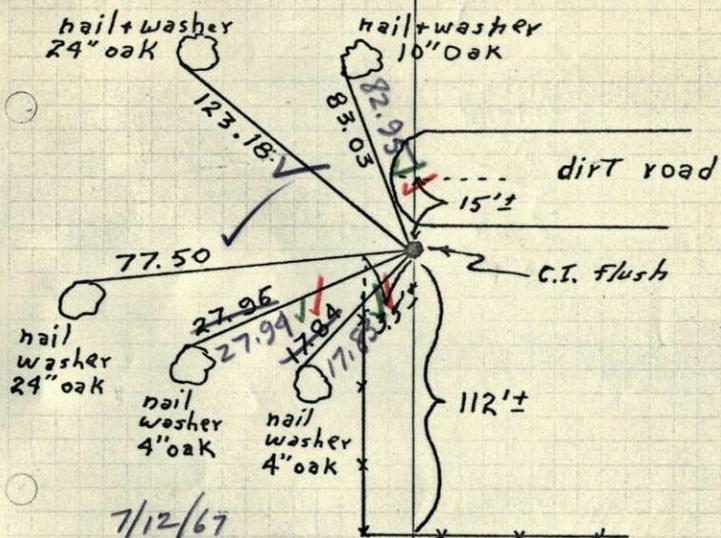Set cast iron monument from area  
resurvey. mon. set in slope of Rd. ditch.Dec. 23 1966  
M.D. Anderson  
H. S. Larson  
D. L. Potter

7/12/67

D. POTTER  
D. POWELL  
✓#7-67✓TEMPERATURE CORRECTED  
AND HORIZONTALLY  
TAPED MEASUREMENTSROLAND W. ANDERSON  
COUNTY SURVEYOR  
ANOKA COUNTY, MINNESOTA

E 1/4 Cor. Sec. 30-T34-R23

Set C.I. Man from area resurvey  
Man set in slope of Rd ditch

Dec 23, 1966  
M. D. Anderson  
L. J. Larson  
D. L. Peltier  
temp: 30° ✓  
tape 47 ✓

