

CERTIFICATE OF LOCATION OF GOVERNMENT CORNER

County of Anoka State of Minnesota


East 1/4 Corner of Sec. 29 Township 34 Range 23

On the 8th day of December, 1976, the described corner was evidenced by area resurvey

and to perpetuate the location of said corner, at the exact location thereof, a permanent marker was placed consisting of a cast iron monument (down 2'±) COULD BE RAISED...

AND on the 15th day of May, 2002, said permanent marker was found and the ties were updated

Updated reference ties are as shown below.

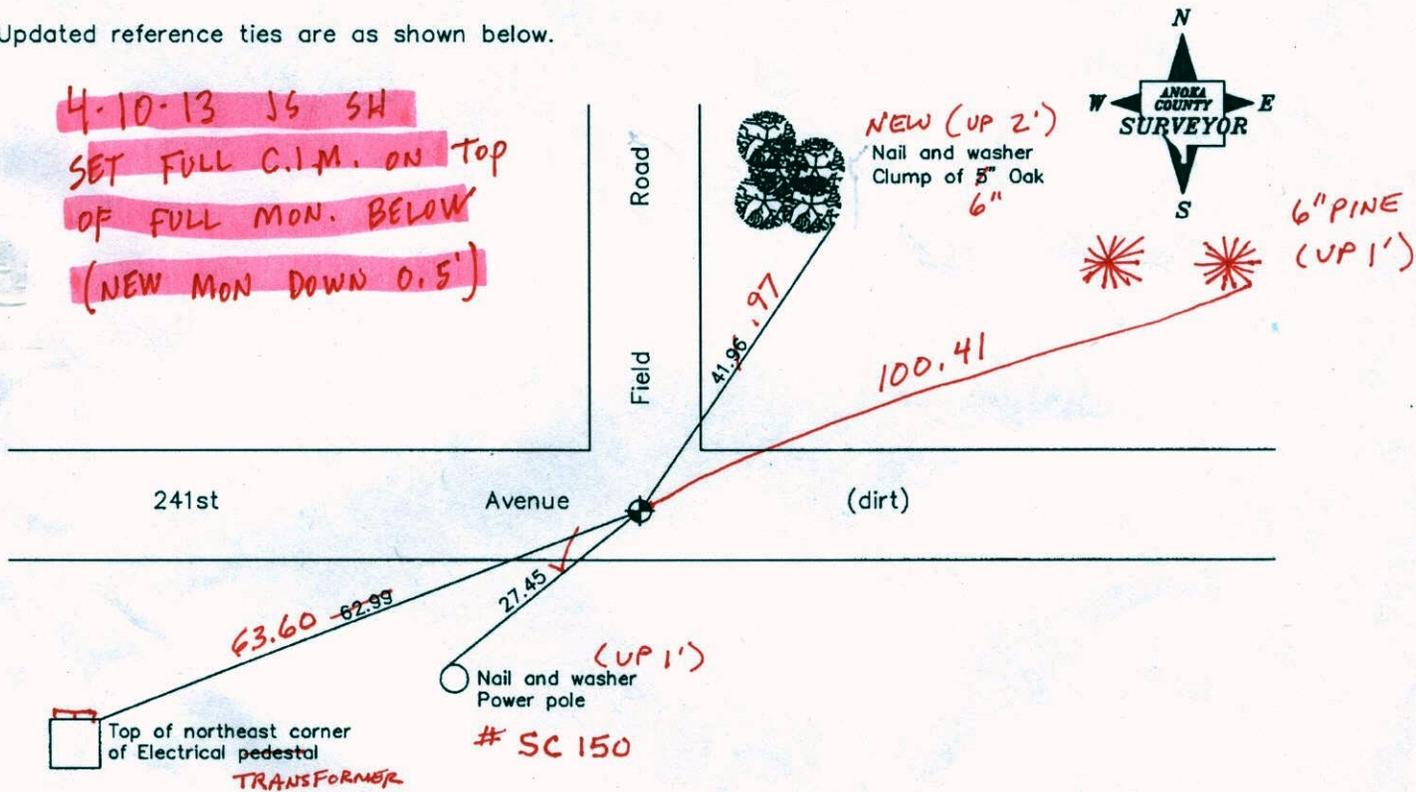

29
10-~~10~~-12
BK-SS
T/T

Revised date
8/05/92
8/07/97
5/15/02

N.A.D. 1983 Coordinates (1996 Adjustment)	
County Project Coordinates	
Northing	235399.2289
Easting	510800.5155
Date	5/15/02

I hereby certify that this United States public land survey monument record is correct and complete to the best of my knowledge and belief.

Larry D. Hoium Date 5/15/02

Larry D. Hoium, Anoka County Surveyor

Minnesota License Number 18165

CERTIFICATE OF LOCATION OF GOVERNMENT CORNER

County of Anoka

State of Minnesota


East 1/4 Corner of Sec. 29 Township 34 Range 23

On the 8th day of December, 1976, the described corner was evidenced by area resurvey

and to perpetuate the location of said corner, at the exact location thereof, a permanent marker was placed consisting of a cast iron monument (down 2'±)

AND on the 15th day of May, 2002, said permanent marker was found and the ties were updated

Updated reference ties are as shown below.

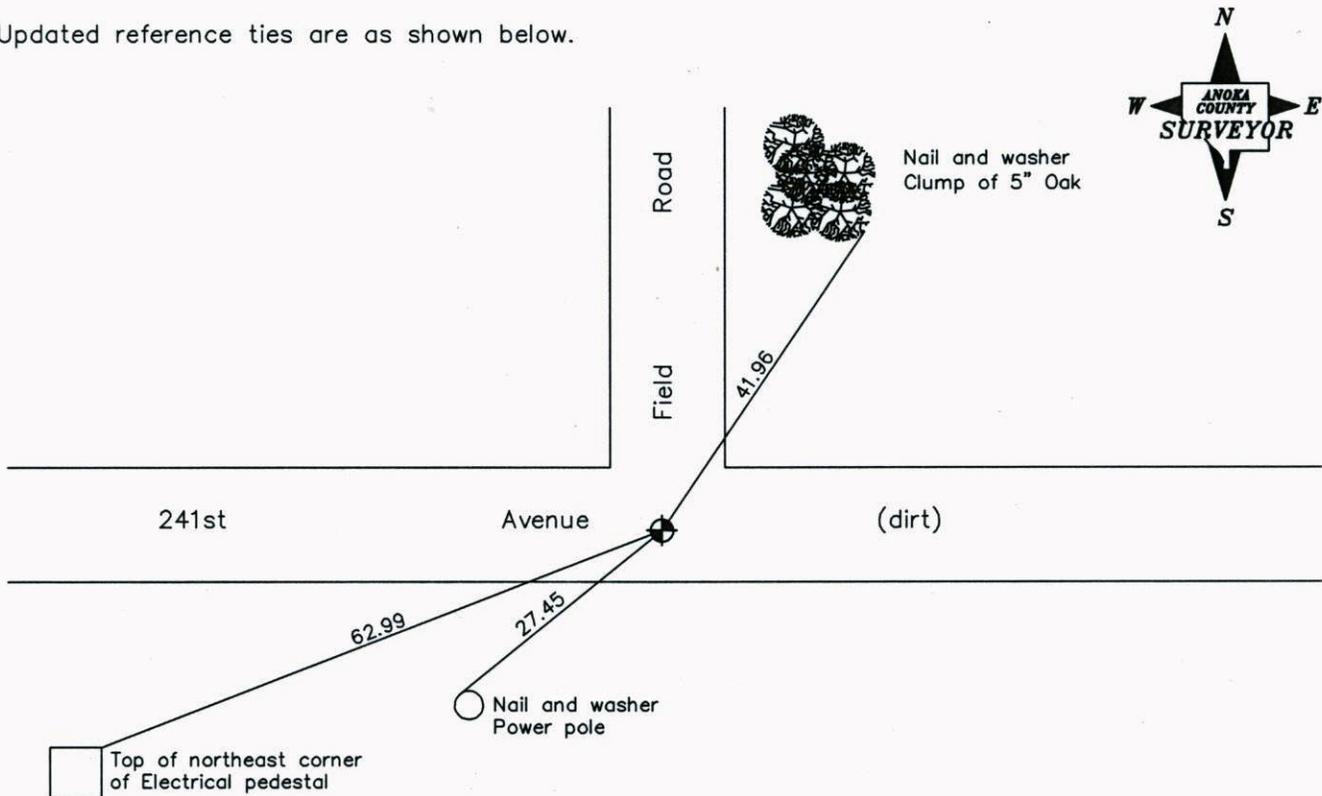

Revised date
8/05/92
8/07/97
5/15/02

N.A.D. 1983 Coordinates (1996 Adjustment)	
County Project Coordinates	
Northing	<u>235399.2289</u>
Easting	<u>510800.5155</u>
Date	<u>5/15/02</u>

I hereby certify that this United States public land survey monument record is correct and complete to the best of my knowledge and belief.

Larry D. Hoium Date 5/15/02
 _____, Anoka County Surveyor
 Minnesota License Number 18165

CERTIFICATE OF LOCATION OF GOVERNMENT CORNER

County of Anoka


State of Minnesota

EAST QTR. Corner of Sec. 29 Township 34 Range 23


I hereby certify that on the 8 day of DEC., 19 76, I found the described corner which was evidenced by AREA RESURVEY

and I further certify that to perpetuate the location of said corner, I did, at the exact location thereof, place a permanent marker consisting of CAST IRON MON.
DOWN 2'±

which reference or witness monuments are located in the manner following:

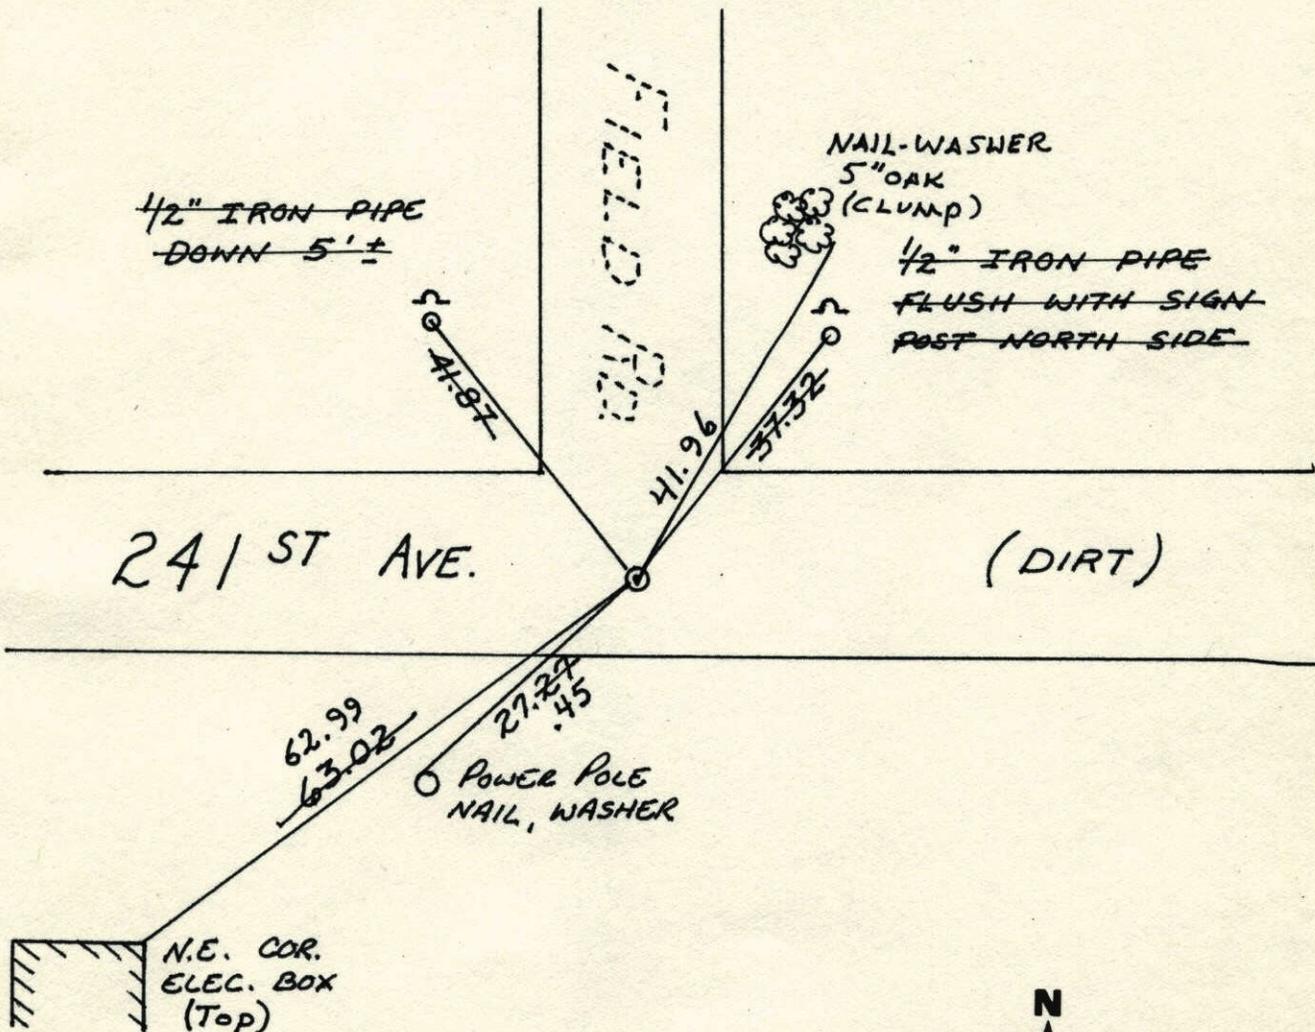


Revised date	Revised date	Revised date
8-6-86		
8-5-92		
8-7-97 HL		
5-15-02		

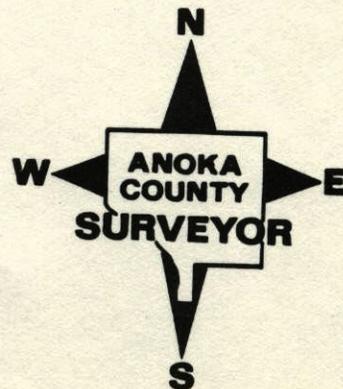

E 1/4 COR. SECTION 29-T34-R23


RESET CAST IRON MONUMENT TO NEW LOCATION.

CAST IRON DOWN 1'± AND 1'± SOUTH OF CENTERLINE.

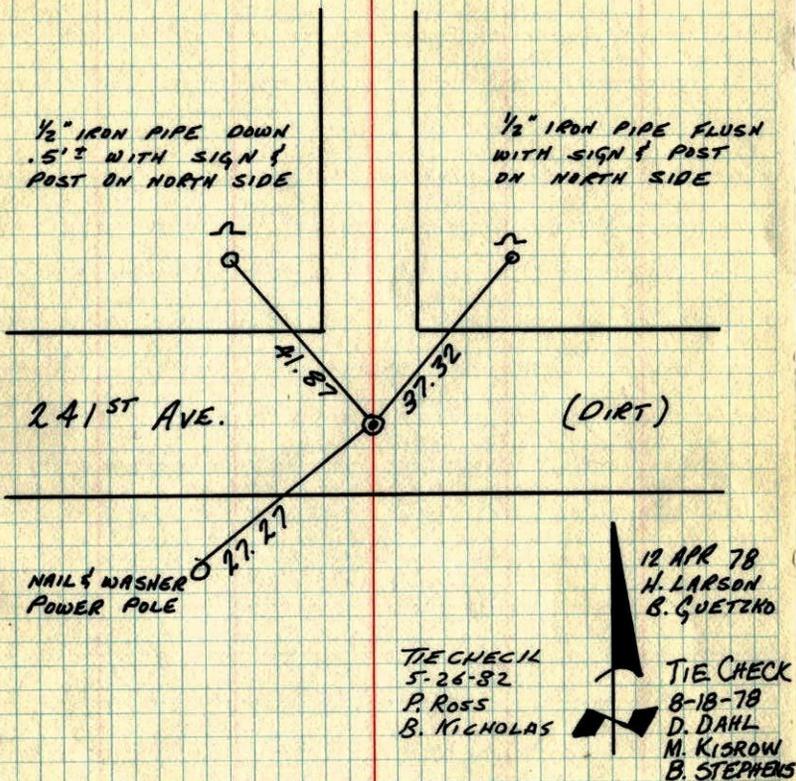TEMPERATURE CORRECTED
AND HORIZONTALLY
TAPED MEASUREMENTSROLAND W. ANDERSON
COUNTY SURVEYOR
ANOKA COUNTY, MINNESOTA



E 1/4 Cor. Section 29 T34 R23

Reset cast iron monument to

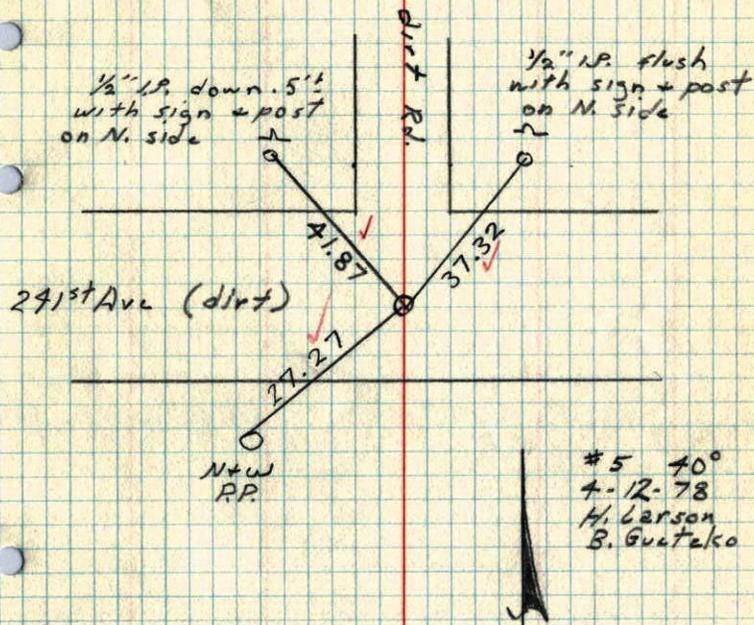new location E. 1 down 1'± and 1'±
south of &.

E
 29
 66
 W 1/4 COR. SEC. 28, T. 34, R. 23

SET CAST IRON MONUMENT FROM AREA
 RESURVEY. CAST IRON DOWN 0.5'±. SET
 1/2" IRON PIPES N.W. & N.E. AS TIE POINTS
 SIGNS & POSTS BY IRON PIPES.

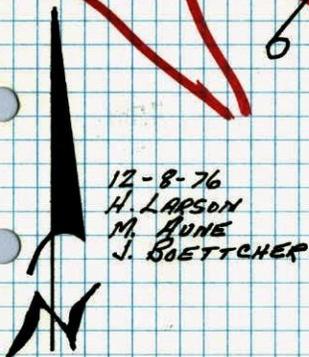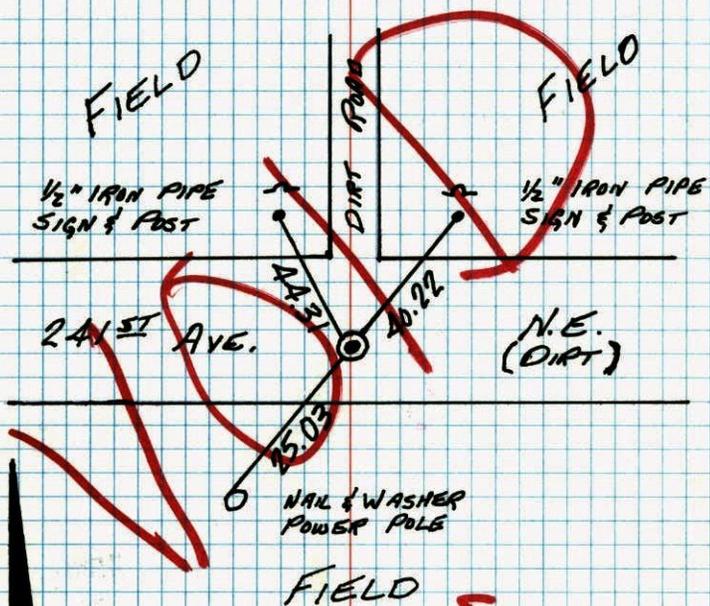


12-8-76
 H. LARSON
 M. RYNE
 J. BOETTCHER

See New
 Ties
 H. Larson
 E

TEMPERATURE CORRECTED AND HORIZONTALLY TAPED MEASUREMENTS
 ROLAND W. ANDERSON
 COUNTY SURVEYOR
 ANOKA COUNTY, MINNESOTA

E
 29
 W 1/4 Cor. Sec. 28 T34 R23

Set cast iron monument from area
 resurvey. C.I. down .5'± set 1/2" iron
 pipes N.W. & N.E. as tie points sign
 + posts by I.P.s.

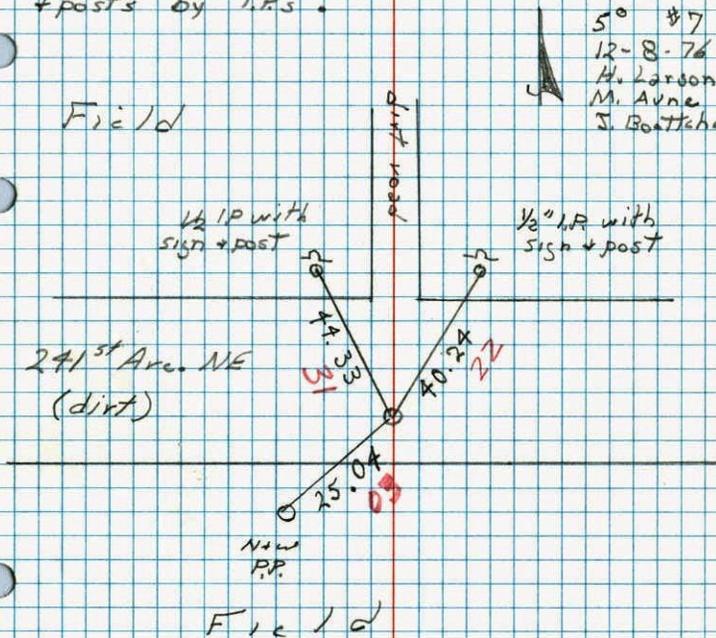

5° 47'
 12-8-76
 H. Larson
 M. Ryne
 J. Boettcher

Field