

CERTIFICATE OF LOCATION OF GOVERNMENT CORNER

County of Anoka

State of Minnesota

East 1/4 Corner of Sec. 27 Township 34 Range 23


On the 16th day of December, 1976, the described corner was evidenced by area resurvey

and to perpetuate the location of said corner, at the exact location thereof, a permanent marker was placed consisting of a cast iron monument with a sign and post on the north side

(Mon. DOWN 0.2'±)

AND on the 21st day of May, 2002, said permanent marker was found and the ties were updated

Updated reference ties are as shown below.

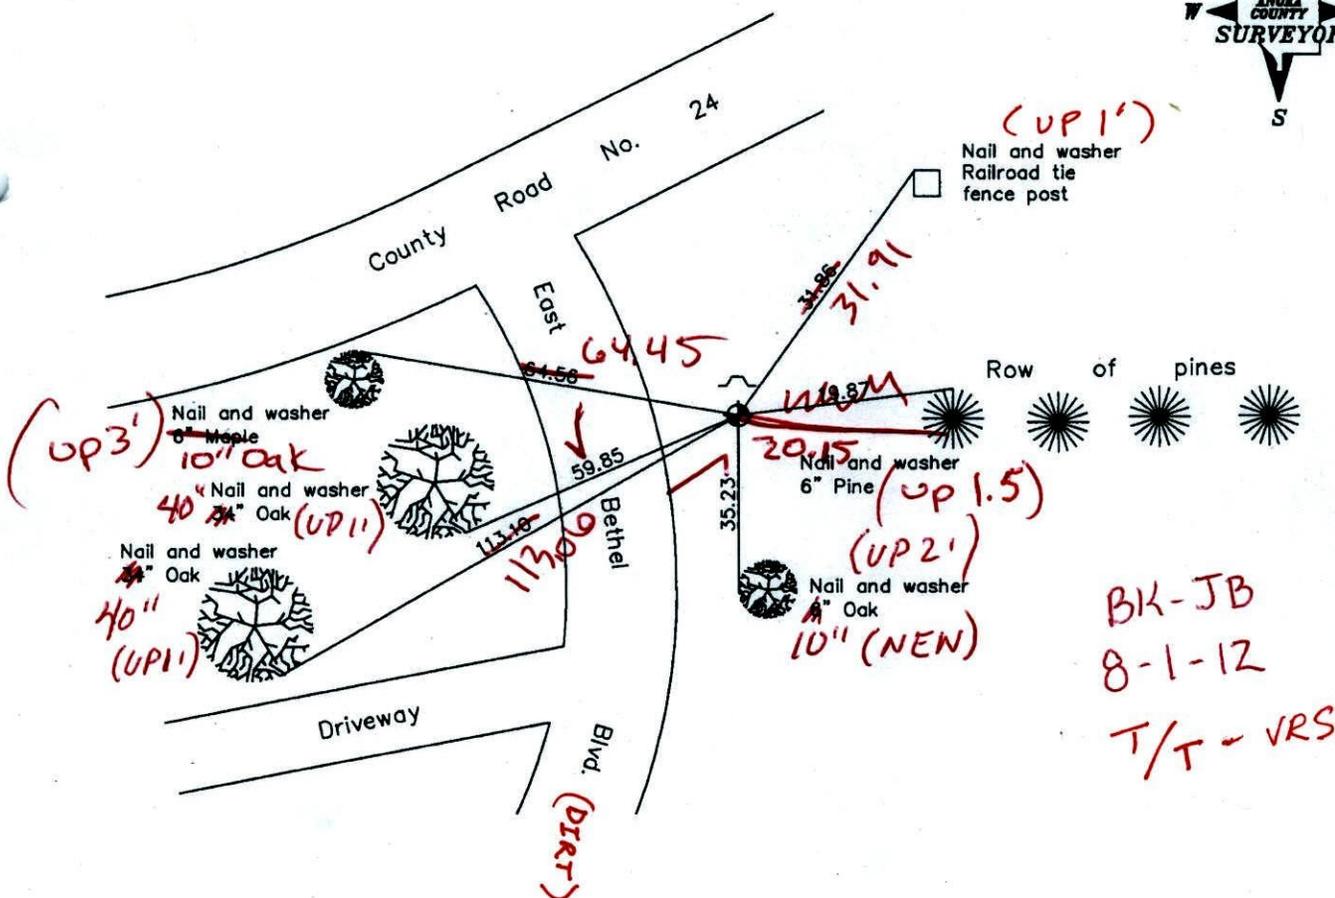

BK-JB
8-1-12
T/T - VRS

Revised date
8/04/92
8/04/97
5/21/02

N.A.D. 1983 Coordinates (1996 Adjustment)	
County Project Coordinates	
Northing	<u>235487.8459</u>
Easting	<u>521398.9857</u>
Date	<u>5/21/02</u>

I hereby certify that this United States public land survey monument record is correct and complete to the best of my knowledge and belief.

Larry D. Holm Date 5/21/02

Larry D. Holm, Anoka County Surveyor

Minnesota License Number 18165

VRS 3D = 0.07 N = 235487.7968 E = 521398.8249

CERTIFICATE OF LOCATION OF GOVERNMENT CORNER

County of Anoka


State of Minnesota

EAST 1/4 Corner of Sec. 27 Township 34 Range 23


I hereby certify that on the 16 day of December, 1976, I found the described corner which was evidenced by Area Re Survey

and I further certify that to perpetuate the location of said corner, I did, at the exact location thereof, place a permanent marker consisting of CAST IRON MONUMENT WITH
Sign Post N. Side

which reference or witness monuments are located in the manner following:

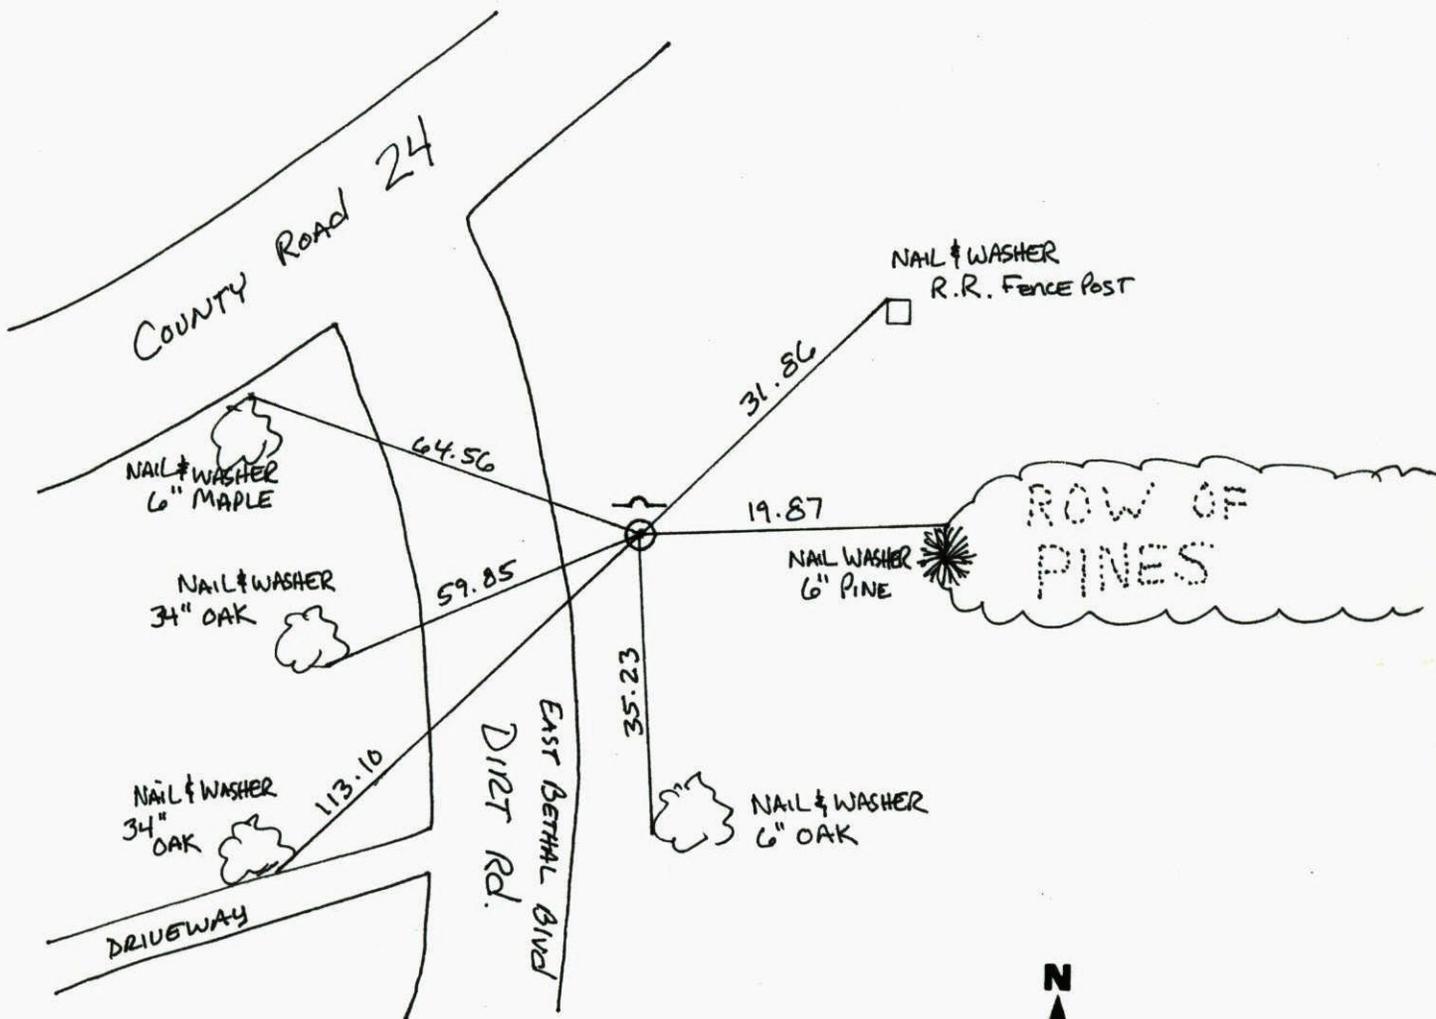


Revised date	Revised date	Revised date
8-1-86		
8-4-92		
8-4-97		
5-21-02		

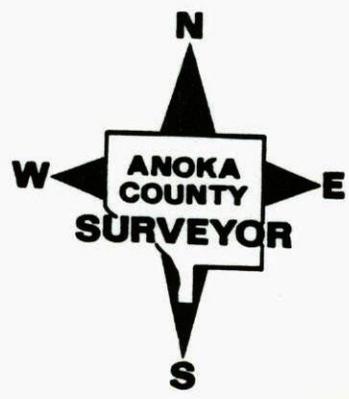

E 1/4 COR. SEC. 27-T34-R23

SET CAST IRON MONUMENT FROM AREA
RESURVEY. CAST IRON FLUSH WITH SIGN
AND POST ON NORTH SIDE.

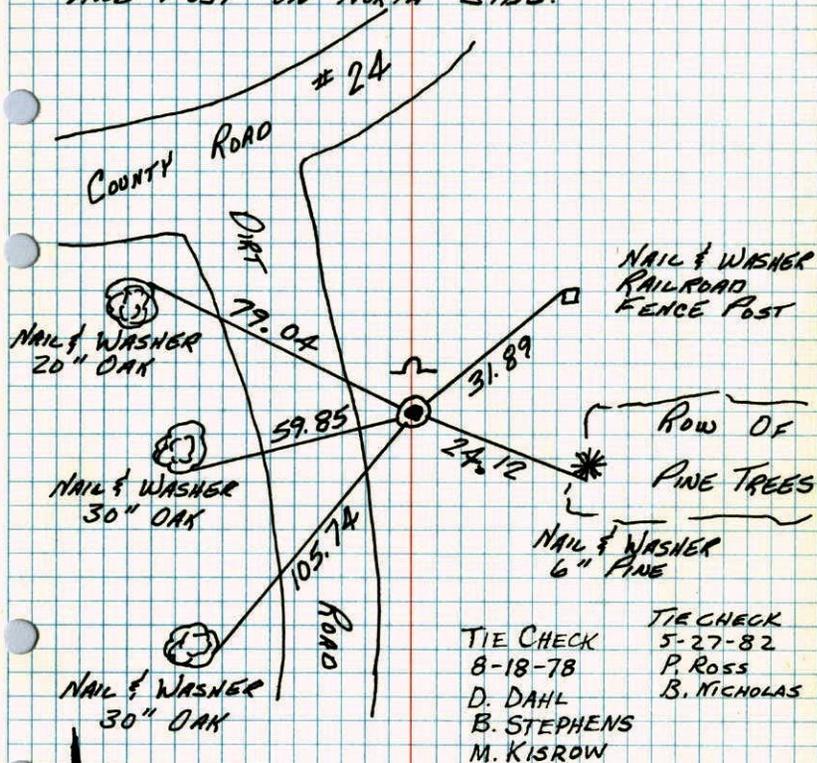

TIE CHECK	TIE CHECK
8-18-78	5-27-82
D. DAHL	P. ROSS
B. STEPHENS	B. NICHOLAS
M. KISROW	


12-16-76
H. LARSON
B. GUETZKO
J. BOETTCHER

TEMPERATURE CORRECTED
AND HORIZONTALLY
TAPED MEASUREMENTS

ROLAND W. ANDERSON
COUNTY SURVEYOR
ANOKA COUNTY, MINNESOTA

E 1/4 Cor. Sec. 27 T34 R23

Set cast iron monument from area
resurvey. C.I. Flush with sign & post
on North side

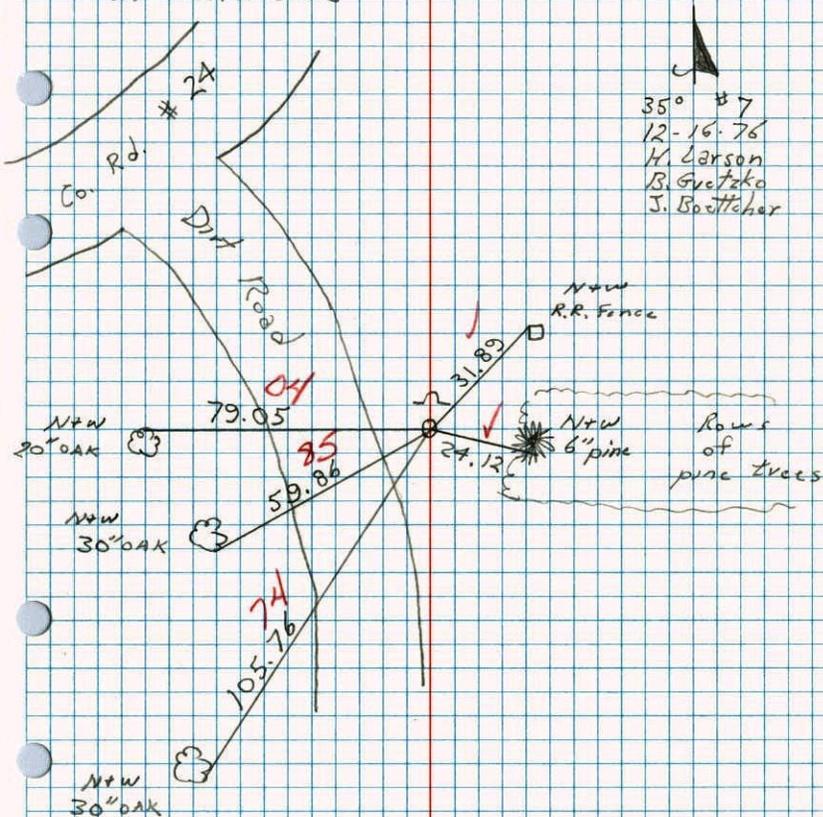

35° #7
12-16-76
H. Larson
B. Guetzko
J. Boettcher