CERTIFICATE OF LOCATION OF GOVERNMENT CORNER

County of Anoka State of Minnesota

Witness Corner of Sec. 25 Township 34 Range 23
(on west line of NW 1/4)

On the 5th day of October, 1978, the described corner was evidenced by a 1/2" iron pipe

and to perpetuate the location of said corner, at the exact location thereof, a permanent marker was placed consisting of a cast iron monument ~~with P.K.'s 2.00' north and east~~ FOUND DOWN 0.2'± RAISED FLUSH W/ RD. SURFACE

AND on the ___ day of _____, ____, said permanent marker was _____

Updated reference ties are as shown below.

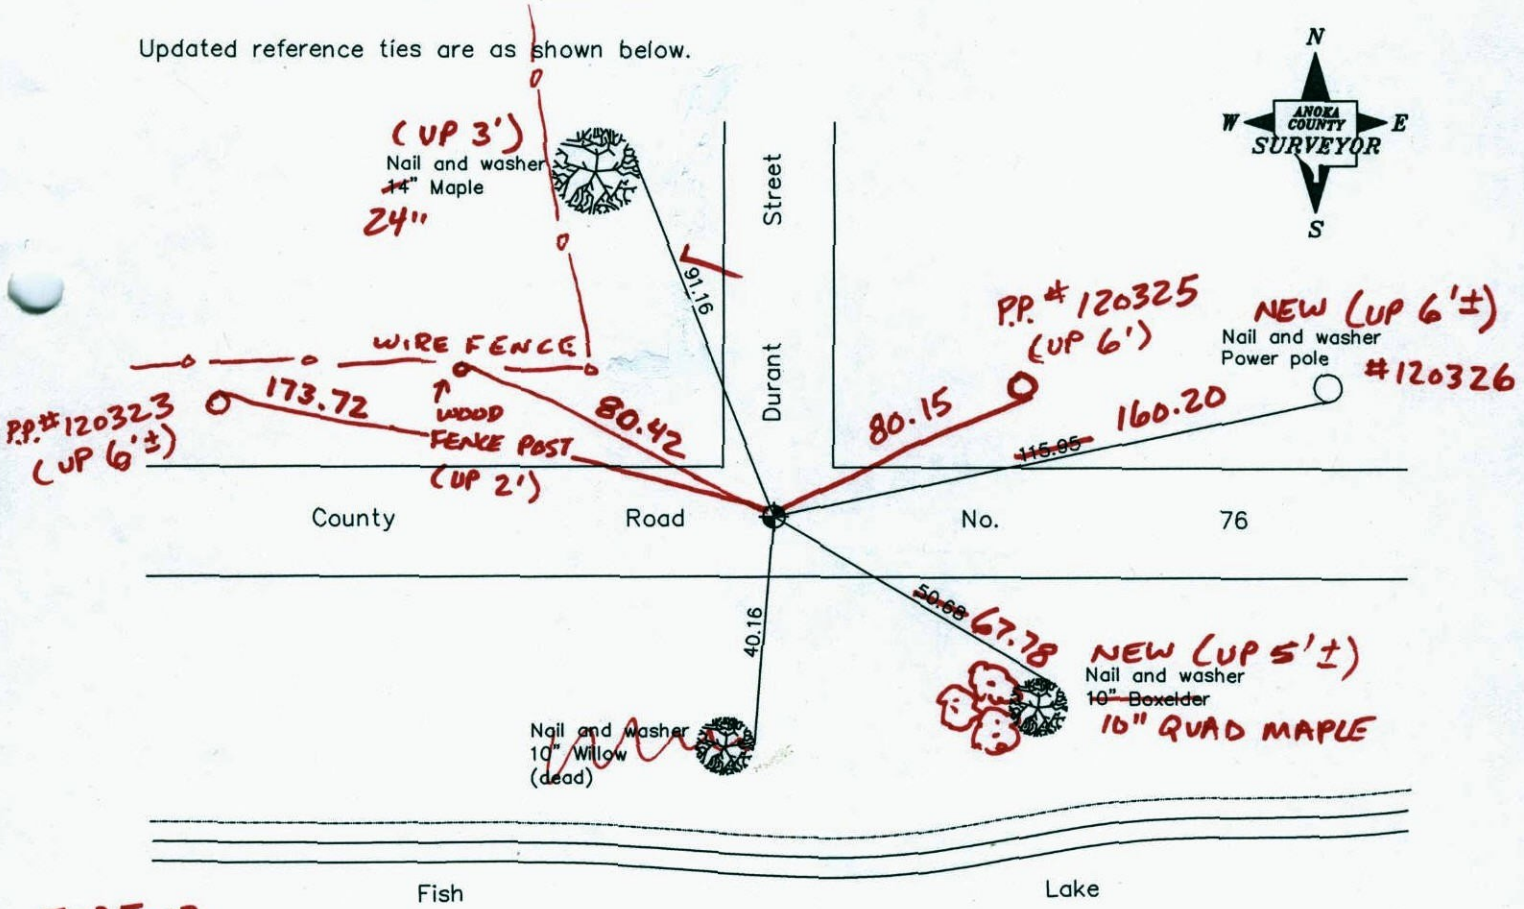

7-25-12
BK-SS
T/A-VRS

Revised date

8/01/86
8/04/92
8/04/97

N.A.D. 1983 Coordinates
(1996 Adjustment)

County Project Coordinates	
Northing	236194.0251
Easting	526654.5239
Date	5/22/02

I hereby certify that this United States public land survey monument record is correct and complete to the best of my knowledge and belief.

_____ Date _____

_____, Anoka County Surveyor

Minnesota License Number _____

VRS 3D = 0.05 N = 236194.0495 E = 526654.5026

CERTIFICATE OF LOCATION OF GOVERNMENT CORNER

County of Anoka *State of Minnesota*

WITNESS ON W. LINE OF
NORTHWEST QTR. Corner of Sec. 25 Township 34 Range 23

I hereby certify that on the 5 *day of* OCT. , 19 78, *I found the described corner which was evidenced by* 1/2" I.P.

and I further certify that to perpetuate the location of said corner, I did, at the exact location thereof, place a permanent marker consisting of CAST IRON MON.
P.K.'S 2.00' N. & E.

which reference or witness monuments are located in the manner following:

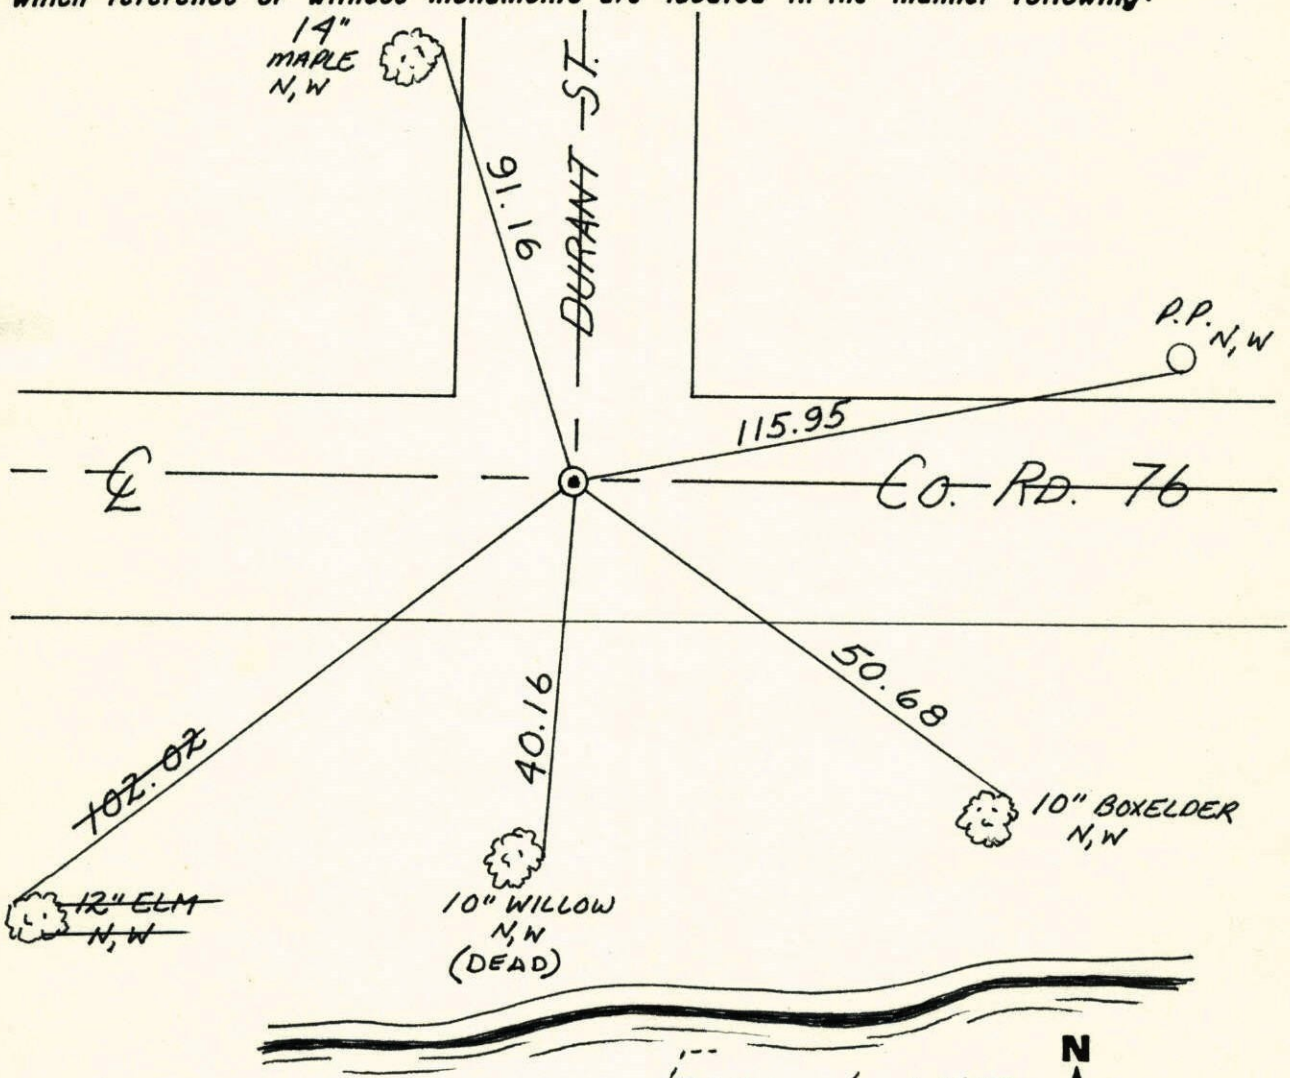

Revised date	Revised date	Revised date
8-1-86		
8-4-92		
" " 97		

N
W ANOKA COUNTY SURVEYOR E
S

69A

WITNESS CORNER ON WEST LINE OF NW 1/4 SEC. 25 T34-R23

SET CAST IRON MONUMENT IN PLACE OF 1/2" IRON PIPE SET BY N.C. HOLUM. CAST IRON FLUSH WITH PK'S 2.00' NORTH AND EAST.

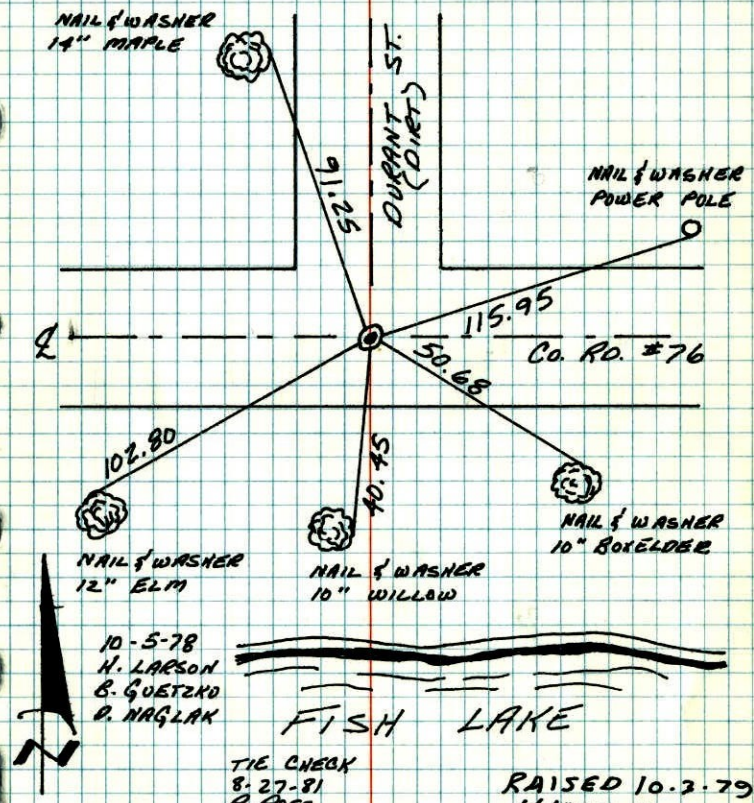

TIE CHECK
8-27-81
P. ROSS
P. HORNBY

RAISED 10-3-79
H. LARSON
B. Guetzko
D. Naglak

TEMPERATURE CORRECTED AND HORIZONTALLY TAPED MEASUREMENTS

ROLAND W. ANDERSON
COUNTY SURVEYOR
ANOKA COUNTY, MINNESOTA

NO. 448 TELEDYNE

W.C. on West line of NW 1/4
Sec. 25 T34 R23
Set cast iron monument in place of
1/2" iron pipe set by N.C. Holum.
C.I. flush with PKs 2.00' North & East.

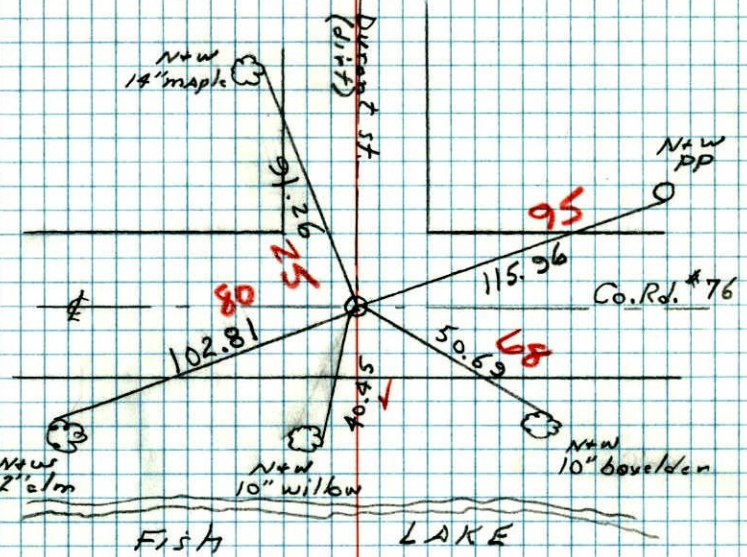

#1 45°
10-5-78
H. Larson
B. Guetzko
D. Naglak

NO. 448 TELEDYNE