

1-11-13 BROKEN
NEED TO STATIC FIN.

CERTIFICATE OF LOCATION OF GOVERNMENT CORNER

County of Anoka

State of Minnesota

East 1/4 Corner of Sec. 25 Township 34 Range 23


On the 23rd day of July, 1962, the described corner was evidenced by a 1 1/2" iron pipe

and to perpetuate the location of said corner, at the exact location thereof, a permanent marker was placed consisting of a cast iron monument POSSIBLE RESET BROKEN??

AND on the 22nd day of May, 2002, said permanent marker was found and the ties were updated

JS SH 5-29-13 SET CIM. & RETIED
NEW TIES CIRCLED

Updated reference ties are as shown below.

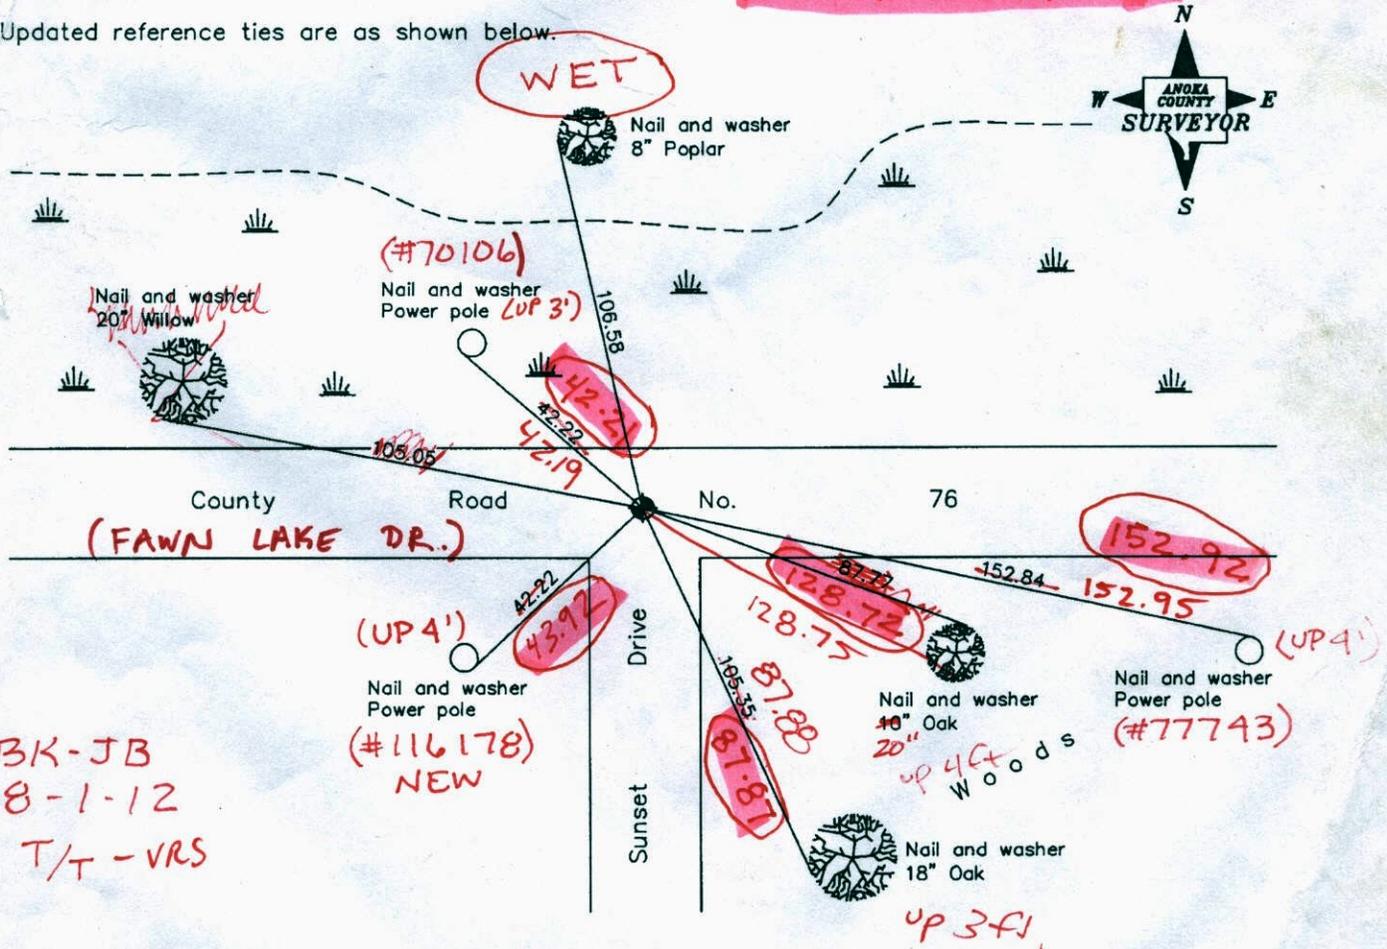

BK-JB
8-1-12
T/T-VRS

Revised date

8/05/92
8/11/97
5/22/02

N.A.D. 1983 Coordinates
(1996 Adjustment)

County Project Coordinates	
Northing	<u>235406.5953</u>
Easting	<u>531974.0032</u>
Date	<u>5/22/02</u>

I hereby certify that this United States public land survey monument record is correct and complete to the best of my knowledge and belief.

Larry D. Hoium Date 5/22/02
Larry D. Hoium, Anoka County Surveyor
Minnesota License Number 18165

VRS 30=0.06

N = 235406.5975

E = 531973.9618

Point Id	Point Class	Date/Time	Northing	Easting	Ellip. Hgt.	Ortho. Hgt.	Geoid Sep.
<input checked="" type="checkbox"/> DNR	Control	01/14/2013 10:02:59	203406.0634	546197.8802	-116.0071	900.3644	-1016.3716
<input checked="" type="checkbox"/> bethall	Control	01/14/2013 10:31:44	222531.8393	513652.0959	-98.1834	919.5589	-1017.7422
<input checked="" type="checkbox"/> EB33	Averaged	01/14/2013 11:20:54	219566.0813	520971.1975	-93.6335	923.9931	-1017.6266
<input checked="" type="checkbox"/> EB101	Averaged	01/14/2013 13:10:34	200678.5240	521239.1423	-111.4025	905.5345	-1016.9370
<input checked="" type="checkbox"/> EB71	Averaged	01/14/2013 14:53:14	235406.6324	531973.9704	-97.7330	920.1699	-1017.9029

S:0.16 W:0.06

S:0.02 W:0.09

S:0.04 E:0.03

CERTIFICATE OF LOCATION OF GOVERNMENT CORNER

County of Anoka

State of Minnesota


East 1/4 Corner of Sec. 25 Township 34 Range 23

On the 23rd day of July, 1962, the described corner was evidenced by a 1 1/2" iron pipe

and to perpetuate the location of said corner, at the exact location thereof, a permanent marker was placed consisting of a cast iron monument

AND on the 22nd day of May, 2002, said permanent marker was found and the ties were updated

Updated reference ties are as shown below.

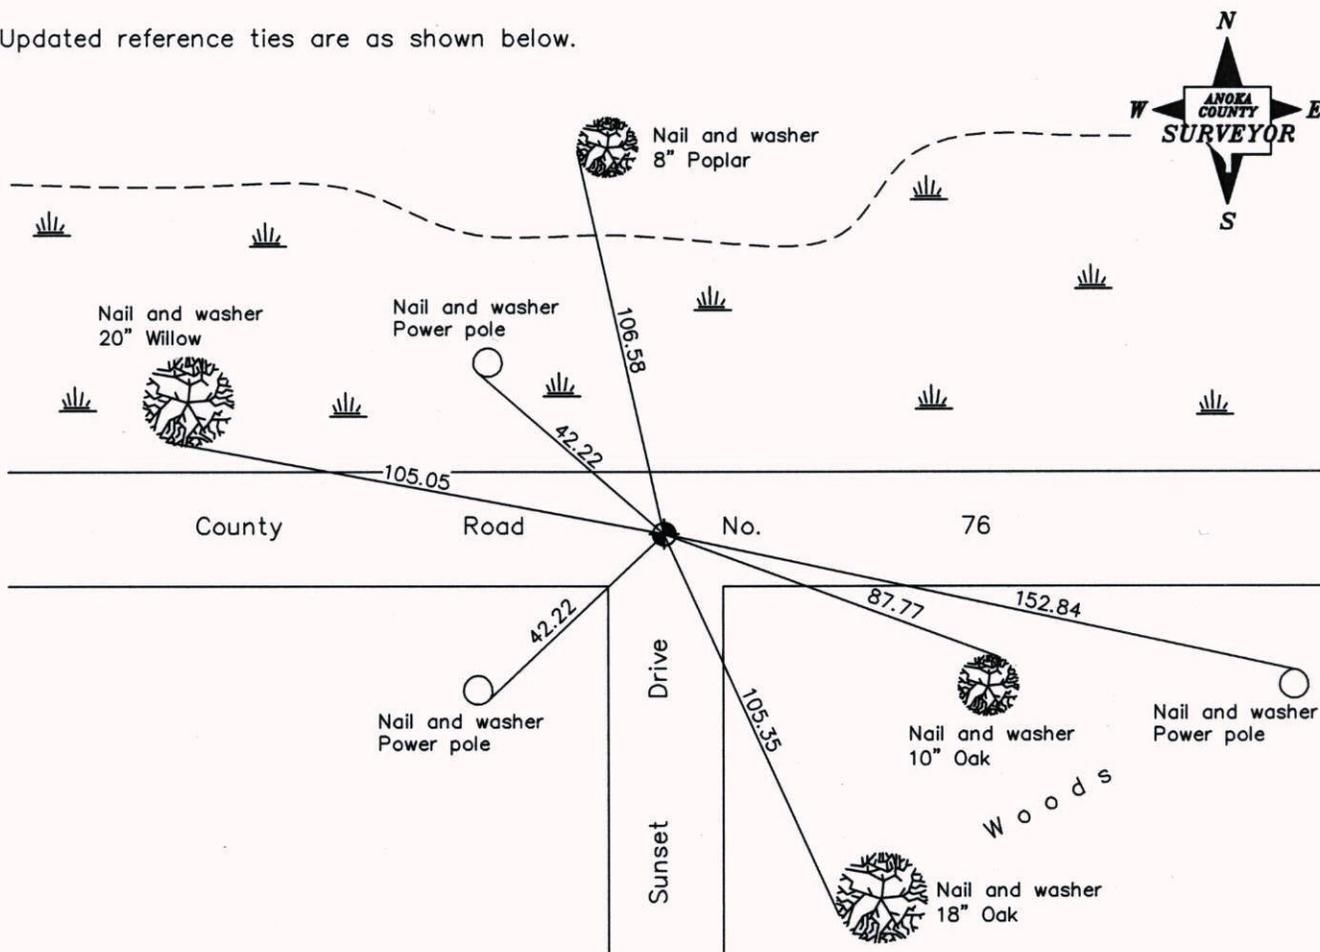

Revised date

8/05/92
8/11/97
5/22/02

**N.A.D. 1983 Coordinates
(1996 Adjustment)**

County Project Coordinates	
Northing	<u>235406.5953</u>
Easting	<u>531974.0032</u>
Date	<u>5/22/02</u>

I hereby certify that this United States public land survey monument record is correct and complete to the best of my knowledge and belief.

Larry D. Hoium Date 5/22/02
 _____, Anoka County Surveyor
 Minnesota License Number 18165

CERTIFICATE OF LOCATION OF GOVERNMENT CORNER

County of Anoka


State of Minnesota

EAST QTR. Corner of Sec. 25 Township 34 Range 23


I hereby certify that on the 23 day of JULY, 1962, I found the described corner which was evidenced by 1 1/2" I.P.

and I further certify that to perpetuate the location of said corner, I did, at the exact location thereof, place a permanent marker consisting of CAST IRON MON.

which reference or witness monuments are located in the manner following:

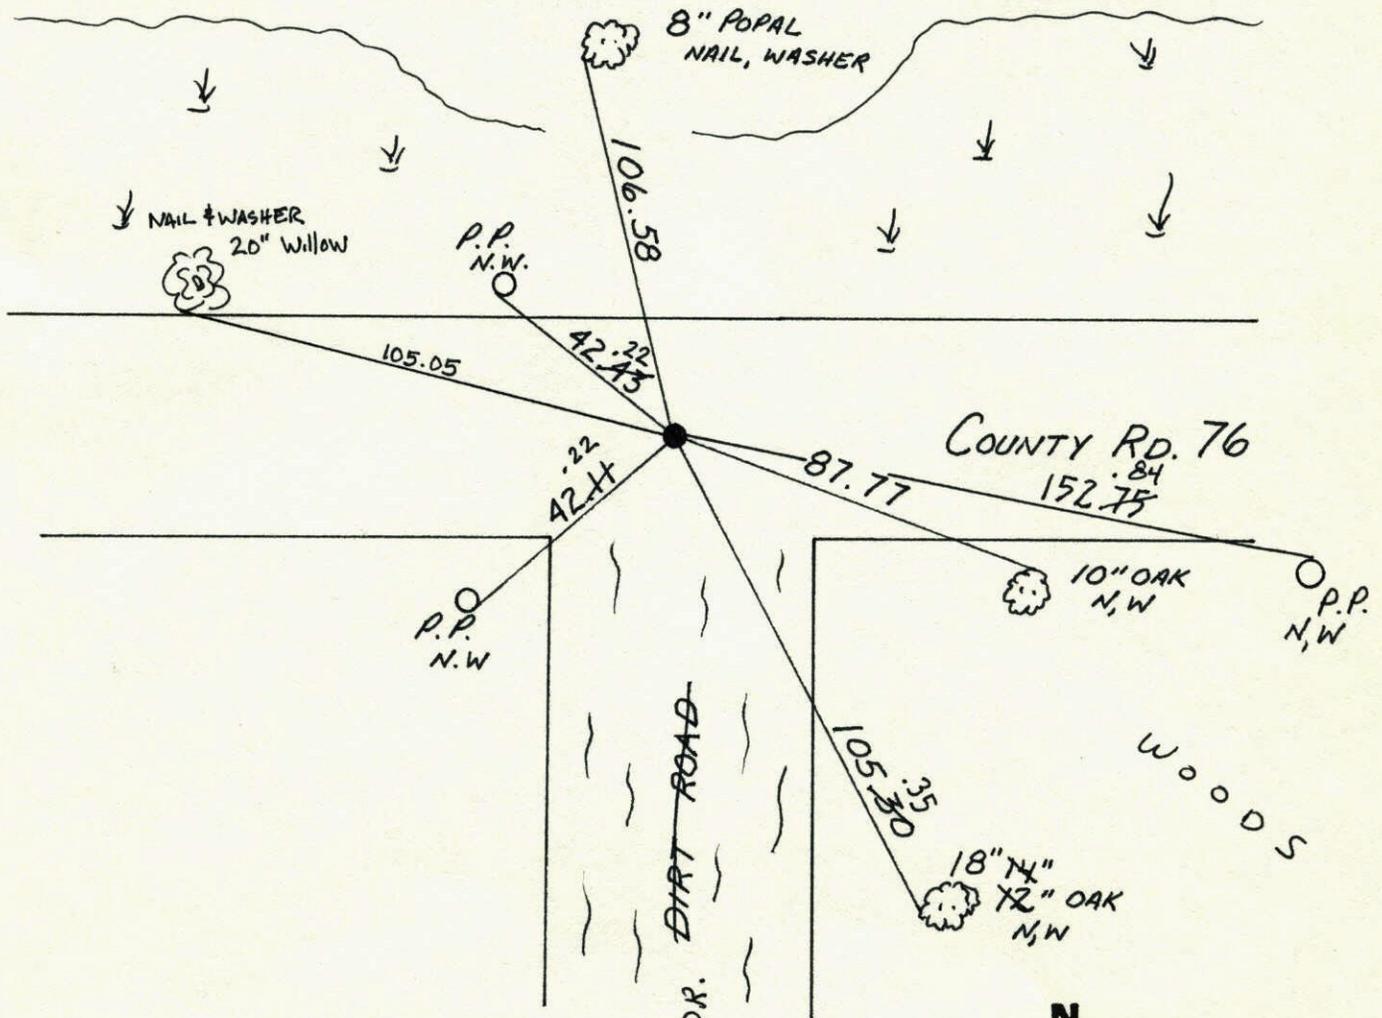

Revised date	Revised date	Revised date
8-1-86		
8-5-92		
8-11-97		
5-22-02		

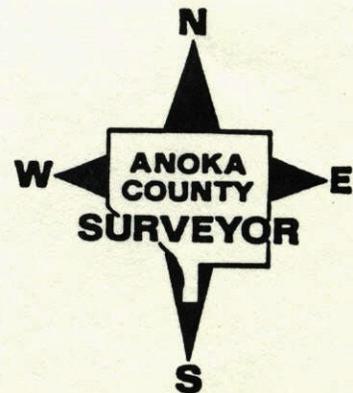

SUNSET DR. DIRT ROAD

71
E 1/4 Cor. Sec. 25-T34-R23

Replaced 1 1/2" Iron Pipe with Cast Iron
Monument flush. PK's 2.00' North+East.

8" Popal
Nail+Washer

August 5, 1968
D. Powell
R. Olson
P. Pich

Tie Check
Aug. 16, 1971
R. Bogen
J. Boettcher
B. Olson

Guy
Telephone Pole
Nail+Washer

106.58
85.58

49.52
41.57
21.90
16.70

County
Road #76

87.73
77

Nail+Washer
POWER POLE

TIE CHECK
8-27-81
P. ROSS
P. HORNBY

10" Oak
Nail+Washer

98.41
98.41

105.51
76

12
6" Oak
Nail+Washer
NEW

9" Popal
Nail+Washer

Dirt
Road

TIE CHECK
8-18-78
D. DAHL
B. STEPHENS
M. KISROW

RAISED
10-2-79
H. LARSON
B. GUTZK.
D. NAELAK

TIE CHECK
8-8-75
D. DAHL
B. SANDERUD
G. ADAMS

TEMPERATURE CORRECTED
AND HORIZONTALLY
TAPED MEASUREMENTS

ROLAND W. ANDERSON
COUNTY SURVEYOR
ANOKA COUNTY, MINNESOTA

E 1/4 Cor. Sec. 25, T34, R23

Found 1 1/2" I. P. Sticking up 0.3'



N+win 8"
Popal

23 July 62

68

J. O. Tiver
R. Carlson

TEMP. CORR.

N+win T.P.

106.58

0.48.52

Rd. #76

87.81

N+win 10"
Oak

N+win 9" Popal

98.41

105.472

N+win 6" Oak

Co.

E 1/4 Cor. Sec. 25-34-23

2

Found 1/2" iron pipe up 0.3'

8" Popal
Nail & Washer

July 23, 1962

J. Oliver
R. Carlson

7.4"
Nail & Washer

85.58

48.54

9" Popal
Nail & Washer

98.41

COUNTY

ROLL
COUNTY SURVEY
AND
TEMPERATURE

10" Oak
Nail & Washer


6" Oak
Nail & Washer

E 1/4 Cor. Sec. 25, T 34, R 23

2


1/2" Iron Pipe

New Ties in
New Tie Book

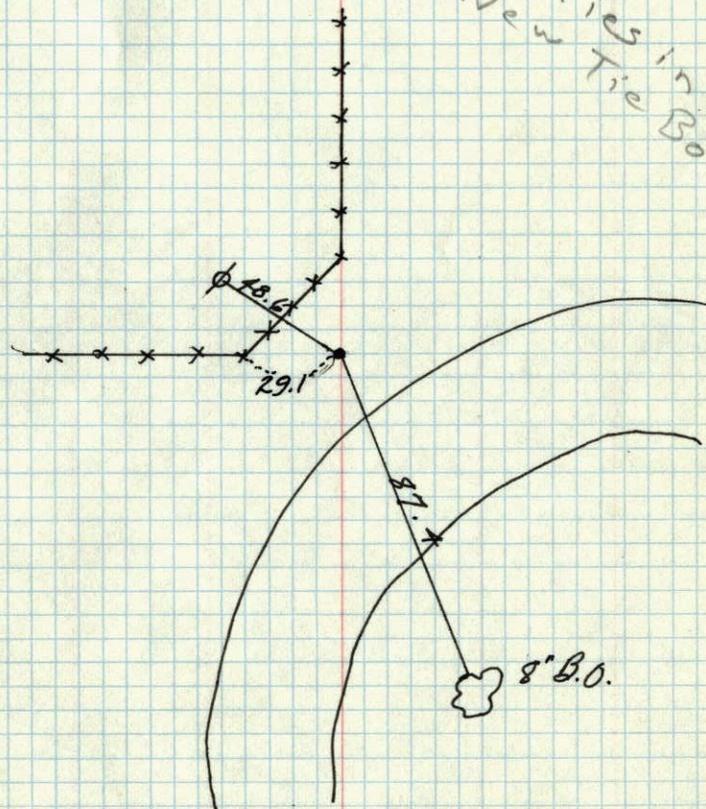

E 1/4 Cor

SEC 25 T.34 R.23

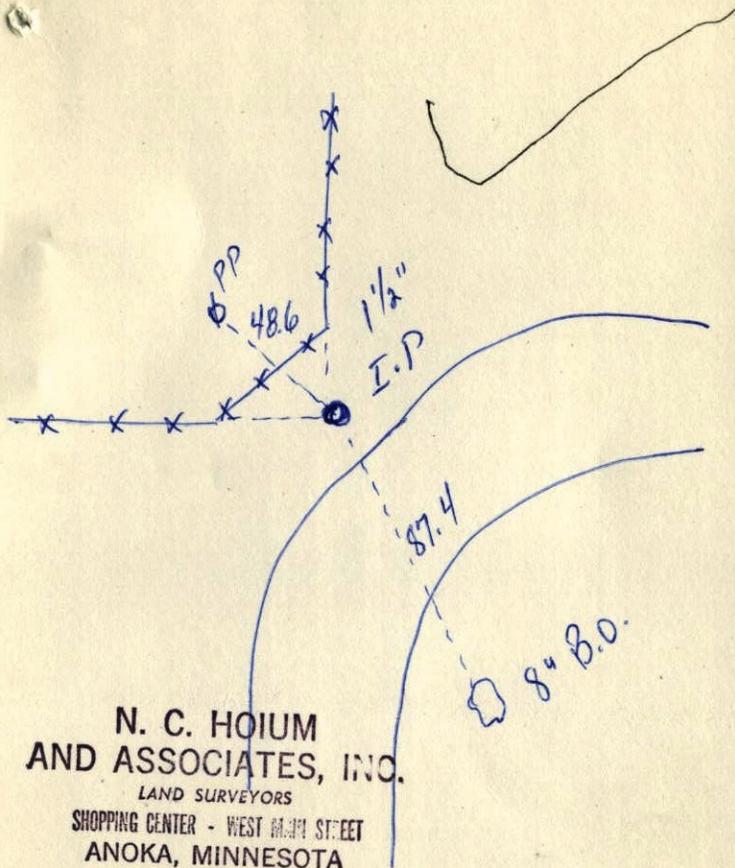

N. C. HOIUM
AND ASSOCIATES, INC.
LAND SURVEYORS
SHOPPING CENTER - WEST MAIN STREET
ANOKA, MINNESOTA
Harrison 1-6340