Page No. 72

CERTIFICATE OF LOCATION OF GOVERNMENT CORNER

County of Anoka State of Minnesota

Southeast Corner of Sec. 25 Township 34 Range 23

On the 2nd day of May, 1975, the described corner was evidenced by a 1" iron pipe

and to perpetuate the location of said corner, at the exact location thereof, a permanent marker was placed consisting of a cast iron monument (1' ± W. OF ℄)

AND on the 22nd day of May, 2002, said permanent marker was found and the ties were updated

Updated reference ties are as shown below.

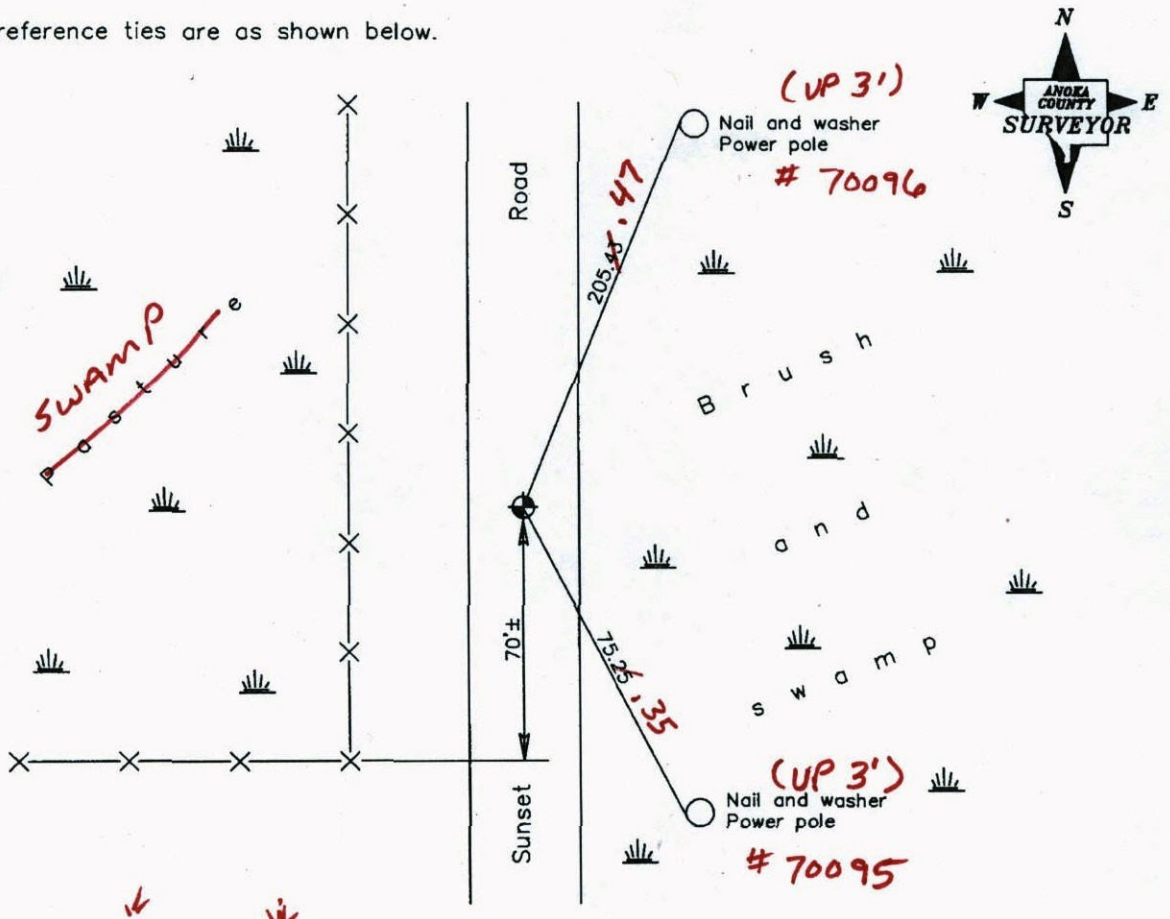

4-27-12
BK-SS
T/T - VRS

Revised date
6/02/97
8/11/97
5/22/02

N.A.D. 1983 Coordinates
(1996 Adjustment)

County Project Coordinates	
Northing	232767.0941
Easting	531985.1914
Date	5/22/02

I hereby certify that this United States public land survey monument record is correct and complete to the best of my knowledge and belief.

Larry D. Hoium Date 5/22/02

Larry D. Hoium, Anoka County Surveyor

Minnesota License Number 18165

VRS 3D = 0.05 N = 232767.0888 E = 531985.1265

CERTIFICATE OF LOCATION OF GOVERNMENT CORNER

County of Anoka State of Minnesota

SOUTHEAST Corner of Sec. 25 Township 34 Range 23

I hereby certify that on the 2ND day of MAY, 19 75, I found the described corner which was evidenced by 1" IRON PIPE

and I further certify that to perpetuate the location of said corner, I did, at the exact location thereof, place a permanent marker consisting of CAST IRON MONUMENT

which reference or witness monuments are located in the manner following:

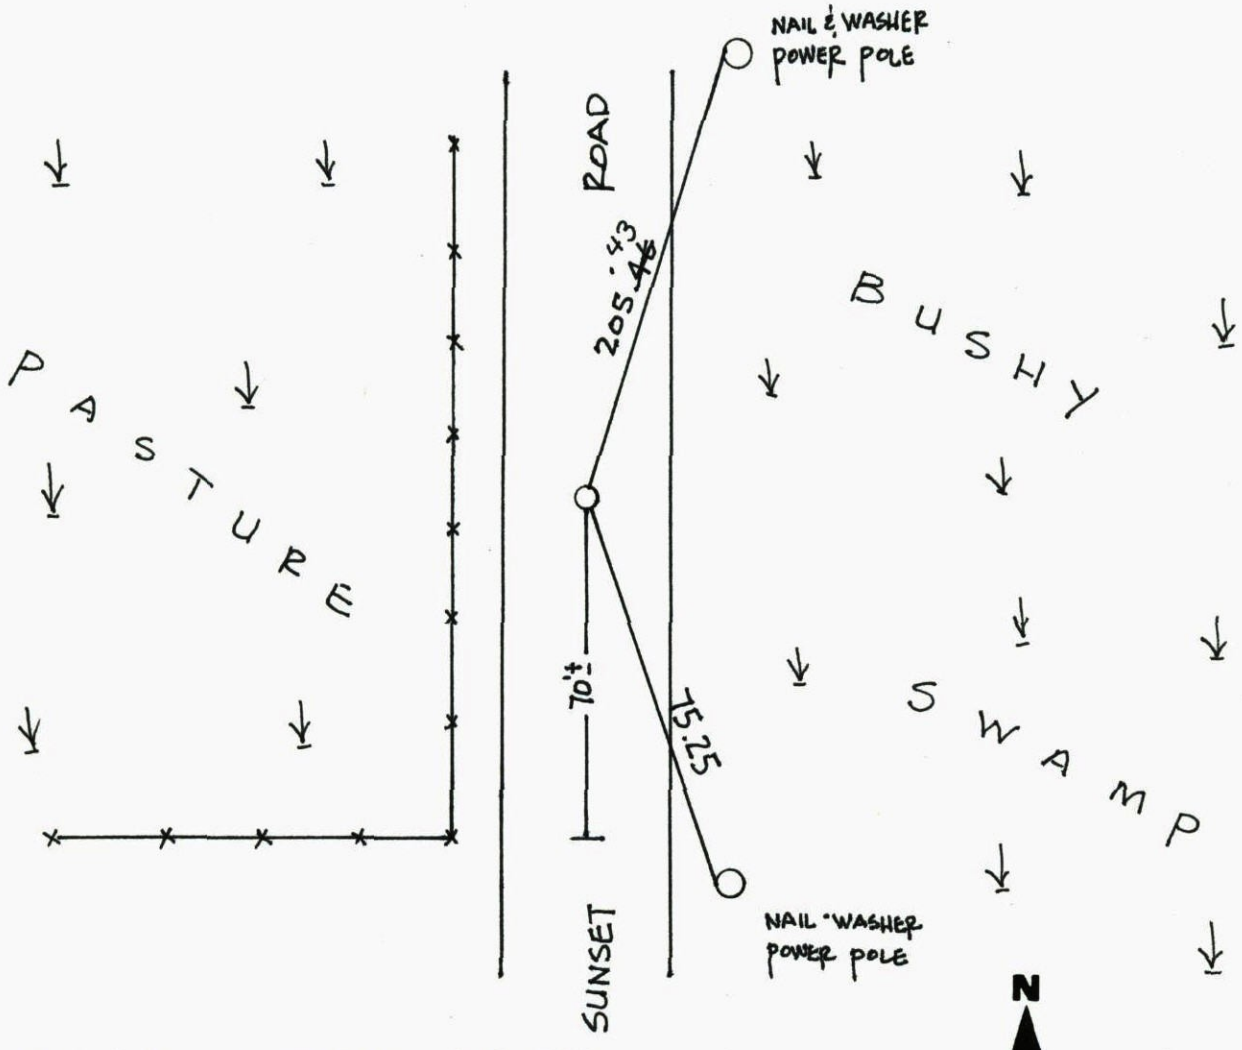

Revised date	Revised date	Revised date
8-5-92		
10-28-93 R.P.		
6-2-97		
8-11-97		
5-22-02		

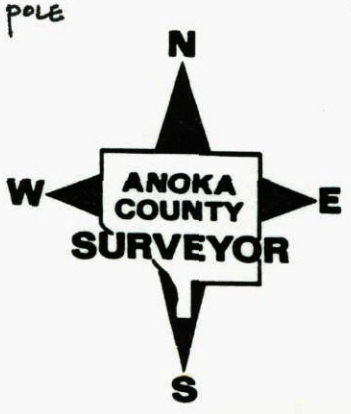

SE COR SEC. 25 T34 R23

REPLACED CAST IRON. MOVED TO ORGINAL POSITION.

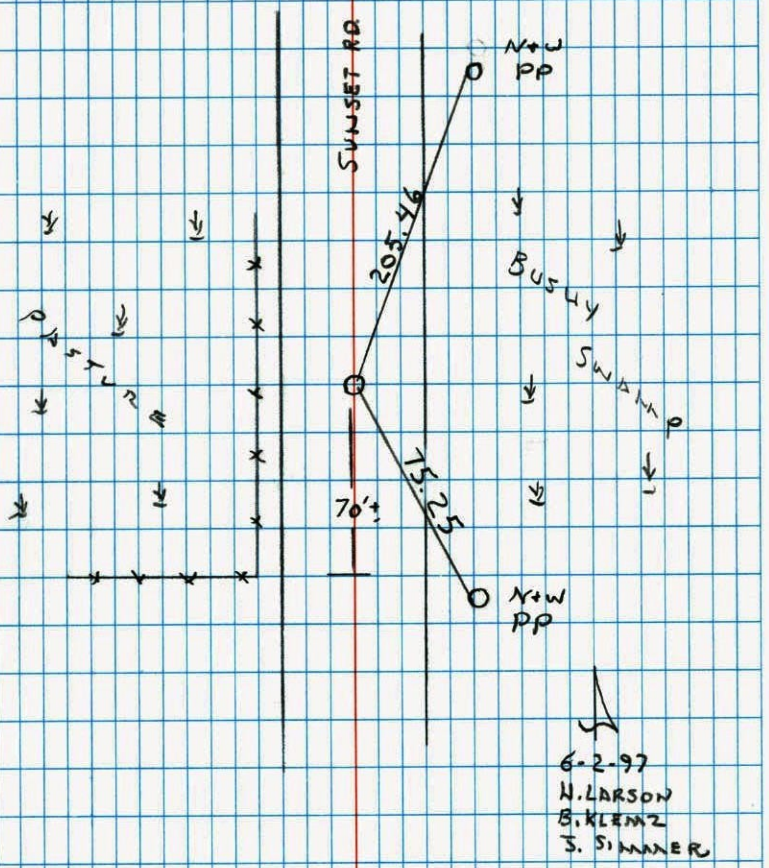

NO. 446
NATIONAL PRINTFAST

SE CORNER SEC. 25 T34 R23

REPLACED CAST IRON AFTER CONST.

RETIED

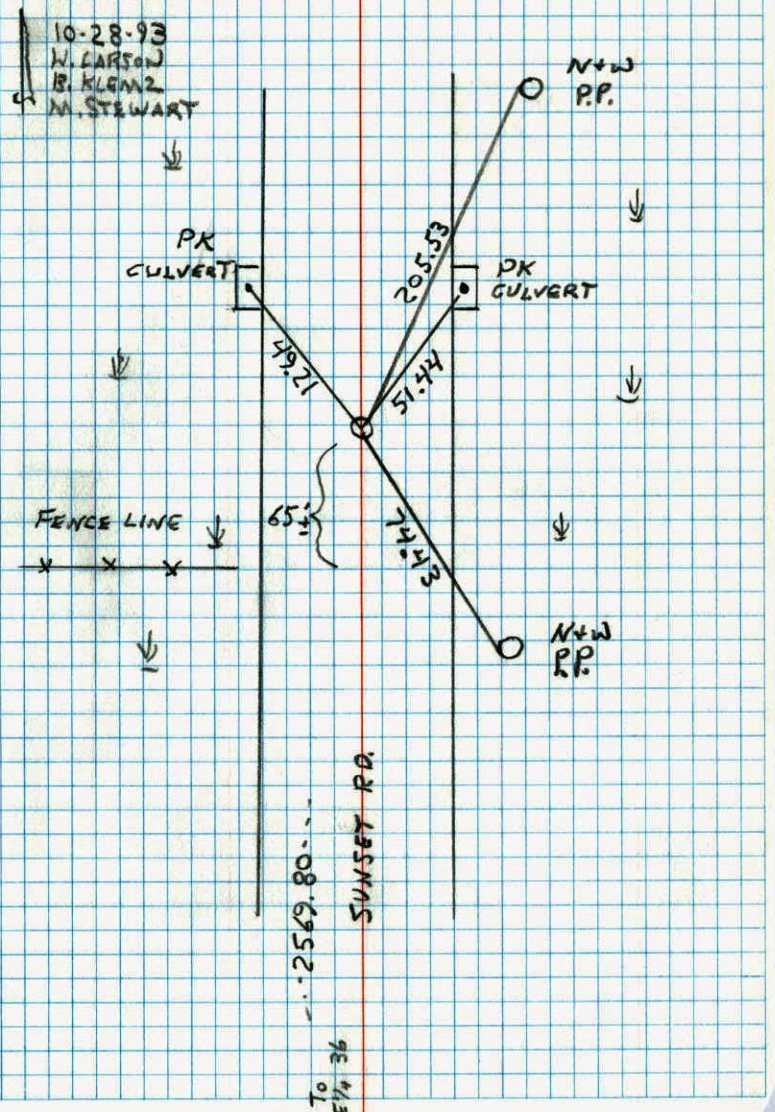

NO. 448
TELEDYNE

CONSTRUCTION TIE

SE COR. SECTION 25 T34 R23

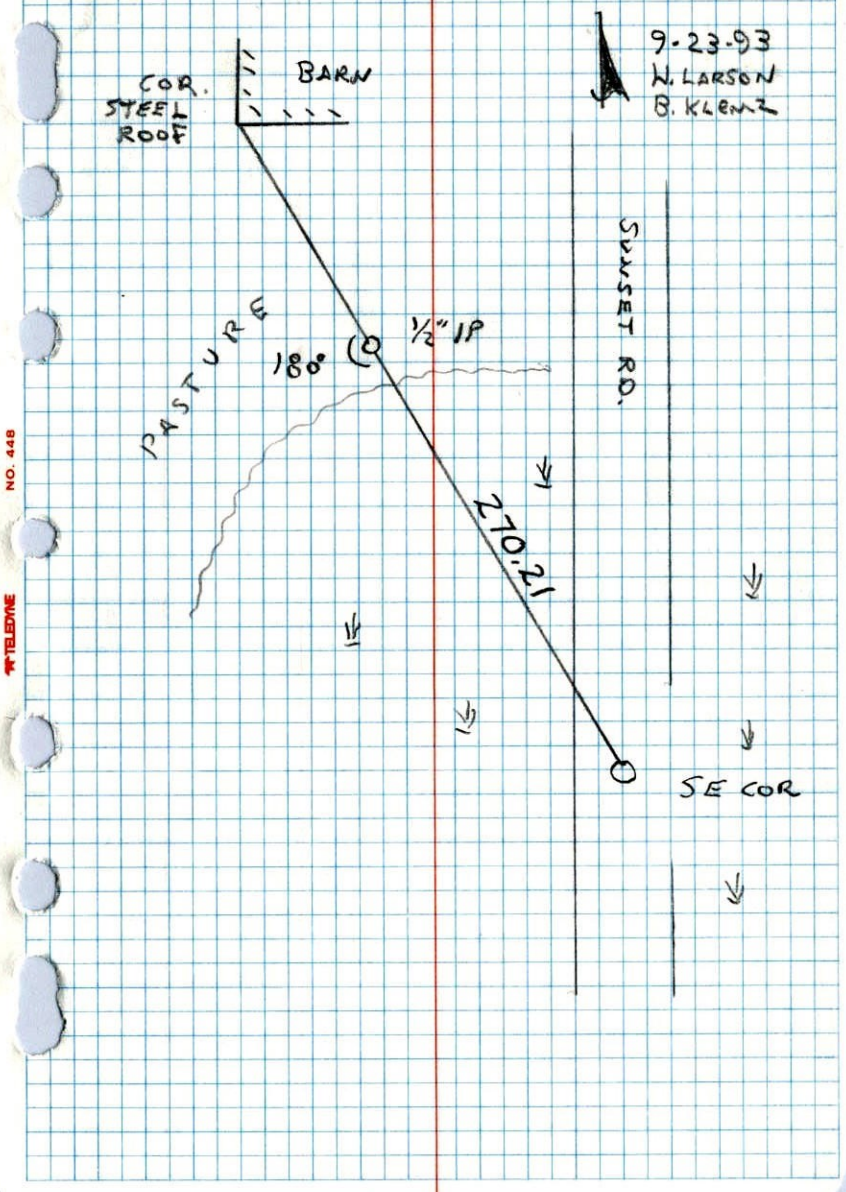

NO. 448 TELEDYNE

72

S.E. Cor. Sec 25 - T34 - R23

Set Cast Iron Monument In Place Of 1" Iron Pipe That Was Set By N.C. Hoium. C.I. Down .5'± Re-survey distance checks Hoiums distance to South by 0.08'.

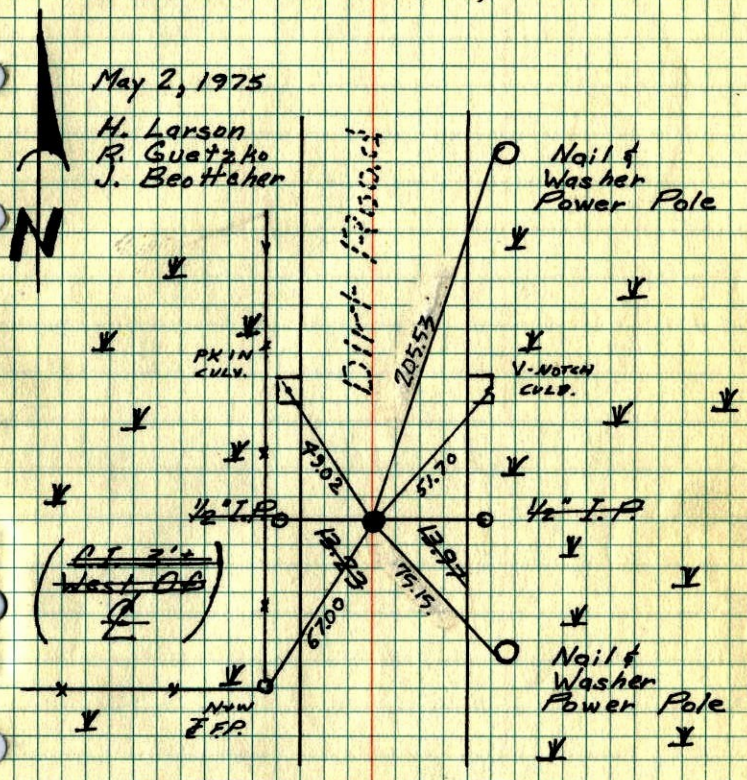

TIE CHECK
8-18-78
D. DAHL
M. KISROW
B. STEPHENS

TIE CHECK
6-2-82
P. ROSS
B. NICHOLAS

TEMPERATURE CORRECTED AND HORIZONTALLY TAPED MEASUREMENTS

ROLAND W. ANDERSON
COUNTY SURVEYOR
ANOKA COUNTY, MINNESOTA

4

S.E. Cor. Sec. 25, T. 34, R. 23

1" IRON PIPE
Mushroomed top,
Pipe leaning NNW
down 0.5' ±

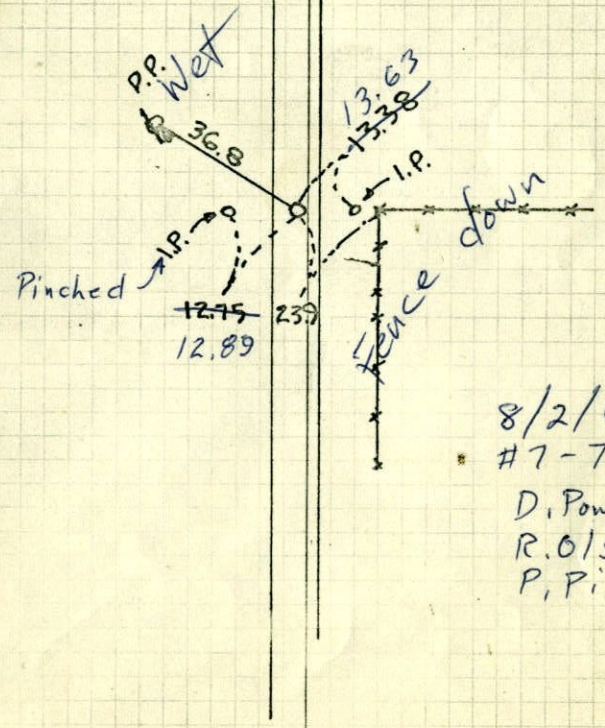

8/2/68
#7 - 75°
D. Powell
R. Olson
P. Pieh

N.C. HOIUM

9-53

T.34 R.23	T.34 R.22
25	30
36	31

SE Cor Sec. 25 T. 34 R. 23
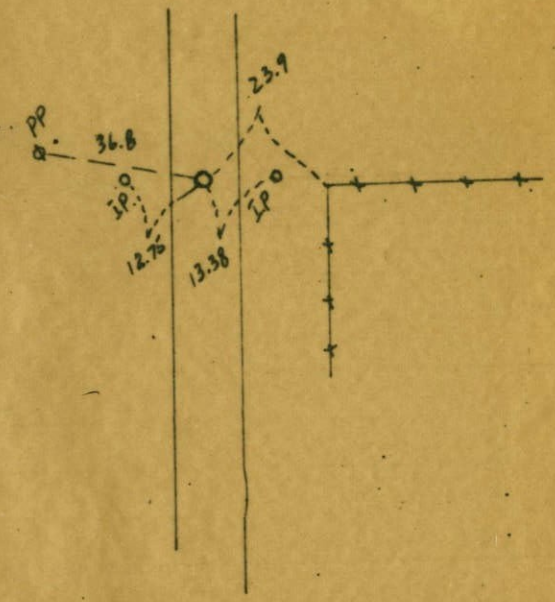
1" I.P.