

CERTIFICATE OF LOCATION OF GOVERNMENT CORNER

County of Anoka


State of Minnesota

NORTH QTR. Corner of Sec. 36 Township 34 Range 23


I hereby certify that on the 25TH day of OCT., 19 73, I found the described corner which was evidenced by 6' SWAMP IRON

and I further certify that to perpetuate the location of said corner, I did, at the exact location thereof, place a permanent marker consisting of RED & WHITE IRON PIPE WITH SIGN & CAP.
UP 2.5'±

which reference or witness monuments are located in the manner following:

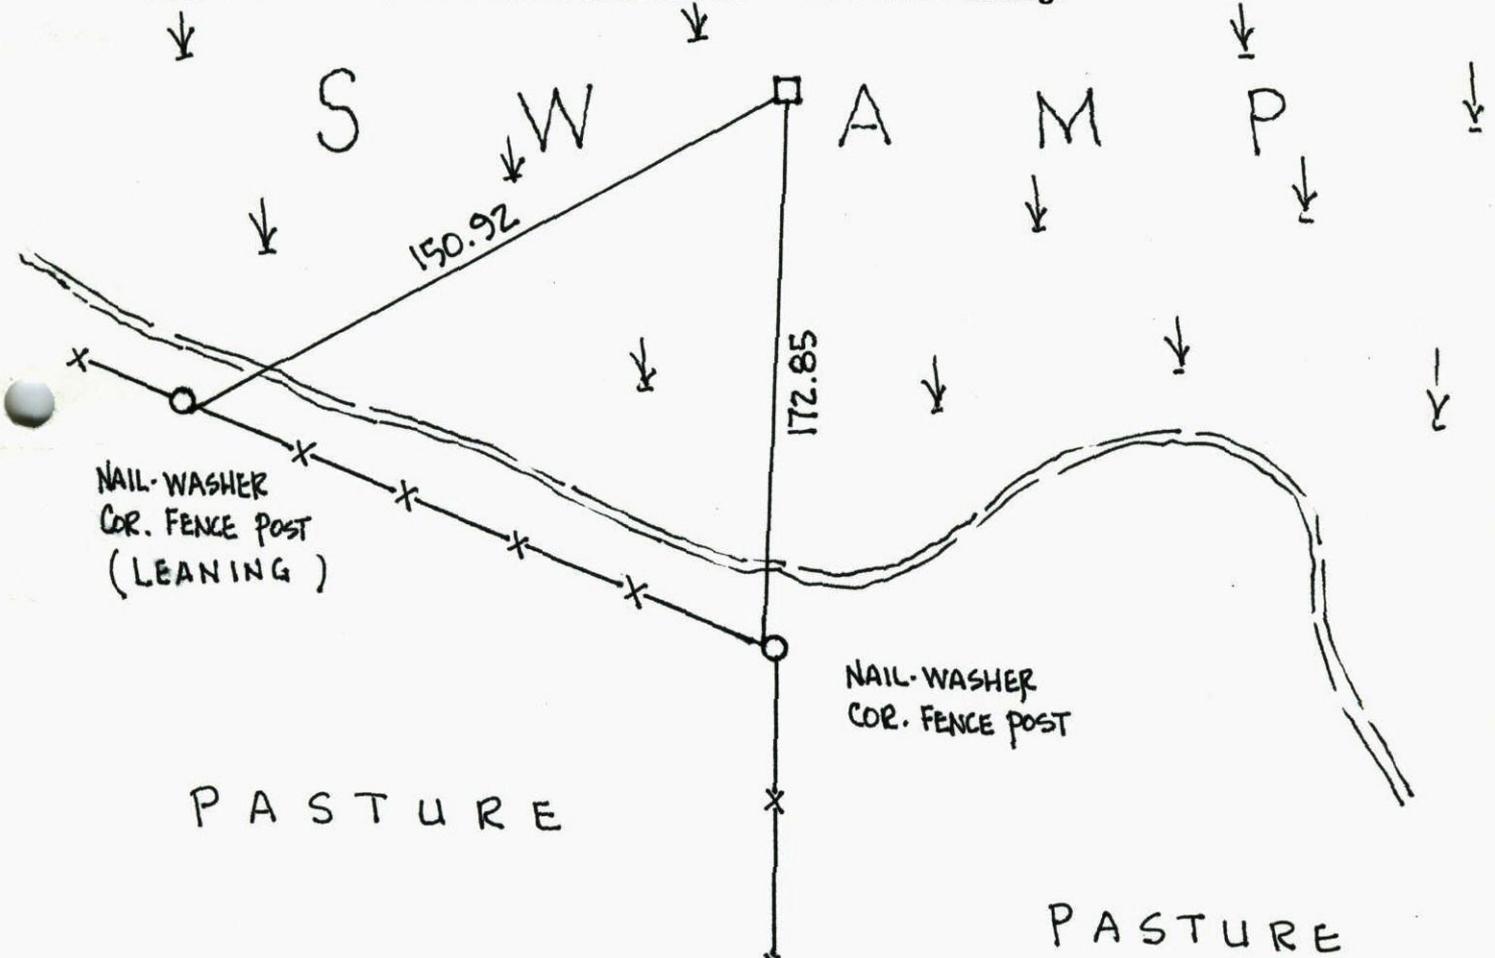


Revised date	Revised date	Revised date
6-9-82		
11-26-97		

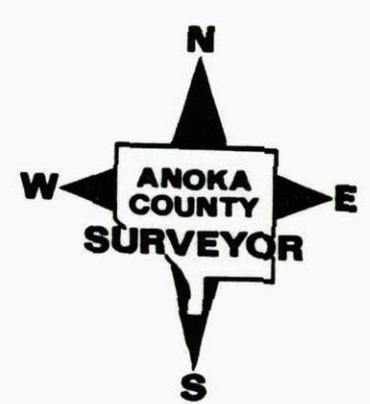

N $\frac{1}{4}$ CORNER SECTION 36 T34 R23

REPLACED 6' SWAMP IRON WITH
RED AND WHITE IRON PIPE WITH SIGN
AND CAP. UP 2.5'


11-26-97
W. LARSON
B. KLENZ
J. SIMMER

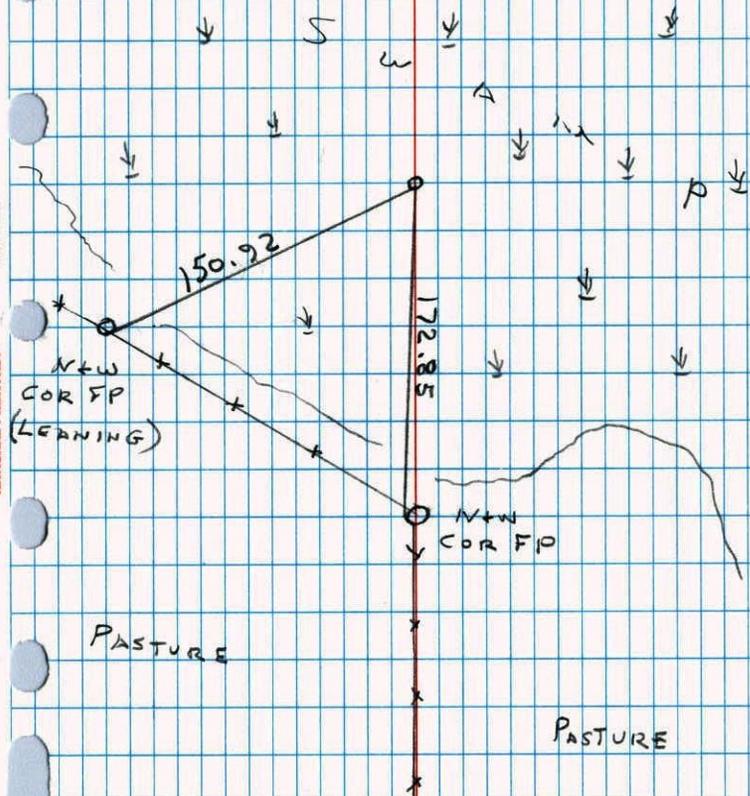

N $\frac{1}{4}$ CORNER SEC. 36, T. 34, R. 23

SET N $\frac{1}{4}$ CORNER OCT. 25, 1973

SET 6' SWAMP IRON AS N $\frac{1}{4}$ CORNER

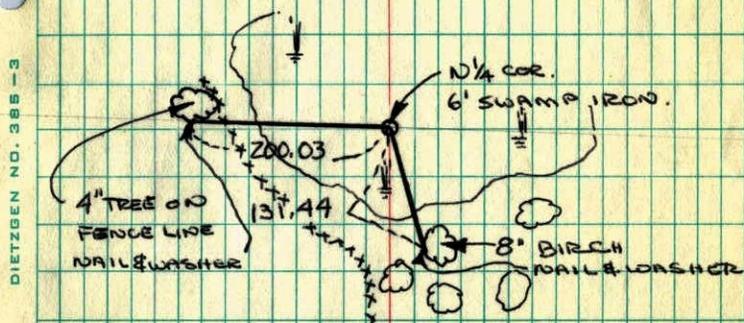

TIE CHECK
6-982
PROSS
J. BEIER

LeROY H. WINNER & ASSOC., INC.
LAND SURVEYOR'S
8398 CENTER DRIVE
MINNEAPOLIS, MINN. 55432
PHONE 784-0210