CERTIFICATE OF LOCATION OF GOVERNMENT CORNER

County of Anoka State of Minnesota

Witness Corner of Sec. 36 Township 34 Range 23
(on north line of NW 1/4)

On the 5th day of October, 1978, the described corner was evidenced by area resurvey

and to perpetuate the location of said corner, at the exact location thereof, a permanent marker was placed consisting of a cast iron monument with a sign and post on the north side
~~(NEEDS SIGN)~~ SIGN ADDED

AND on the ___ day of _____, ____, said permanent marker was _____

Updated reference ties are as shown below.

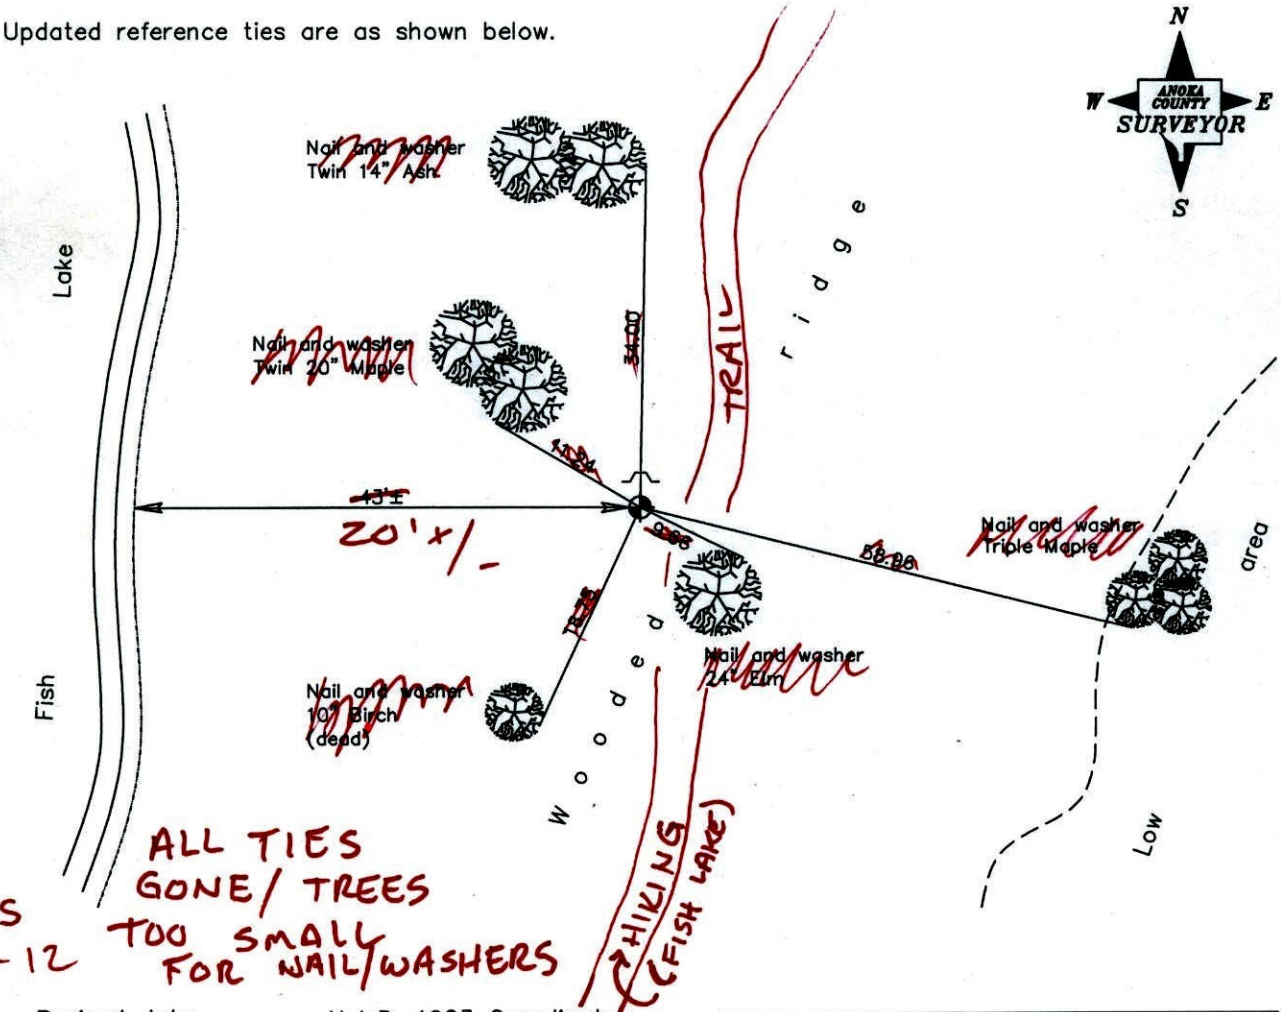

ALL TIES GONE/ TREES TOO SMALL FOR NAIL/WASHERS

BK-SS
4-24-12
VRS

Revised date
6/10/82
8/08/86
8/26/92

N.A.D. 1983 Coordinates (1996 Adjustment)

County Project Coordinates	
Northing	232855.4866
Easting	527214.8168
Date	4/07/03

I hereby certify that this United States public land survey monument record is correct and complete to the best of my knowledge and belief.

_____ Date _____

_____, Anoka County Surveyor

Minnesota License Number _____

VRS 3D = 0.15 N = 232855.5589 E = 527214.7571

Page No. 74

CERTIFICATE OF LOCATION OF GOVERNMENT CORNER

County of Anoka *State of Minnesota*

WITNESS COR. ON N. LINE OF
NORTHWEST QTR. Corner of Sec. 36 Township 34 Range 23

I hereby certify that on the 5 *day of* OCT. , 19 78, *I found the described corner which was evidenced by* AREA RESURVEY

and I further certify that to perpetuate the location of said corner, I did, at the exact location thereof, place a permanent marker consisting of CAST IRON MON.

which reference or witness monuments are located in the manner following:

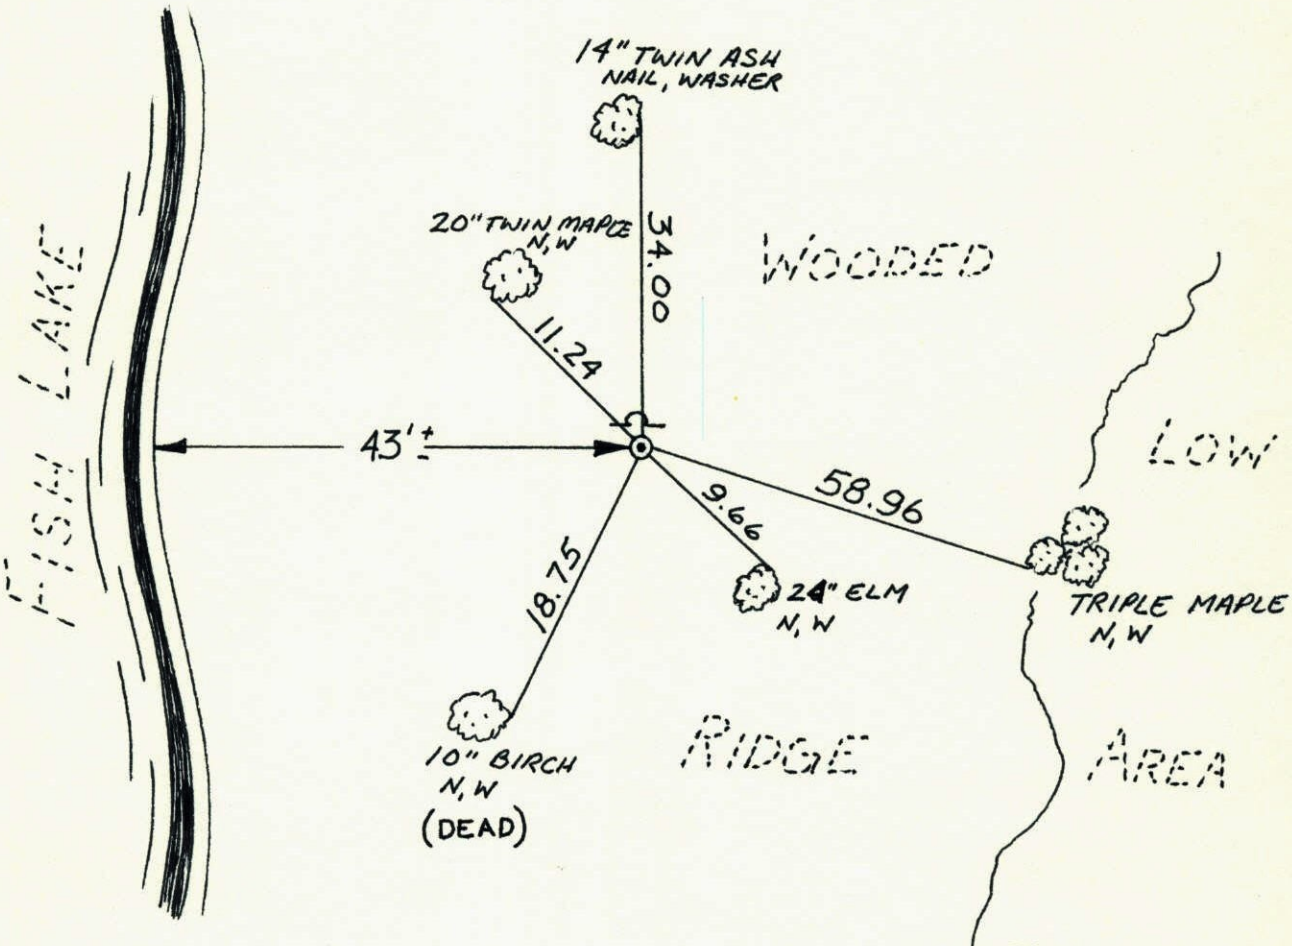

Revised date	Revised date	Revised date
6-10-82		
8-8-86		
8-26-92		

N
W ANOKA COUNTY SURVEYOR E
S

WITNESS CORNER ON NORTH LINE OF NW 1/4 SECTION 36, T34, R23

SET CAST IRON MONUMENT IN PLACE OF 1 1/4" IRON ROD FOUND TO BE WITNESS CORNER FROM AREA RESURVEY. CAST IRON FLUSH WITH SIGN POST ON NORTH SIDE.

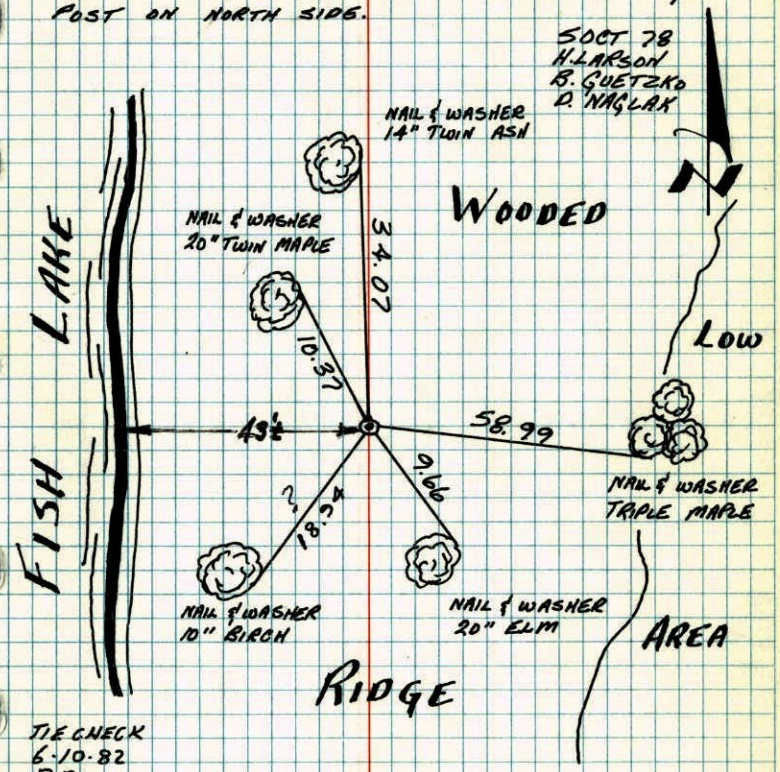

TIE CHECK
6-10-82
P. ROSS
J. BEIER

TEMPERATURE CORRECTED AND HORIZONTALLY TAPED MEASUREMENTS

ROLAND W. ANDERSON
COUNTY SURVEYOR
ANOKA COUNTY, MINNESOTA

W.C. on North Line of NW 1/4
Section 36 T34 R23
Set cast iron monument in place of 1 1/4" iron rod found to be W.C. From area resurvey. C.I. flush with sign post on N. side

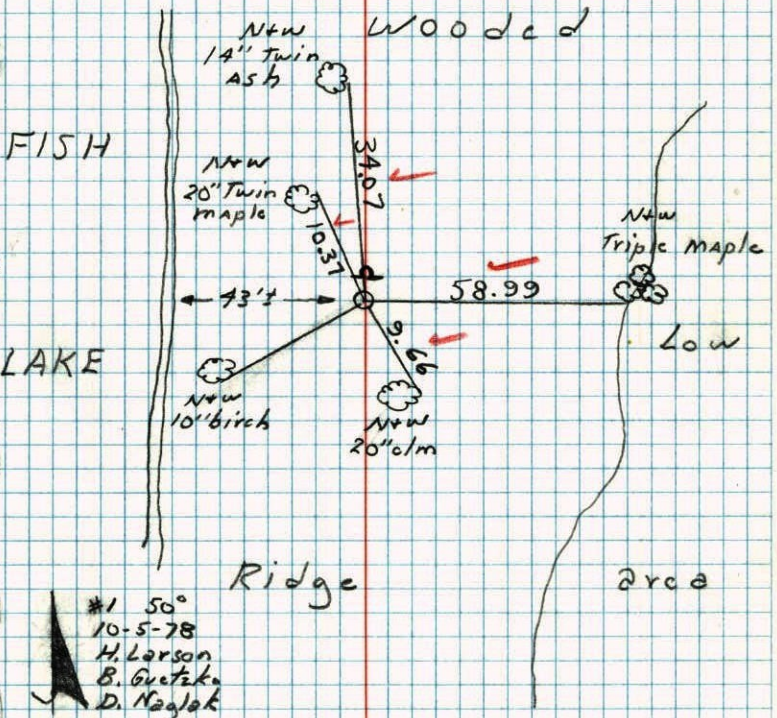

#1 50°
10-5-78
H. Larson
B. Guetzko
D. Naglak