

CERTIFICATE OF LOCATION OF GOVERNMENT CORNER

County of Anoka


State of Minnesota

WITNESS Corner of Sec. 35 Township 34 Range 23
ON NORTH LINE


I hereby certify that on the 9th day of DEC., 1976, I found the described corner which was evidenced by 1" IRON PIPE

and I further certify that to perpetuate the location of said corner, I did, at the exact location thereof, place a permanent marker consisting of CAST IRON MONUMENT SIGN AND POST ON NORTH SIDE

which reference or witness monuments are located in the manner following:

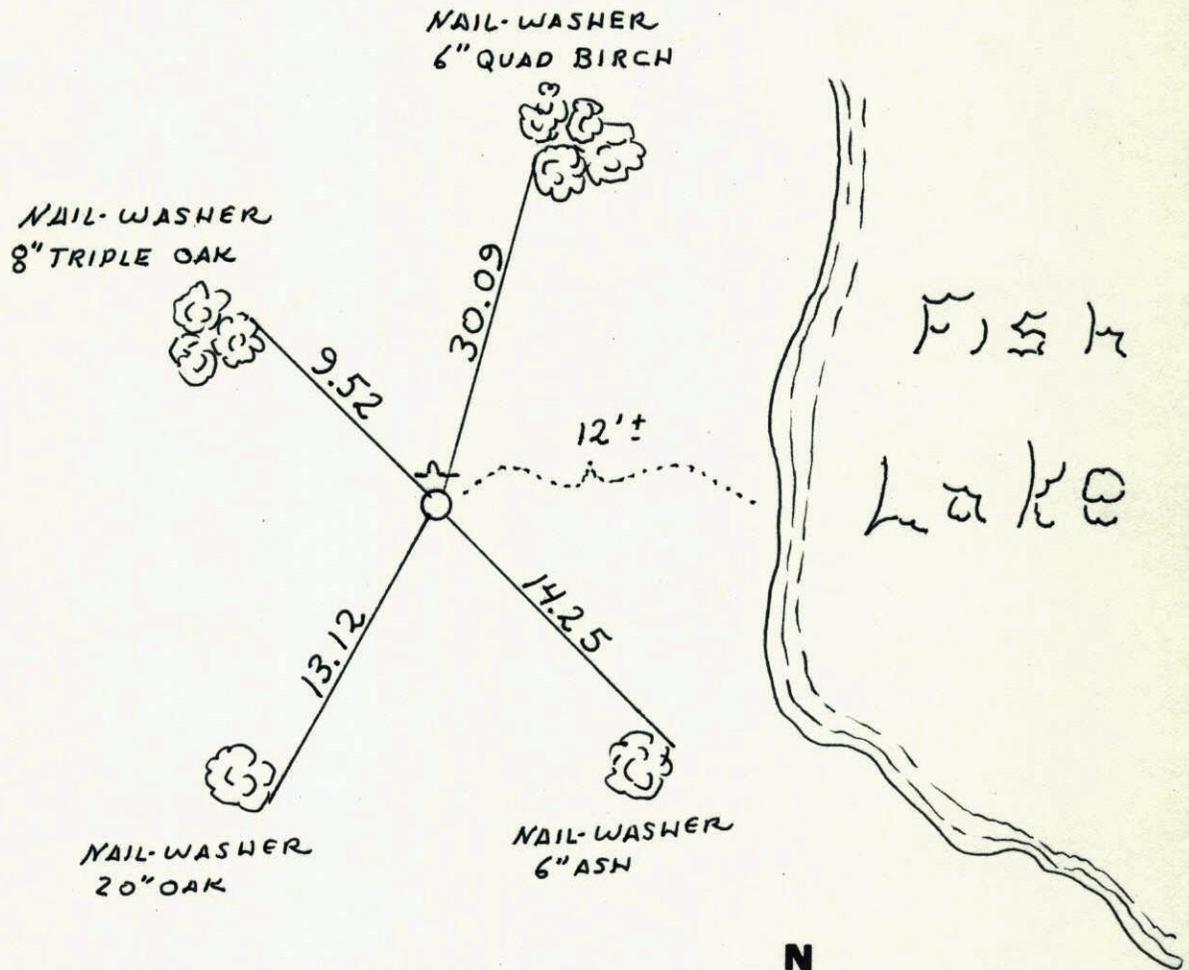


| Revised date | Revised date | Revised date |
|--------------|--------------|--------------|
| 8-8-86 | | |
| 8-21-92 | | |
| | | |
| | | |
| | | |
| | | |

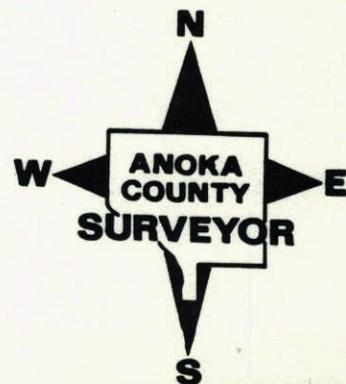

W.C. ON NORTH LINE OF NW 1/4 SEC 35-
T34-R23

FOUND 1" IRON PIPE SET IN 1908. REPLACED
WITH CAST IRON MONUMENT. CAST IRON
FLUSH WITH SIGN AND POST ON NORTH SIDE.

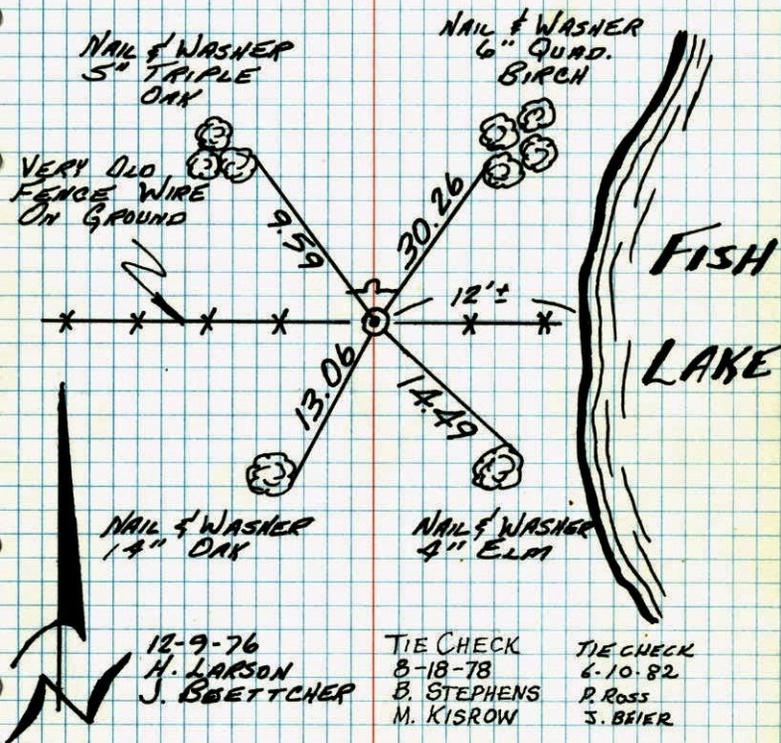

TEMPERATURE CORRECTED
AND HORIZONTALLY
TAPED MEASUREMENTS

ROLAND W. ANDERSON
COUNTY SURVEYOR
ANOKA COUNTY, MINNESOTA

W.C. on North Line of NW 1/4 Sec 35, T34R23

Found 1" iron pipe set in 1908 replaced
with cast iron monument. C.I. Flush with
sign + post on N. side.

10" #7
12-9-76
H. Larson
J. Boellcher

