

CERTIFICATE OF LOCATION OF GOVERNMENT CORNER

County of Anoka

State of Minnesota



North 1/4 Corner of Sec. 33 Township 34 Range 23

On the 17th day of September, 1976, the described corner was evidenced by area resurvey

and to perpetuate the location of said corner, at the exact location thereof, a permanent marker was placed consisting of a red and white iron pipe w/ SIGN ATTACHED FACING NORTH (UP 3'±)

AND on the ___ day of _____, _____, said permanent marker was _____

Updated reference ties are as shown below.

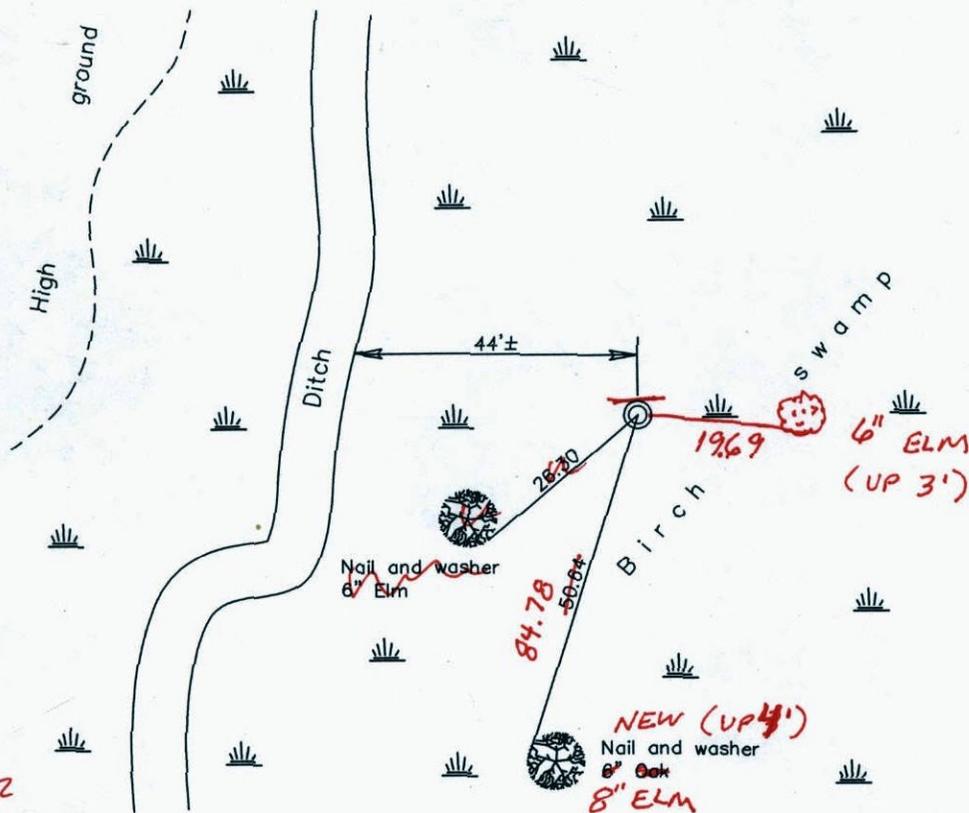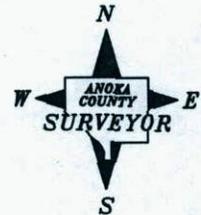

29
10-~~28~~-12
BK-55
TAPED

Revised date
6/14/93

N.A.D. 1983 Coordinates (1996 Adjustment)	
County Project Coordinates	
Northing	<u>232867.4162</u>
Easting	<u>513479.6834</u>
Date	<u>5/15/02</u>

I hereby certify that this United States public land survey monument record is correct and complete to the best of my knowledge and belief.

Date _____
_____, Anoka County Surveyor
Minnesota License Number _____

CERTIFICATE OF LOCATION OF GOVERNMENT CORNER

County of Anoka


State of Minnesota

NORTH ONE QUARTER Corner of Sec. 33 Township 34 Range 23


I hereby certify that on the 17 day of Sept., 19 76, I found the described corner which was evidenced by AREA RESURVEY

and I further certify that to perpetuate the location of said corner, I did, at the exact location thereof, place a permanent marker consisting of RED AND WHITE IRON PIPE

which reference or witness monuments are located in the manner following:

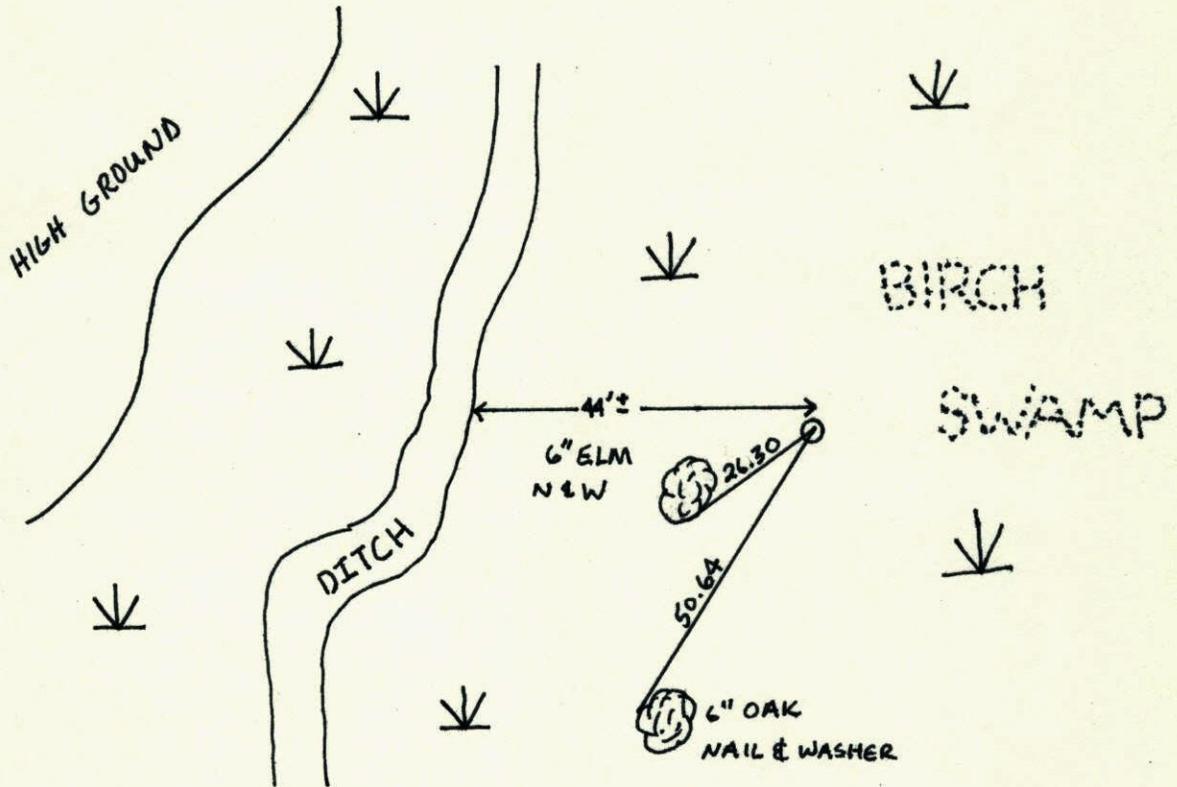


Revised date	Revised date	Revised date
6-14-93		

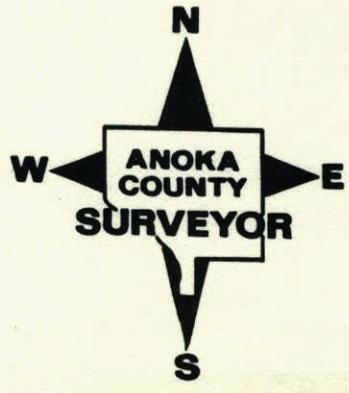

NORTH QUARTER SEC 33 T34 R23

RETIE RED & WHITE IRON PIPE.

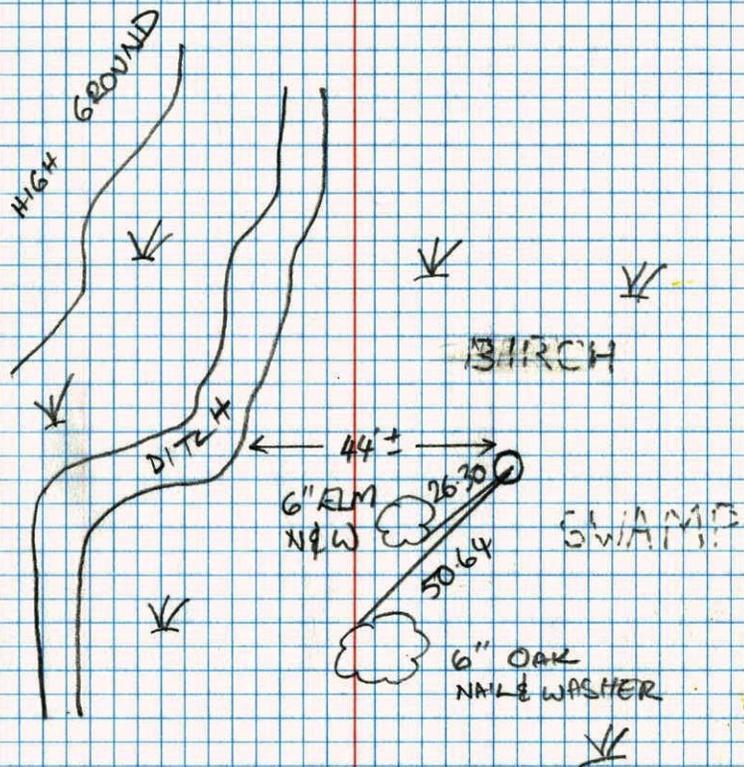


B. KLEMZ
M. STEWART

6-14-93

N. 1/4 COR. SEC. 33 T34 R23

SET RED AND WHITE IRON PIPE FROM AREA RESURVEY. IRON PIPE UP 3'± WITH SIGN.

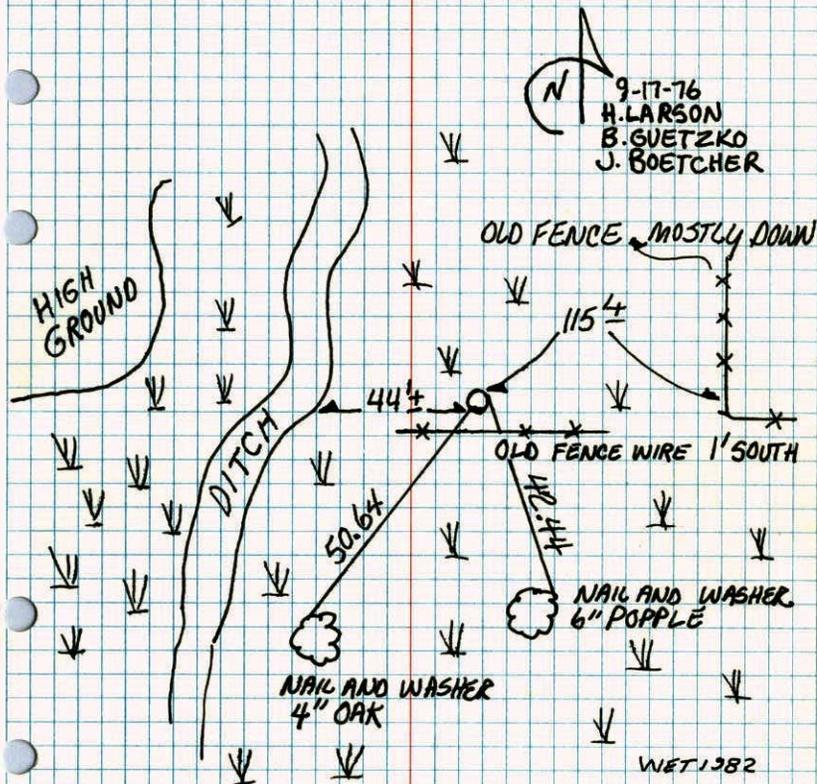

9-17-76
H. LARSON
B. SVETZKO
J. BOETCHER

TEMPERATURE CORRECTED
AND HORIZONTALLY
TAPED MEASUREMENTS

ROLAND W. ANDERSON
COUNTY SURVEYOR
ANOKA COUNTY, MINNESOTA.

N¹/₄ Cor. Sec. 33 T34 R23

set red + white iron pipe from area
resurvey. I.P. up 3'± with sign

*7 75°
9-17-76
H. Larson
B. Gutzek
J. Baettcher

