

# CERTIFICATE OF LOCATION OF GOVERNMENT CORNER

County of Anoka

State of Minnesota


Northwest Corner of Sec. 27 Township 34 Range 22

On the \_\_\_ day of July, 1960, the described corner was evidenced by an Isanti County cast iron monument

and to perpetuate the location of said corner, at the exact location thereof, a permanent marker was placed consisting of a cast iron monument with a sign and post on the north side

AND on the \_\_\_ day of \_\_\_\_\_, \_\_\_\_\_, said permanent marker was \_\_\_\_\_

Updated reference ties are as shown below.

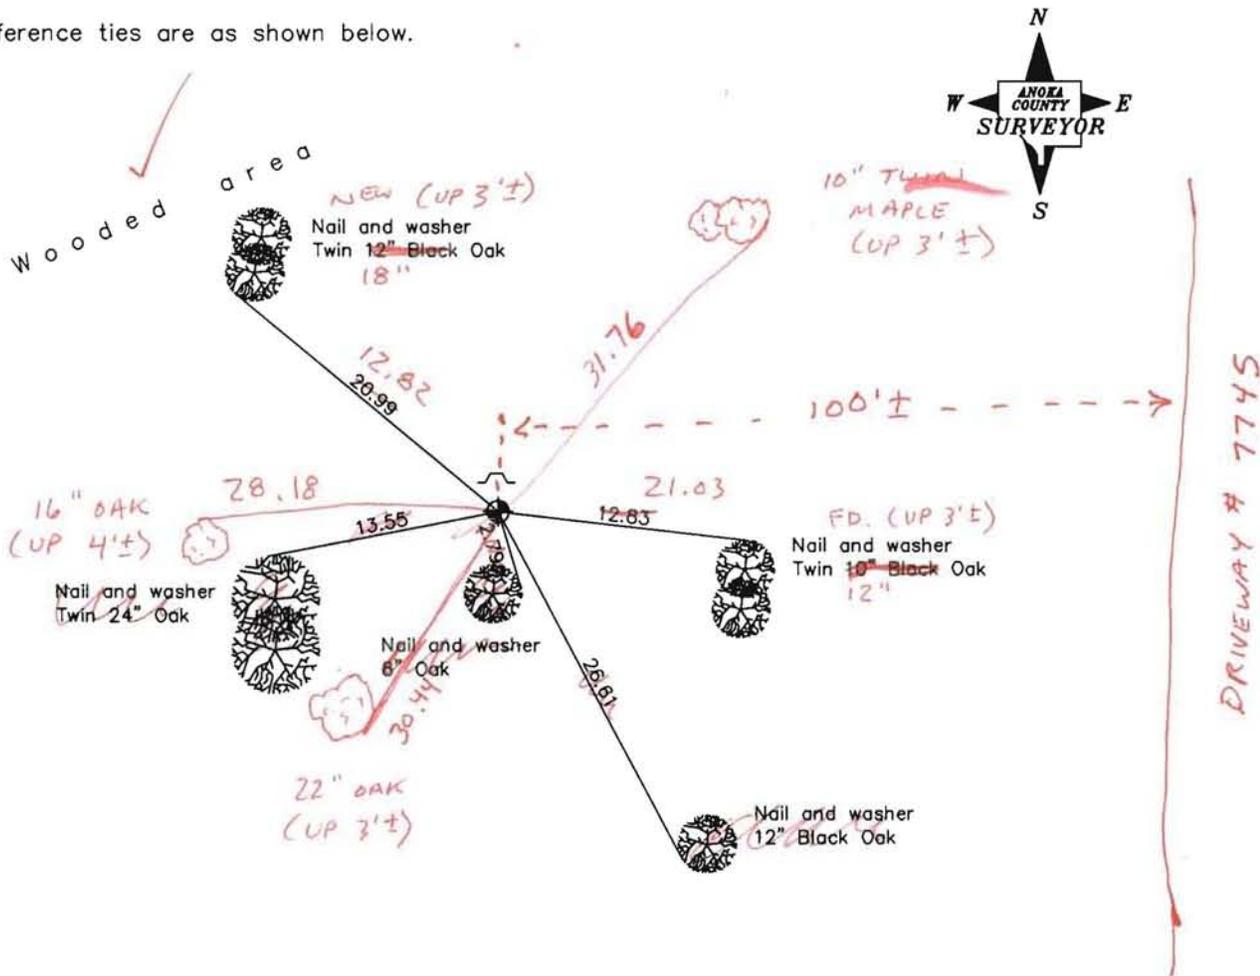

Revised date
8/11/86
12/29/92
2-3-14
BK-55
TAPED

N.A.D. 1983 Coordinates (1996 Adjustment)
County Project Coordinates
Northing <u>237747.2745</u>
Easting <u>547628.0739</u>
Date <u>1/08/04</u>

I hereby certify that this United States public land survey monument record is correct and complete to the best of my knowledge and belief.

\_\_\_\_\_, Anoka County Surveyor

Minnesota License Number \_\_\_\_\_

# CERTIFICATE OF LOCATION OF GOVERNMENT CORNER

County of Anoka

State of Minnesota


NORTHWEST Corner of Sec. 27 Township 34 Range 22

I hereby certify that on the        day of JULY, 1960, I found the described corner which was evidenced by I SANTI CO. CAST IRON MON.


and I further certify that to perpetuate the location of said corner, I did, at the exact location thereof, place a permanent marker consisting of CAST IRON MON. SIGN POST NORTH SIDE

which reference or witness monuments are located in the manner following:

WOODED AREA

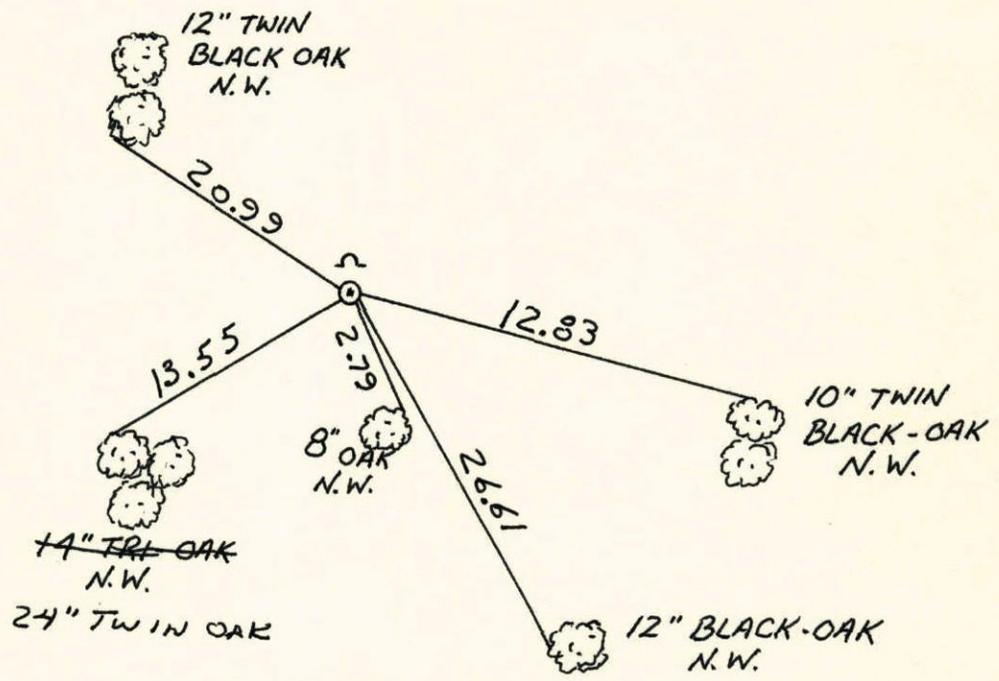

Revised date	Revised date	Revised date
8-11-86		
12-29-92		

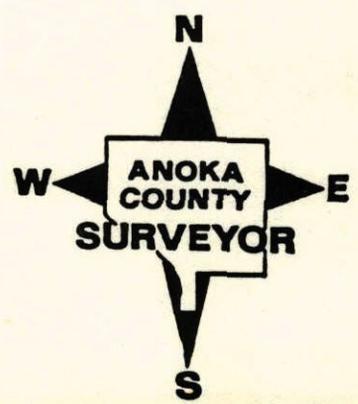

# CERTIFICATE OF LOCATION OF GOVERNMENT CORNER


~~NORTHEAST~~ <sup>NW</sup> Corner of Section 28<sup>27</sup>, Township 34 N., Range 22 W., 4th P.M.

STATE OF MINNESOTA, County of ANOKA

At the corner location shown on the sketch:

- On 6-3-88 found an ISANTI COUNTY CAST IRON MONUMENT  
DATE
- left monument as found,  lowered monument,  removed monument (explain)
- On \_\_\_\_\_ placed a \_\_\_\_\_  
DATE

## SKETCH OF REFERENCE TIES

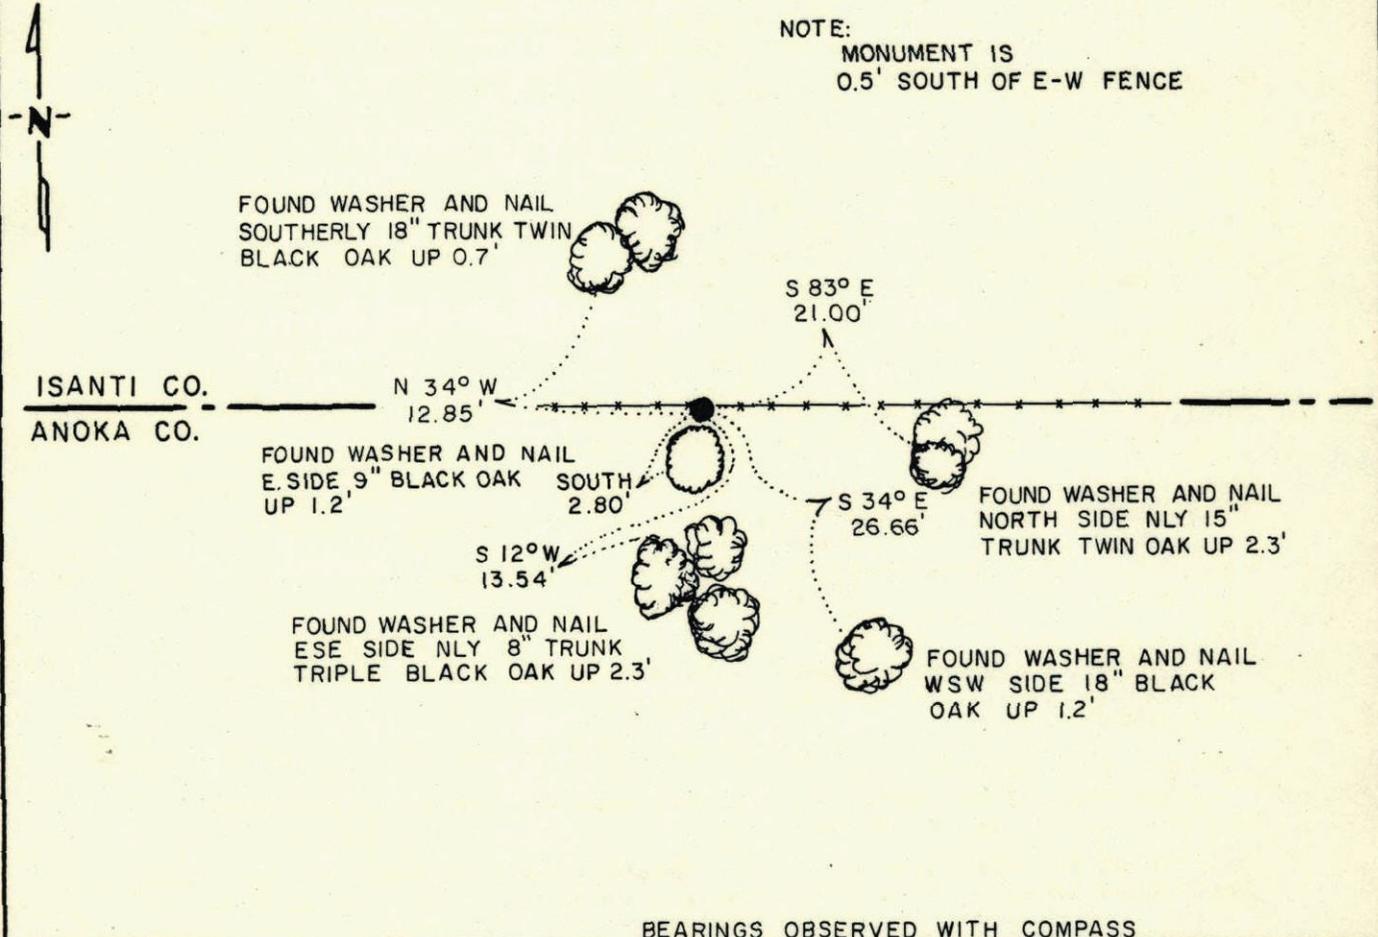

NOTE:  
MONUMENT IS  
0.5' SOUTH OF E-W FENCE

ISANTI CO.  
ANOKA CO.

BEARINGS OBSERVED WITH COMPASS

Statement of evidence relative to this corner location is on back of page.

J.A.G. 6/24/88  
G-1121

I hereby certify that this document and the data contained herein was prepared by me or under my direct supervision.

Bruce W. Shupard 6-30-88  
SIGNATURE DATE

Registration No. 17003

Land Surveyor,  Professional Engineer  
 County Surveyor,  County Engineer

OFFICE OF THE COUNTY RECORDER  
County of \_\_\_\_\_

I hereby certify that this document was filed in the Co. Recorders office at \_\_\_\_\_ .M. on the \_\_\_\_\_ day of \_\_\_\_\_ A.D., 19 \_\_\_\_\_

County Recorder \_\_\_\_\_  
By \_\_\_\_\_, Deputy

DOCUMENT NO. \_\_\_\_\_

Northeast Corner of Section 28, Township 34 North, Range 22 West

The DNR Bureau of Engineering contacted the following for survey information:

Secretary of State's Office  
Isanti County Recorder's Office  
Isanti County Surveyor - Don E. Hansen, RLS #9260  
Hult and Associates, Inc., of Forest Lake  
Kurth Surveying, Inc., of Columbia Heights  
Dale B. Anderson, RLS #16091  
Anoka County Surveyor's Office

- 1854 U.S. General Land Office notes obtained from the Secretary of State's Office show that a wood post was set to mark the corner. No bearing trees were taken to corner.
- 1911 Surveyor's Record Book B, on page 30, obtained from the County Recorder's Office contains a survey by A. W. Holm. Survey states that corner was put in by memory of Mr. Shorack. A description of what was set to mark corner is not given. The corner is shown:  
3039.96 feet from meander corner number 19  
5290.56 feet from the northeast corner of Section 21
- 1960 A tie sheet for corner obtained from the Anoka County Surveyor's Office shows that an Isanti County cast iron monument was set in place of an iron pipe which was set in the location of a found old rotten post (testimony of Eugene Boettcher said that this post was set for the corner when he was a boy). The following ties are shown to corner:  
0.5 of a foot south of an east-west fence  
nail and washer in 10" twin Black Oak, S. 85° E., 20.99 feet  
nail and washer in 12" Black Oak, S. 15° E., 26.64 feet  
nail and washer in 8" Oak, south, 2.80 feet  
nail and washer in triple 14" Black Oak, S. 5° W., 13.59 feet  
nail and washer in 12" twin Black Oak, N. 15° W., 12.86 feet  
The above ties were checked in 1978 and 1982.
- 1969 A section subdivision of Section 28 from the records of the DNR Bureau of Engineering shows that corner is reported to be in place. A description of a monument is not given. The corner is shown:  
2606.17 feet from the east quarter corner of Section 28  
570.57 feet from meander corner number 18
- 1972 The plat of SHERWOOD NORTH by Don C. Hult, RLS #6617, obtained from the Anoka County Surveyor's Office shows a cast iron monument in place at corner. The corner is shown:  
2606.14 feet from the east quarter corner of Section 28  
570.57 feet easterly of an in-place iron pipe on the north line of Section 28
- 1978 August, a worksheet obtained from the Anoka County Surveyor's Office shows a cast iron monument at corner but does not indicate if found or set. The corner is shown:  
2606.04 feet (2640.00' GLO distance) from the east quarter corner of Section 28  
570.13 feet easterly of a 1/2 inch iron pipe found on the north line of Section 28
- No Date A section subdivision of Section 22 obtained from Kurth Surveying, Inc., shows corner per Anoka County Surveyor's information. The corner is shown:  
5297.78 feet from the northeast corner of Section 21  
2657.15 feet from the north quarter corner of Section 27
- 1986 August, DNR Bureau of Engineering found an Isanti County cast iron monument at corner. Searched for and found the 1960 ties as shown on sketch of reference ties. The cast iron monument was found to be:  
570.28 feet easterly of a found 7/8 inch diameter iron pipe  
5297.64 feet from the northeast corner of Section 21

Analysis of the above information led the DNR Bureau of Engineering to conclude that the found cast iron monument marks the obliterated location of the corner.

# CERTIFICATE OF LOCATION OF GOVERNMENT CORNER

County of Anoka


State of Minnesota

Northwest Corner of Sec. 27 Township 34 Range 22

I hereby certify that on the      day of July, 1960, I found the described corner which was evidenced by Isanti County cast iron monument

and I further certify that to perpetuate the location of said corner, I did, at the exact location thereof, place a permanent marker consisting of     

which reference or witness monuments are located in the manner following:

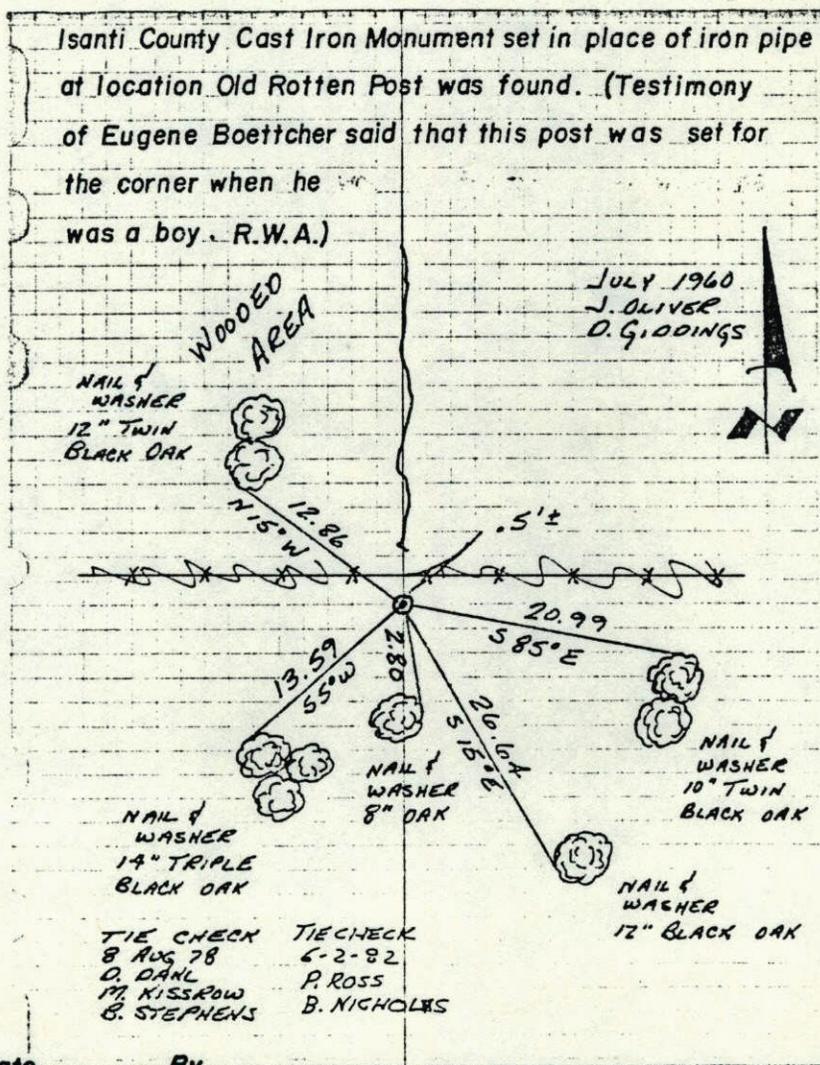

Revised date

By

6-21-67
7-14-71
8-1-75
8-8-78
8-11-86

D. Potter
R. Brien
D. Dahl
D. Dahl
D. Ross

Minnesota State Plane Coordinates  
South Zone

Y \_\_\_\_\_ X \_\_\_\_\_


County Surveyor

Date

Registered Land Surveyor No. \_\_\_\_\_

# N.W. Corner Section 27-T34-R22

Isanti County Cast Iron Monument set in place of iron pipe at location Old Rotten Post was found. (Testimony of Eugene Boettcher said that this post was set for the corner when he was a boy. R.W.A.)

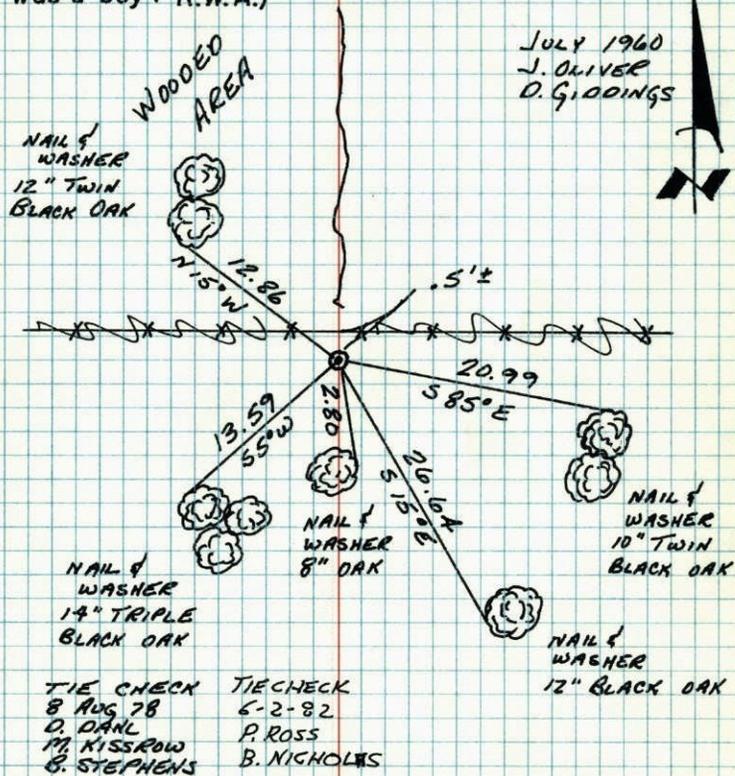

TEMPERATURE CORRECTED  
AND HORIZONTALLY  
TAPED MEASUREMENTS

ROLAND W. ANDERSON  
COUNTY SURVEYOR  
ANOKA COUNTY, MINNESOTA


# NW Cor. Sec. 27-T34-R22

Found Old Rotted Post, set Iron Pipe until position can be checked. Testimony of Eugene Boettcher said that this post was set for the corner when he was a boy. R.W.A.

Found Isanti County Cast Iron Mon.

Tie Check July 19, 1971  
8-8-78 R. Brien  
D. Dahl J. Boettcher  
B. Stephens B. Olson  
M. Kisrow

TIE CHECK  
8-1-75  
D. DAHL  
B. SAANNERUD  
G. ADAMS

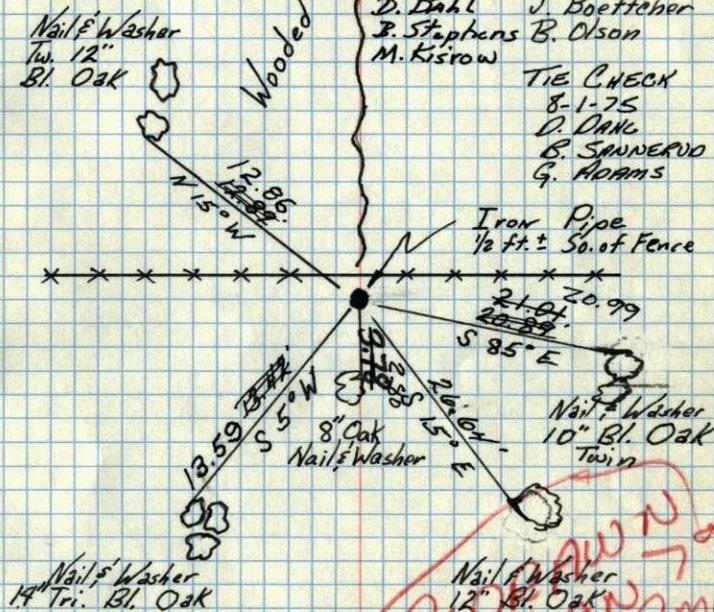

TEMPERATURE CORRECTED  
AND HORIZONTALLY  
TAPED MEASUREMENTS


Tie Check  
June 21, 1967  
D. Potter  
D. Powell

ROLAND W. ANDERSON  
COUNTY SURVEYOR  
ANOKA COUNTY, MINNESOTA

RED JARRING  
July, 1960  
Dick Giddings  
Assist.  
SEE NEW TIE BOOK

D  
NW Cor. Sec. 27-T34-R22

Found Old Rotted Post, set Iron Pipe until position can be checked  
Testimony of Eugene Boettcher said that this post was set for the corner when he was a boy.  
R.W.A.

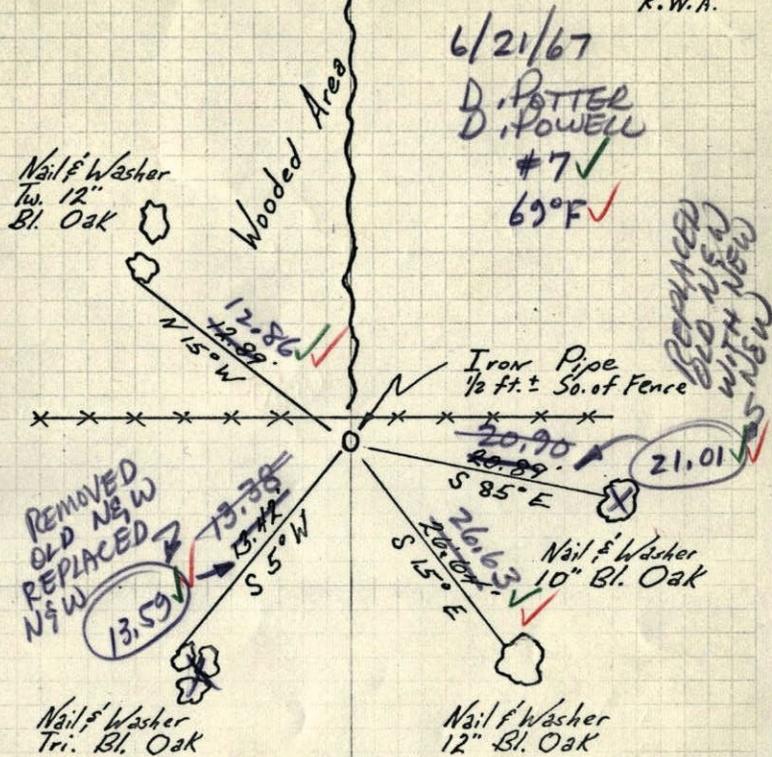


TEMPERATURE CORRECTED  
AND HORIZONTALLY  
TAPED MEASUREMENTS

July, 1960  
Dick Giddings  
Assist.

ROLAND W. ANDERSON  
COUNTY SURVEYOR  
ANOKA COUNTY, MINNESOTA

(?) N.W. Corn. Sec. 27 T. 34, R. 22

Found Old Rotted Post, set Iron Pipe  
Until position can be checked

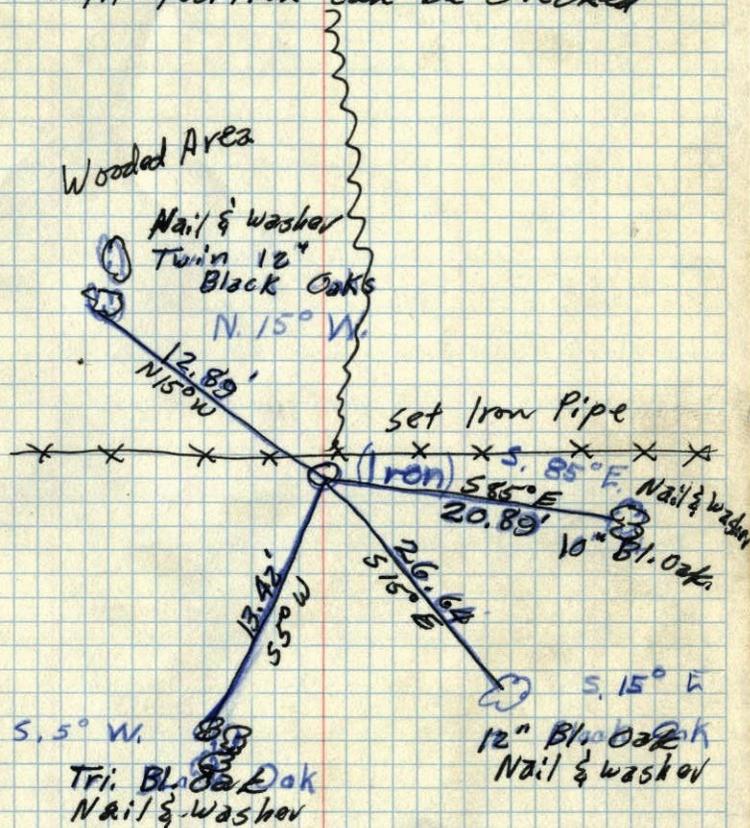

July 1960

Dick Giddings Assist.

9/6/60