

CERTIFICATE OF LOCATION OF GOVERNMENT CORNER

County of Anoka

State of Minnesota


Witness Corner of Sec. 32 Township 34 Range 23
 (to N 1/4 corner of section)

On the 31st day of May, 1960, the described corner was evidenced by a chisel mark

and to perpetuate the location of said corner, at the exact location thereof, a permanent marker was placed consisting of a 1/2" iron pipe set using ties 12-20-12 UNDER BIT.

AND on the ___ day of _____, _____, said permanent marker was _____

Updated reference ties are as shown below.

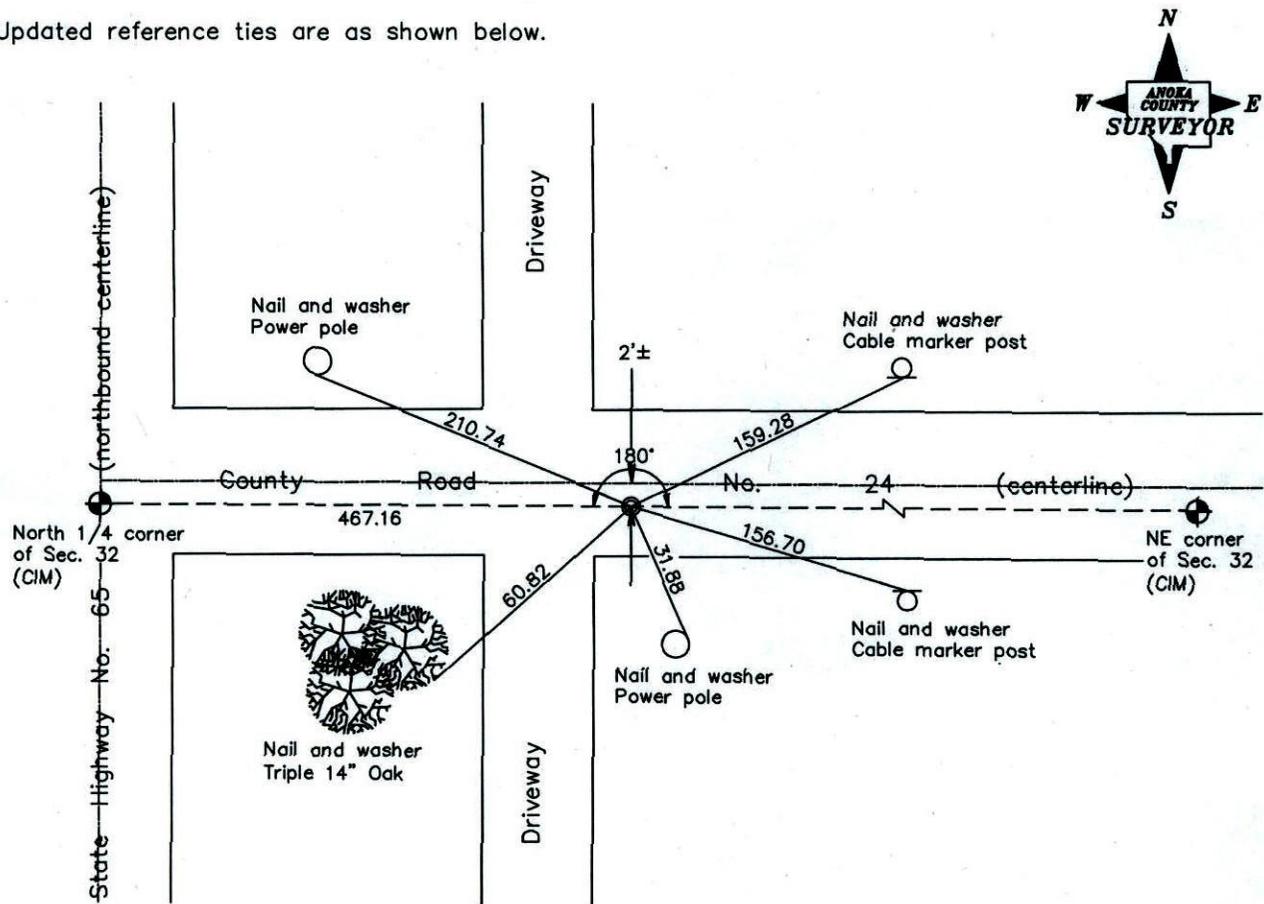

Revised date
8/03/92
3/24/97

N.A.D. 1983 Coordinates (1996 Adjustment)	
County Project Coordinates	
Northing	<u>232731.0974</u>
Easting	<u>508683.6557</u>
Date	<u>5/09/02</u>

I hereby certify that this United States public land survey monument record is correct and complete to the best of my knowledge and belief.

_____, Date _____
 _____, Anoka County Surveyor
 Minnesota License Number _____

CERTIFICATE OF LOCATION OF GOVERNMENT CORNER

County of Anoka

State of Minnesota


WITNESS TO

NORTH QTR. Corner of Sec. 32 Township 34 Range 23


I hereby certify that on the 31 day of MAY, 1960, I found the described corner which was evidenced by CHISEL MARK

and I further certify that to perpetuate the location of said corner, I did, at the exact location thereof, place a permanent marker consisting of SET 1/2" I.P. FROM TIES;
COR. 2' S. OF C.L.

which reference or witness monuments are located in the manner following:

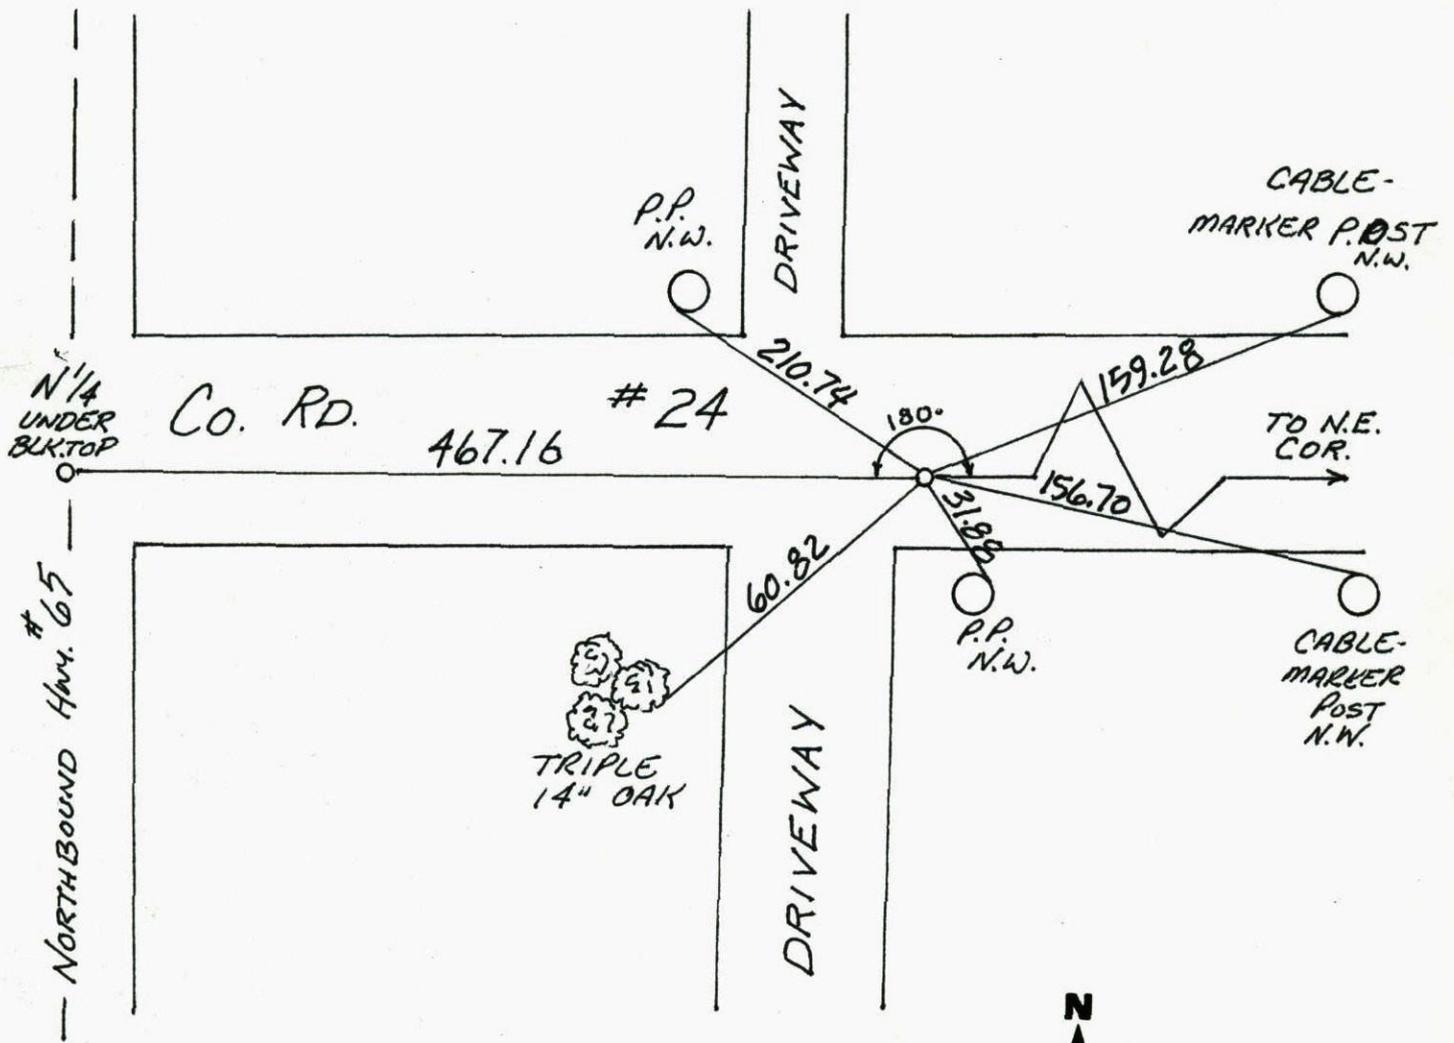

Revised date	Revised date	Revised date
8-3-92		
3-24-97		

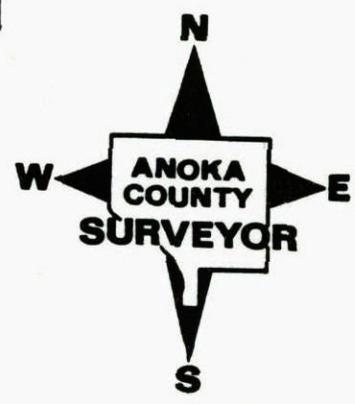


WC TO N1/4 SEC. 32 T34 R23

SET 1/2" IP FROM TIES COR 2' S. OF E

TELEPHONE NO. 448

3-24-97
H. LARSON
B. KLENZ
S. SINNER

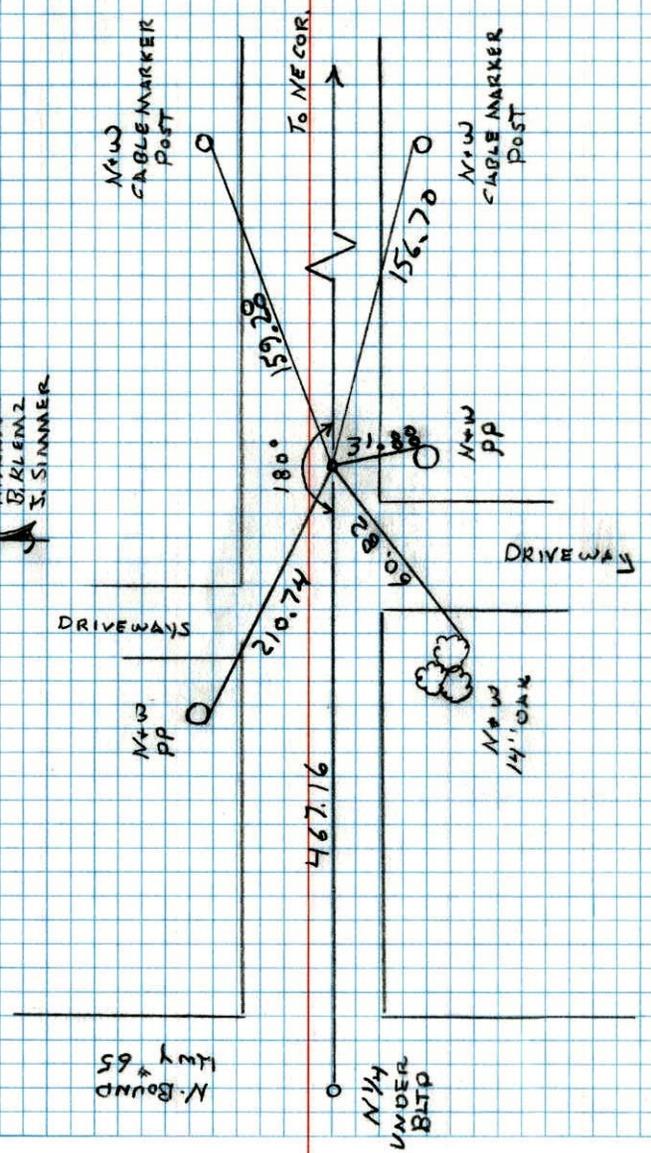

N. Bound Hwy # 65