

CERTIFICATE OF LOCATION OF GOVERNMENT CORNER

County of Anoka

State of Minnesota


Northwest Corner of Sec. 32 Township 34 Range 23

On the 5th day of February, 1963, the described corner was evidenced by a 1 1/4" iron pipe

and to perpetuate the location of said corner, at the exact location thereof, a permanent marker was placed consisting of a cast iron monument *COULD USE SIGN & POST*

AND on the 15th day of May, 2002, said permanent marker was found and the ties were updated

Updated reference ties are as shown below.

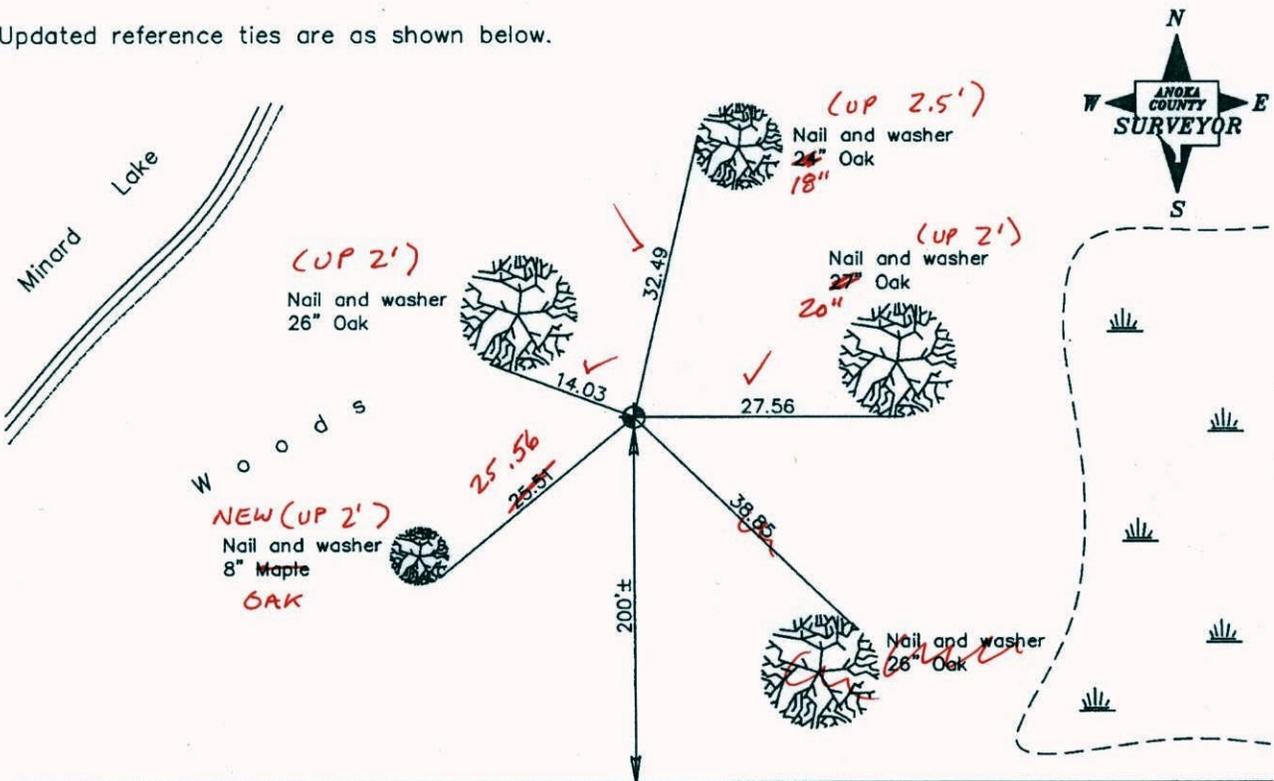

County Road No. 24

*12-20-12
BK-55
TAPED*

Revised date
8/05/92
8/13/97
5/15/02

N.A.D. 1983 Coordinates (1996 Adjustment)	
County Project Coordinates	
Northing	<u>232690.5398</u>
Easting	<u>505579.7204</u>
Date	<u>5/15/02</u>

I hereby certify that this United States public land survey monument record is correct and complete to the best of my knowledge and belief.

Larry D. Hoium Date 5/15/02
 Larry D. Hoium, Anoka County Surveyor
 Minnesota License Number 18165

CERTIFICATE OF LOCATION OF GOVERNMENT CORNER

County of Anoka


State of Minnesota

Northwest Corner of Sec. 32 Township 34 Range 23


I hereby certify that on the 5 day of Feb., 1963, I found the described corner which was evidenced by 1 1/4" IRON PIPE

and I further certify that to perpetuate the location of said corner, I did, at the exact location thereof, place a permanent marker consisting of CAST IRON

which reference or witness monuments are located in the manner following:

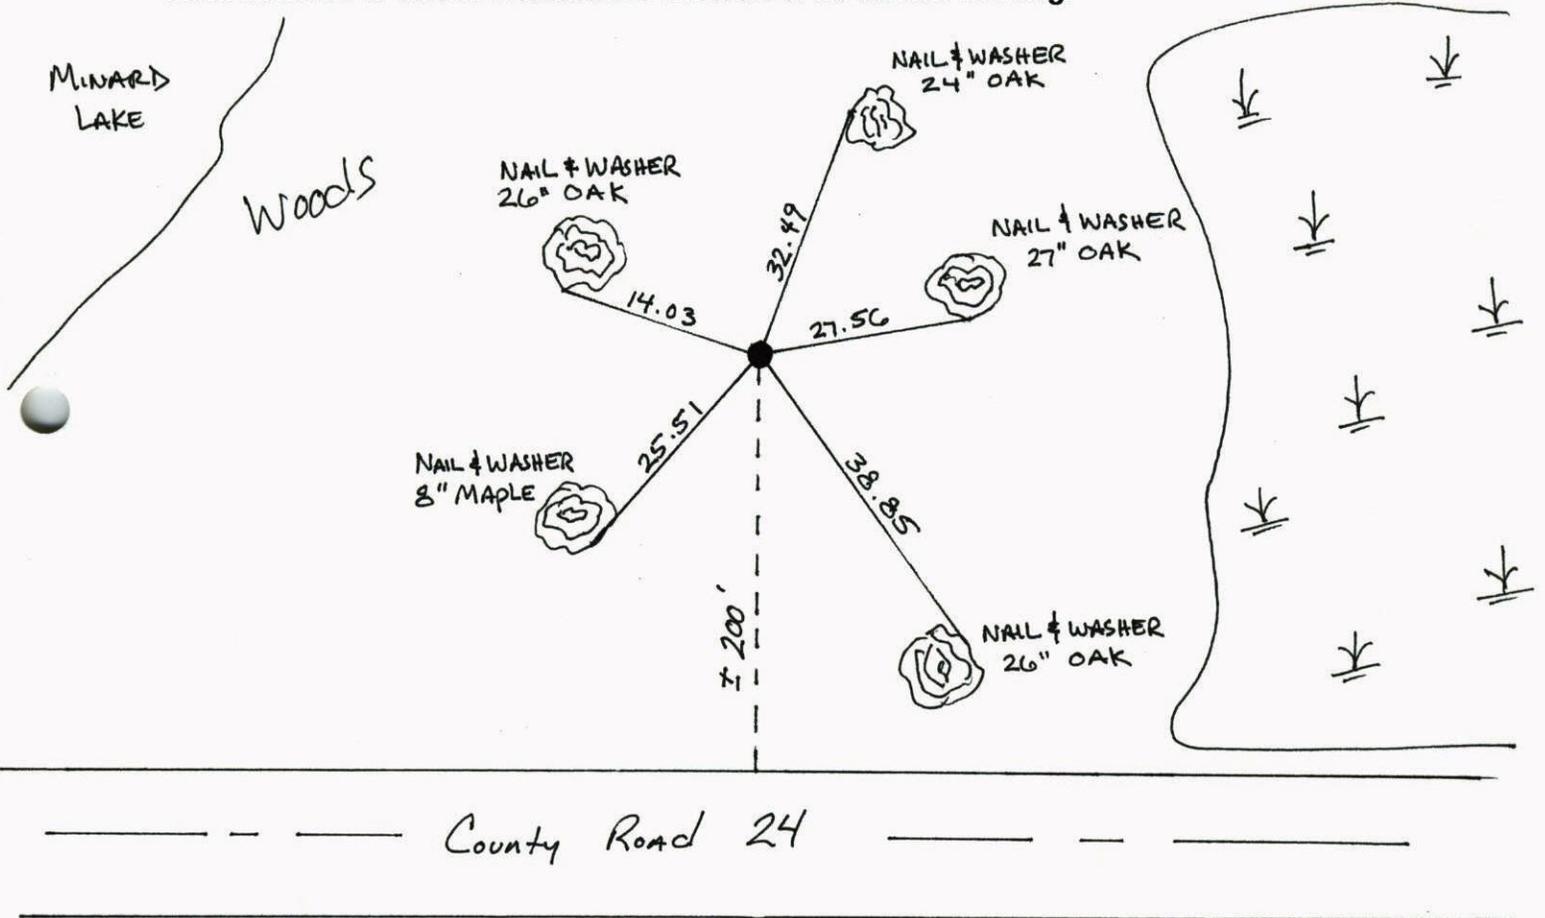


Revised date	Revised date	Revised date
8/5/92		
8-13-97		
5-15-02		

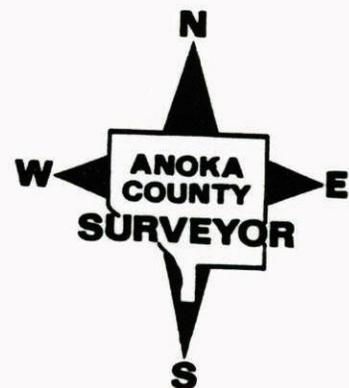

N.W. Cor Sec 32 - T34 - R23

1 1/4" Iron pipe up 0.1'

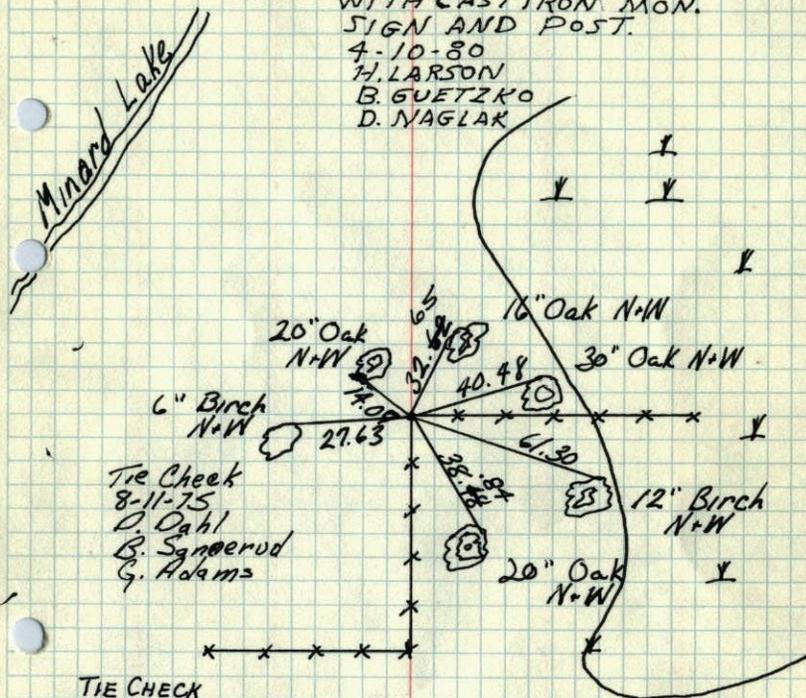
* REPLACED IRON PIPE
WITH CAST IRON MON.
SIGN AND POST.4-10-80
H. LARSON
B. GUETZKO
D. NAGLAKTIE CHECK
8-28-78
M. KISROW
B. STEPHENSTIE CHECK
6-7-82
P. ROSS
B. MICHALAS
S. BEIER

CO. RD. #24

Tie Check
Aug 20, 1971R. Brien
J. Baettcher
B. OlsonTEMPERATURE CORRECTED
AND HORIZONTALLY
TAPED MEASUREMENTSROLAND W. ANDERSON
COUNTY SURVEYOR
ANOKA COUNTY, MINNESOTA

N.W. Cor. Sec. 32-T34-R23

1 1/4" Iron pipe up 0.1'

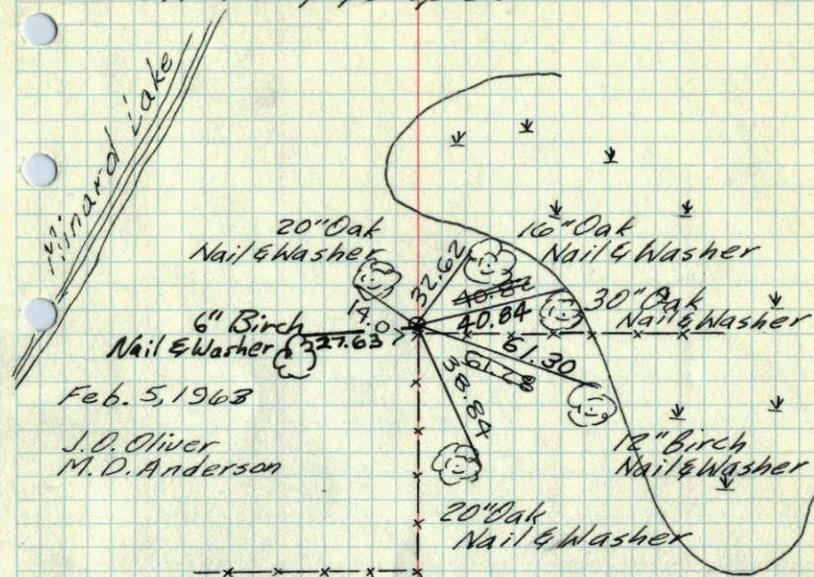

Feb. 5, 1963

J. D. Oliver
M. D. Anderson

COUNTY RD. #24

Tie Check
July 12, 1967
D. Potter
D. PowellTie Check
Aug. 20, 1971
R. Brien
J. Baettcher
B. OlsonTEMPERATURE CORRECTED
AND HORIZONTALLY
TAPED MEASUREMENTSROLAND W. ANDERSON
COUNTY SURVEYOR
ANOKA COUNTY, MINNESOTA

N.W. Cor. Sec. 32-T34-R23

1 1/4" Iron pipe up 0.1'



COUNTY RD. #24


7/12/67
D. PATER
D. POWELL
J#7-870

TEMPERATURE CORRECTED
AND HORIZONTALLY
TAPED MEASUREMENTS

ROLAND W. ANDERSON
COUNTY SURVEYOR
ANOKA COUNTY, MINNESOTA

NW Cor. Sec. 32, T34, R 23


Found 1 1/4" I.P. up 0.1'

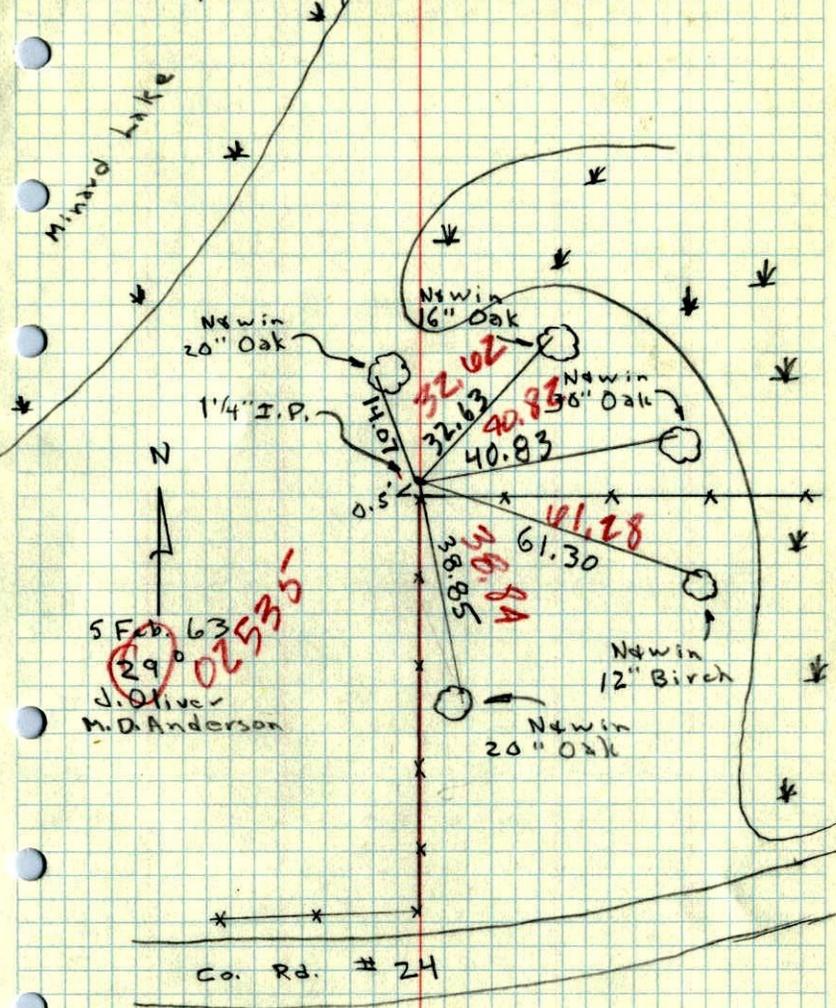

N.W. COR. SEC. 32-34-23

10

IRON PIPE

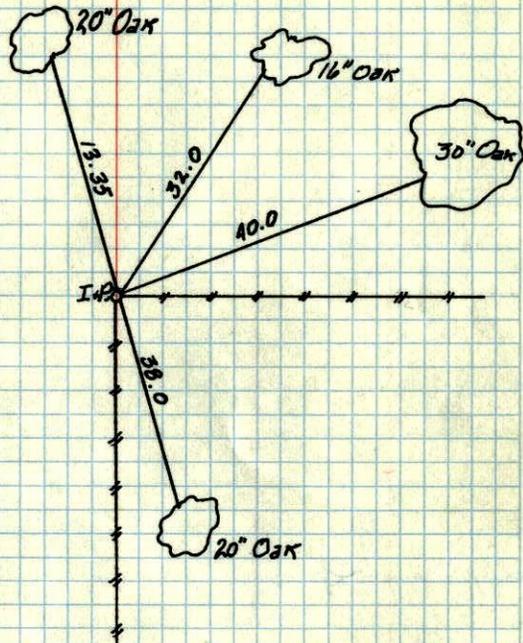

NORMAN C. HOLUM