

CERTIFICATE OF LOCATION OF GOVERNMENT CORNER

County of Anoka State of Minnesota


Northwest Corner of Sec. 31 Township 34 Range 23

On the 23rd day of February, 1962, the described corner was evidenced by a 1" iron bolt

and to perpetuate the location of said corner, at the exact location thereof, a permanent marker was placed consisting of a cast iron monument

AND on the 15th day of May, 2002, said permanent marker was found and the ties were updated

Updated reference ties are as shown below.

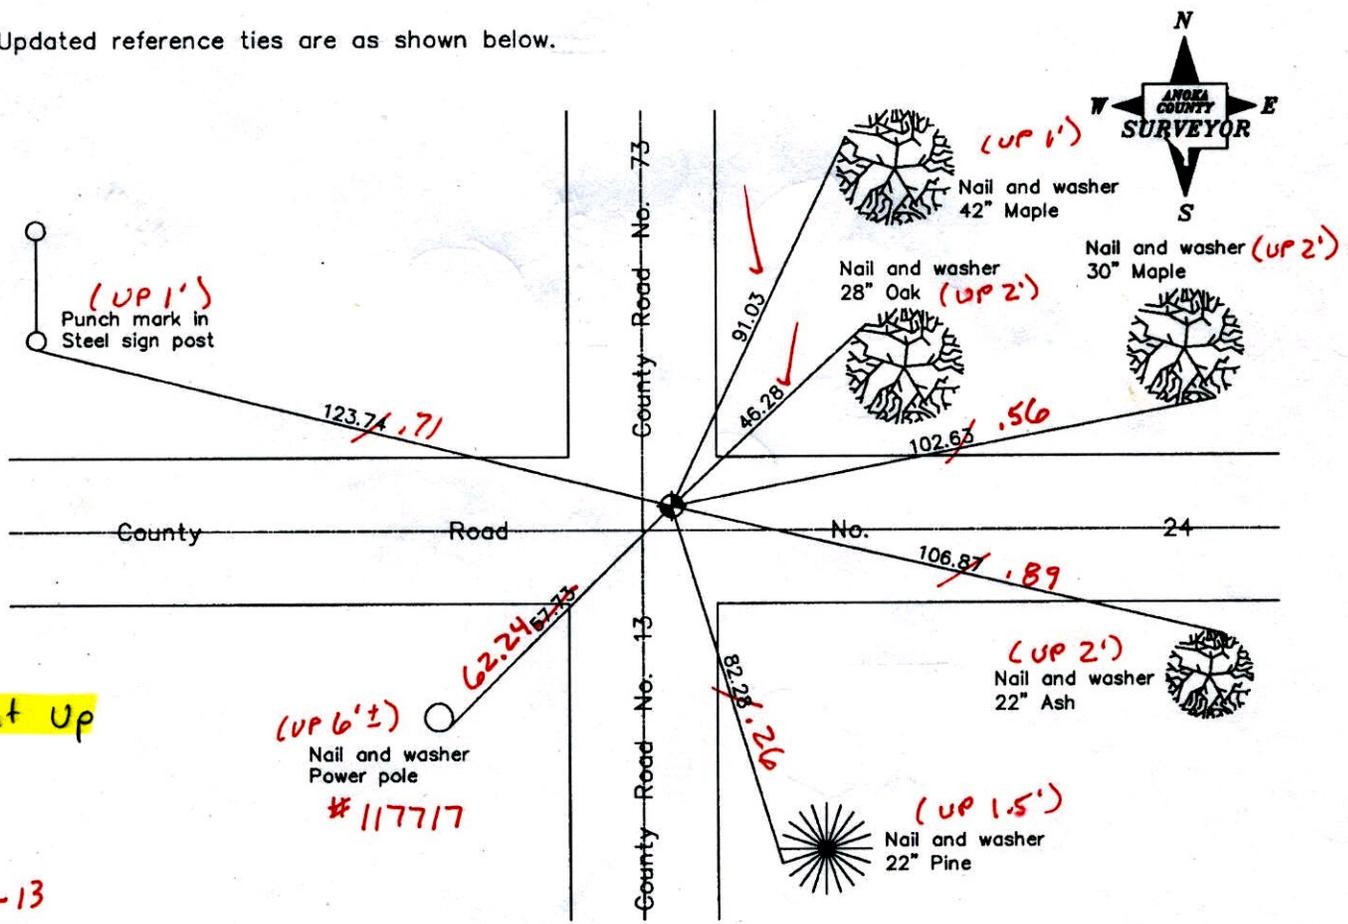

Paint Up

5-14-13
BK-55
T/T-~~117717~~

Revised date
8/06/97
5/25/00
5/15/02

N.A.D. 1983 Coordinates (1996 Adjustment)	
County Project Coordinates	
Northing	<u>232732.2258</u>
Easting	<u>500338.5341</u>
Date	<u>5/15/02</u>

I hereby certify that this United States public land survey monument record is correct and complete to the best of my knowledge and belief.

Larry D. Hoium Date 5/15/02

Larry D. Hoium, Anoka County Surveyor

Minnesota License Number 18165

SPARKMAN *N 232732* *E 500338*

CERTIFICATE OF LOCATION OF GOVERNMENT CORNER

County of Anoka

State of Minnesota


Northwest Corner of Sec. 31 Township 34 Range 23

On the 23rd day of February, 1962, the described corner was evidenced by a 1" iron bolt

and to perpetuate the location of said corner, at the exact location thereof, a permanent marker was placed consisting of a cast iron monument **-RAISED FLUSH**

AND on the 15th day of May, 2002, said permanent marker was found and the ties were updated

Updated reference ties are as shown below.

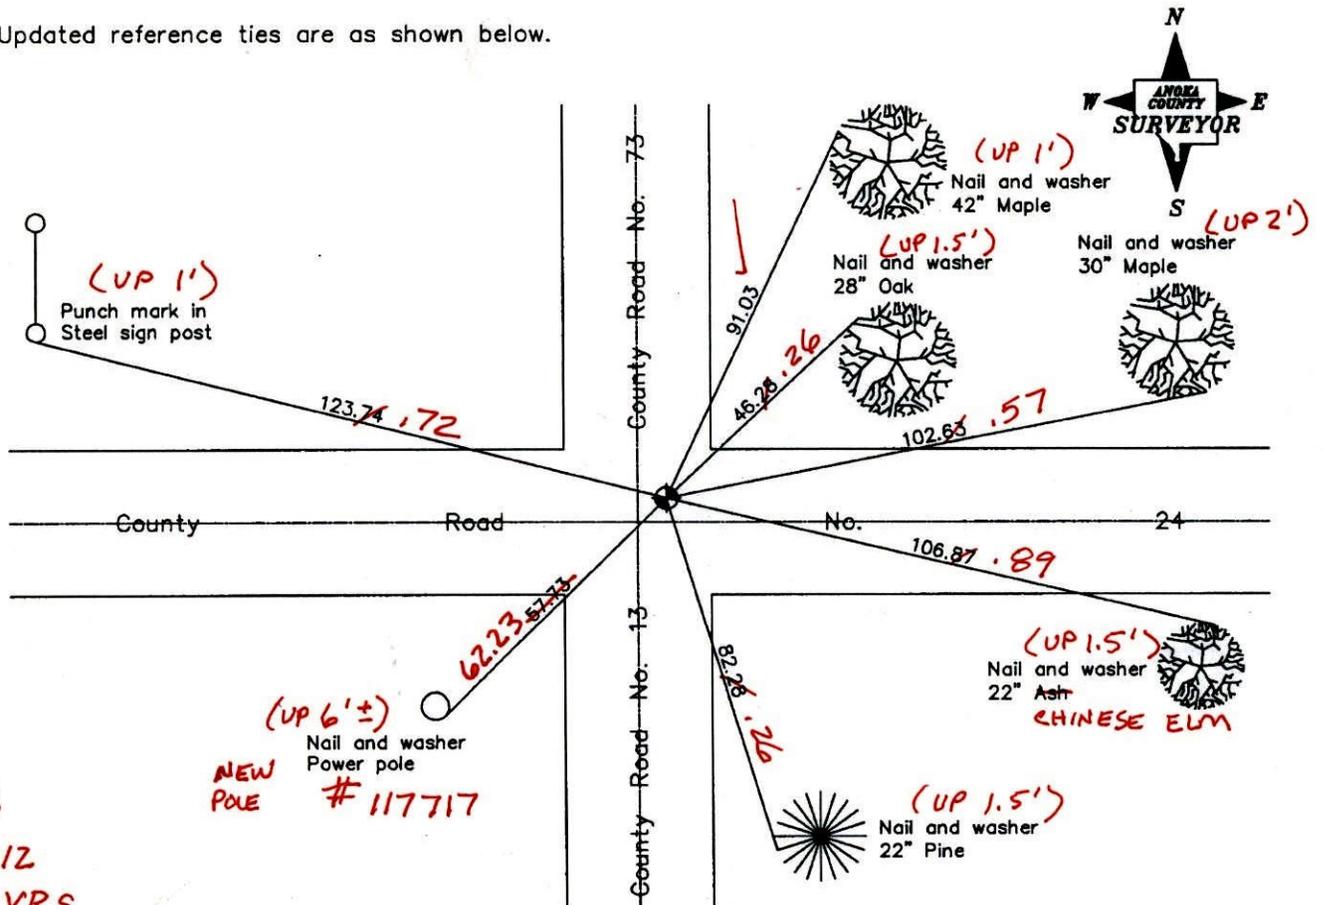

BK-SS
12-7-12
T/T-VRS

Revised date
8/06/97
5/25/00
5/15/02

N.A.D. 1983 Coordinates (1996 Adjustment)	
County Project Coordinates	
Northing	<u>232732.2258</u>
Easting	<u>500338.5341</u>
Date	<u>5/15/02</u>

I hereby certify that this United States public land survey monument record is correct and complete to the best of my knowledge and belief.

Larry D. Hoium Date 5/15/02

Larry D. Hoium, Anoka County Surveyor
Minnesota License Number 18165

3D=0.05 **N=232732.2180** **E=500338.4738**

CERTIFICATE OF LOCATION OF GOVERNMENT CORNER

County of Anoka

State of Minnesota



Northwest Corner of Sec. 31 Township 34 Range 23

On the 23rd day of February, 1962, the described corner was evidenced by a 1" iron bolt

and to perpetuate the location of said corner, at the exact location thereof, a permanent marker was placed consisting of a cast iron monument

AND on the 7th day of December, 2012, said permanent marker was found, raised to the surface and the ties were updated

Updated reference ties are as shown below.

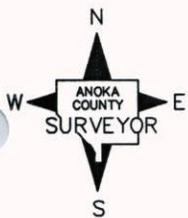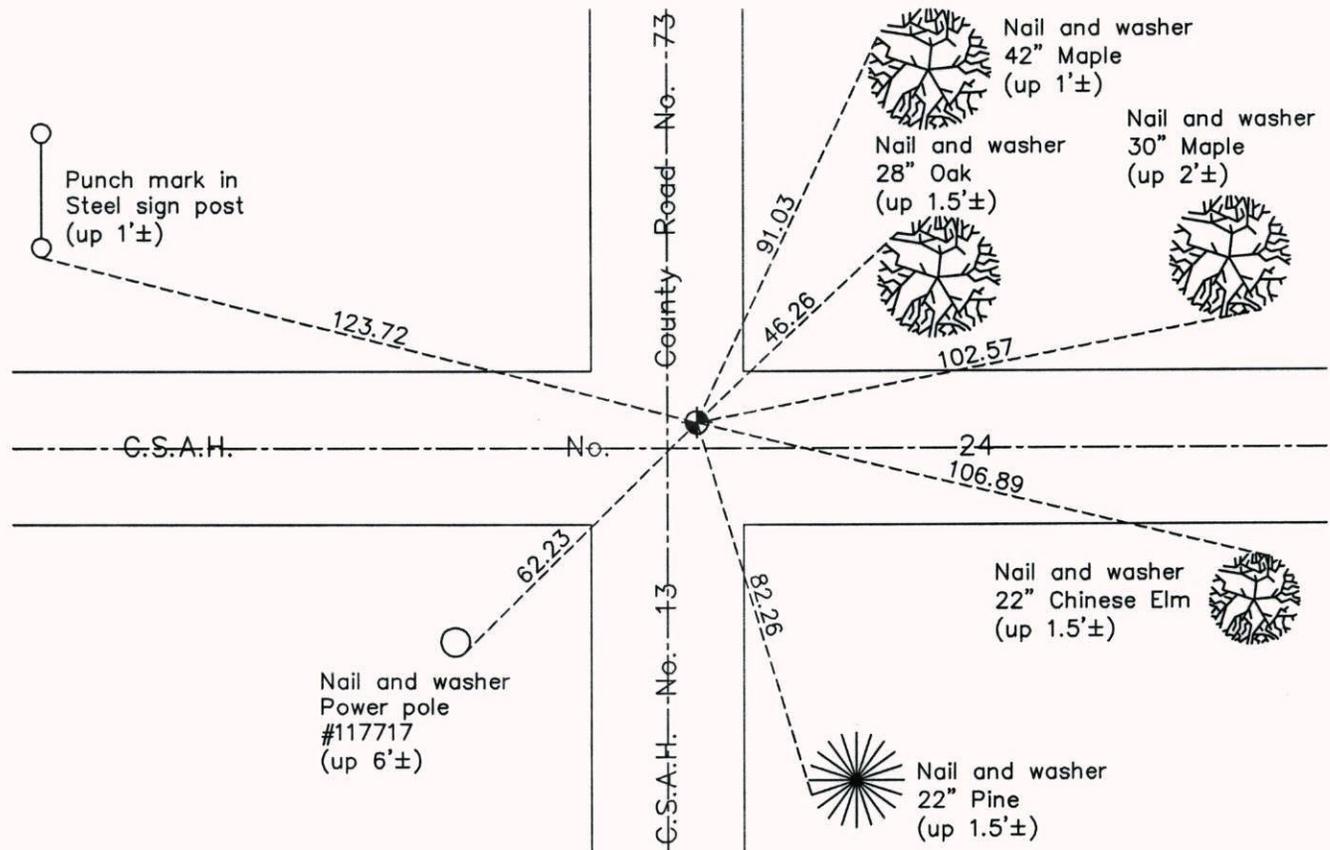

Revision Date
3/27/12

N.A.D. 1983 Coordinates.
(1996 Adjustment)

County Project Coordinates	
Northing	<u>232732.2258</u>
Easting	<u>500338.5341</u>
Date	<u>5/15/02</u>

I hereby certify that this United States public land survey monument record is correct and complete to the best of my knowledge and belief.

Larry D. Hoium Date 3/27/13

Larry D. Hoium, Anoka County Surveyor
Minnesota License Number 18165

CERTIFICATE OF LOCATION OF GOVERNMENT CORNER

County of Anoka


State of Minnesota

NORTHWEST Corner of Sec. 31 Township 34 Range 23


I hereby certify that on the 23RD day of FEBRUARY, 19 62, I found the described corner which was evidenced by 1" IRON BOLT

and I further certify that to perpetuate the location of said corner, I did, at the exact location thereof, place a permanent marker consisting of CAST IRON MONUMENT

which reference or witness monuments are located in the manner following:

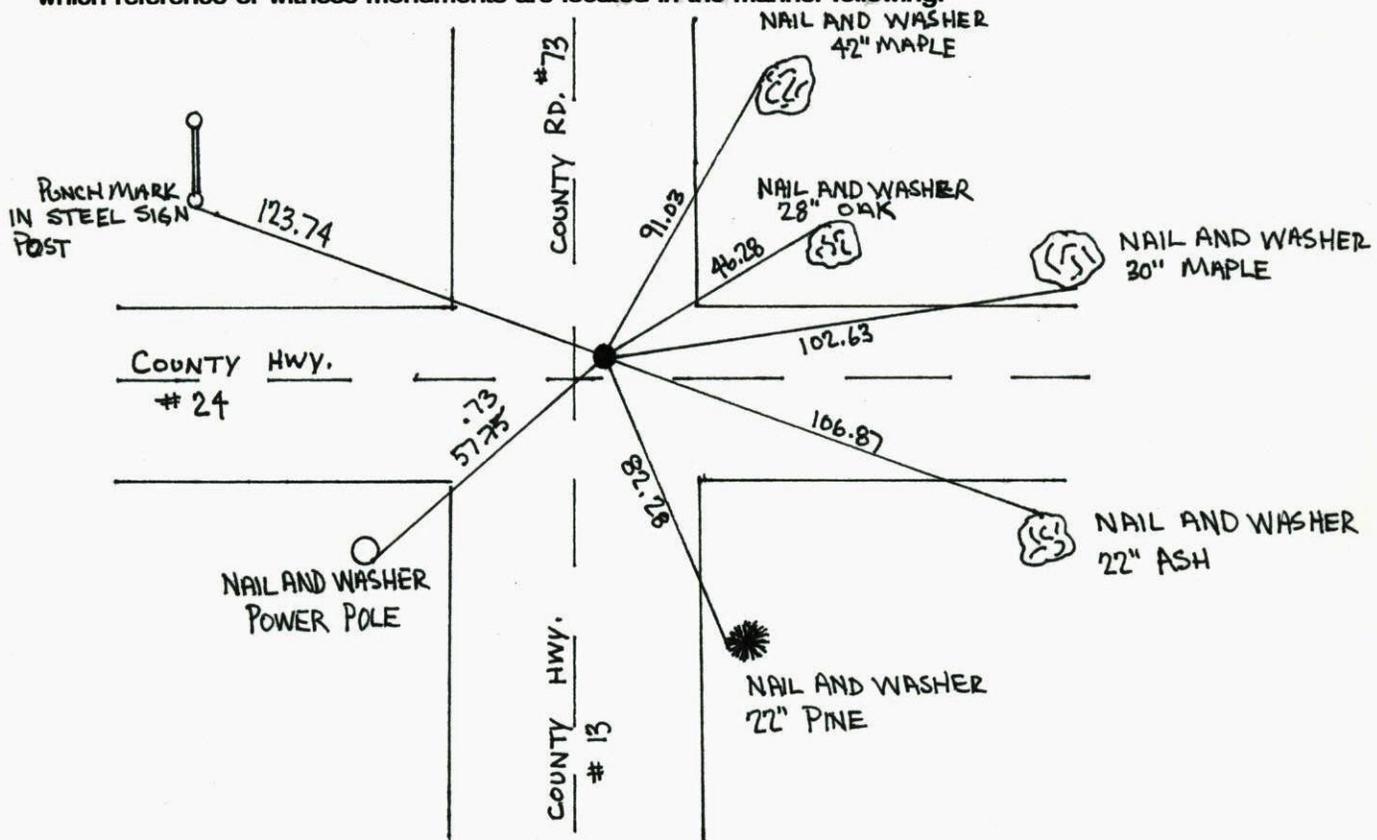


Revised date	Revised date	Revised date
8-4-86		
8-5-92		
8-6-97		
5-25-00		
5-15-02		

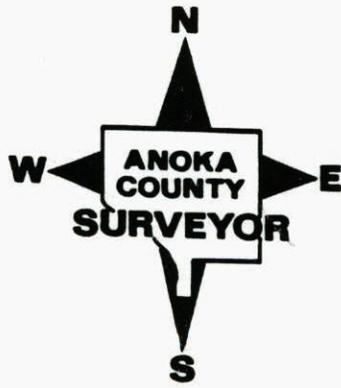

N.W. Cor. Sec. 31 T34 R23

Cast Iron Monument Flush. PK's 2.00' N.E.

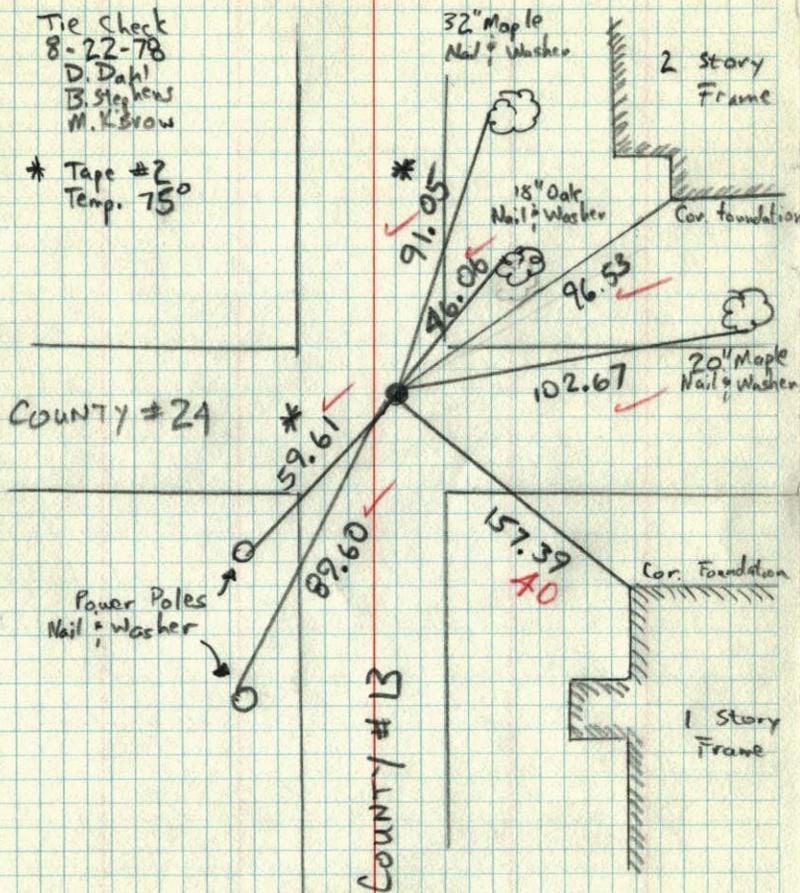

N.W. Cor. Sec. 31, T.34, R.23

Cast Iron Monument Flush. PK's 2.00' North + East.

Feb. 23, 1962

J. Oliver
M.D. Anderson
H. Small

Check New Ties 8-22-78

D. Dahl


COUNTY #24

Nail & Washer P.P.'S

TIE CHECK
8-8-75
D. DAHL
B. SANDERSON
G. ADAMS


TEMPERATURE CORRECTED
AND HORIZONTALLY
TAPED MEASUREMENTS

ROLAND W. ANDERSON
COUNTY SURVEYOR
ANOKA COUNTY, MINNESOTA

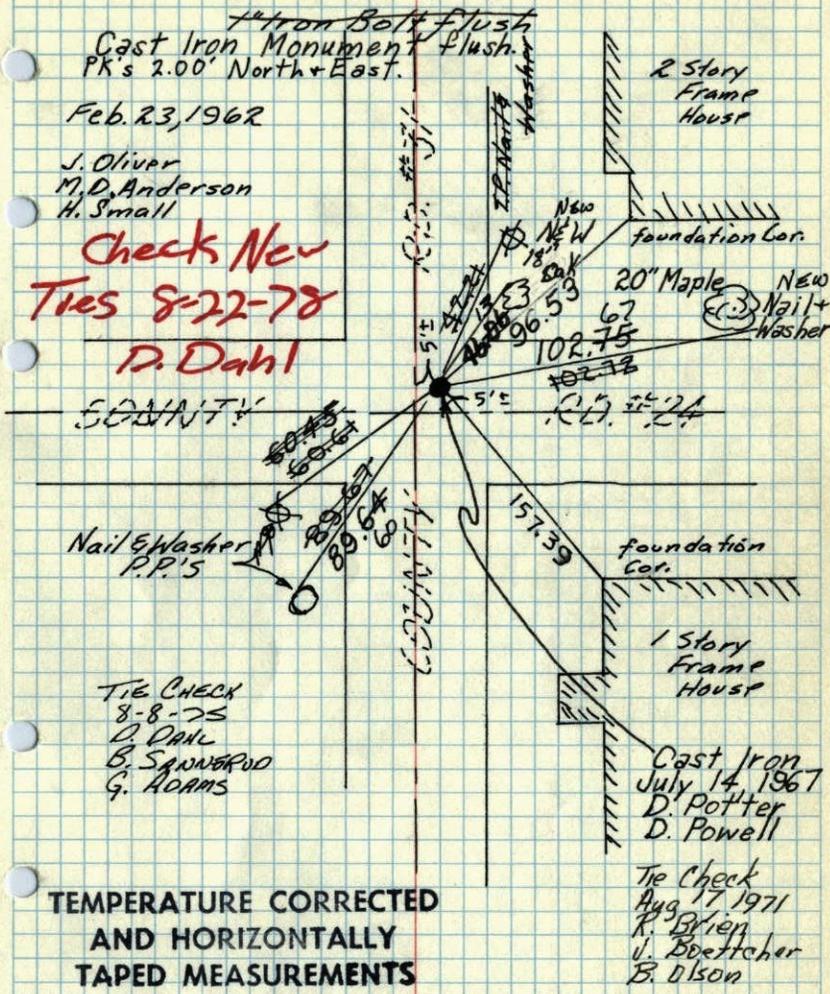

N.W. Cor. SEC. 31-34-23

IRON BOLT & SPIKE

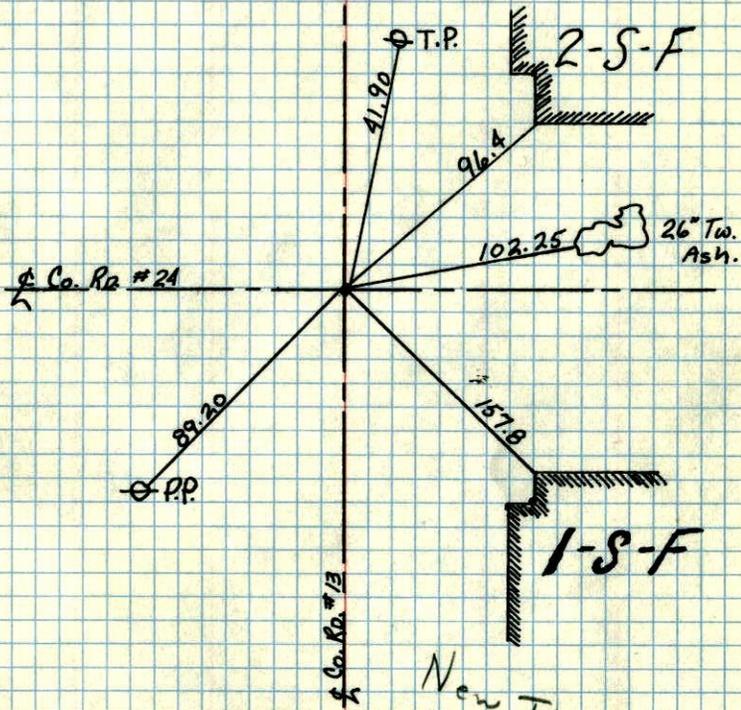

New Ties in
New Tie Book

NORMAN C. HOUM