

CERTIFICATE OF LOCATION OF GOVERNMENT CORNER

County of Anoka State of Minnesota

West 1/4 Corner of Sec. 31 Township 34 Range 23


On the 7th day of April, 1969, the described corner was evidenced by area resurvey

and to perpetuate the location of said corner, at the exact location thereof, a permanent marker was placed consisting of a cast iron monument

AND on the 15th day of May, 2002, said permanent marker was found and the ties were updated (CIM FALLS 4'E EAST OF C)

Updated reference ties are as shown below

8/10/13
 JS SH SS
 RESET CIM,
 TIES AND VRS
 3D QUAL: 0.04
 N: 230143.696
 E: 500341.119
 CIRCLED
 DIST'S ARE
 FINAL

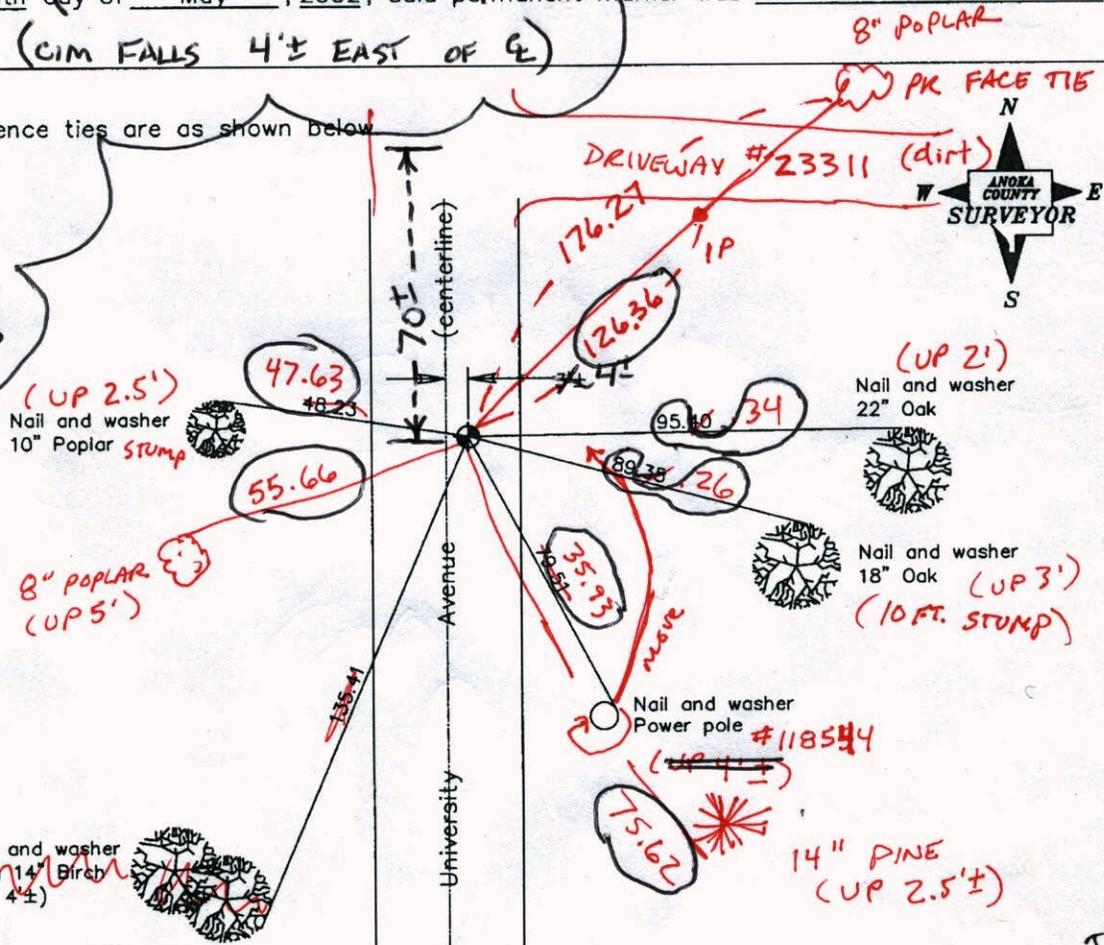

5.13-13
 BK-SS
 T/T-VRS

CONST T/T

Revised date
8/06/97
5/25/00
5/15/02

N.A.D. 1983 Coordinates (1996 Adjustment)	
County Project Coordinates	
Northing	230143.6814
Easting	500341.1314
Date	5/15/02

I hereby certify that this United States public land survey monument record is correct and complete to the best of my knowledge and belief.

Larry D. Hoium Date 5/15/02

Larry D. Hoium, Anoka County Surveyor
 Minnesota License Number 18165

VRS 3D=0.06 N=230143.6924 E=500341.0627

CERTIFICATE OF LOCATION OF GOVERNMENT CORNER

County of Anoka

State of Minnesota


West 1/4 Corner of Sec. 31 Township 34 Range 23

On the 7th day of April, 1969, the described corner was evidenced by area resurvey

and to perpetuate the location of said corner, at the exact location thereof, a permanent marker was placed consisting of a cast iron monument

AND on the 20th day of December, 2012, said permanent marker was found and the ties were updated

Updated reference ties are as shown below.

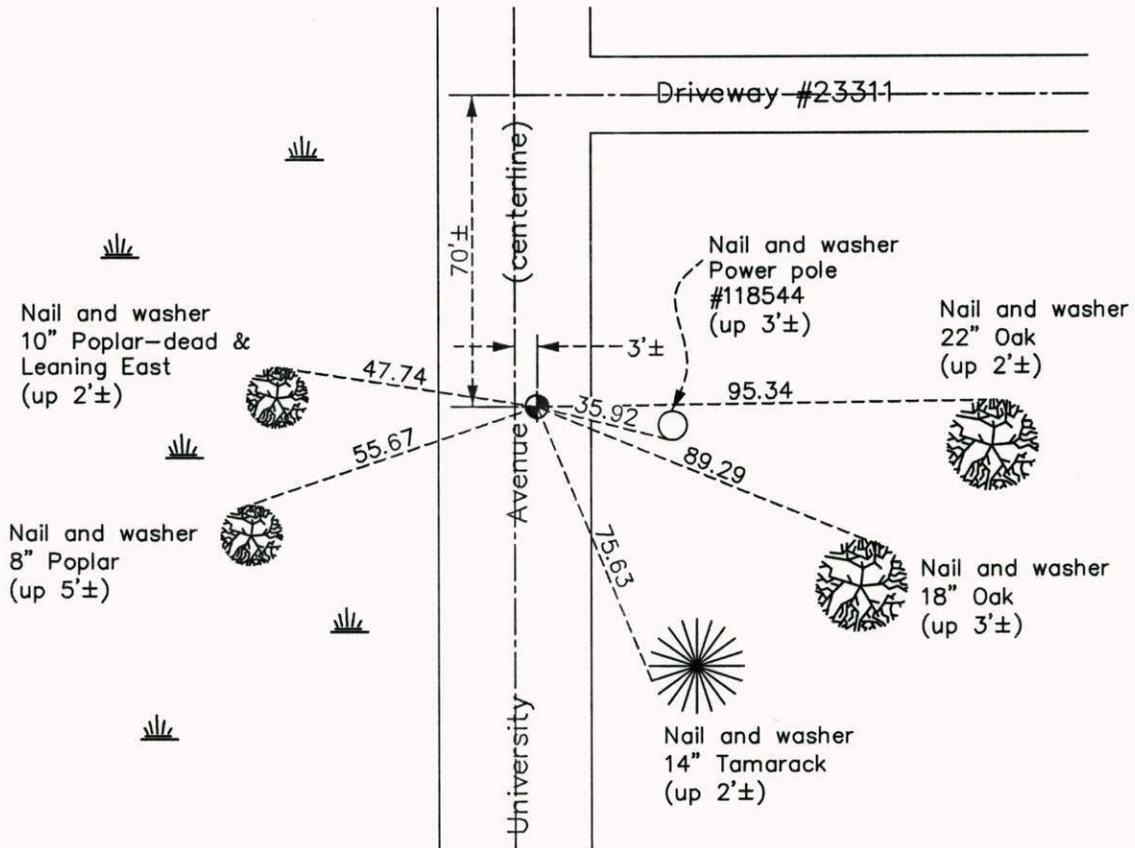

ANOKA COUNTY SURVEYOR

Revision Date 3/27/13

N.A.D. 1983 Coordinates (1996 Adjustment)

County Project Coordinates	
Northing	<u>230143.6814</u>
Easting	<u>500341.1314</u>
Date	<u>5/15/02</u>

I hereby certify that this United States public land survey monument record is correct and complete to the best of my knowledge and belief.

Larry D. Hoium Date 3/27/13

Larry D. Hoium, Anoka County Surveyor
Minnesota License Number 18165

CERTIFICATE OF LOCATION OF GOVERNMENT CORNER


County of Anoka State of Minnesota

WEST 1/4 Corner of Sec. 31 Township 34 Range 23


I hereby certify that on the 7TH day of APRIL, 19 69, I found the described corner which was evidenced by AREA RESURVEY

and I further certify that to perpetuate the location of said corner, I did, at the exact location thereof, place a permanent marker consisting of CAST IRON MONUMENT

which reference or witness monuments are located in the manner following:

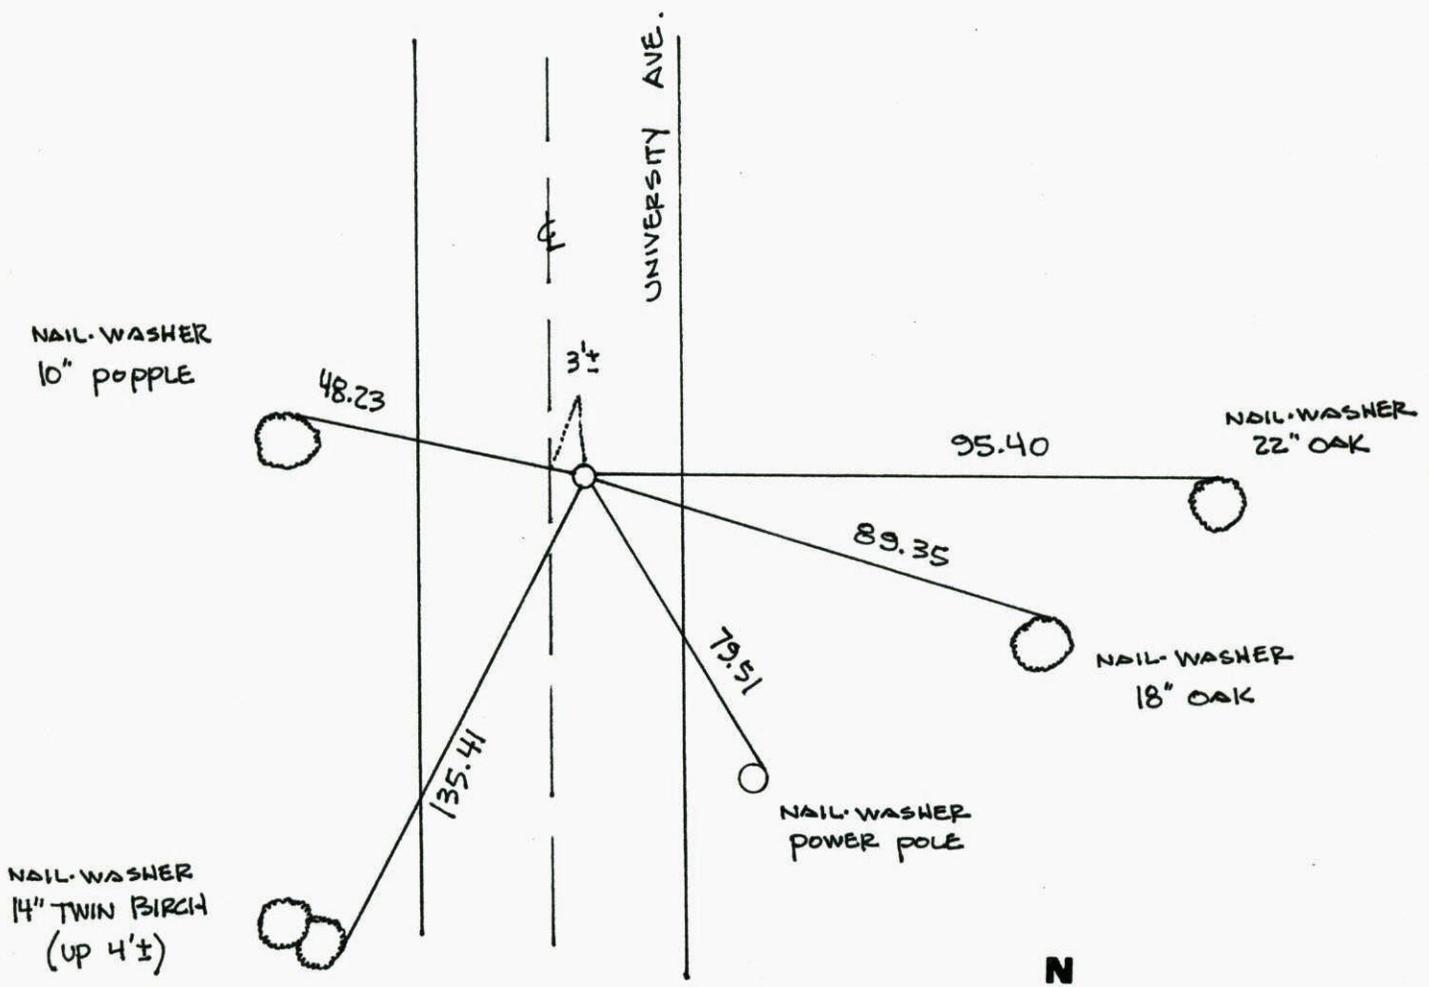


Revised date	Revised date	Revised date
8-4-86		
5-22-92		
8-5-92		
8-6-97		
5-25-00		
5-15-02		

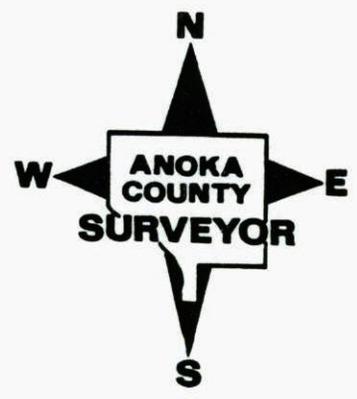

WEST 1/4 COR. SEC. 31, T. 34, R. 23

RETIED C. I. M.

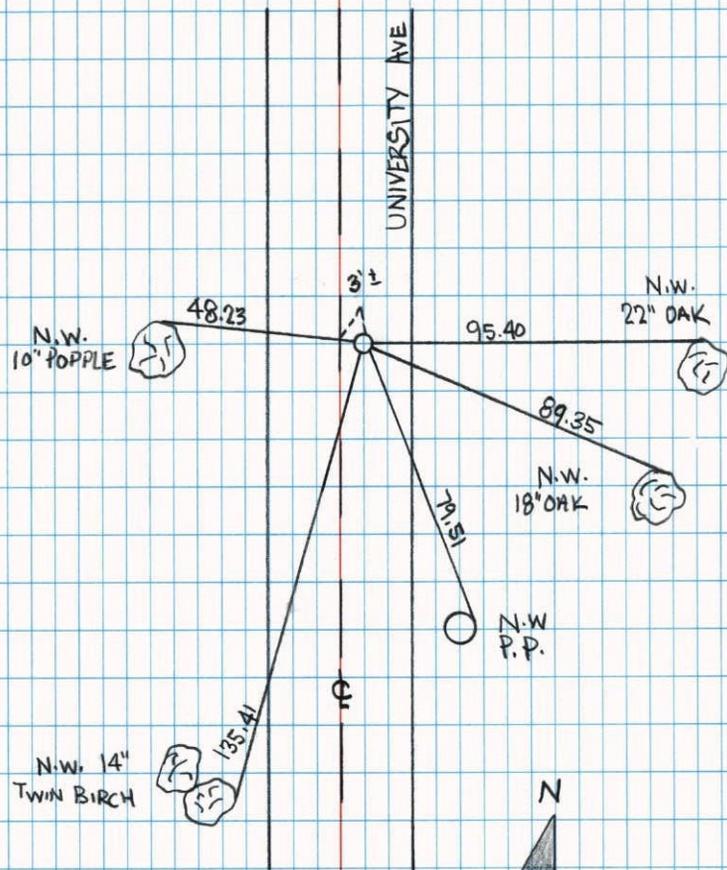

5-25-00

J. SIMMER

B. KLEMZ


T. SCHWAR

W 1/4 Cor. Sec. 31-T34-R23

Set PK nail from area resurvey.

Set Cast Iron Monument
 Flush. PK Nails 2.00' North
 and East.
 July 29, 1969
 D. Powell
 R. Olson
 B. Olson

April 7, 1969
 M. D. Anderson
 H. J. Larson
 R. A. Olson

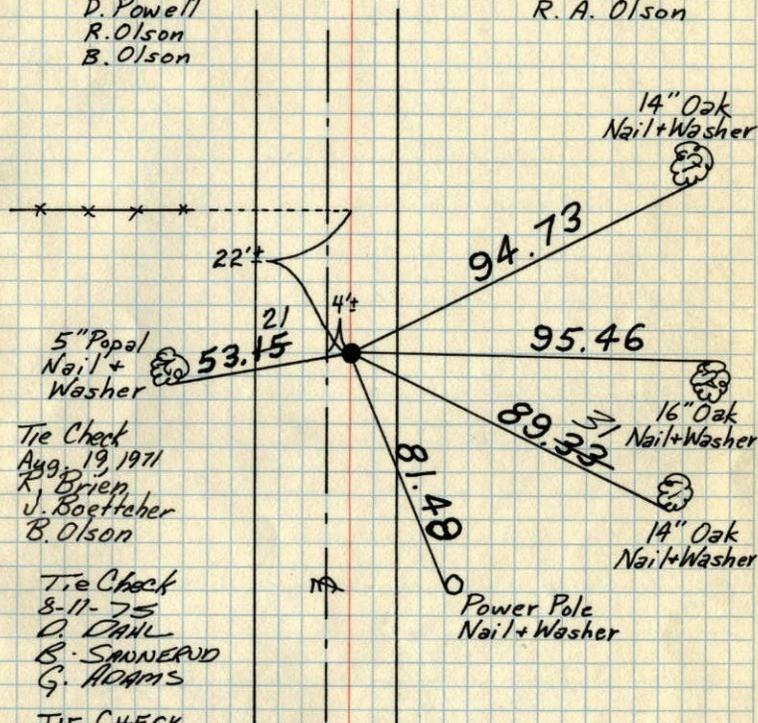

Tie Check
 Aug. 19, 1971
 R. Brien
 J. Boettcher
 B. Olson

Tie Check
 8-11-75
 O. DANL
 B. SANDERUD
 G. ADAMS

TIE CHECK
 8-28-78
 B. STEPHENS
 M. KISROW

TIE CHECK
 5-27-82
 P. ROSS
 B. NICHOLAS

TEMPERATURE CORRECTED ROLAND W. ANDERSON
 AND HORIZONTALLY COUNTY SURVEYOR
 TAPED MEASUREMENTS ANOKA COUNTY, MINNESOTA.


W 1/4 Cor. Sec. 31-T34-R23

Set PK nail from area resurvey.

Add ties to West when placing C.I. Mon.

Set C.I. Mon. flush.
PK's 2.00' N+E

April 7, 1969
M. D. Anderson
H. J. Larson
R. A. Olson

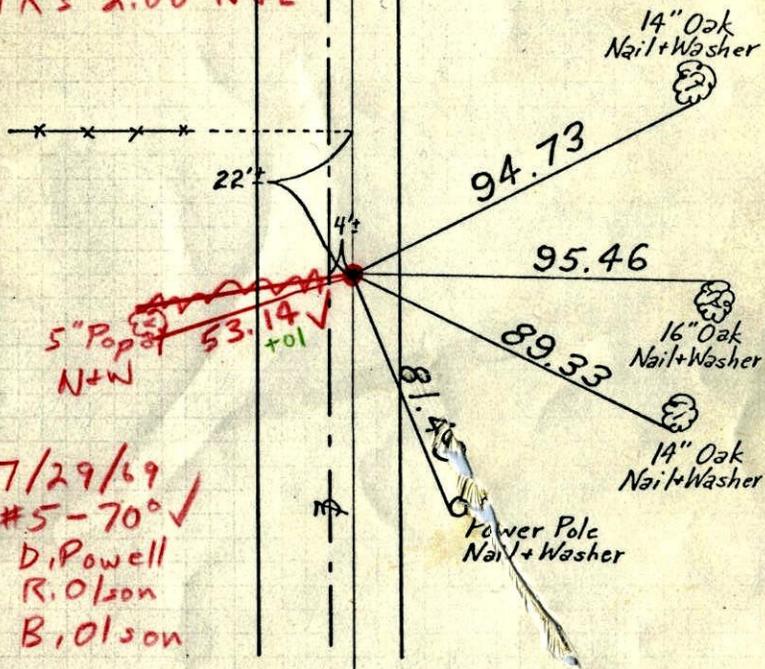


7/29/69
#5-70°
D. Powell
R. Olson
B. Olson

TEMPERATURE CORRECTED
AND HORIZONTALLY
TAPED MEASUREMENTS

W 1/4 Cor. Sec. 31-T34-R23

set P.K. nail
set from area resurvey

April 7, 1969
M. D. Anderson
H. J. Larson
R. A. Olson
Tape 65'

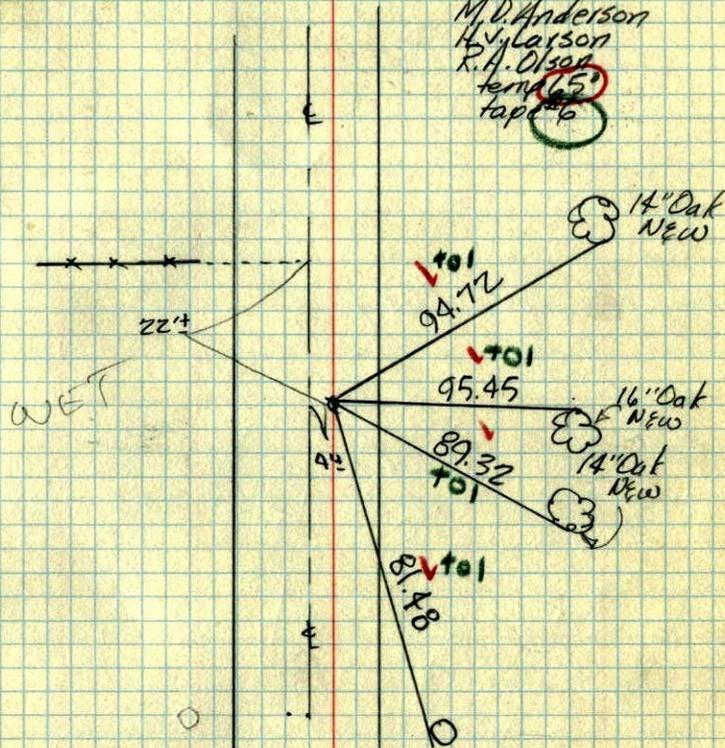

Add ties when placing
C.I. Mon. (to west)