

CERTIFICATE OF LOCATION OF GOVERNMENT CORNER

County of Anoka State of Minnesota


East 1/4 Corner of Sec. 32 Township 34 Range 23

On the 18th day of July, 1967, the described corner was evidenced by a 1" iron pipe

and to perpetuate the location of said ✓ corner, at the exact ✓ location thereof, a permanent marker was placed consisting of a cast iron monument with a sign and post on the south side

AND on the 12th day of May, 2005, said permanent marker was found and the ties were updated

Updated reference ties are as shown below.

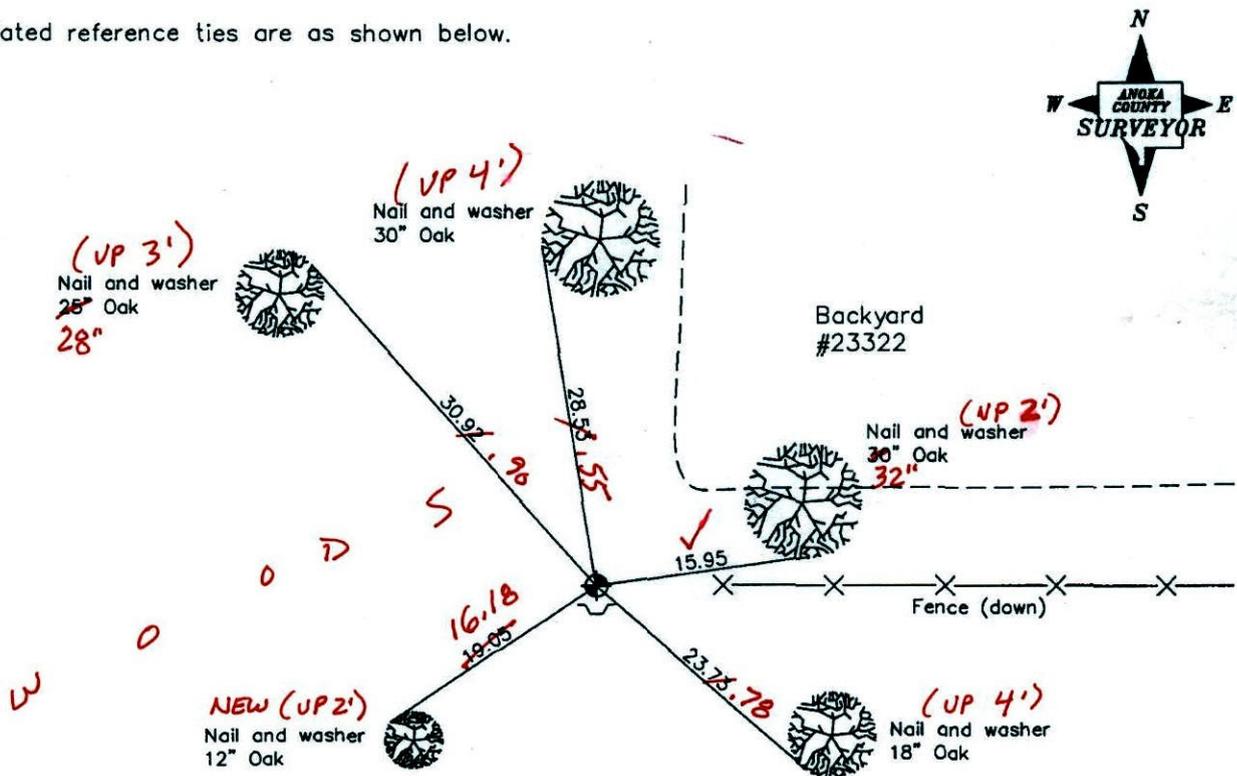

10-24-12
BK-SS
TAPED

Revised date
8/08/86
8/19/92
5/12/05

N.A.D. 1983 Coordinates (1996 Adjustment)	
County Project Coordinates	
Northing	<u>230109.1007</u>
Easting	<u>510911.8663</u>
Date	<u>4/01/03</u>

I hereby certify that this United States public land survey monument record is correct and complete to the best of my knowledge and belief.

Larry D. Hoium Date 5/12/05

Larry D. Hoium, Anoka County Surveyor

Minnesota License Number 18165

CERTIFICATE OF LOCATION OF GOVERNMENT CORNER

County of Anoka


State of Minnesota

EAST 1/4 Corner of Sec. 32 Township 34 Range 23


I hereby certify that on the 18 day of JULY, 19 67, I found the described corner which was evidenced by 1" IRON PIPE

and I further certify that to perpetuate the location of said corner, I did, at the exact location thereof, place a permanent marker consisting of CAST IRON MONUMENT SIGN
AND POST ON SOUTH SIDE

which reference or witness monuments are located in the manner following:

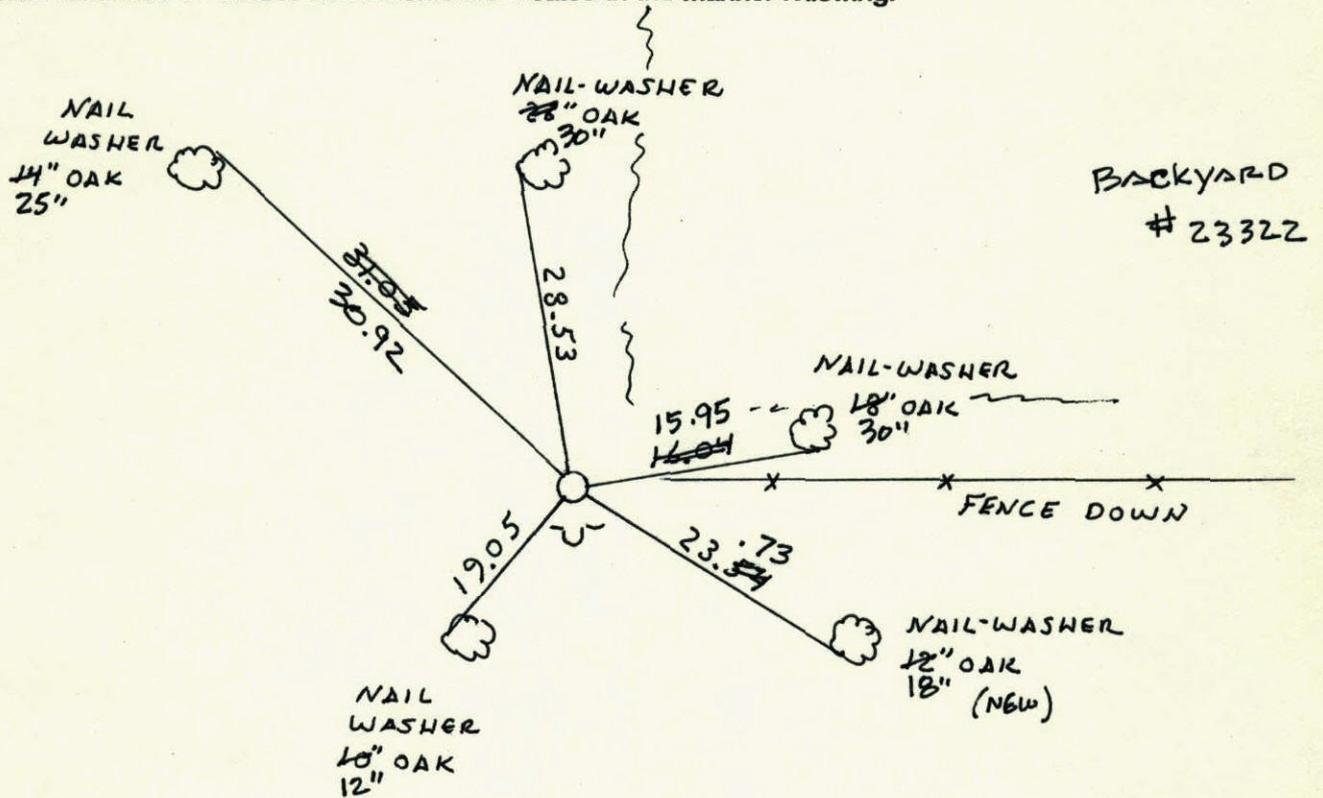


Revised date	Revised date	Revised date
8-8-86		
8-19-92		
5-12-05		

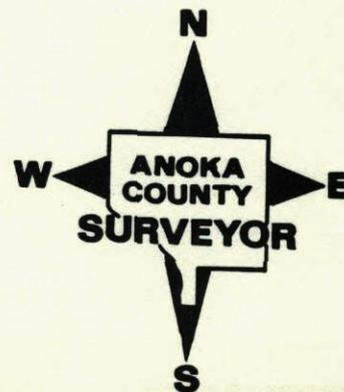

E 1/4 Cor. Sec. 32-T34-R23

1" Iron Pipe flush
 .01" West of 8" Fence post
 Set Cast Iron Monument Flush.
 Monument is 7'±
 West of New Fence Line
 D. Dahl

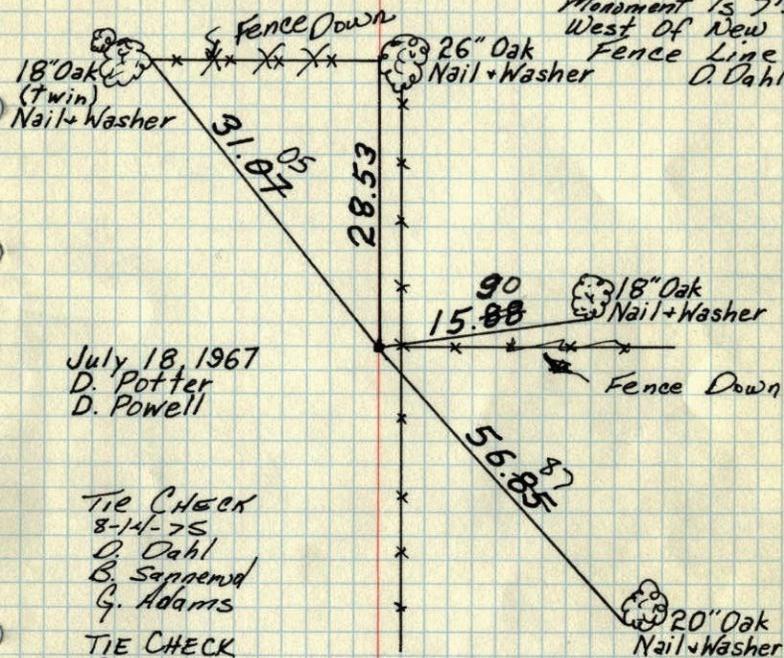

July 18, 1967
 D. Potter
 D. Powell

TIE CHECK
 8-14-75
 D. Dahl
 B. Sannerud
 G. Adams

TIE CHECK
 8-30-78
 M. KISROW
 B. STEPHENS

TIE CHECK
 6-7-82
 P. ROSS
 B. NICHOLAS
 J. BEIER


Tie Check
 Aug. 23, 1971
 B. Olson
 J. Boettcher

TEMPERATURE CORRECTED AND HORIZONTALLY TAPED MEASUREMENTS

ROLAND W. ANDERSON
 COUNTY SURVEYOR
 ANOKA COUNTY, MINNESOTA

E 1/4 Cor. Sec. 32, T34, R23


1" IRON PIPE FLUSH

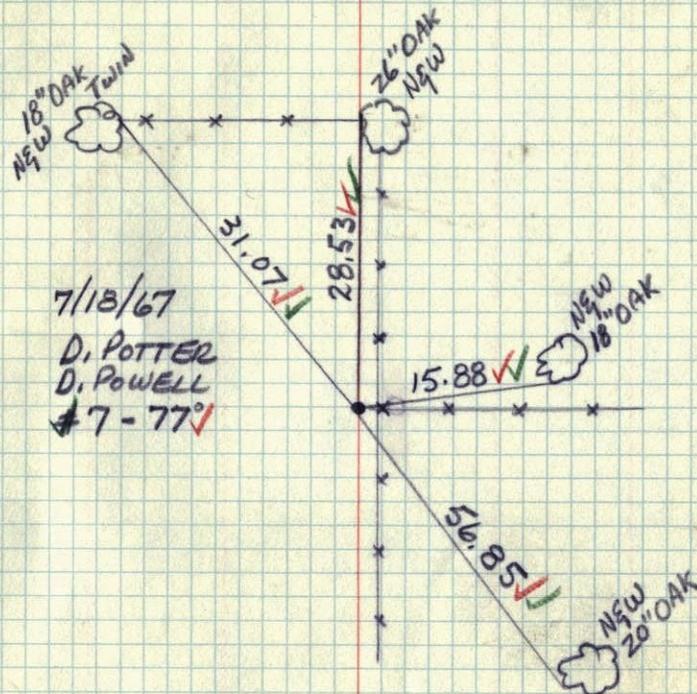

7/18/67
 D. POTTER
 D. POWELL
 7-77

E. 1/4 SEC. 32 - 34 - 23

IRON PIPE

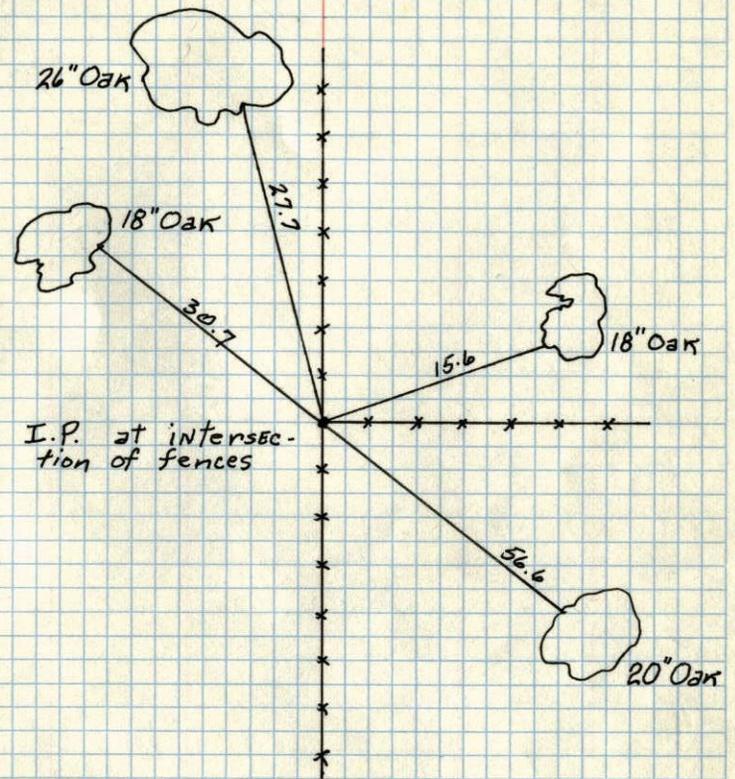

NORMAN C. HOLUM