

# CERTIFICATE OF LOCATION OF GOVERNMENT CORNER

County of Anoka

State of Minnesota

West 1/4 Corner of Sec. 34 Township 34 Range 23

On the 24th day of August, 1976, the described corner was evidenced by a 3/4" iron pipe

and to perpetuate the location of said corner, at the exact location thereof, a permanent marker was placed consisting of a red and white iron pipe with a sign attached (UP 3' +/-)  
LEANING WEST APRX. 0.80' ± (SIGN FACING SOUTH)


AND on the \_\_\_ day of \_\_\_\_\_, \_\_\_\_\_, said permanent marker was \_\_\_\_\_

Updated reference ties are as shown below.



VRS - SHOT ON E. SIDE  
AT GROUND

BK-S.S.  
10-26-12

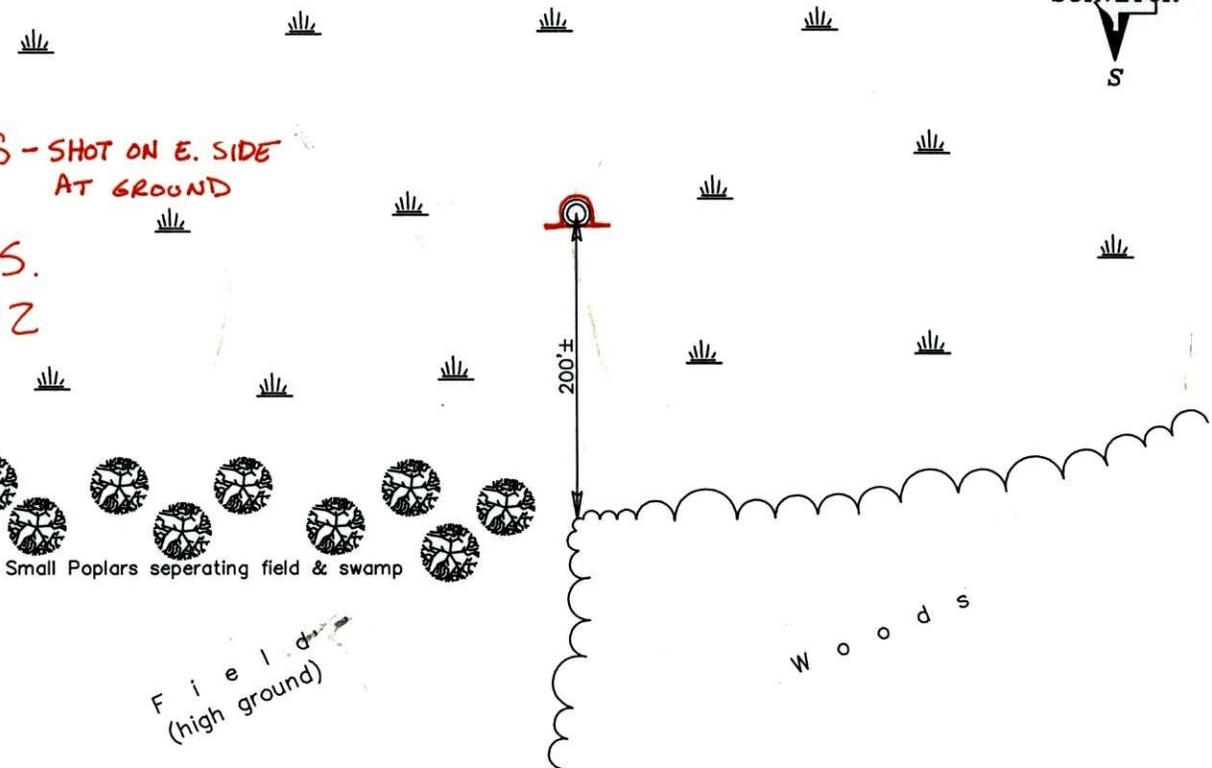

Revised date

1986
5/06/96

N.A.D. 1983 Coordinates  
(1996 Adjustment)

County Project Coordinates	
Northing	<u>230231.8091</u>
Easting	<u>516164.6764</u>
Date	<u>4/09/03</u>

I hereby certify that this United States public land survey monument record is correct and complete to the best of my knowledge and belief.

\_\_\_\_\_  
Date \_\_\_\_\_  
\_\_\_\_\_, Anoka County Surveyor  
Minnesota License Number \_\_\_\_\_

VRS 3D = 0.10

N = 230 231.8018

E = 516164.7290

# CERTIFICATE OF LOCATION OF GOVERNMENT CORNER


County of Anoka                      State of Minnesota

WEST QTR. Corner of Sec. 34 Township 34 Range 23


I hereby certify that on the 24 day of AUG., 1976, I found the described corner which was evidenced by 3/4" I.P.

and I further certify that to perpetuate the location of said corner, I did, at the exact location thereof, place a permanent marker consisting of RED AND WHITE I.P. WITH SIGN

which reference or witness monuments are located in the manner following:

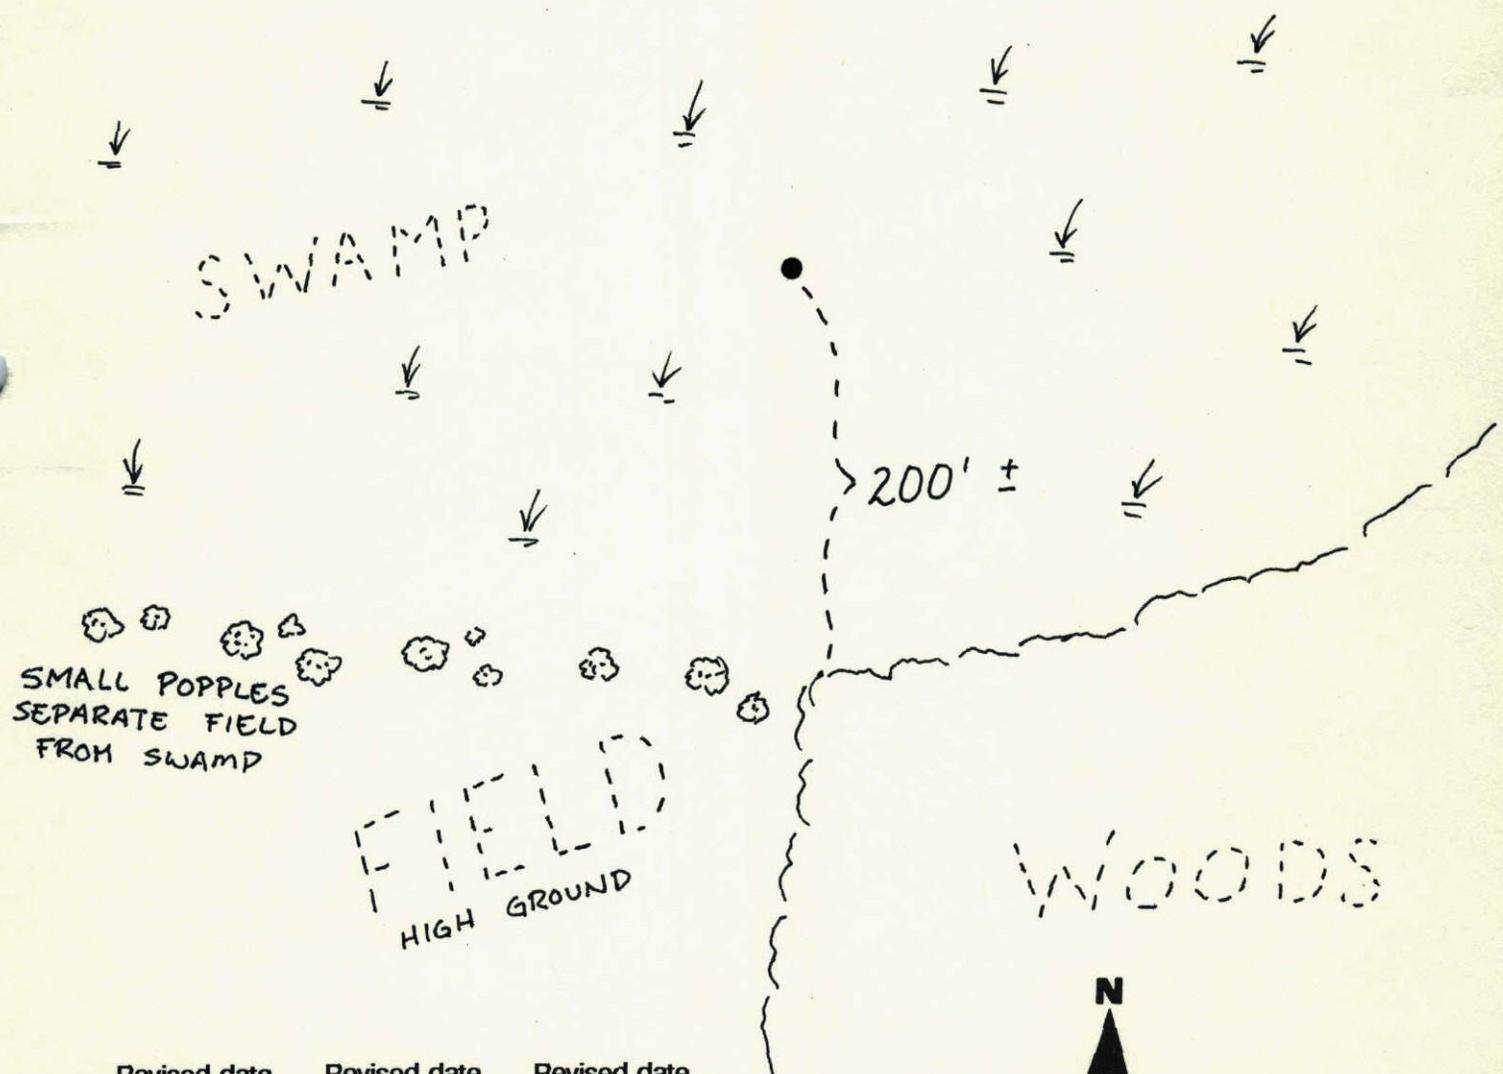


Revised date	Revised date	Revised date
WET 86		
5-6-96		

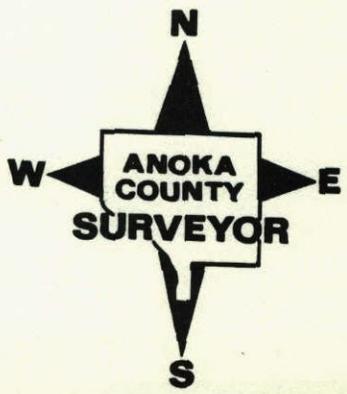

## W. 1/4 CORNER SEC. 34 T. 34 R. 23

FOUND 3/4" IRON PIPE AND OLD ROTTEN STAKE  
 LYING IN SWAMP. PIPE AND STAKE SET IN 1908.  
 FOUND 5" WITNESS TREE TO NORTH 10'± (TREE DEAD)  
 REPLACED WITH RED AND WHITE IRON PIPE UP  
 3'± WITH SIGN ATTACHED TO PIPE ITSELF.

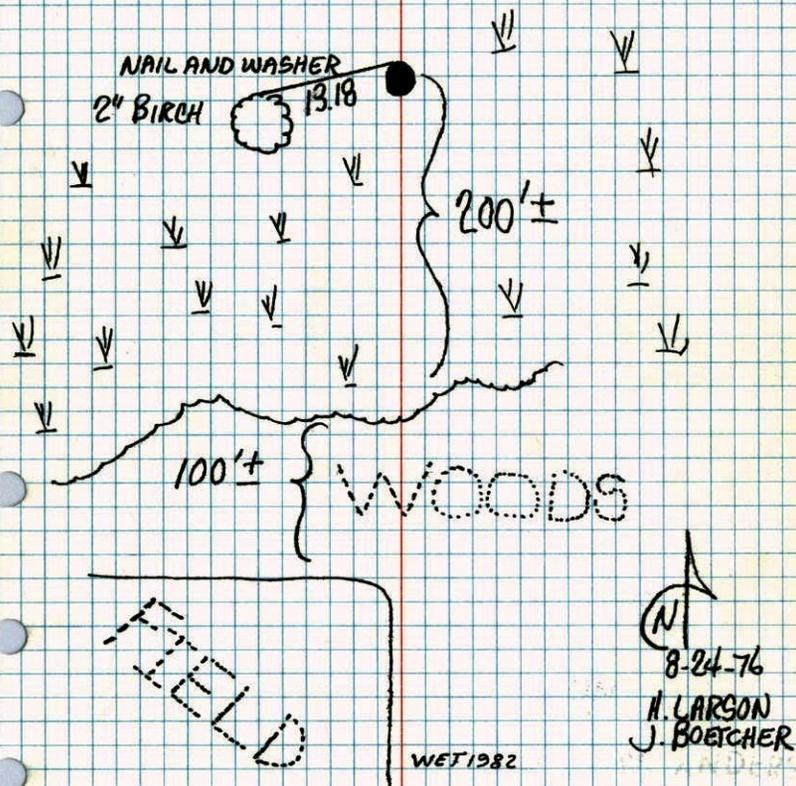

TEMPERATURE CORRECTED  
 AND HORIZONTALLY  
 TAPED MEASUREMENTS

ROLAND W. ANDERSON  
 COUNTY SURVEYOR  
 ANOKA COUNTY, MINNESOTA

## W. 1/4 Cor. Sec. 34 T34 R23

Found 3/4" iron pipe and old rotted stake  
 lying in swamp. pipe and stake set  
 in 1908. Found 5" witness tree to North 10'±. Tree dead.  
 Replaced with red & white iron pipe  
 up 3'± with sign.

