

CERTIFICATE OF LOCATION OF GOVERNMENT CORNER

County of Anoka

State of Minnesota


West 1/4 Corner of Sec. 35 Township 34 Range 23

On the 28th day of September, 1976, the described corner was evidenced by area resurvey

and to perpetuate the location of said corner, at the exact location thereof, a permanent marker was placed consisting of a cast iron monument (DOWN 0.5' ±) (MON. ON WEST EDGE RD.)

AND on the 21st day of May, 2002, said permanent marker was found and the ties were updated

Updated reference ties are as shown below.

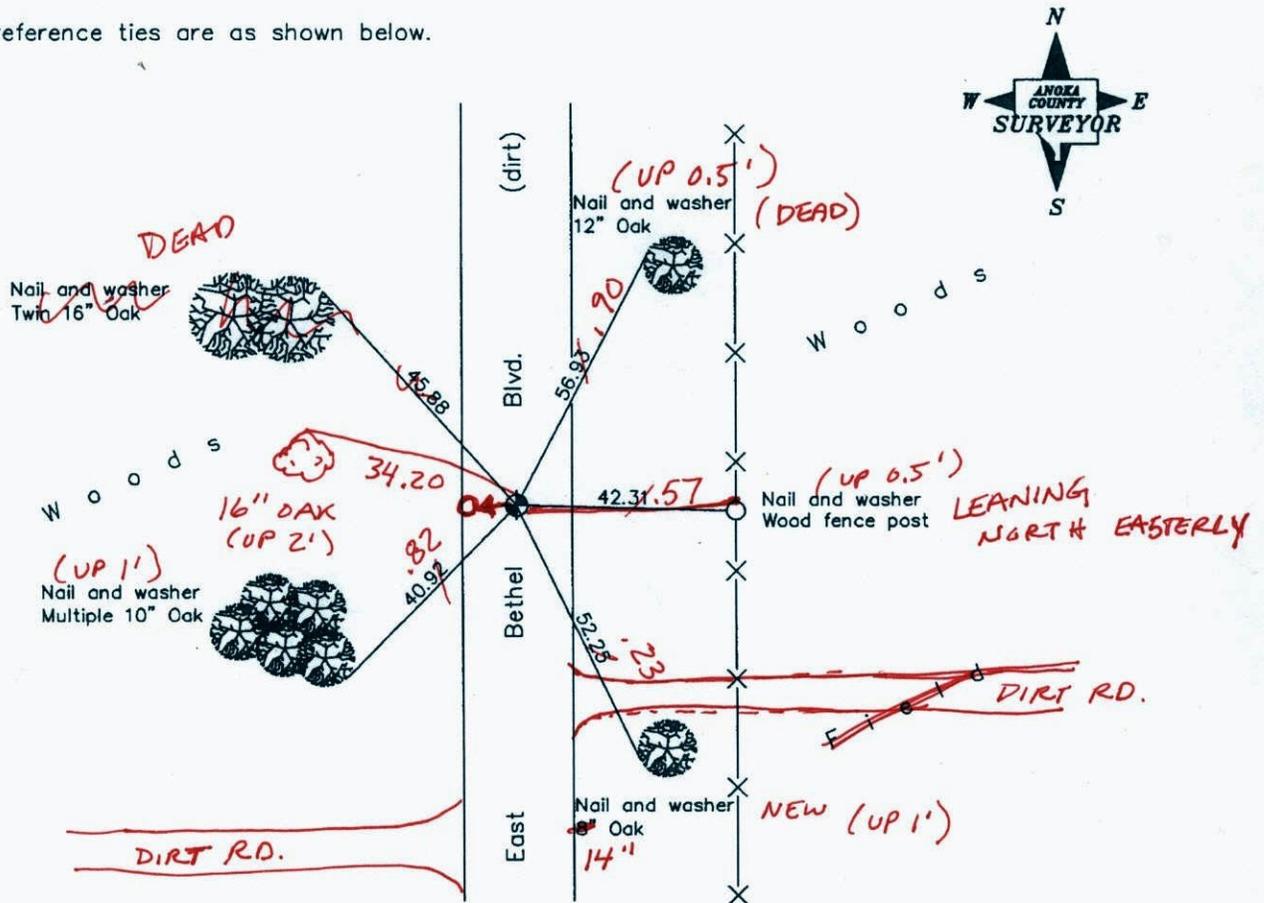

9-27-12
BK-SS
T/T

Revised date
8/04/92
8/16/97
5/21/02

N.A.D. 1983 Coordinates (1996 Adjustment)	
County Project Coordinates	
Northing	<u>230220.6295</u>
Easting	<u>521452.8776</u>
Date	<u>5/21/02</u>

I hereby certify that this United States public land survey monument record is correct and complete to the best of my knowledge and belief.

Larry D. Hoium Date 5/21/02

Larry D. Hoium, Anoka County Surveyor
Minnesota License Number 18165

CERTIFICATE OF LOCATION OF GOVERNMENT CORNER


County of Anoka State of Minnesota

West Quarter Corner of Sec. 35 Township 34 Range 23


I hereby certify that on the 28 day of September, 19 76, I found the described corner which was evidenced by Area Re-survey

and I further certify that to perpetuate the location of said corner, I did, at the exact location thereof, place a permanent marker consisting of cast iron monument

which reference or witness monuments are located in the manner following:

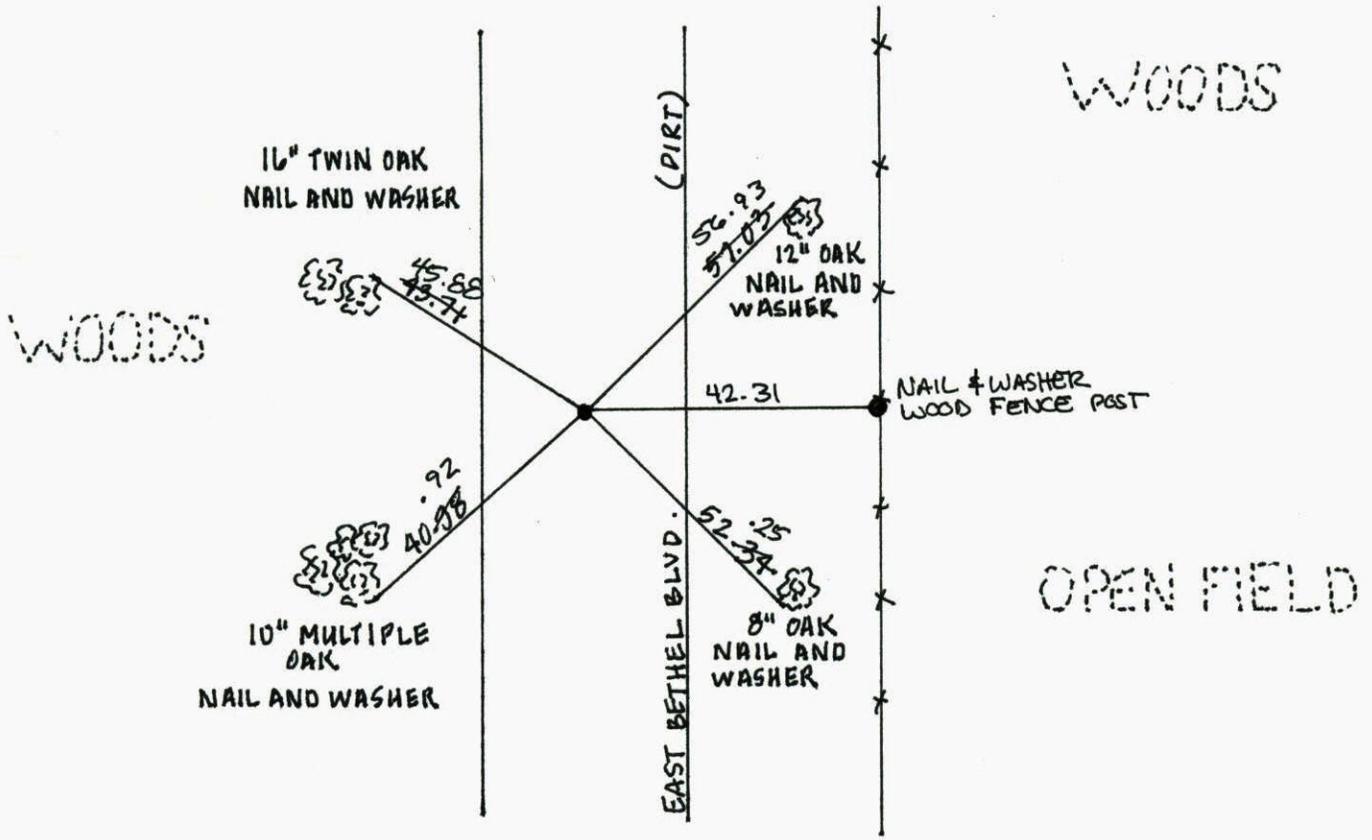


Revised date	Revised date	Revised date
8-1-86		
8-4-92		
8-16-97		
5-21-02		

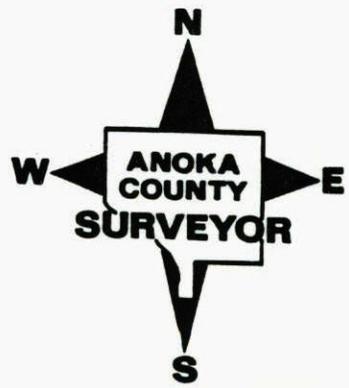

W 1/4 COR. SEC. 35 T. 34 R. 23

SET CAST IRON MONUMENT FROM AREA RESURVEY.
CAST IRON DOWN .5' ± AND 7' ± WEST OF E.

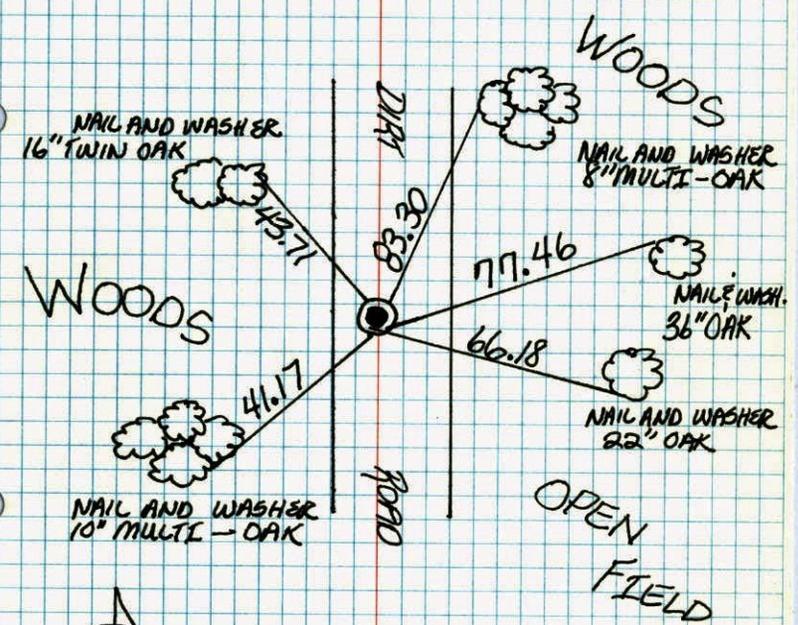

N 9-28-76

H. LARSEN
B. GUETZKO
J. BOETCHER

TIE CHECK
8-21-78
D. DAHL
M. KISROW
B. STEPHENS

TIE CHECK
5-26-82
P. ROSS
B. NICHOLAS


TEMPERATURE CORRECTED
AND HORIZONTALLY
TAPED MEASUREMENTS

ROLAND W. ANDERSON
COUNTY SURVEYOR
ANOKA COUNTY, MINNESOTA

West Quarter Corner of Section 35 T34 R23

Retired Cast Iron

P. 89

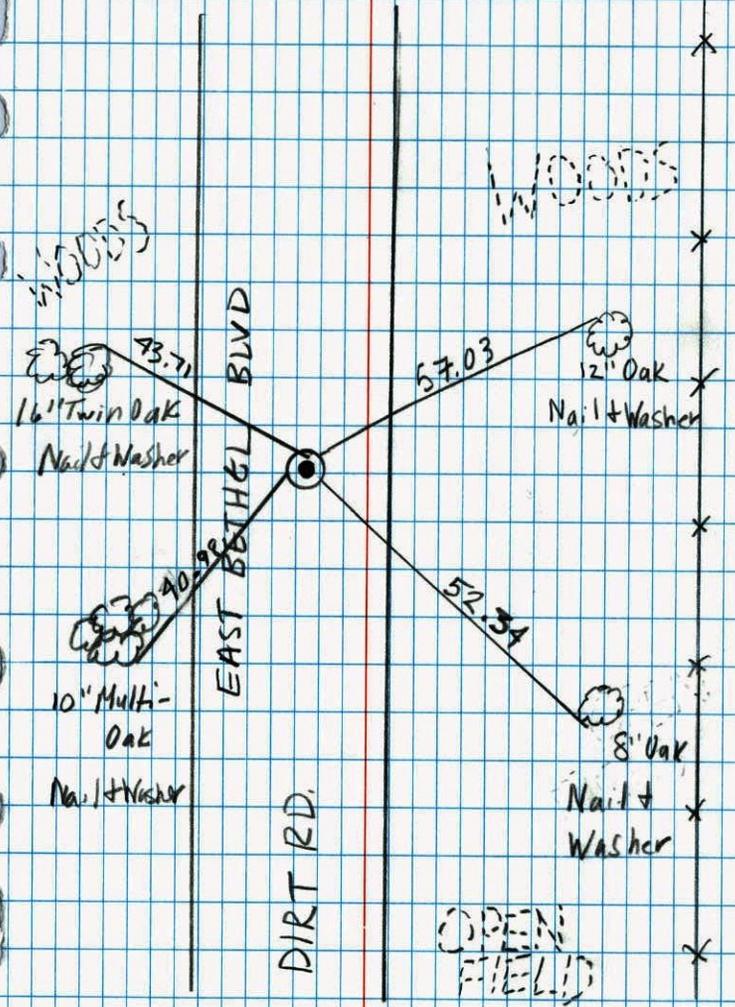

OPEN FIELD

8/6/97
A. Grayson
H. ASKUN

NATIONAL INSTRUMENT NO. 446

