

CERTIFICATE OF LOCATION OF GOVERNMENT CORNER

County of Anoka

State of Minnesota


Witness Corner of Sec. 36 Township 34 Range 23
 (on west line of NW 1/4)

On the 5th day of October, 1978, the described corner was evidenced by area resurvey

and to perpetuate the location of said corner, at the exact location thereof, a permanent marker was placed consisting of a cast iron monument **FOUND SIGN & POST ON N. SIDE FACING S.**

AND on the ___ day of _____, _____, said permanent marker was _____

Updated reference ties are as shown below.

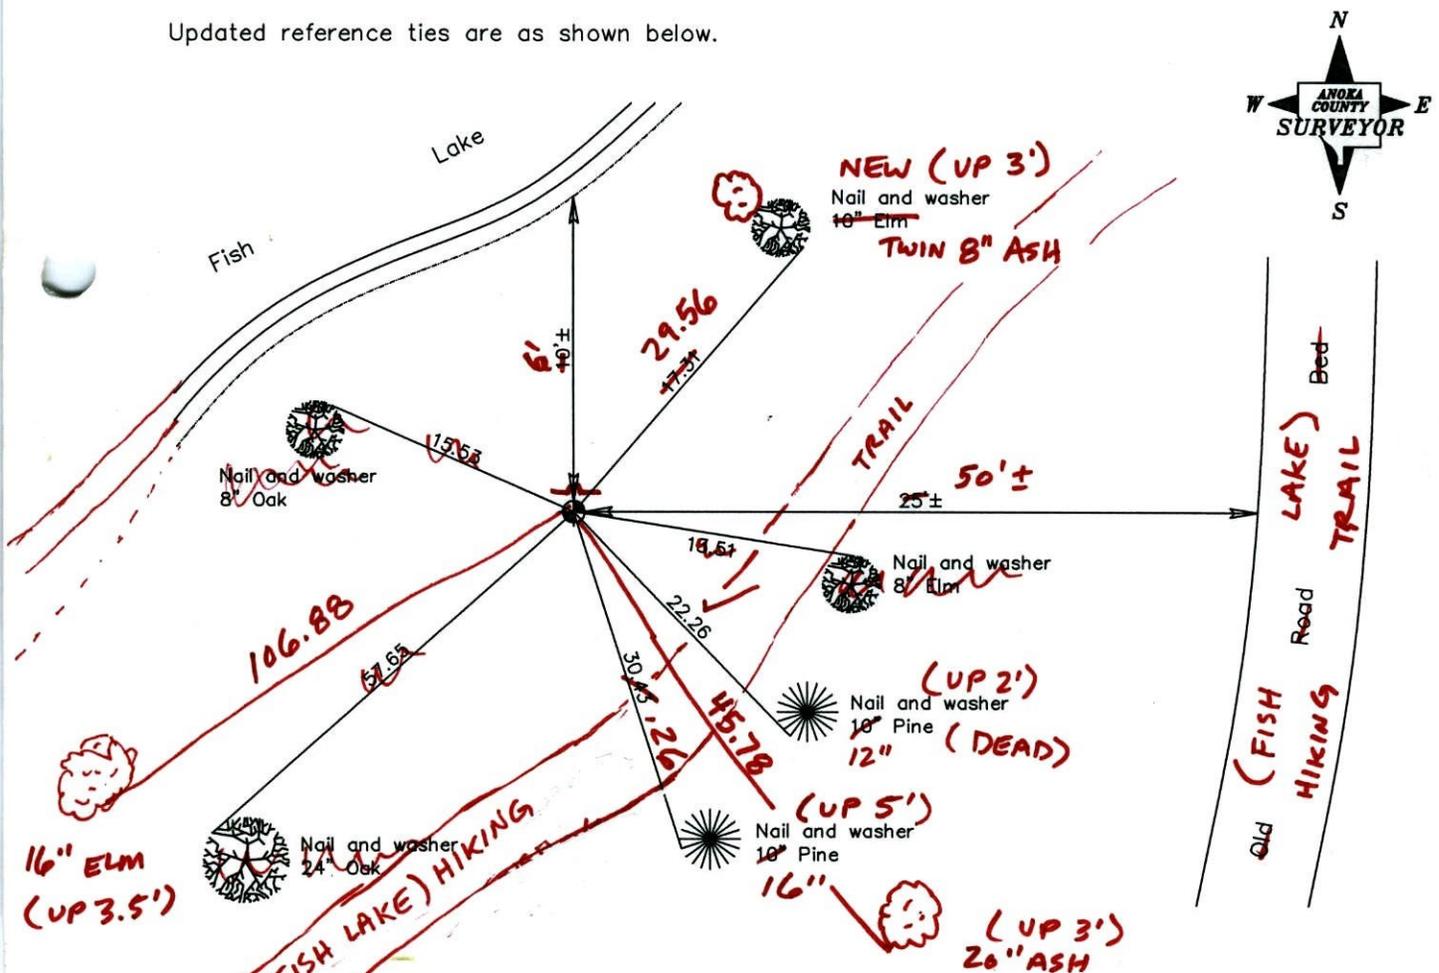

Revised date

8/08/86
8/21/92
8/09/97

N.A.D. 1983 Coordinates
(1996 Adjustment)

County Project Coordinates

Northing	<u>232277.8956</u>
Easting	<u>526621.0034</u>
Date	<u>4/07/03</u>

I hereby certify that this United States public land survey monument record is correct and complete to the best of my knowledge and belief.

Date _____
_____, Anoka County Surveyor
Minnesota License Number _____

4-24-12
BK-SS
TAPED
VRS

30 = 0.05 N = 232277.8849

E = 526621.0126

CERTIFICATE OF LOCATION OF GOVERNMENT CORNER

County of Anoka

State of Minnesota


WITNESS ON W. LINE OF

NORTHWEST QTR. Corner of Sec. 36 Township 34 Range 23


I hereby certify that on the 5 day of OCT., 1978, I found the described corner which was evidenced by AREA RE-SURVEY

and I further certify that to perpetuate the location of said corner, I did, at the exact location thereof, place a permanent marker consisting of CAST IRON

which reference or witness monuments are located in the manner following:

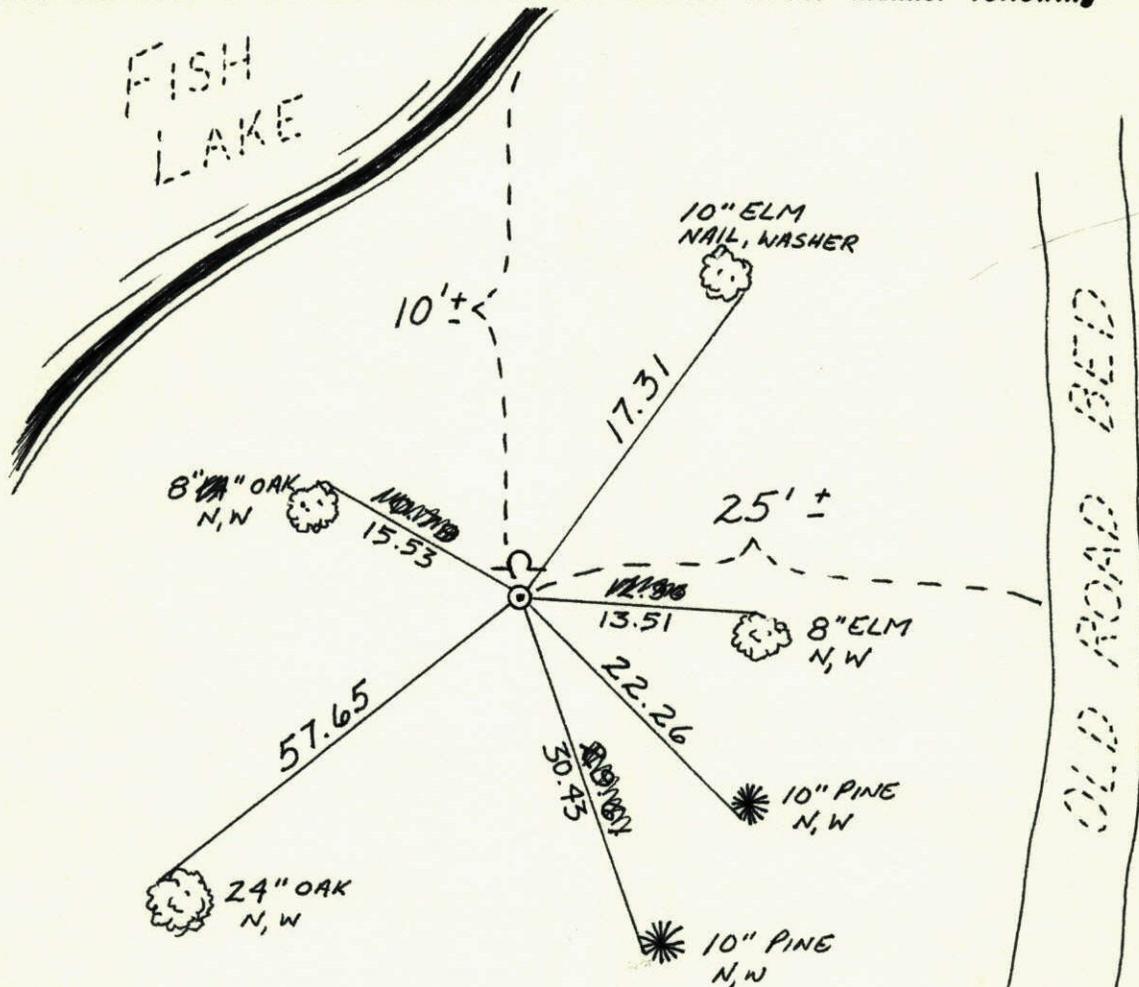


Revised date	Revised date	Revised date
8-8-86		
8-21-92		
8-9-97		

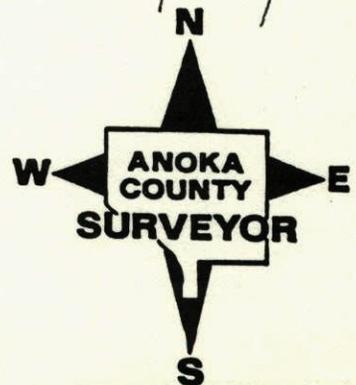

WITNESS CORNER ON WEST LINE OF THE NW 1/4 SECTION 36, T34, R23

SET CAST IRON MONUMENT IN PLACE OF 1 1/4" IRON ROD FOUND TO BE WITNESS CORNER FROM AREA RESURVEY. CAST IRON FLUSH WITH SIGN AND POST ON NORTH SIDE.

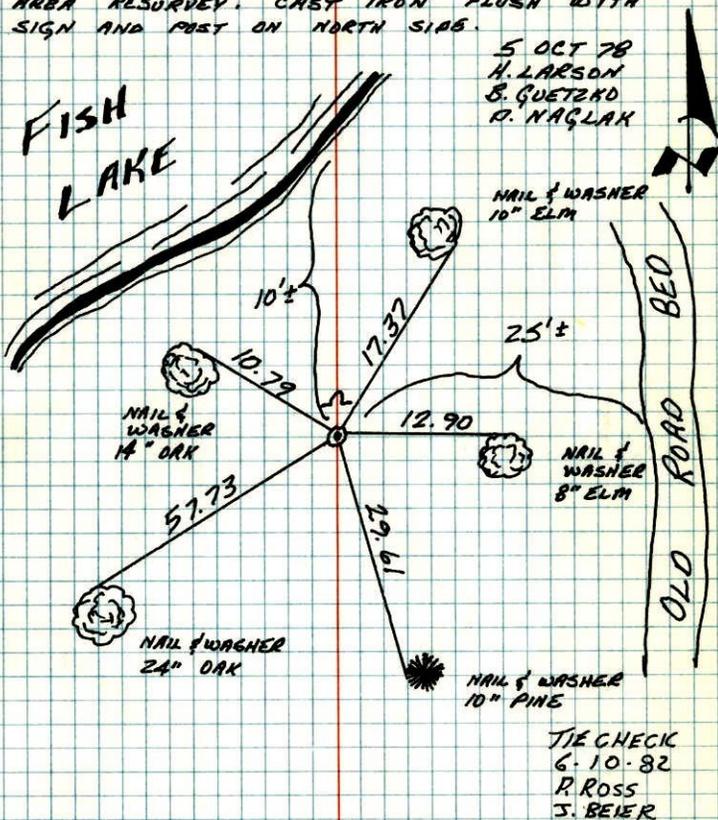

TEMPERATURE CORRECTED
AND HORIZONTALLY
TAPED MEASUREMENTS

ROLAND W. ANDERSON
COUNTY SURVEYOR
ANOKA COUNTY, MINNESOTA

W.C. on West Line of NW 1/4 Section 36 T34 R23

Set cast iron monument in place of 1 1/4" iron rod found to be w.c. From area resurvey. C.I. flush with sign post on N. side.

