W.C. on South Line Sec. 31 - T34 - R23

Set Cast Iron Monument flush from area resurvey a distance of 383.00' East of S¼ Cor. Sec. 31.

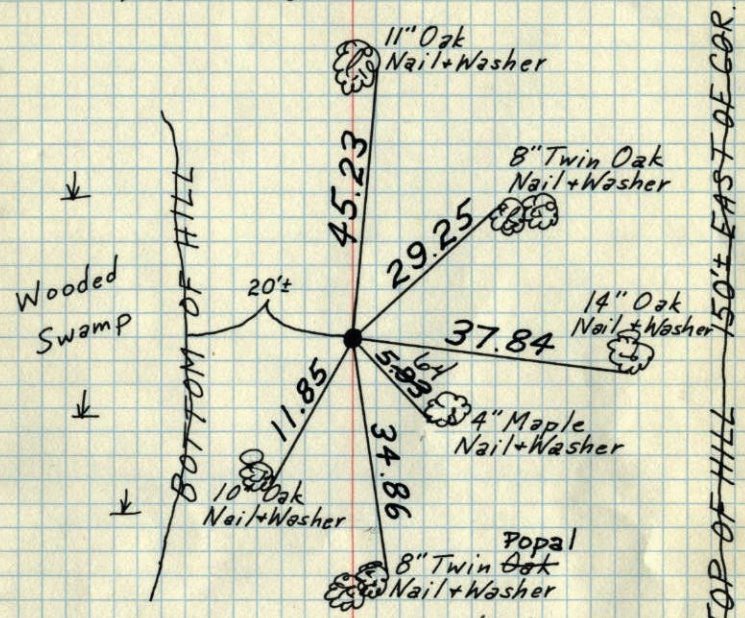

March 11, 1969
M.D. Anderson
H.J. Larson
R.A. Olson

TIE CHECK
6-16-82
P. ROSS
P. HORNBY
J. BEIER

Tie Check
Aug 19 1971
K. Brion
J. Boettcher
B. Olson

Tie Check
8-12-75
D. DAHL
B. SANNERUD
G. ADAMS

TIE CHECK
8-23-78
D. DAHL
B. STEPHENS
M. KISROW

TEMPERATURE CORRECTED AND HORIZONTALLY TAPED MEASUREMENTS

ROLAND W. ANDERSON
COUNTY SURVEYOR
ANOKA COUNTY, MINNESOTA

W.C. on S. line Sec. 31, T34, R23

W.C. is a distance of 383.00 ft. E of S¼ Cor

Set Cast Iron Monument flush
Set from area resurvey

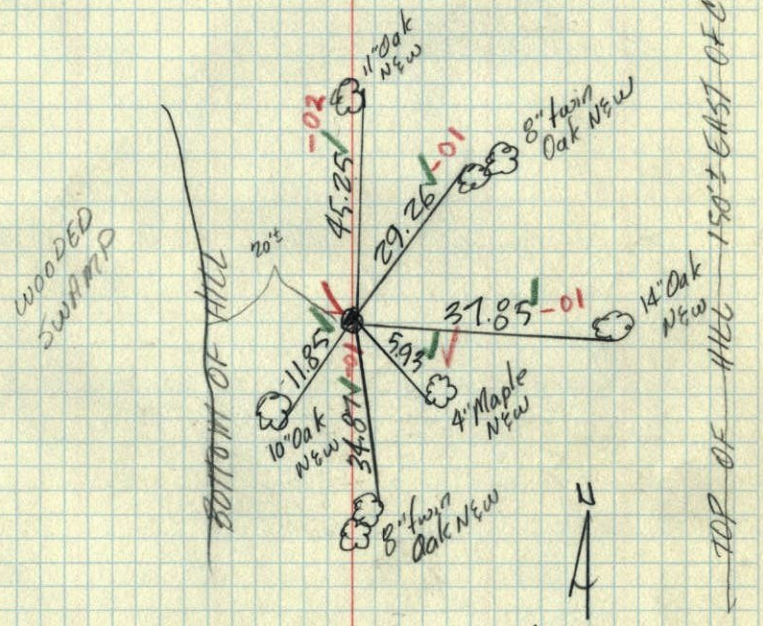

March 11, 1969
M.D. Anderson
H.J. Larson
R.A. Olson
temp. +10°
tape #6