W.C. on South Line Sec. 31-T34-R23

Set Cast Iron Monument flush from area resurvey a distance of 1435.54' West of S¼ Cor. Sec. 31. Sign Post & Warning Sign 1'± North

March 11, 1969
M.D. Anderson
H.J. Larson
R.A. Olson

Tie Check
Aug 19, 1971
R. Breen
J. Boettcher
B. Olson

TIE CHECK
8-30-78
M. KISROW
B. STEPHENS

TIE CHECK
6-7-82
P. ROSS
B. NICHOLAS
J. BEIER

TIE CHECK
O. DAHL
B. SANDERVOD
G. ADAMS

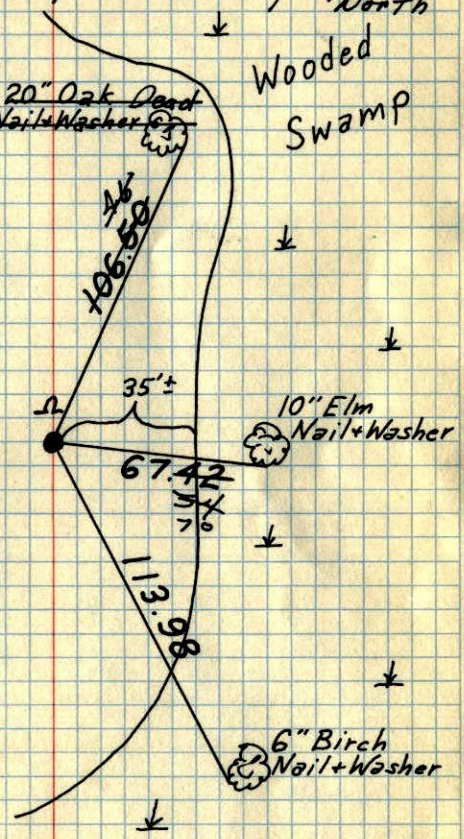

TEMPERATURE CORRECTED AND HORIZONTALLY TAPED MEASUREMENTS

ROLAND W. ANDERSON
COUNTY SURVEYOR
ANOKA COUNTY, MINNESOTA

W.C. on S. line Sec. 31-T34-R23

A distance of 1435.54 W. of S¼ Corn. Sec. 31
set Cast Iron Mon flush
set from area resurvey
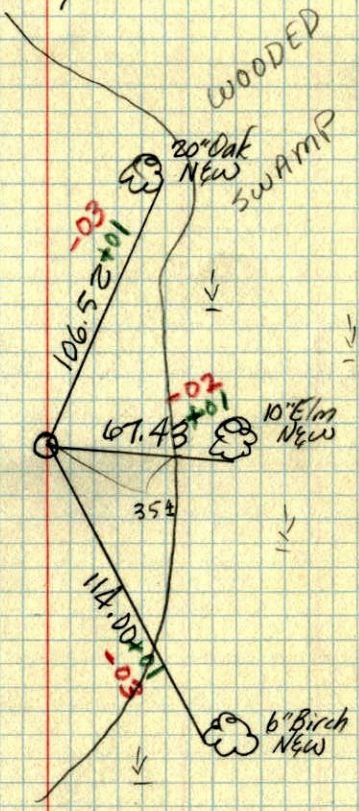
March 11, 1969
M.D. Anderson
H.J. Larson
R.A. Olson
temp. 30°
tape ± 6 ✓