S 1/4 CORNER OF SECTION 26 (1A)
TOWNSHIP 34, RANGE ~~22~~ 23

I.P. DOWN 0.5

107/4

NO SUCH TIES
AT S1/4 SEC 26
T 34, R 22

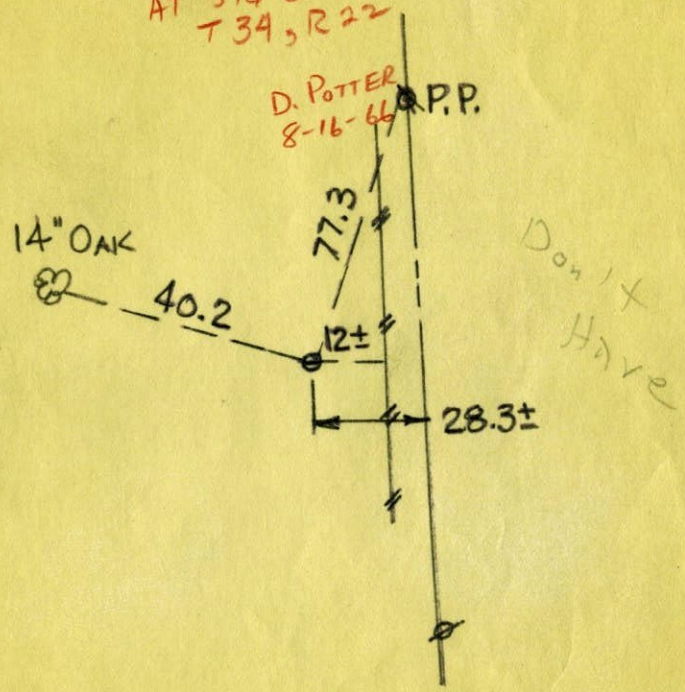

DON'T HAVE

N. C. HOIUM
AND ASSOCIATES, INC.
LAND SURVEYORS

ANOKA, MINNESOTA