S.E. COR SEC. 32-34-23

3" I.P. 4' LONG UP 1.8' IN SWAMP

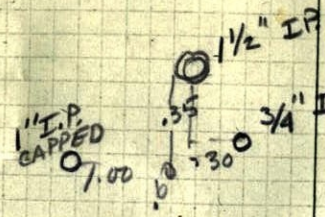

5-1

X 2,199,526.12

Y 870,375.45

ELEV. 897.11

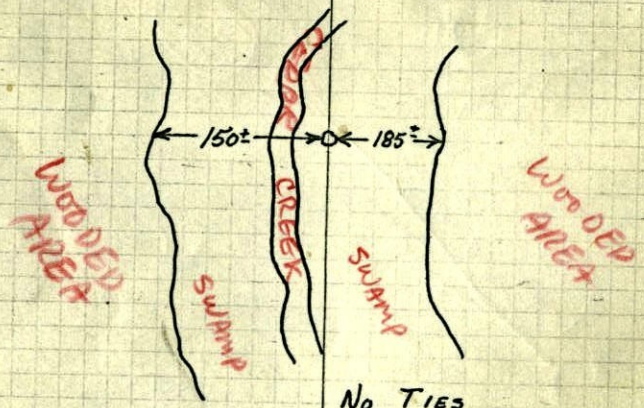

NO TIES

NORMAN C. HOLUM